


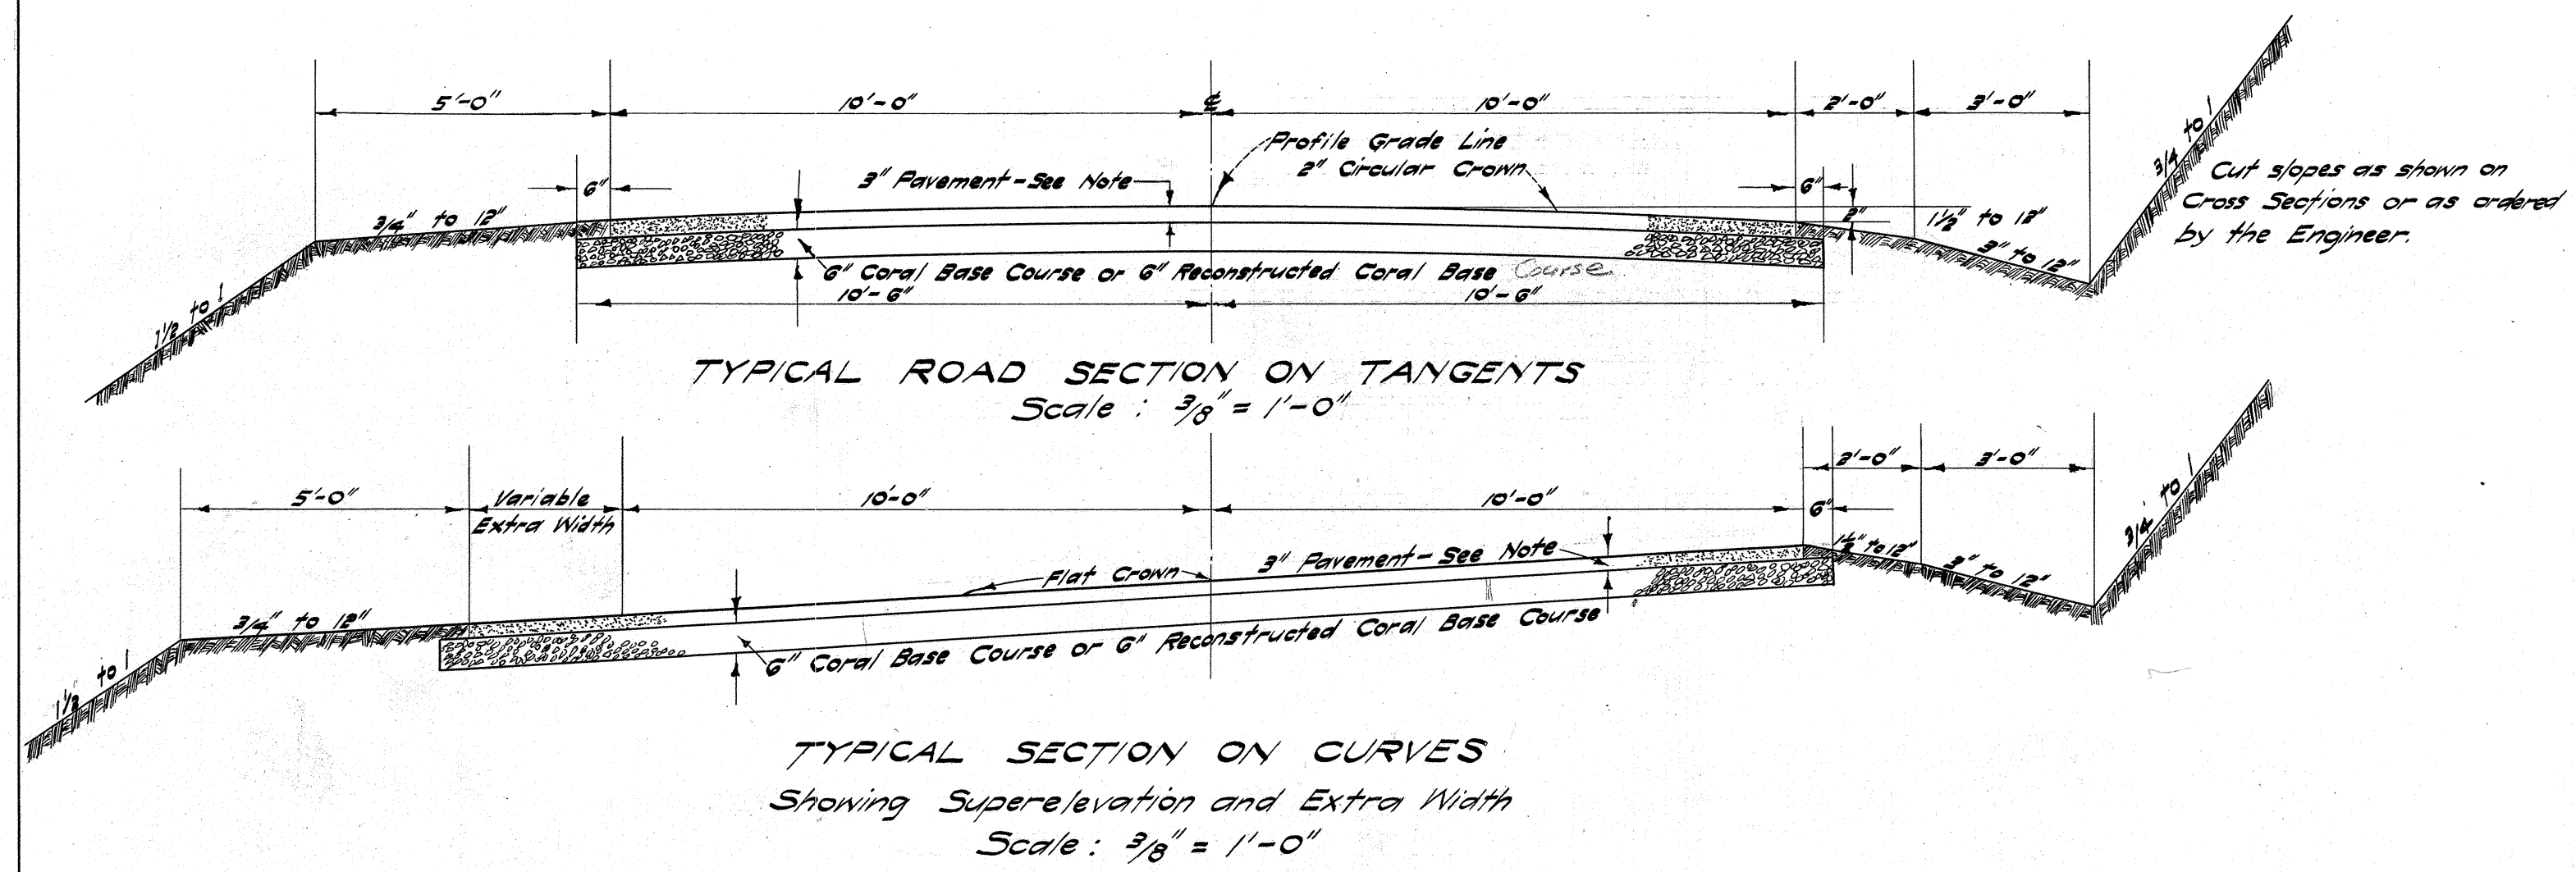


NOTES re Pavements

The 3" Pavement shall be either a 3" Asphaltic Macadam Surface Course with a Seal Coat or a 3" Cold Emulsified Asphalt Pavement depending upon the bid items accepted.

The 3" Asphalt Macadam Surface Course shall have $3\frac{1}{2}$ " (measure loose) of No. 2 Crushed Rock ($2\frac{1}{2}''$ to $1\frac{1}{4}''$), 14 pounds per sq. yd. of Grade A-2 Asphalt (85 - 100) and sufficient No. 3 Crushed Rock ($1\frac{1}{4}''$ to $3\frac{1}{4}''$) to cover. This shall have a seal coat of 4 to 5 pounds of Grade A-2 Asphalt and No. 4 Crushed Rock ($\frac{1}{4}''$ to $\frac{1}{8}''$) to cover.

The 3" Cold Emulsified Asphalt Pavement shall be built in courses as follows: - A 3" (compacted) layer of coarse Rock, Grade C ($2\frac{1}{2}''$ to $1\frac{1}{2}''$) is placed. This is filled to within 1" of its top with Rock chips, Grade "F" ($\frac{3}{8}''$ to $\frac{1}{4}''$). Emulsion is then applied at the rate of $\frac{3}{4}$ to $\frac{3}{8}$ gallon per sq. yd. This is covered with Screenings, Grade "E" ($\frac{3}{4}''$ to $\frac{1}{2}''$). Then a second application of emulsion is made at the rate of $\frac{3}{4}$ to $\frac{1}{2}$ gallon per sq. yd. This is covered with Rock Chips, Grade "F" ($\frac{3}{8}''$ to $\frac{1}{4}''$), later a seal coat of emulsion is applied at a rate of $\frac{3}{8}$ to $\frac{1}{2}$ gallon per sq. yd. and this is covered with Rock Chips Grade "G" ($\frac{1}{4}''$ to $\frac{1}{8}''$). The total emulsion used shall be between the limits of $1\frac{1}{2}$ to $2\frac{1}{2}$ gallons per sq. yd.

Particular reference is made to the Specification covering these items of work.

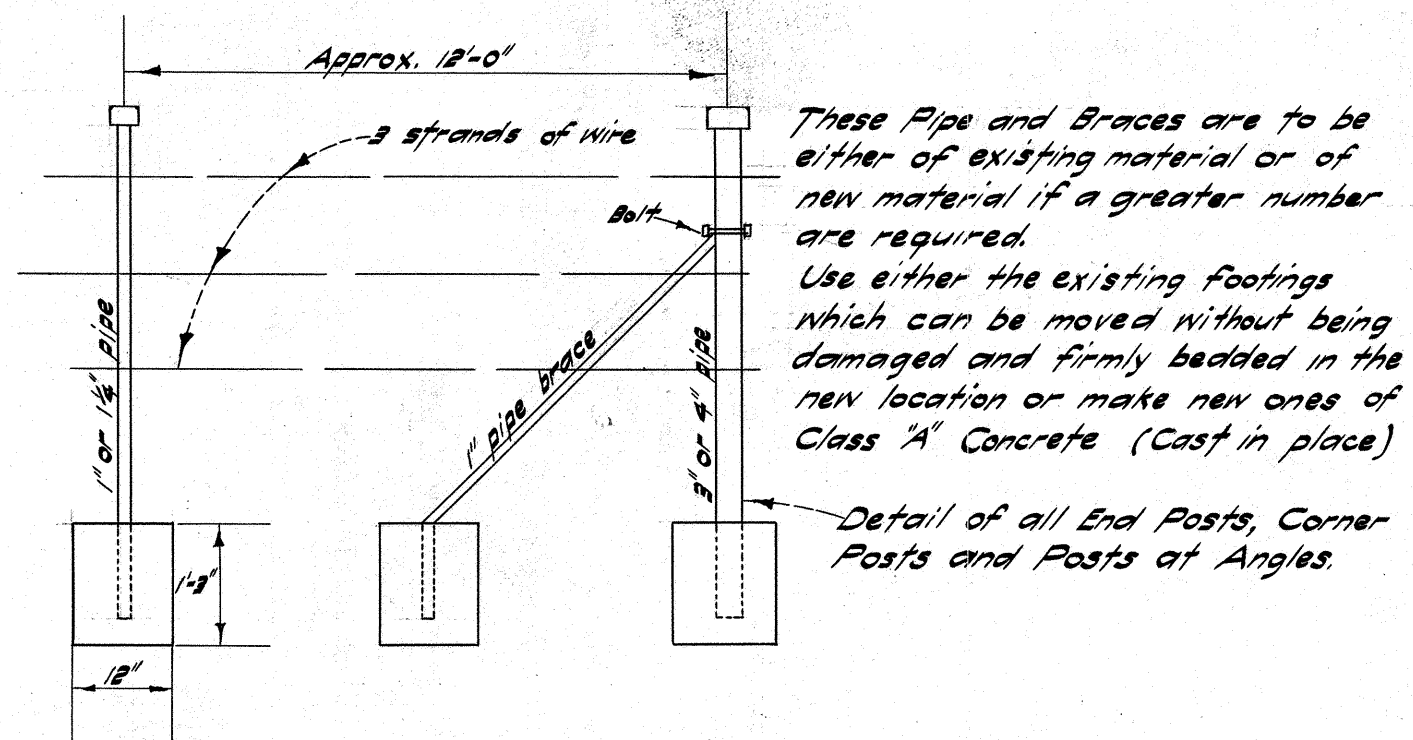

RECONSTRUCTED WIRE FENCE WITH PIPE POSTS

