


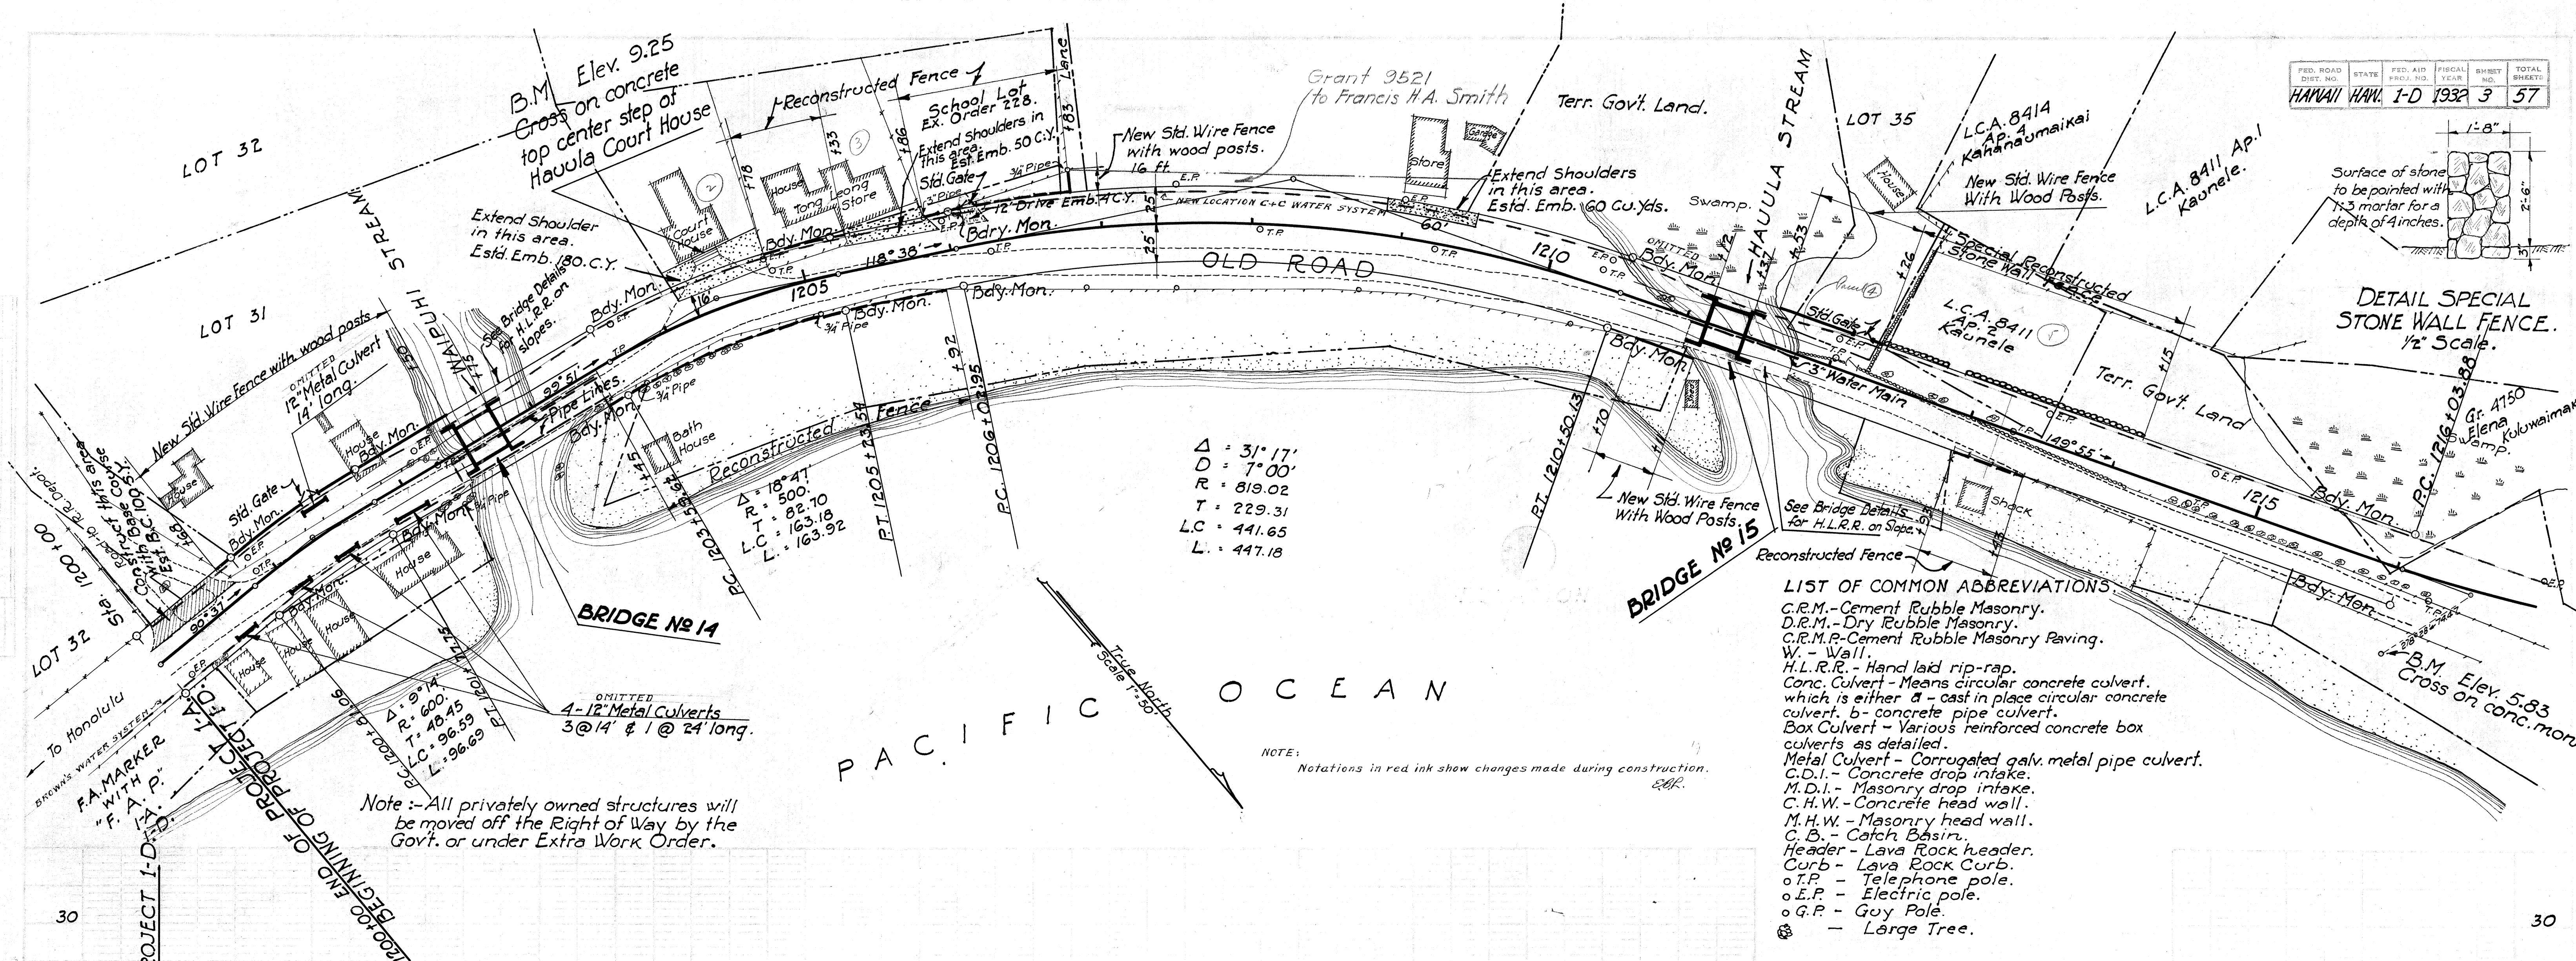


$\Delta = 31^\circ 17'$
 $D = 7^\circ 00'$
 $R = 819.02$
 $T = 229.31$
 $LC = 441.65$
 $L = 447.18$



- LIST OF COMMON ABBREVIATIONS**
- C.R.M. - Cement Rubble Masonry.
 - D.R.M. - Dry Rubble Masonry.
 - C.R.M.P. - Cement Rubble Masonry Paving.
 - W. - Wall.
 - H.L.R.R. - Hand laid rip-rap.
 - Conc. Culvert - Means circular concrete culvert, which is either a - cast in place circular concrete culvert, b - concrete pipe culvert.
 - Box Culvert - Various reinforced concrete box culverts as detailed.
 - Metal Culvert - Corrugated galv. metal pipe culvert.
 - C.D.I. - Concrete drop intake.
 - M.D.I. - Masonry drop intake.
 - C.H.W. - Concrete head wall.
 - M.H.W. - Masonry head wall.
 - C.B. - Catch Basin.
 - Header - Lava Rock header.
 - Curb - Lava Rock Curb.
 - o.T.P. - Telephone pole.
 - o.E.P. - Electric pole.
 - o.G.P. - Guy Pole.
 - o - Large Tree.


DETAIL SPECIAL STONE WALL FENCE.
1/2" Scale.



Note: - All privately owned structures will be moved off the Right of Way by the Gov't. or under Extra Work Order.

NOTE: Notations in red ink show changes made during construction.

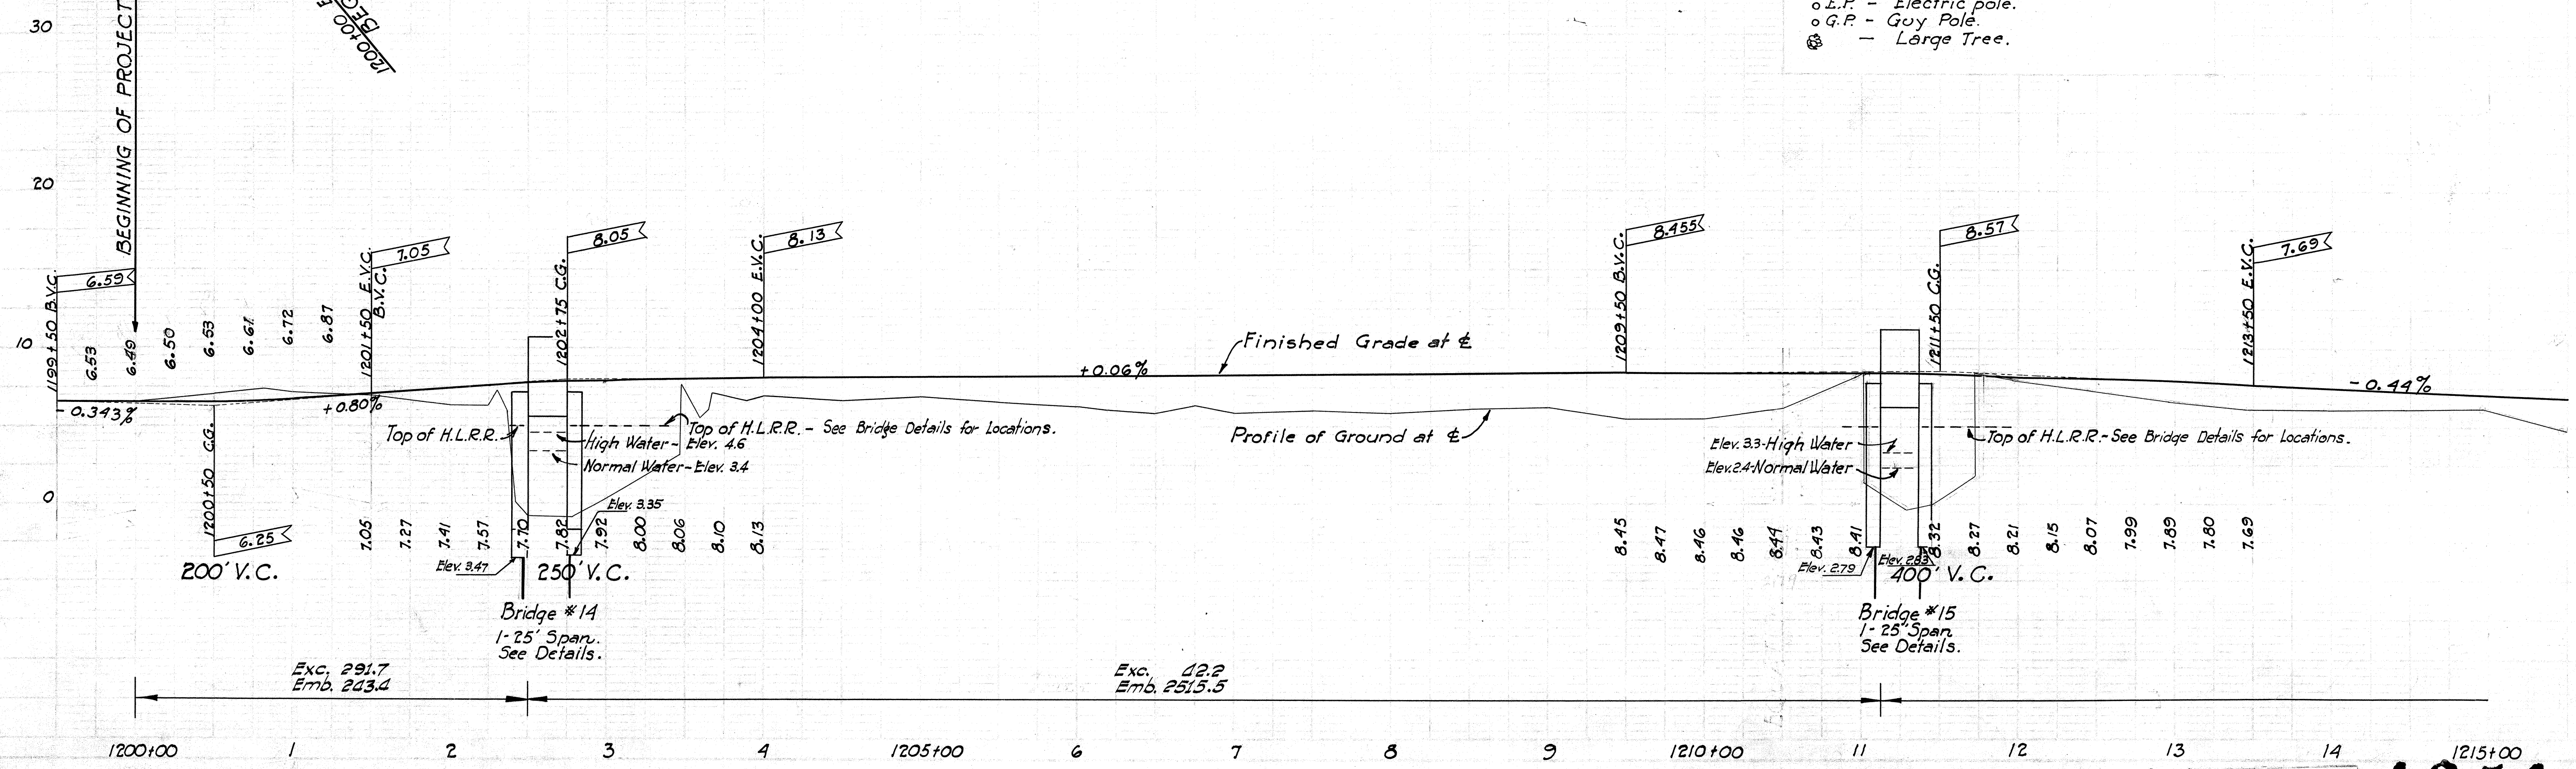

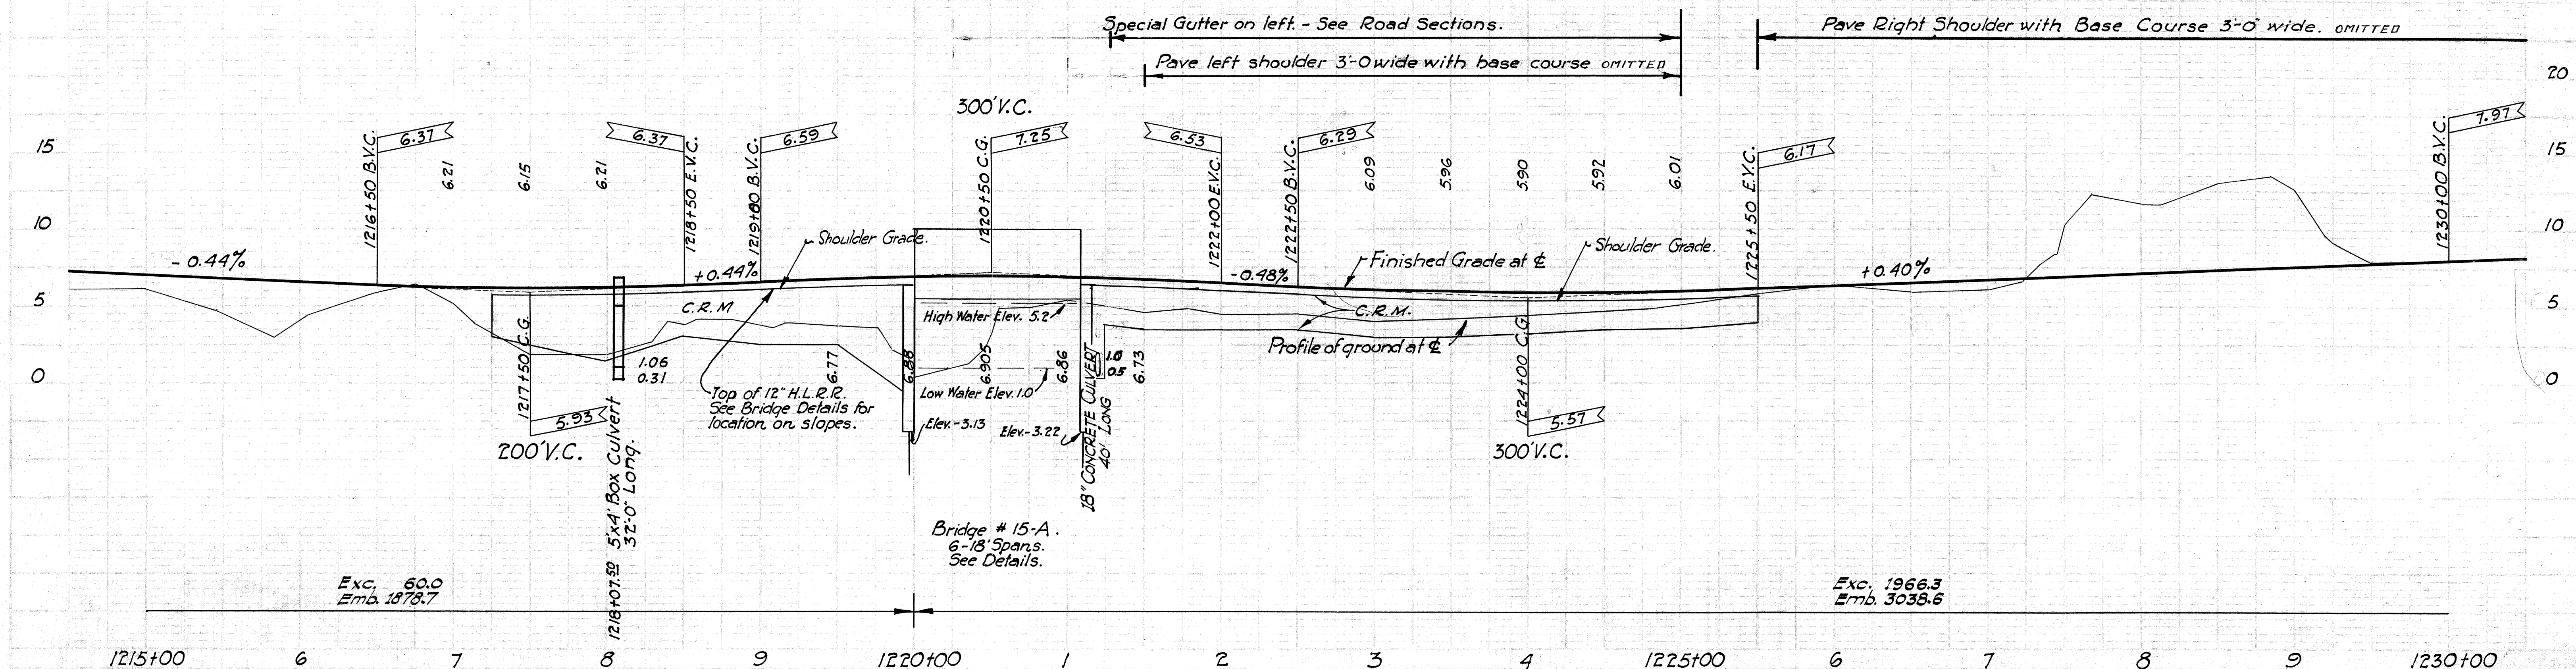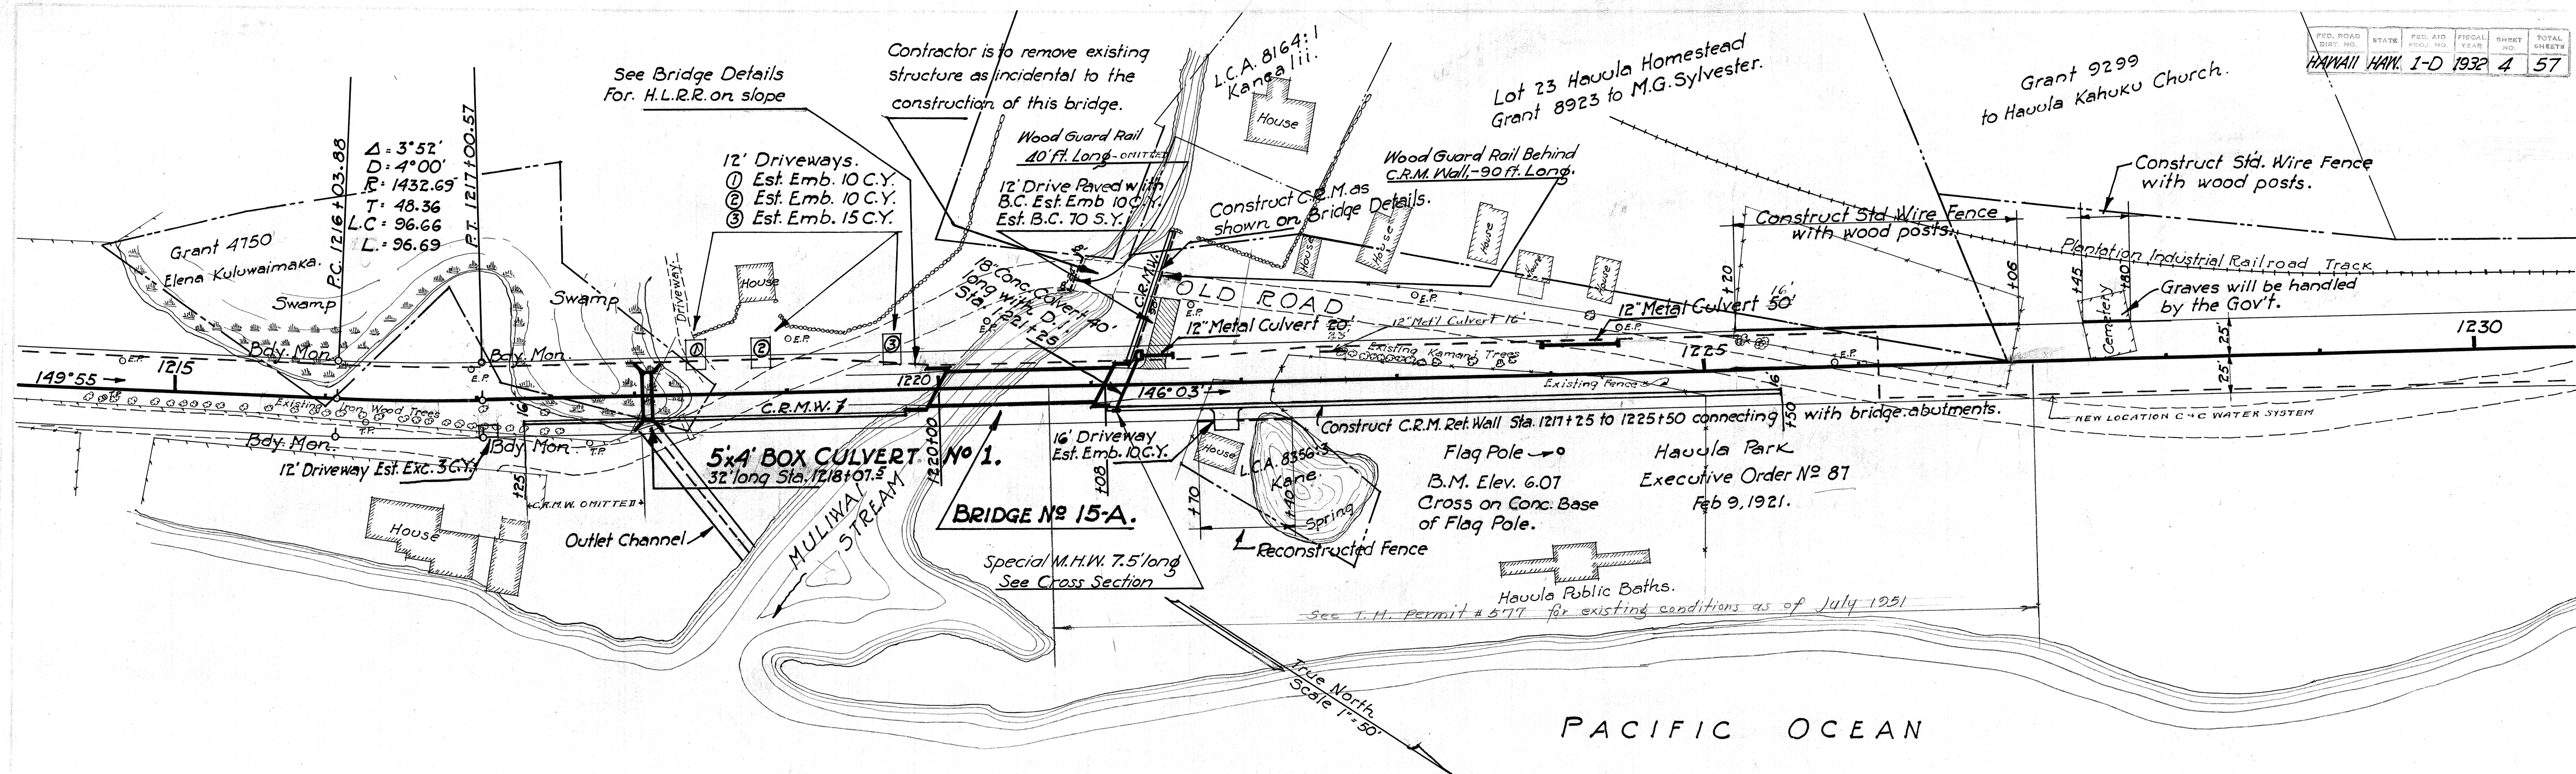

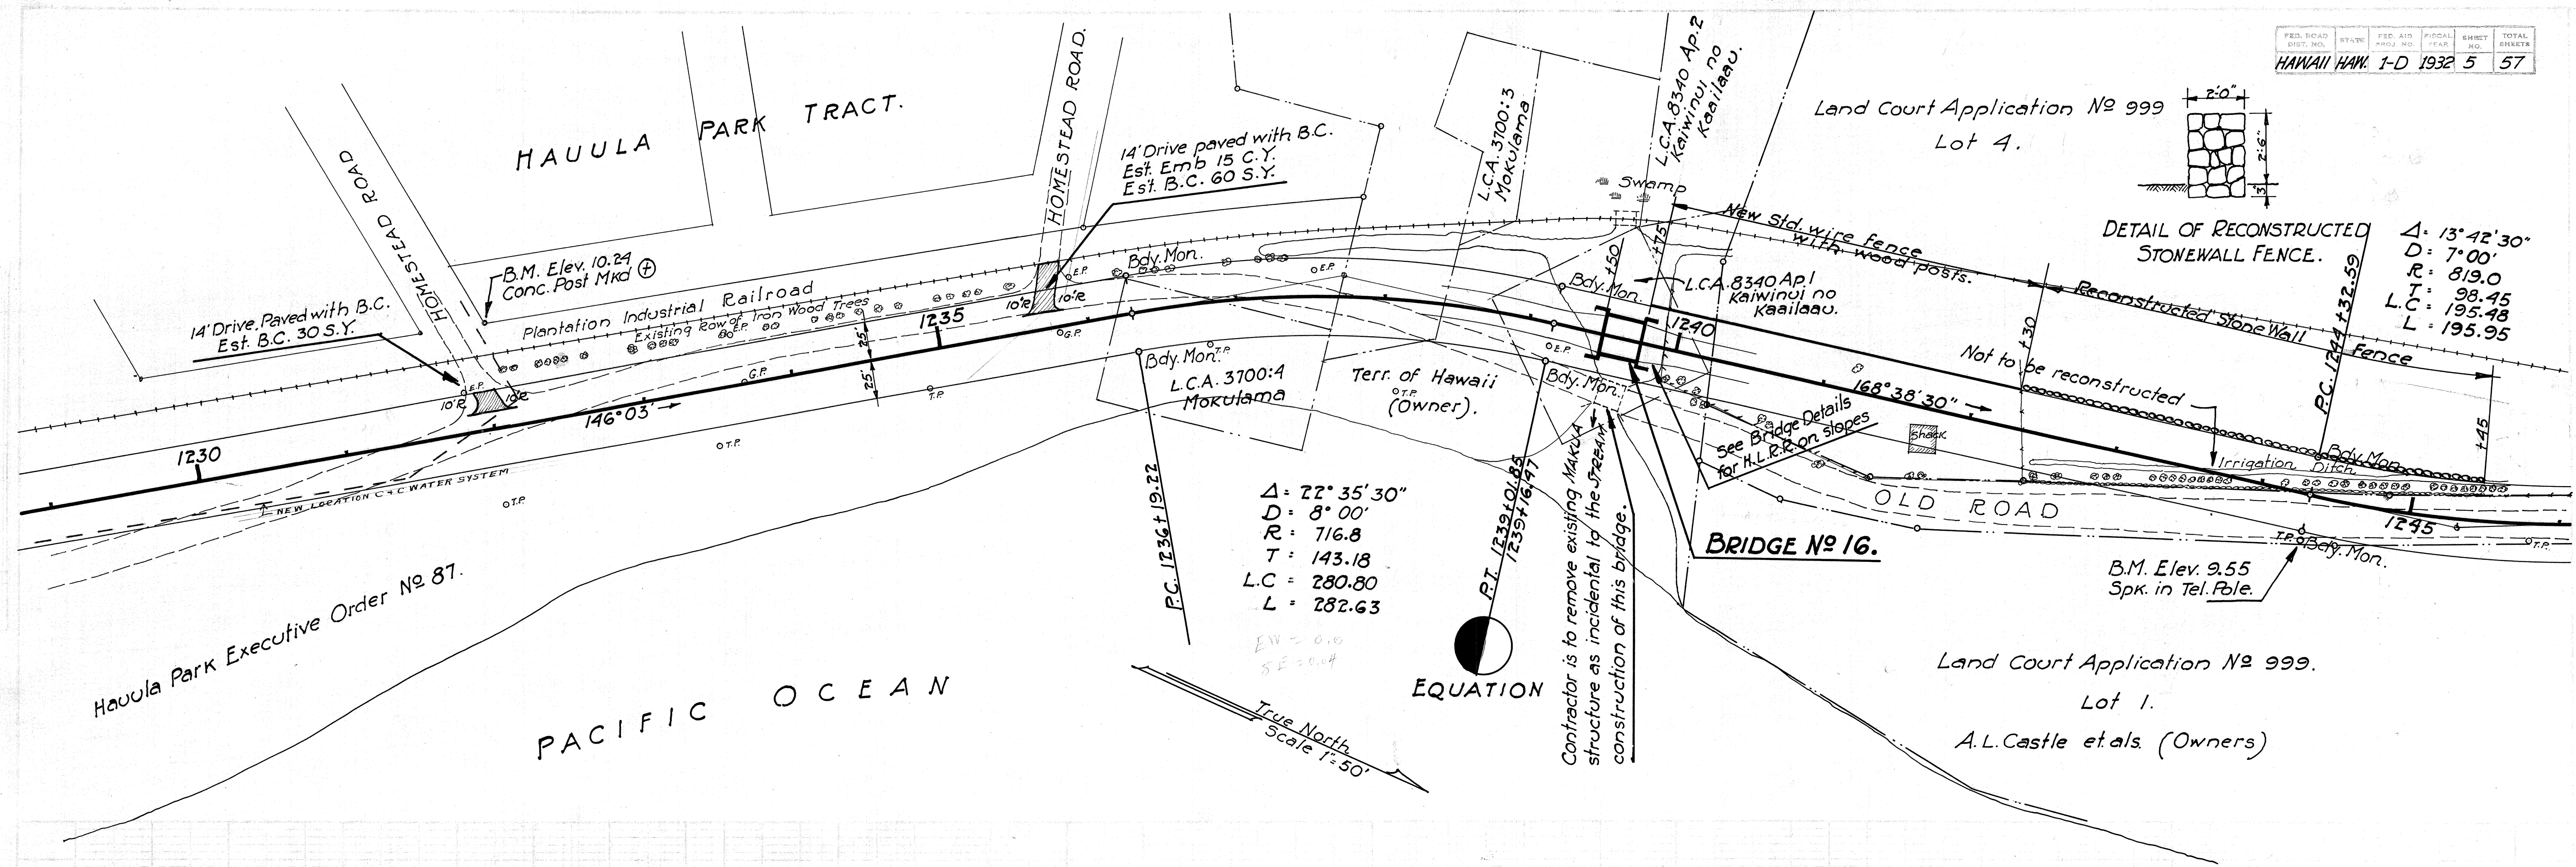


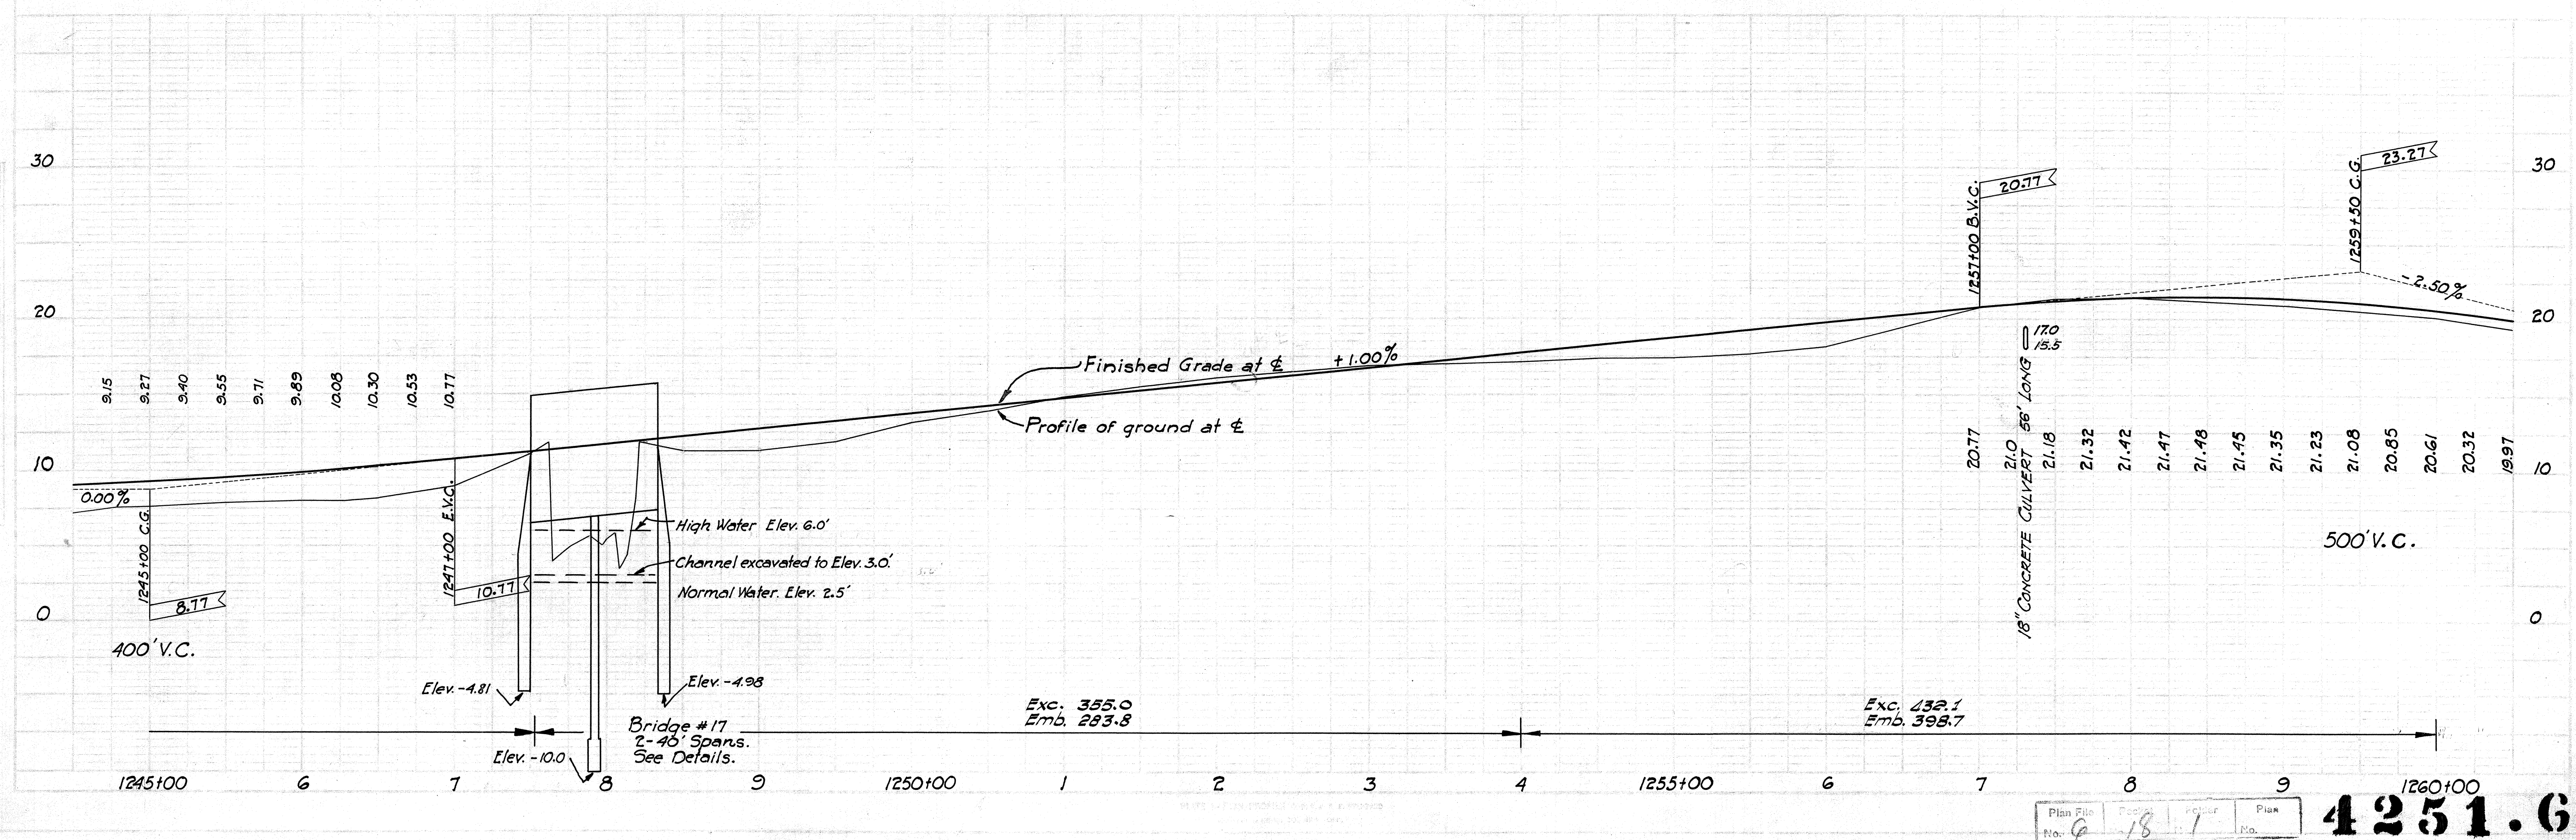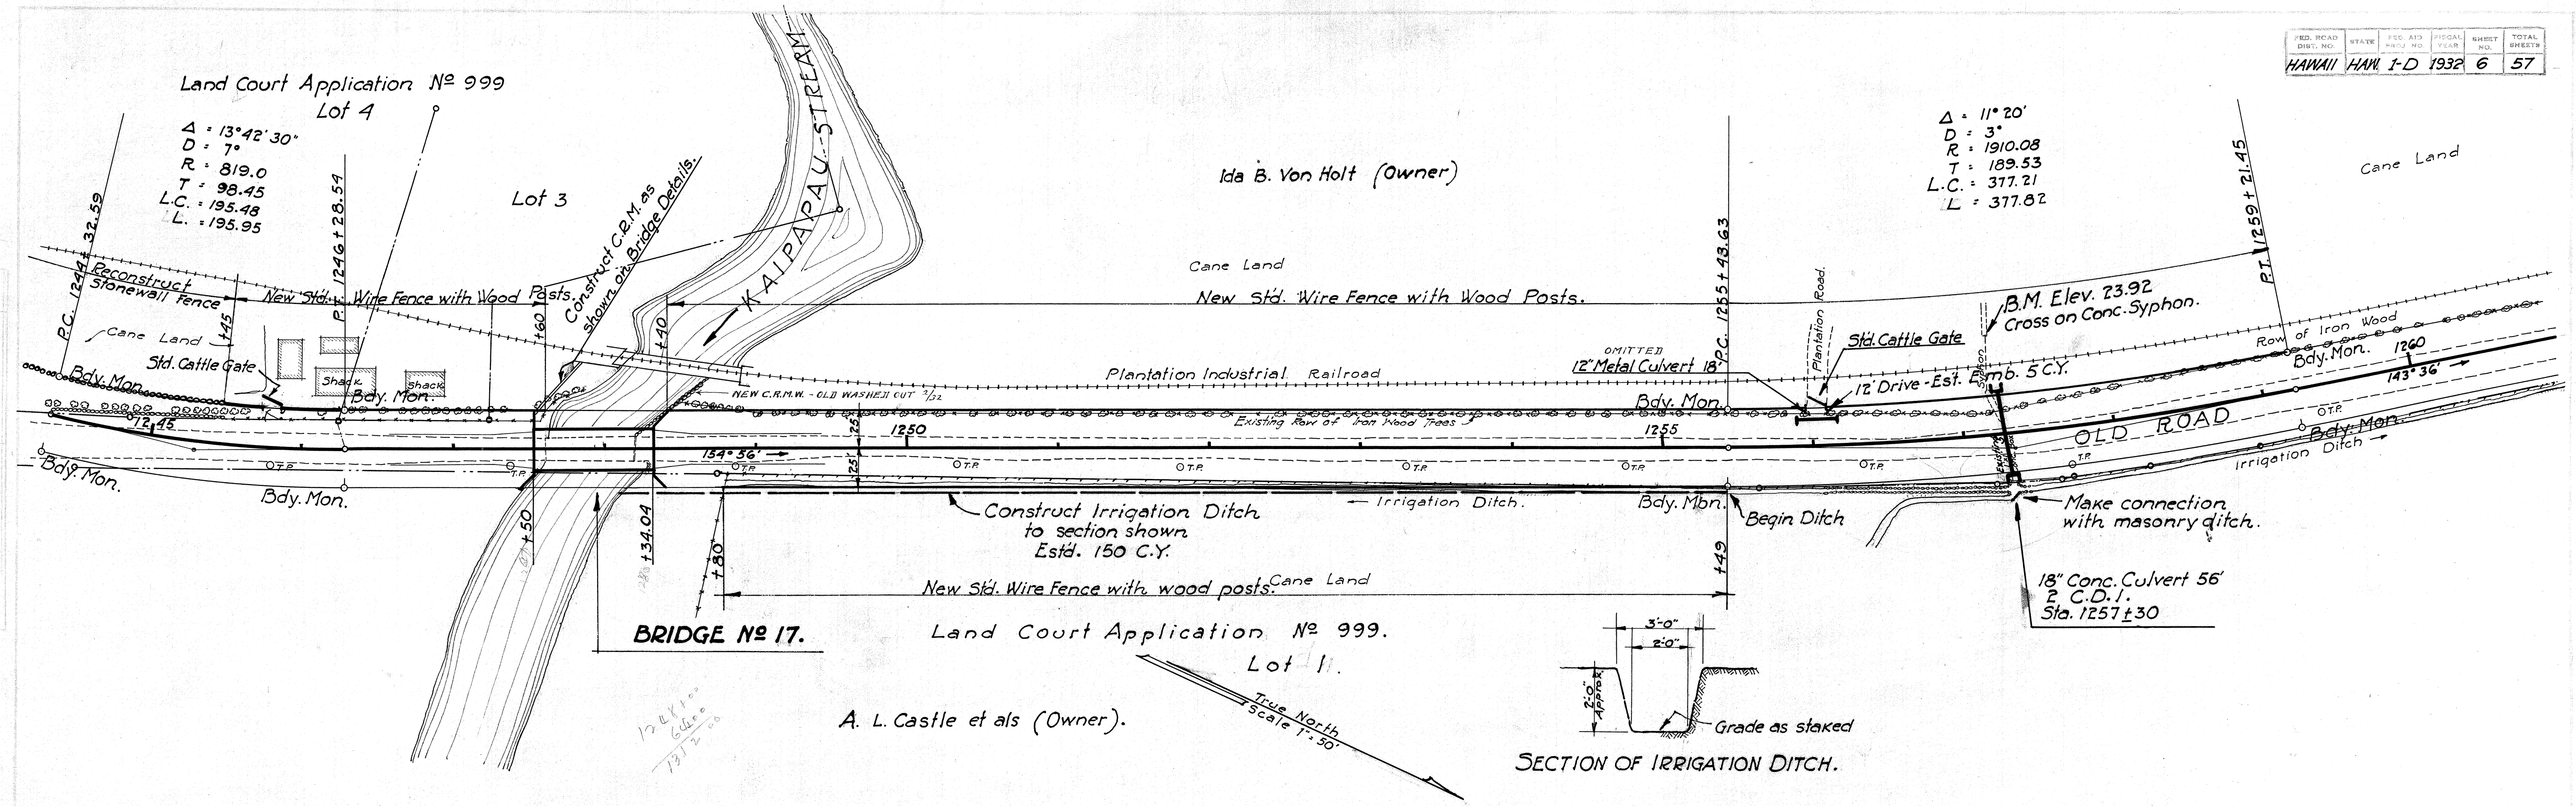


Ida B. Von Holt (Owner).



Δ = 12° 07' 30"
D = 3° 30"
R = 1637.28
T = 173.89
L.C. = 345.82
L = 346.48



DETAIL D.R.M. WALL.
Scale 1/2" = 1'-0"


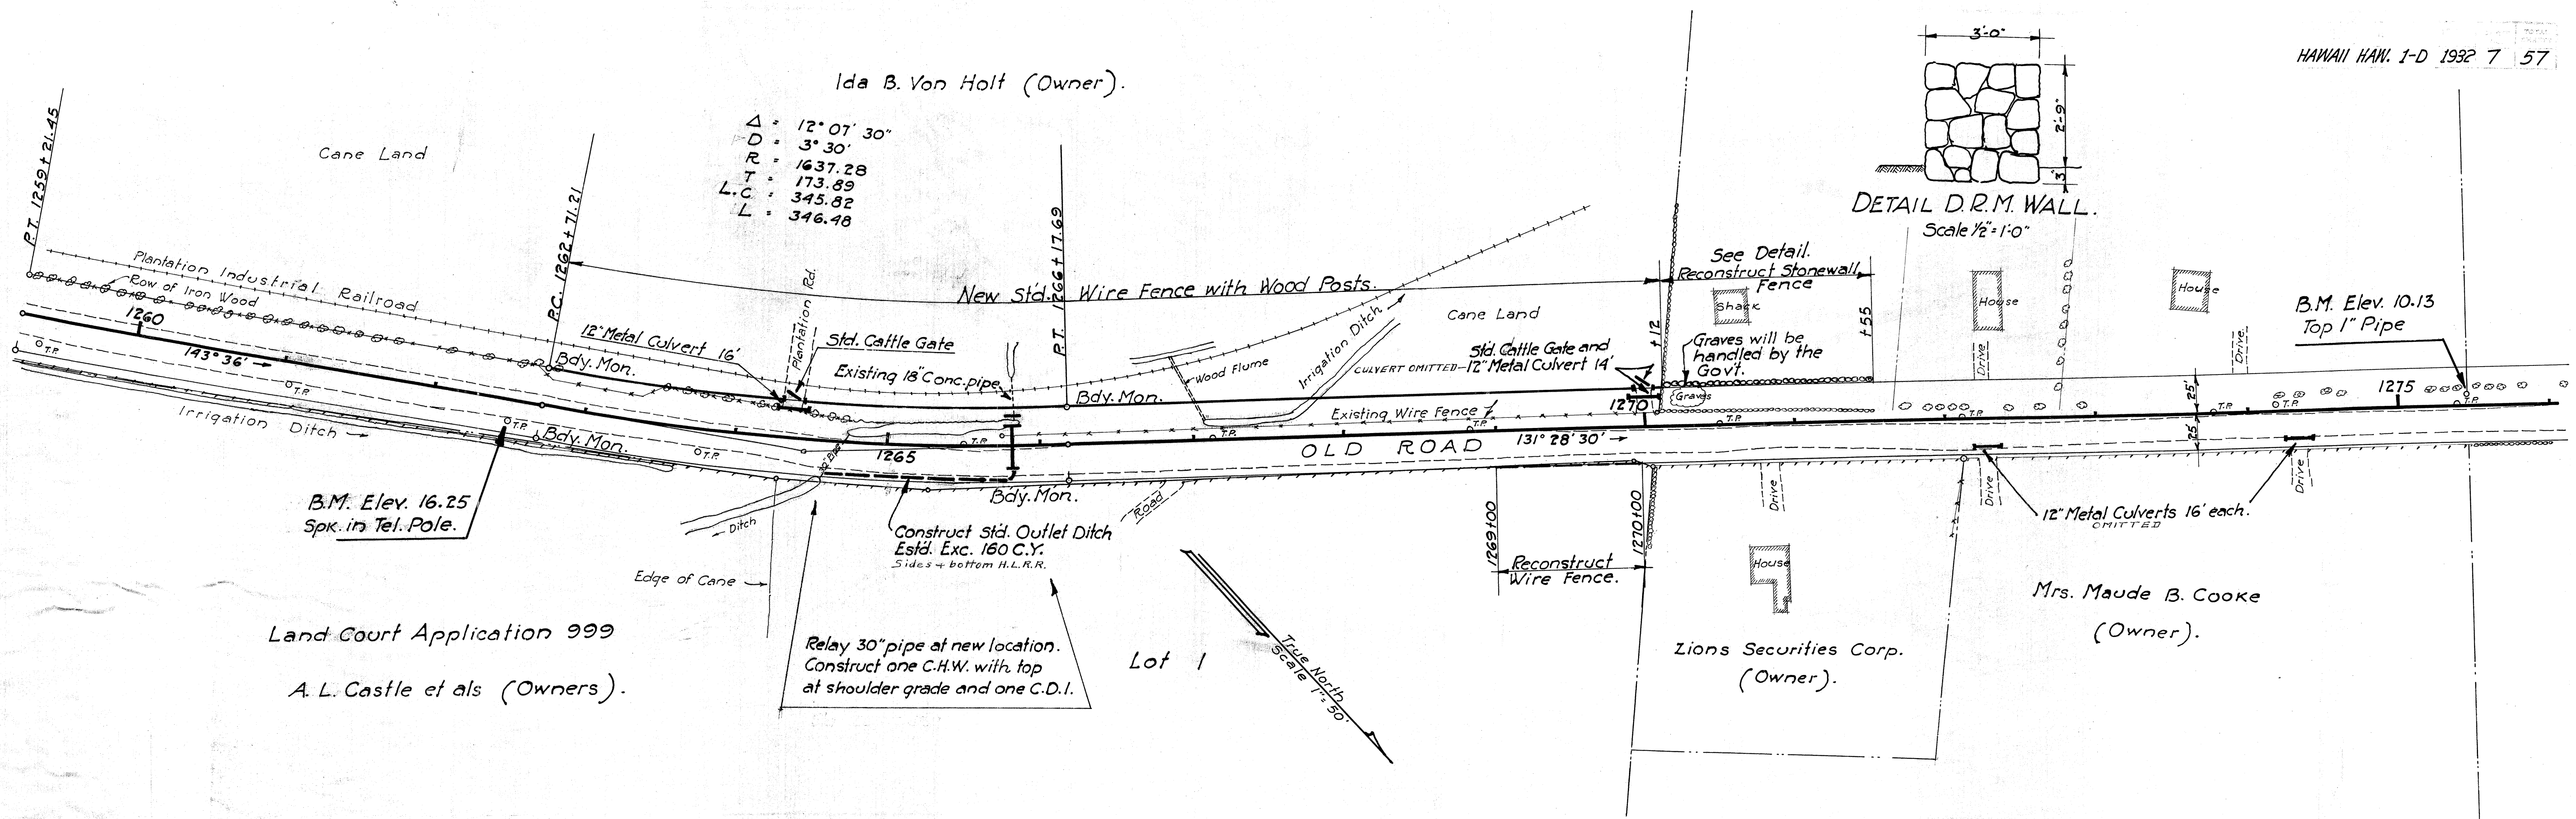


Land Court Application 999
A. L. Castle et als (Owners).


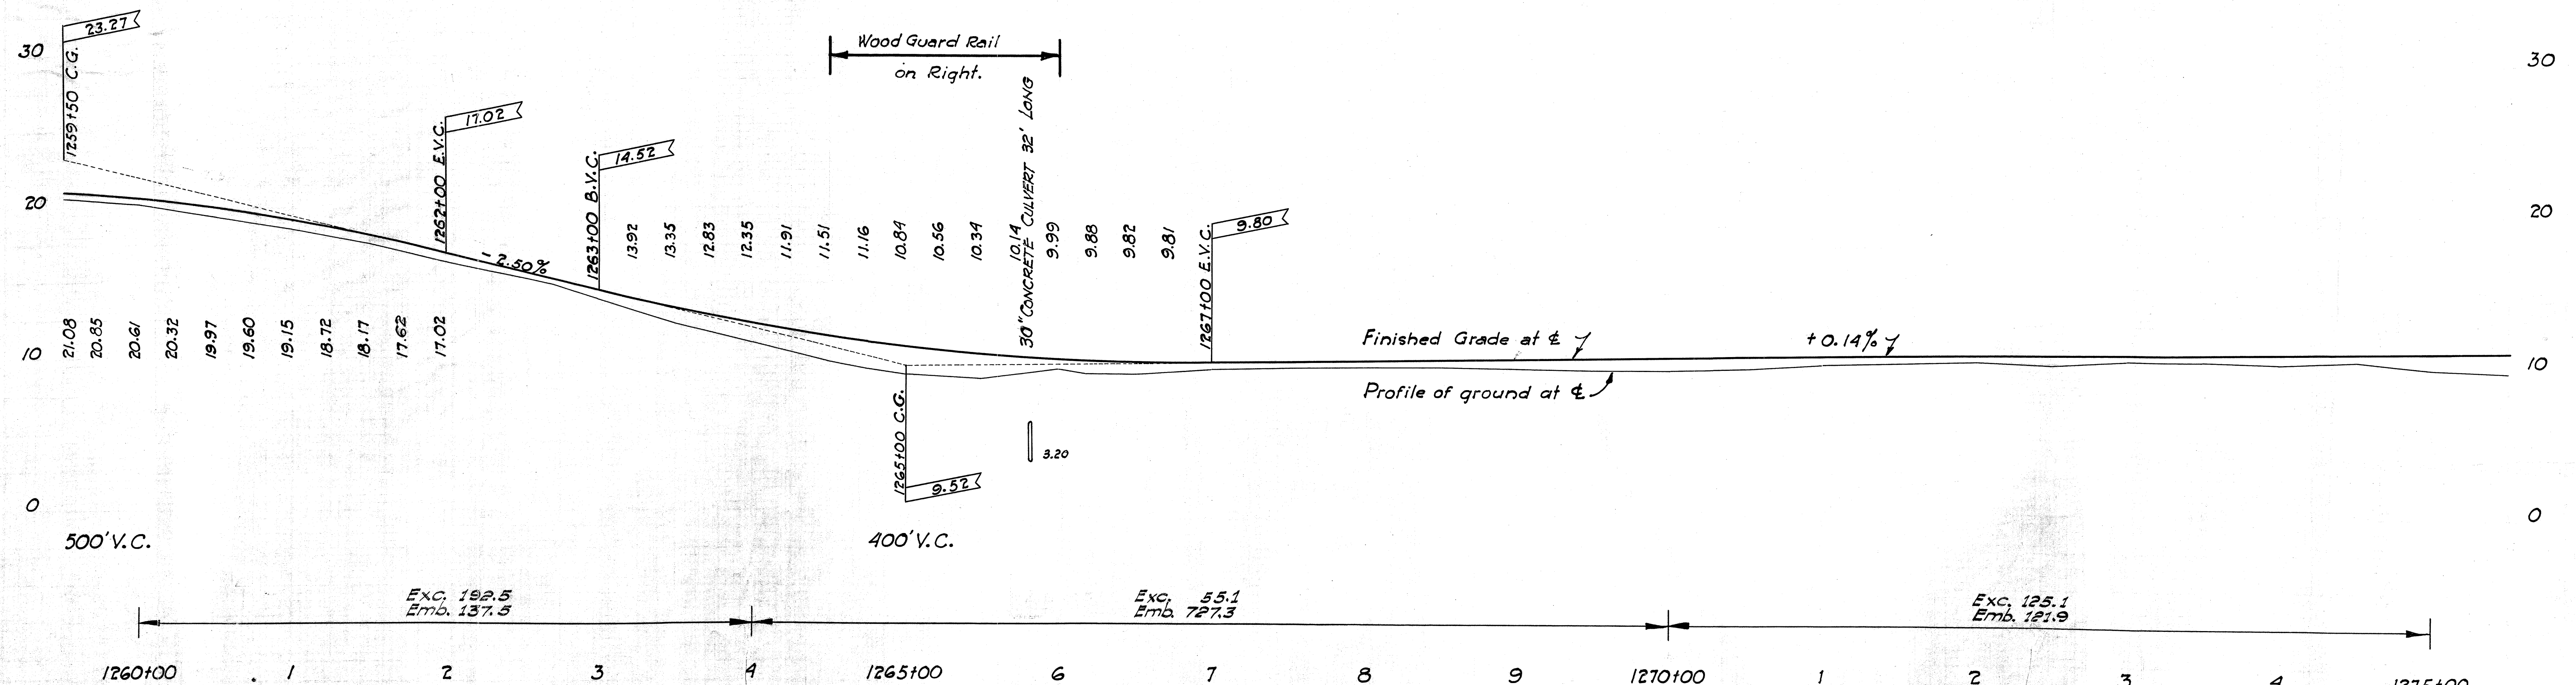


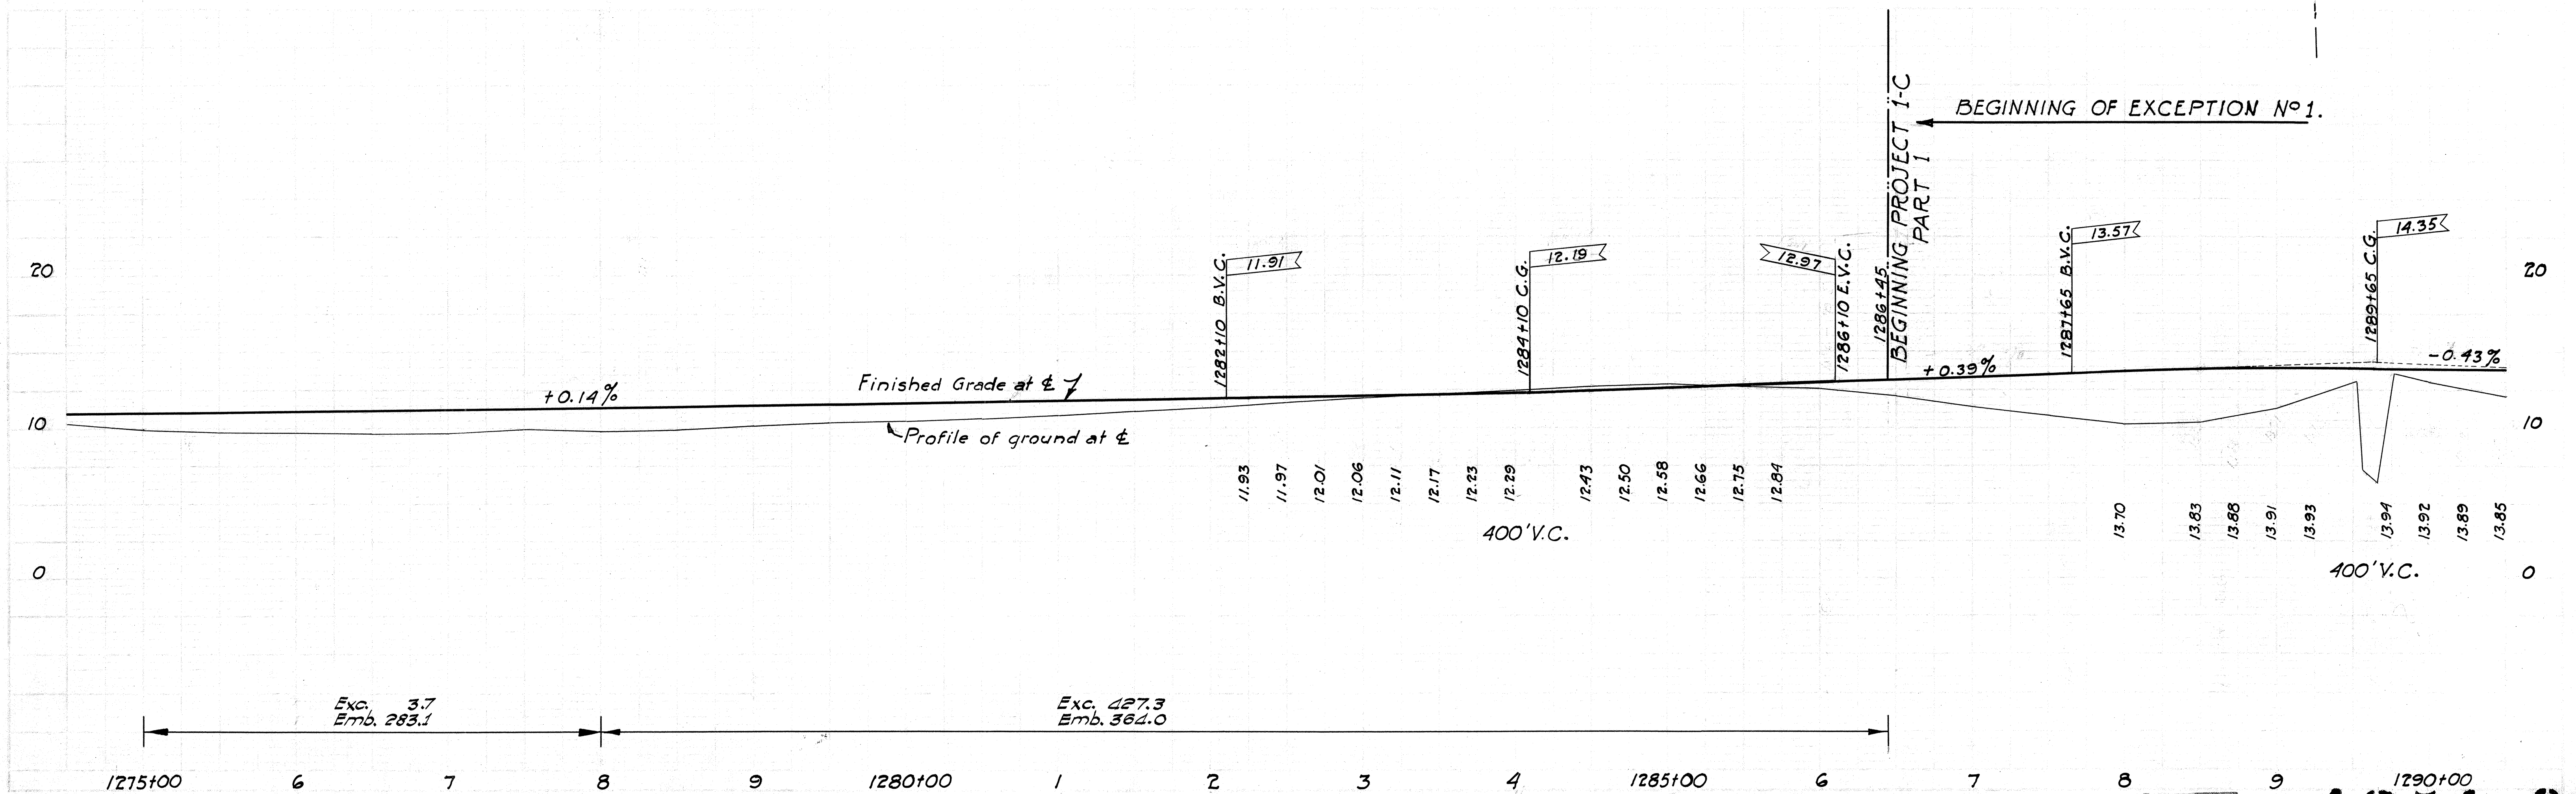
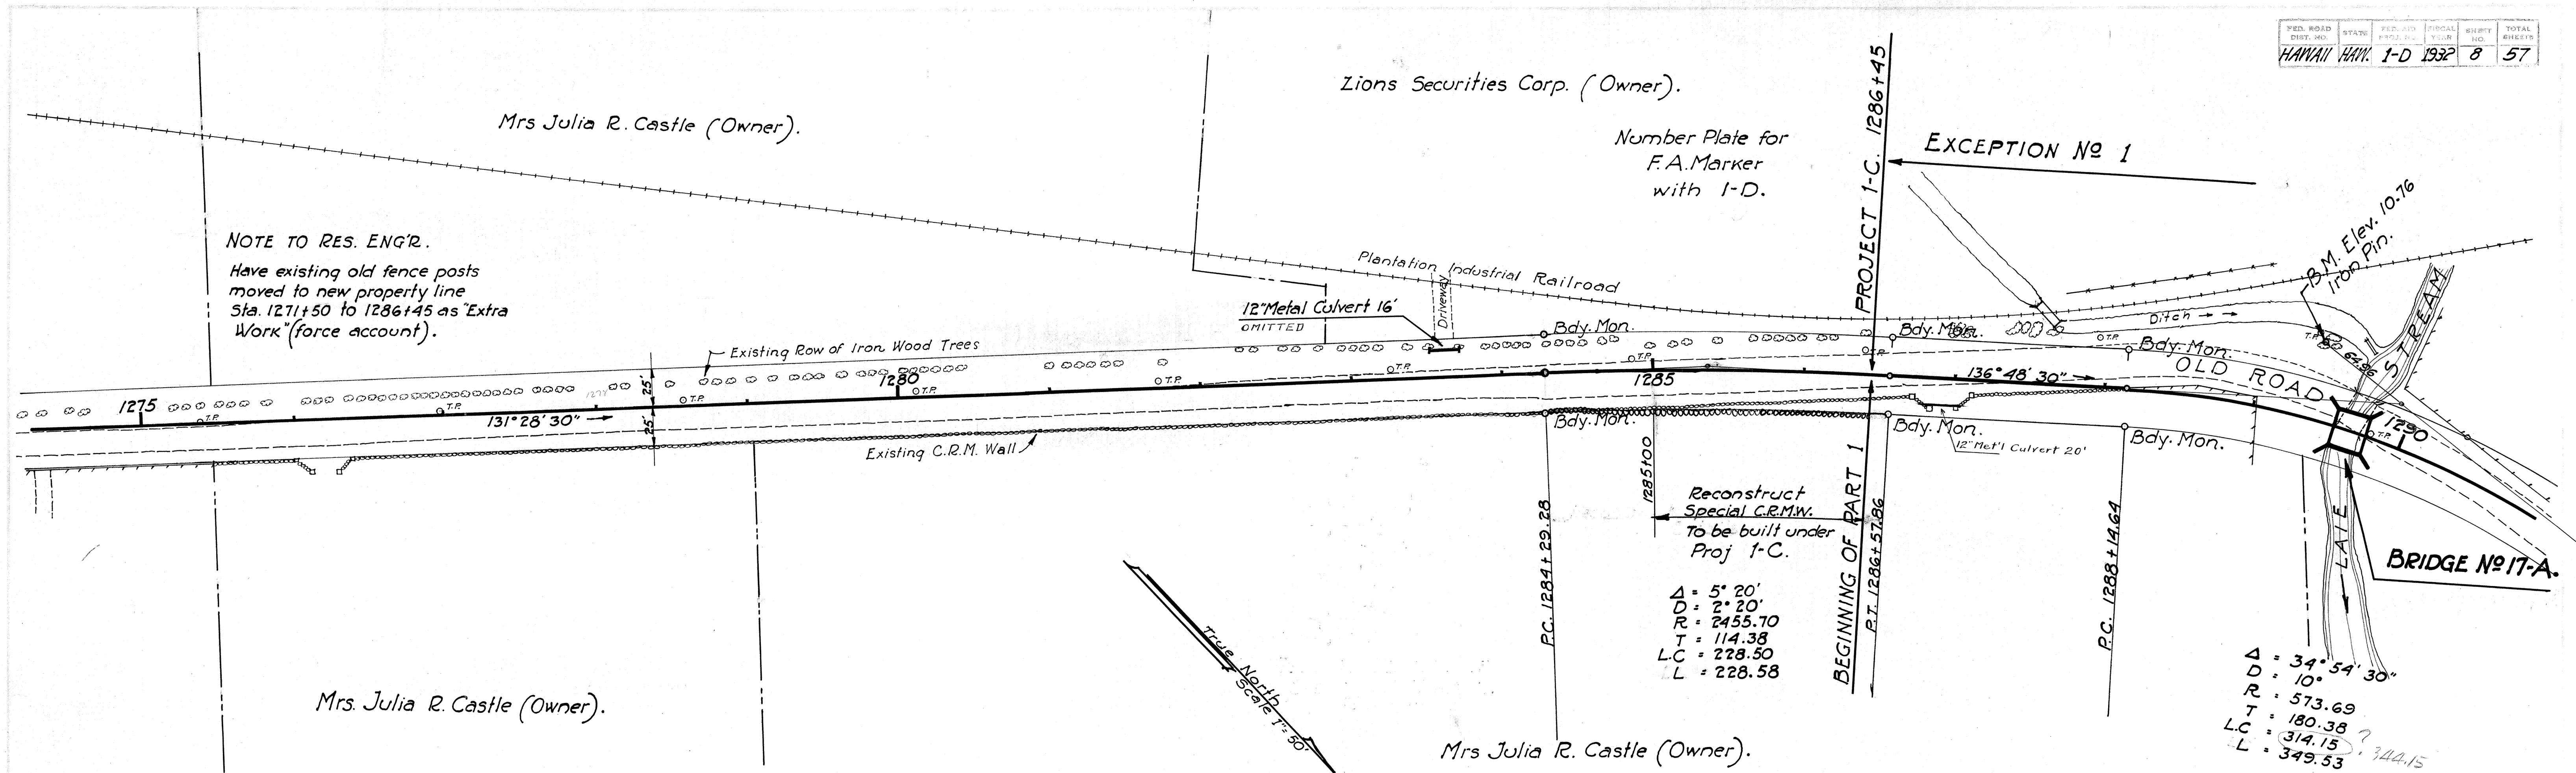


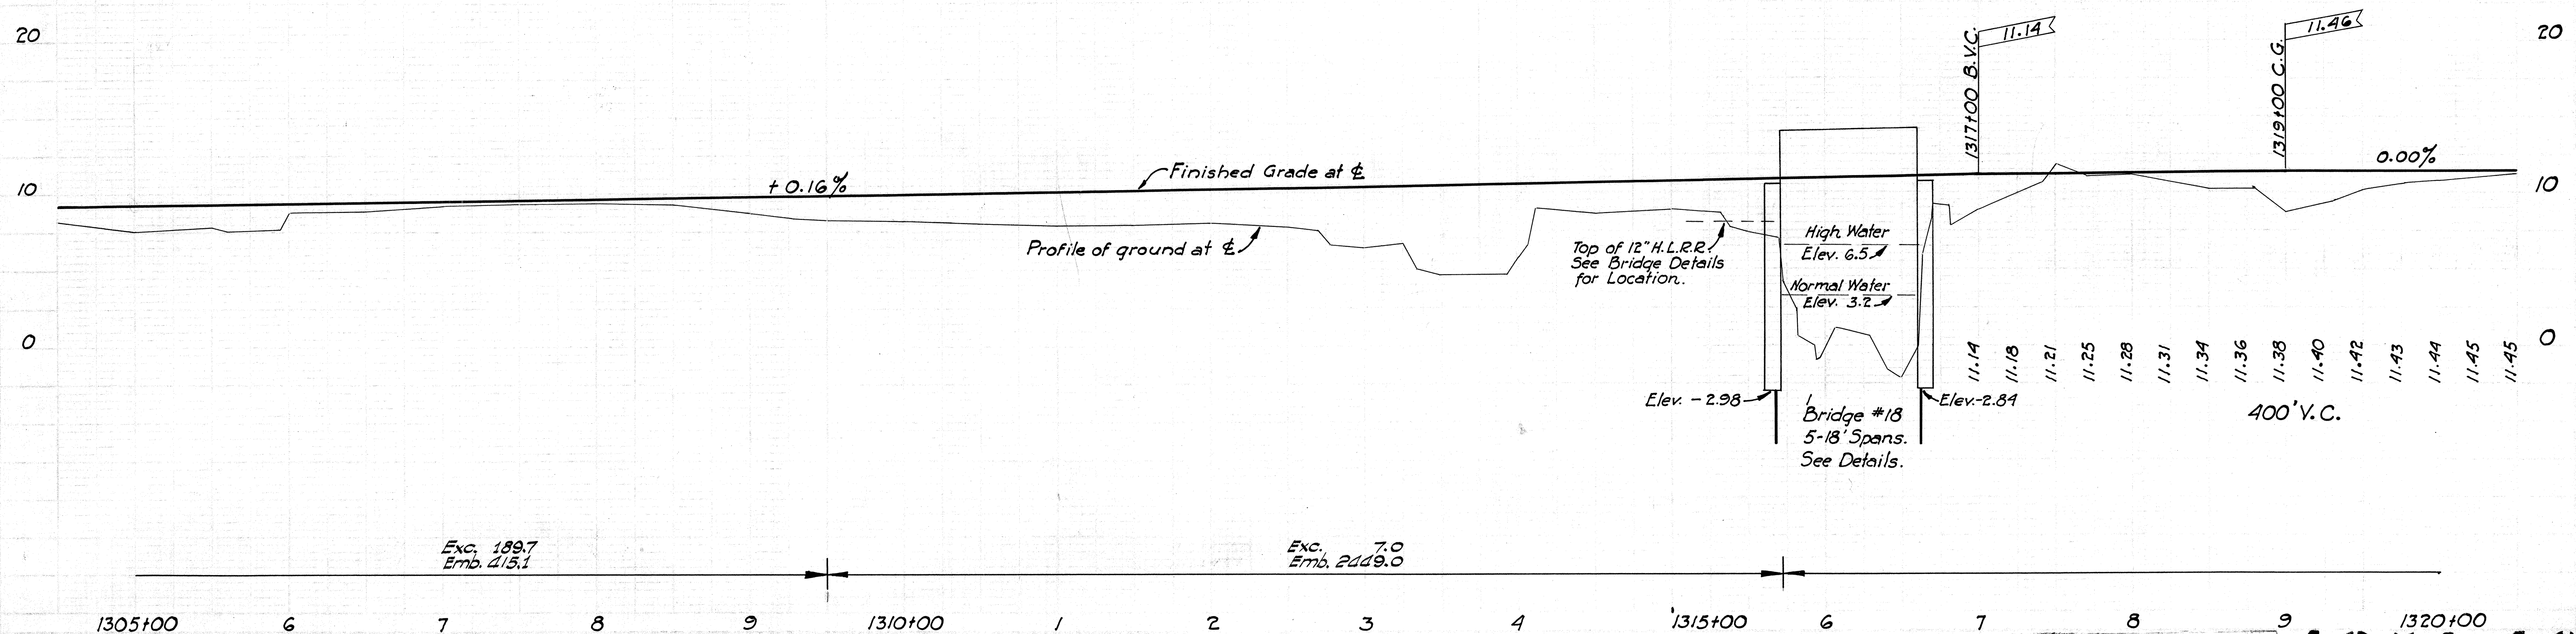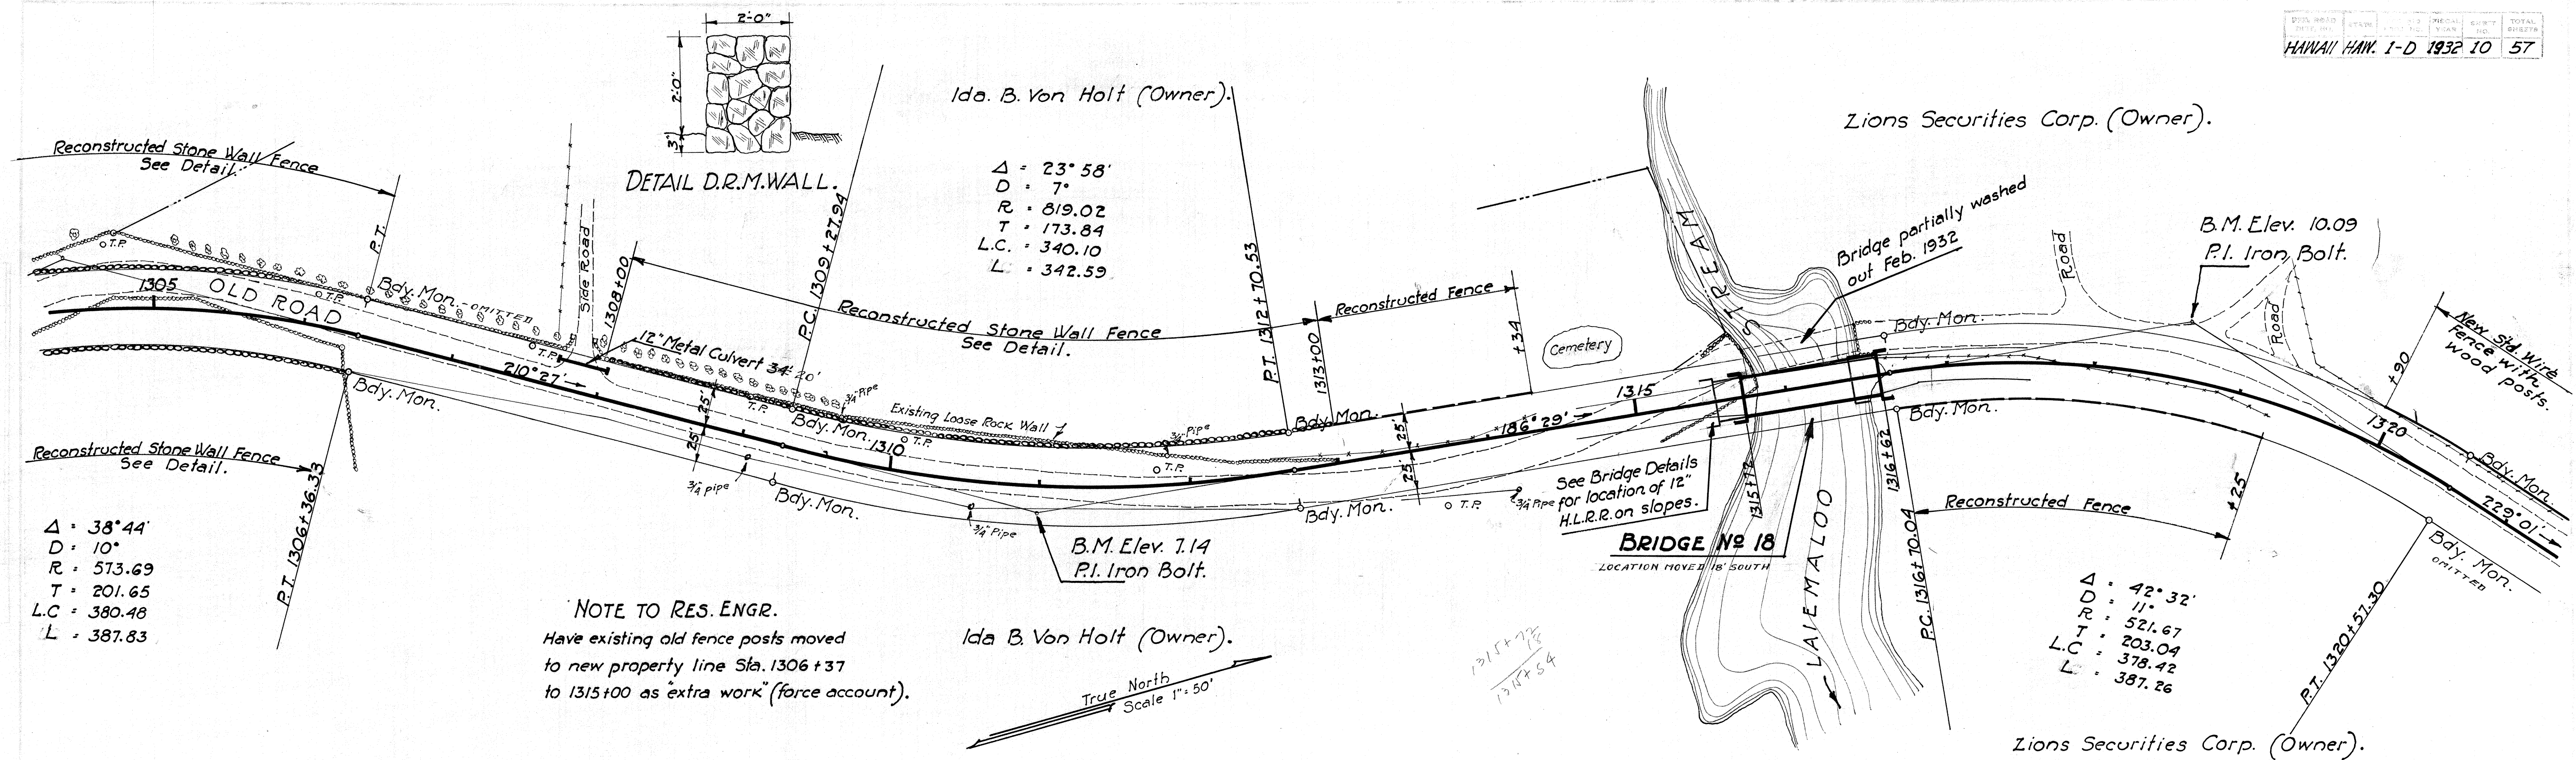


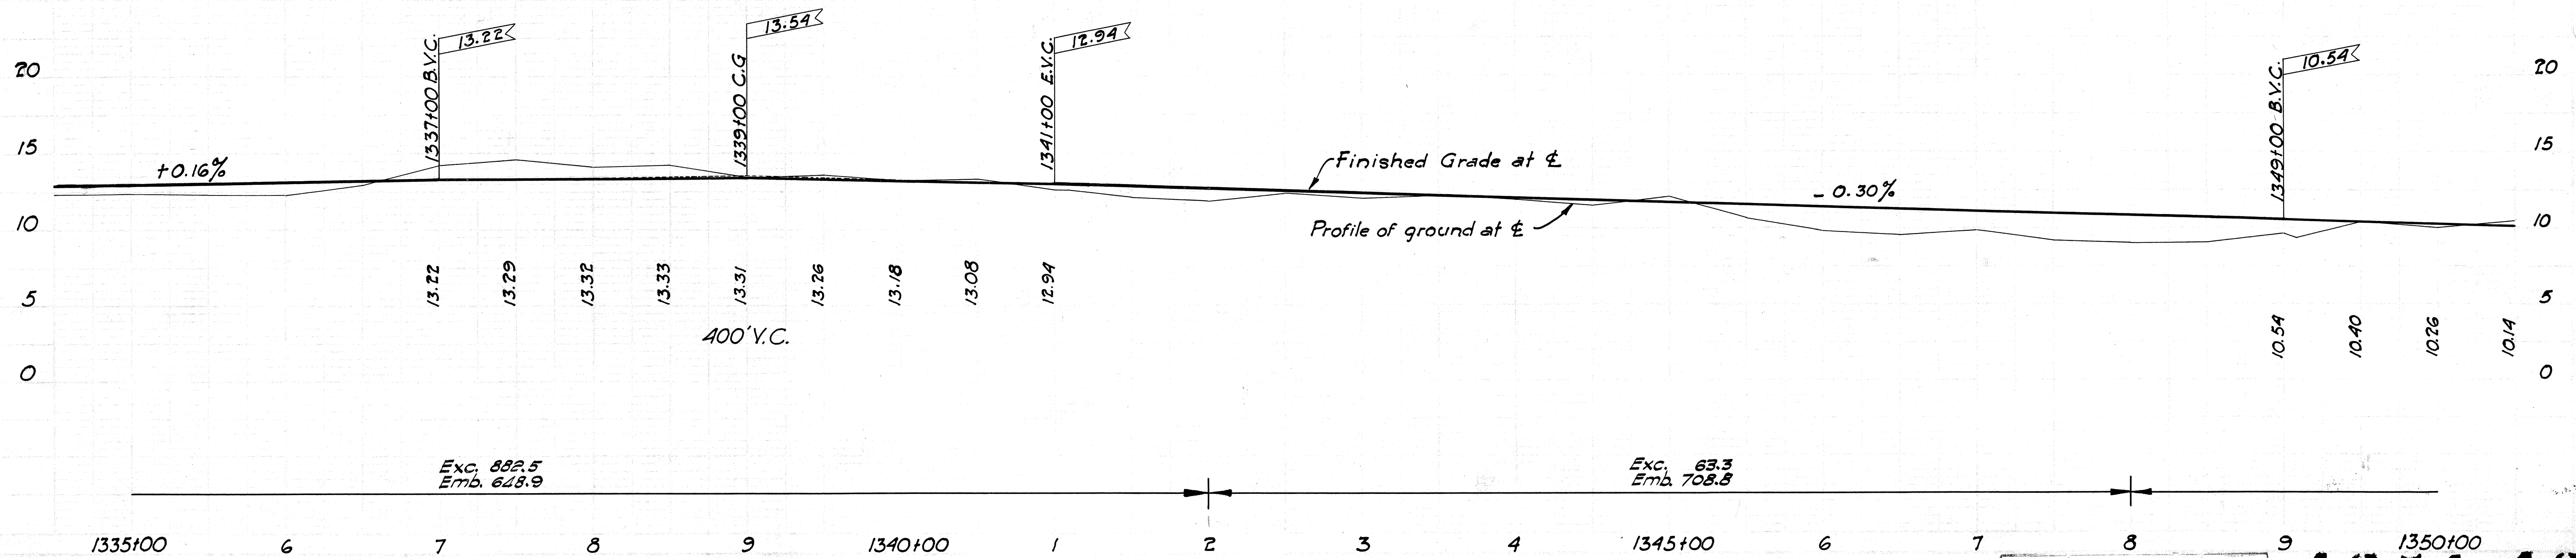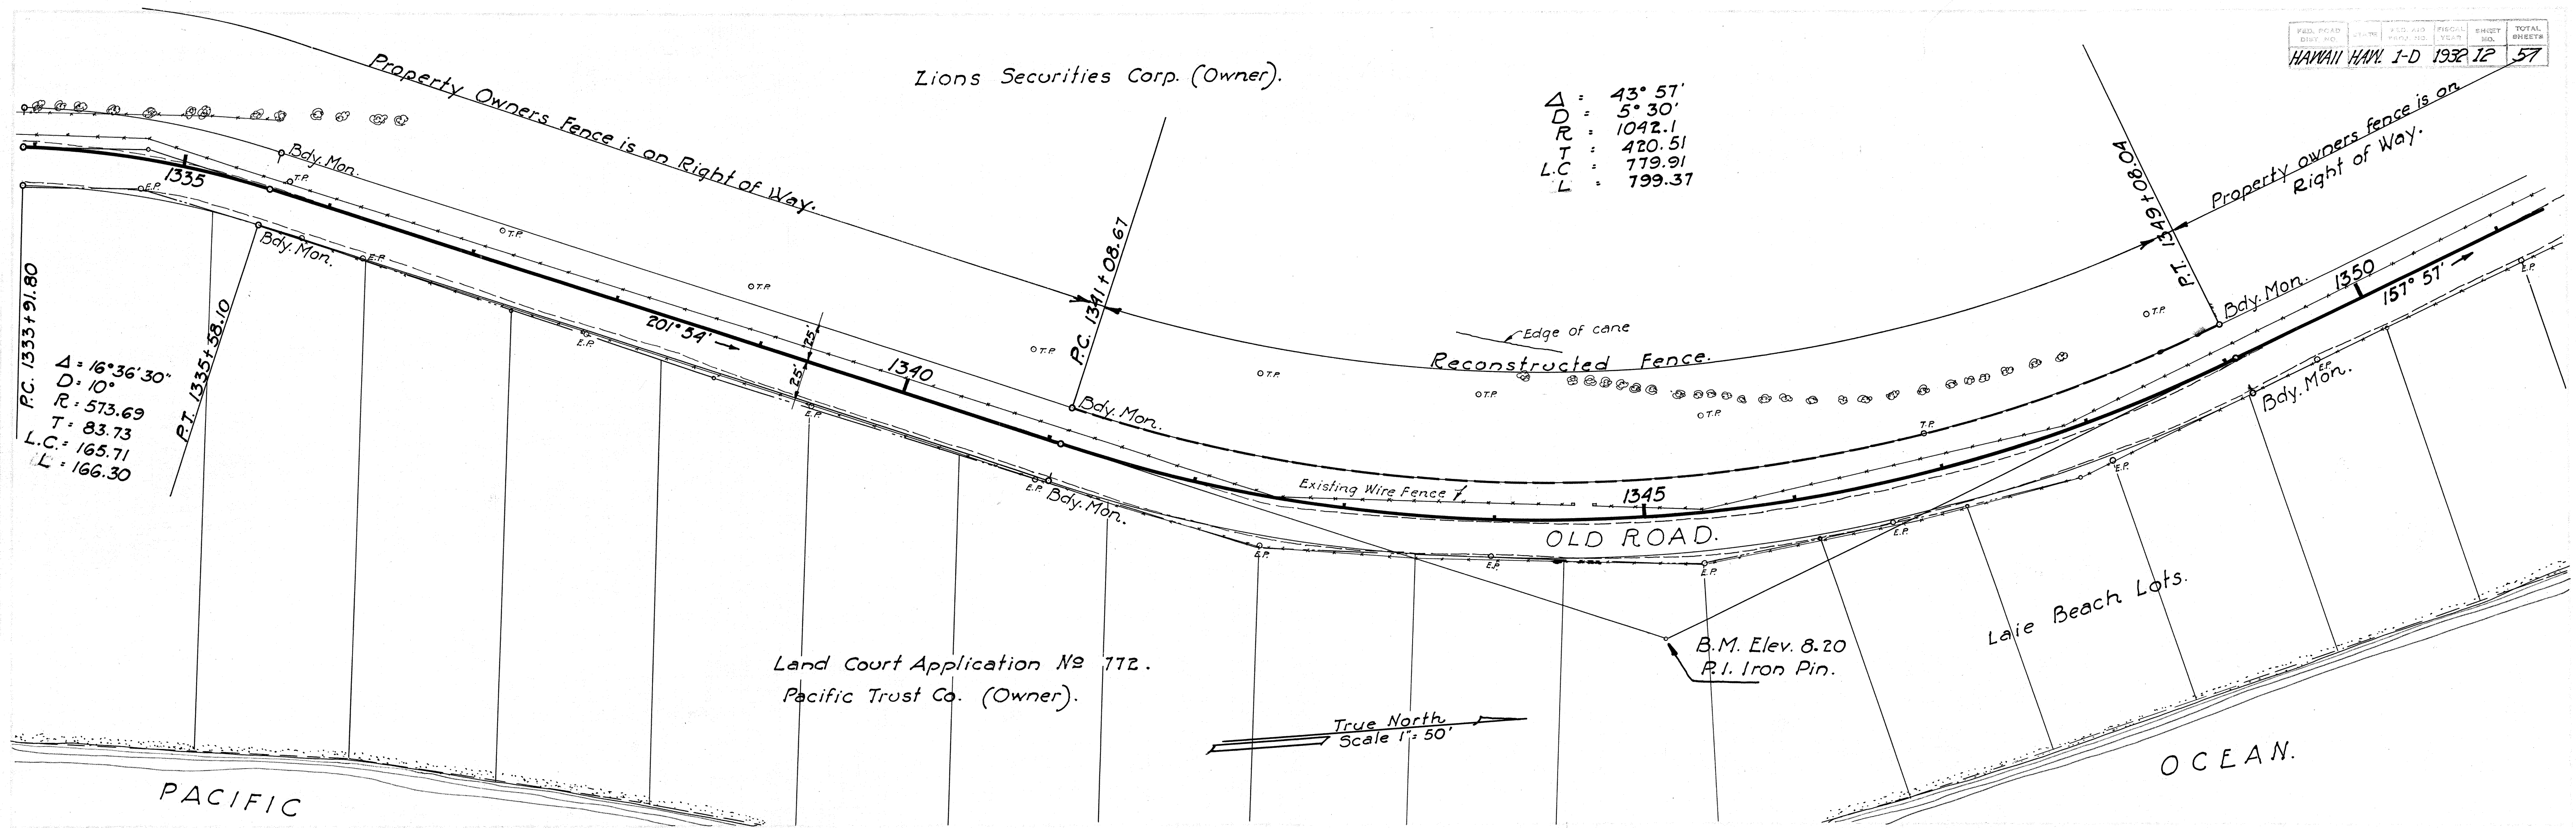

Zions Securities Corp. (Owner).

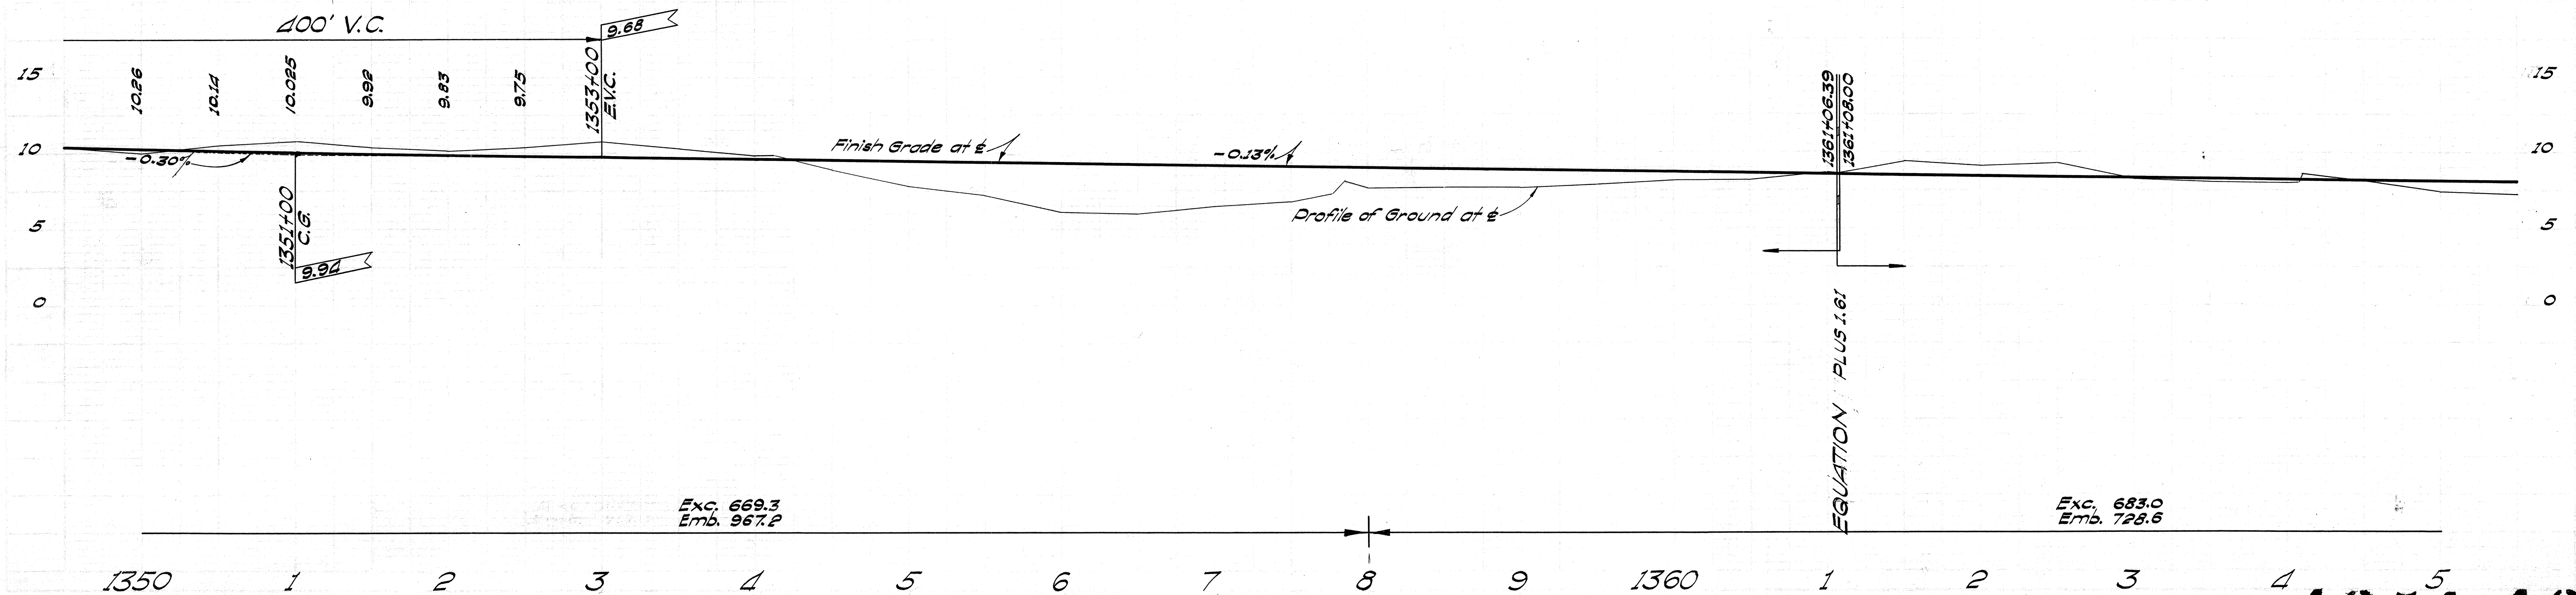
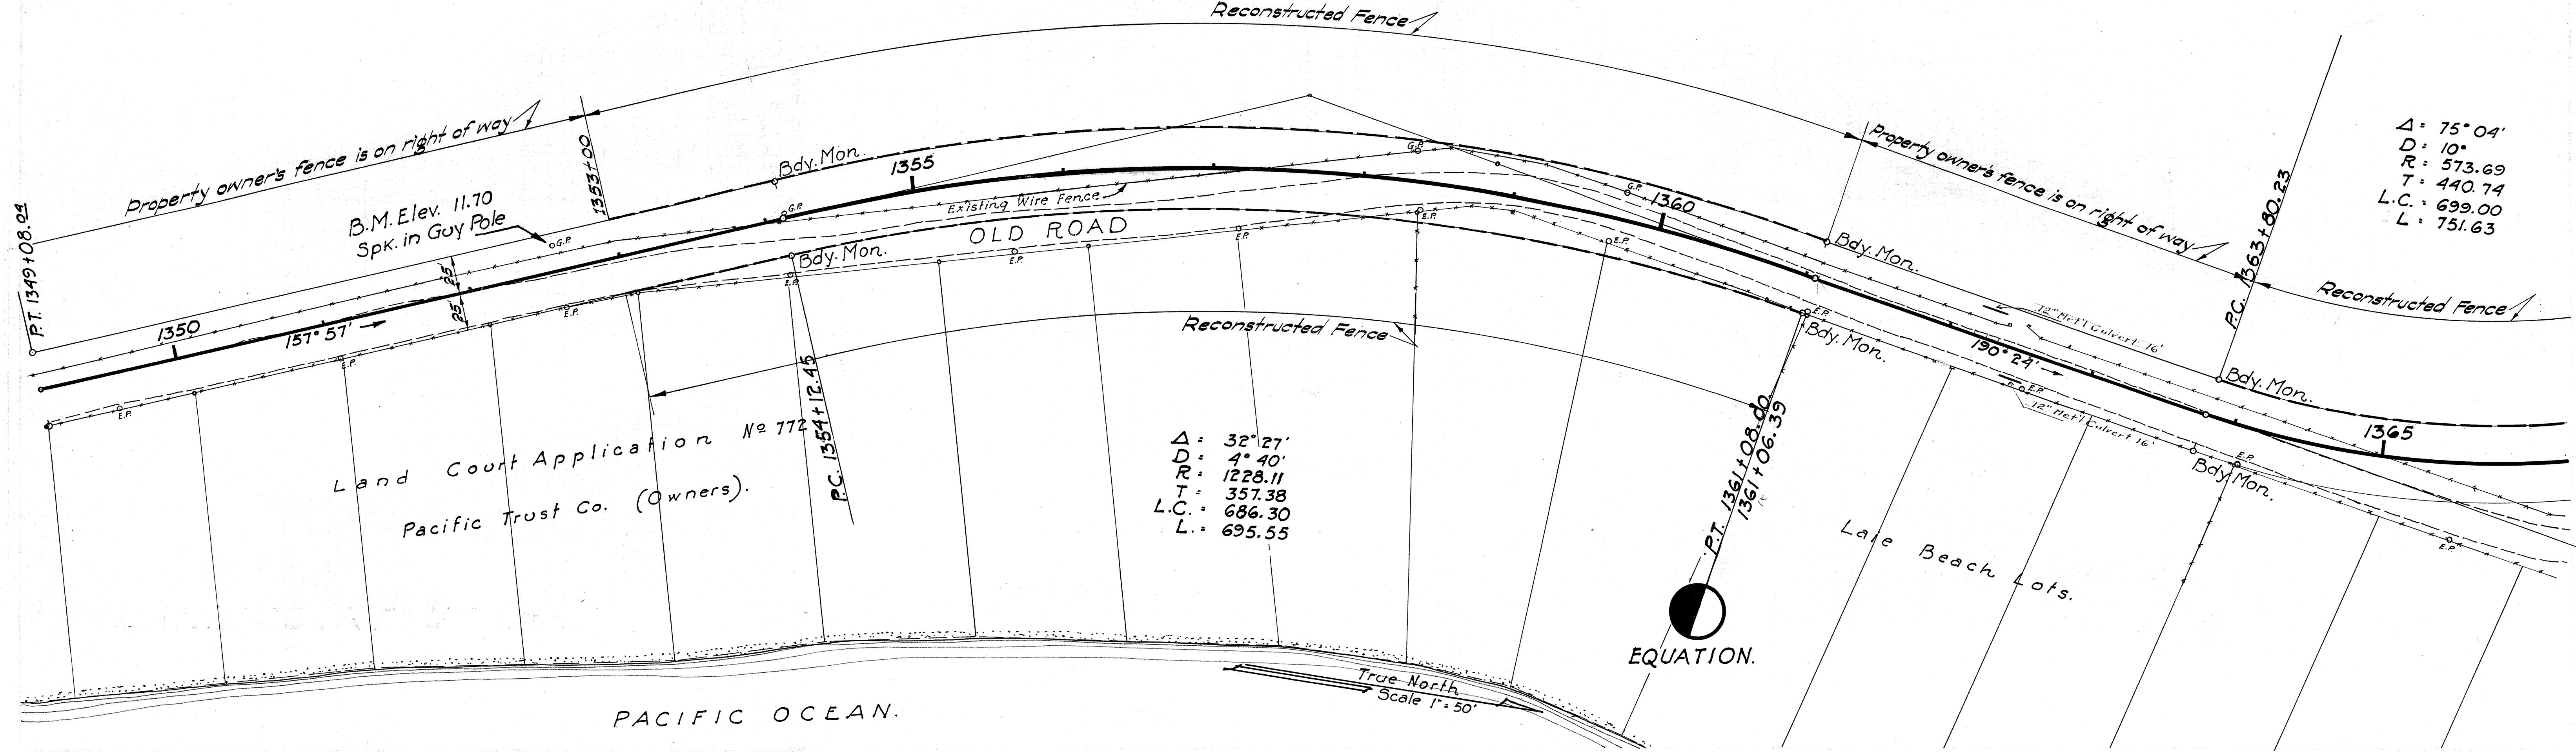


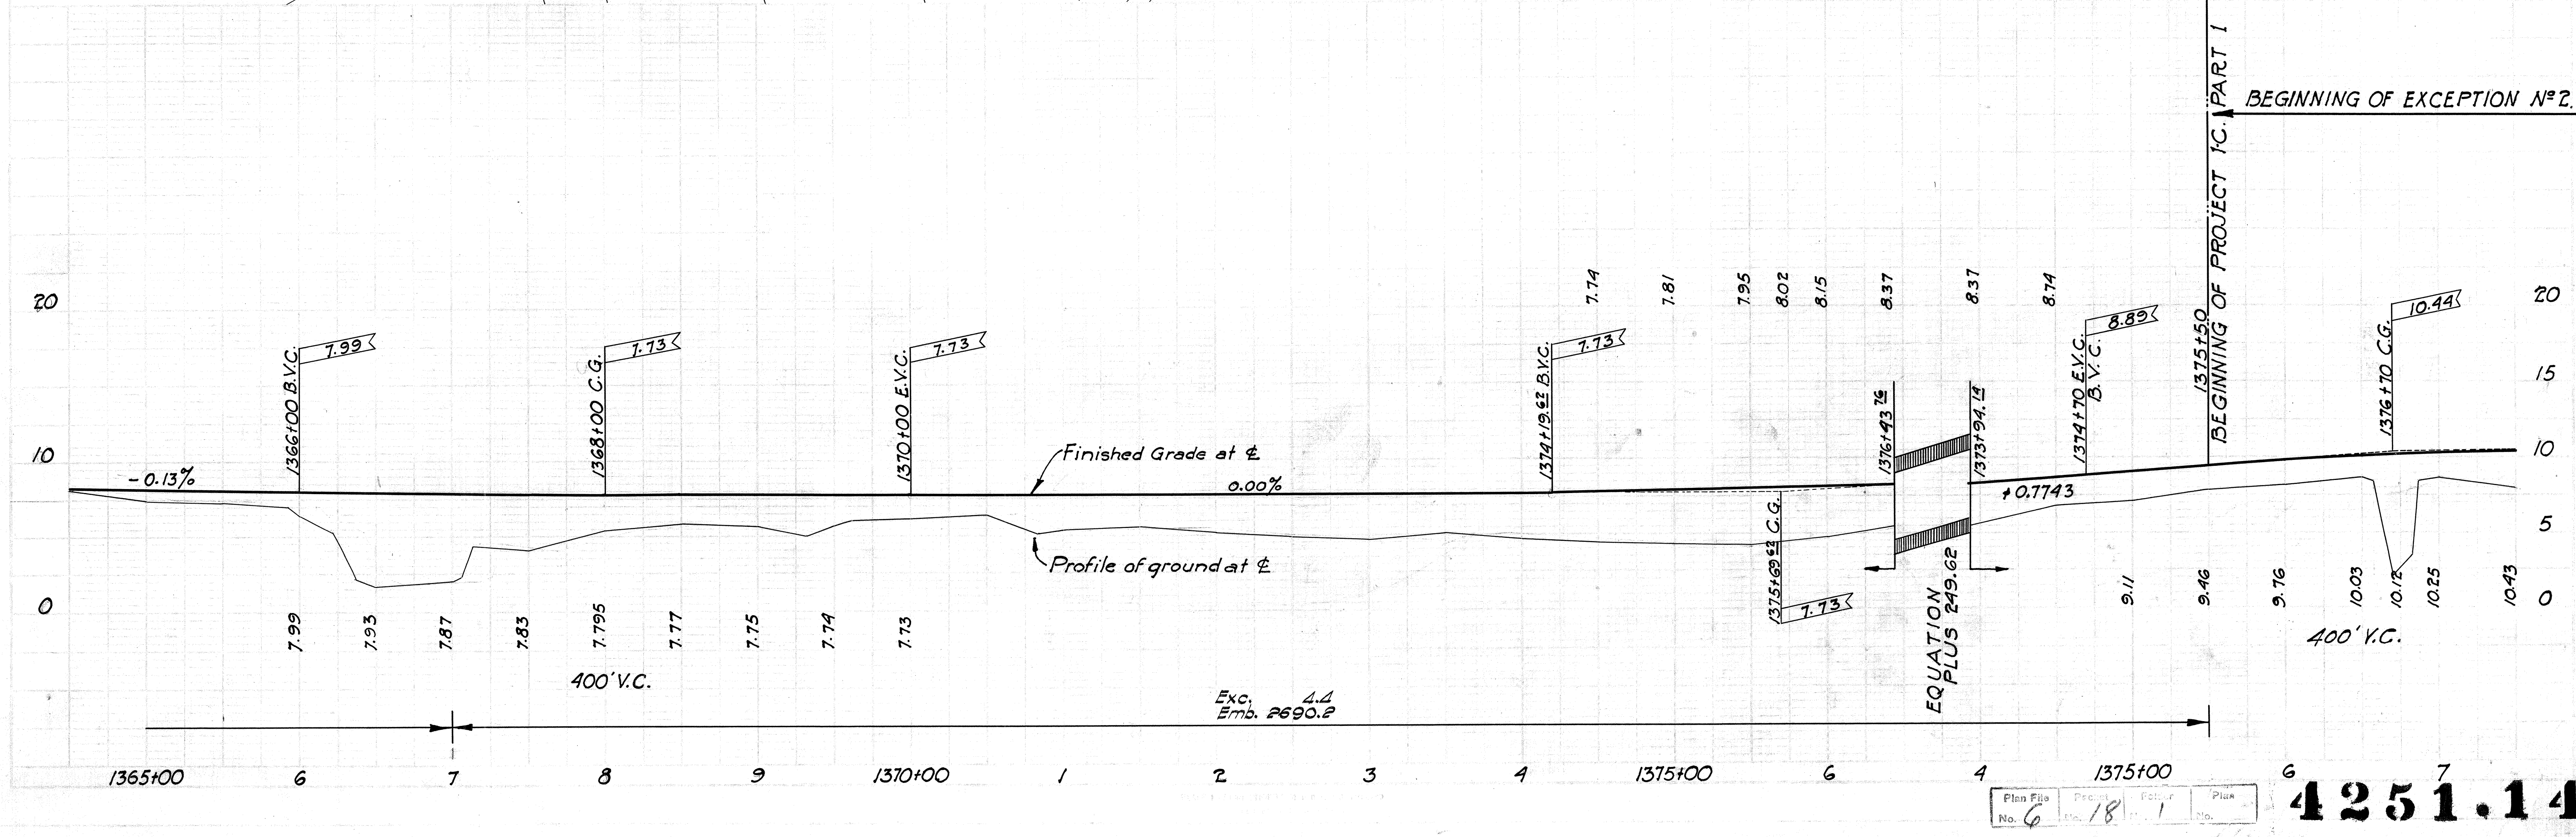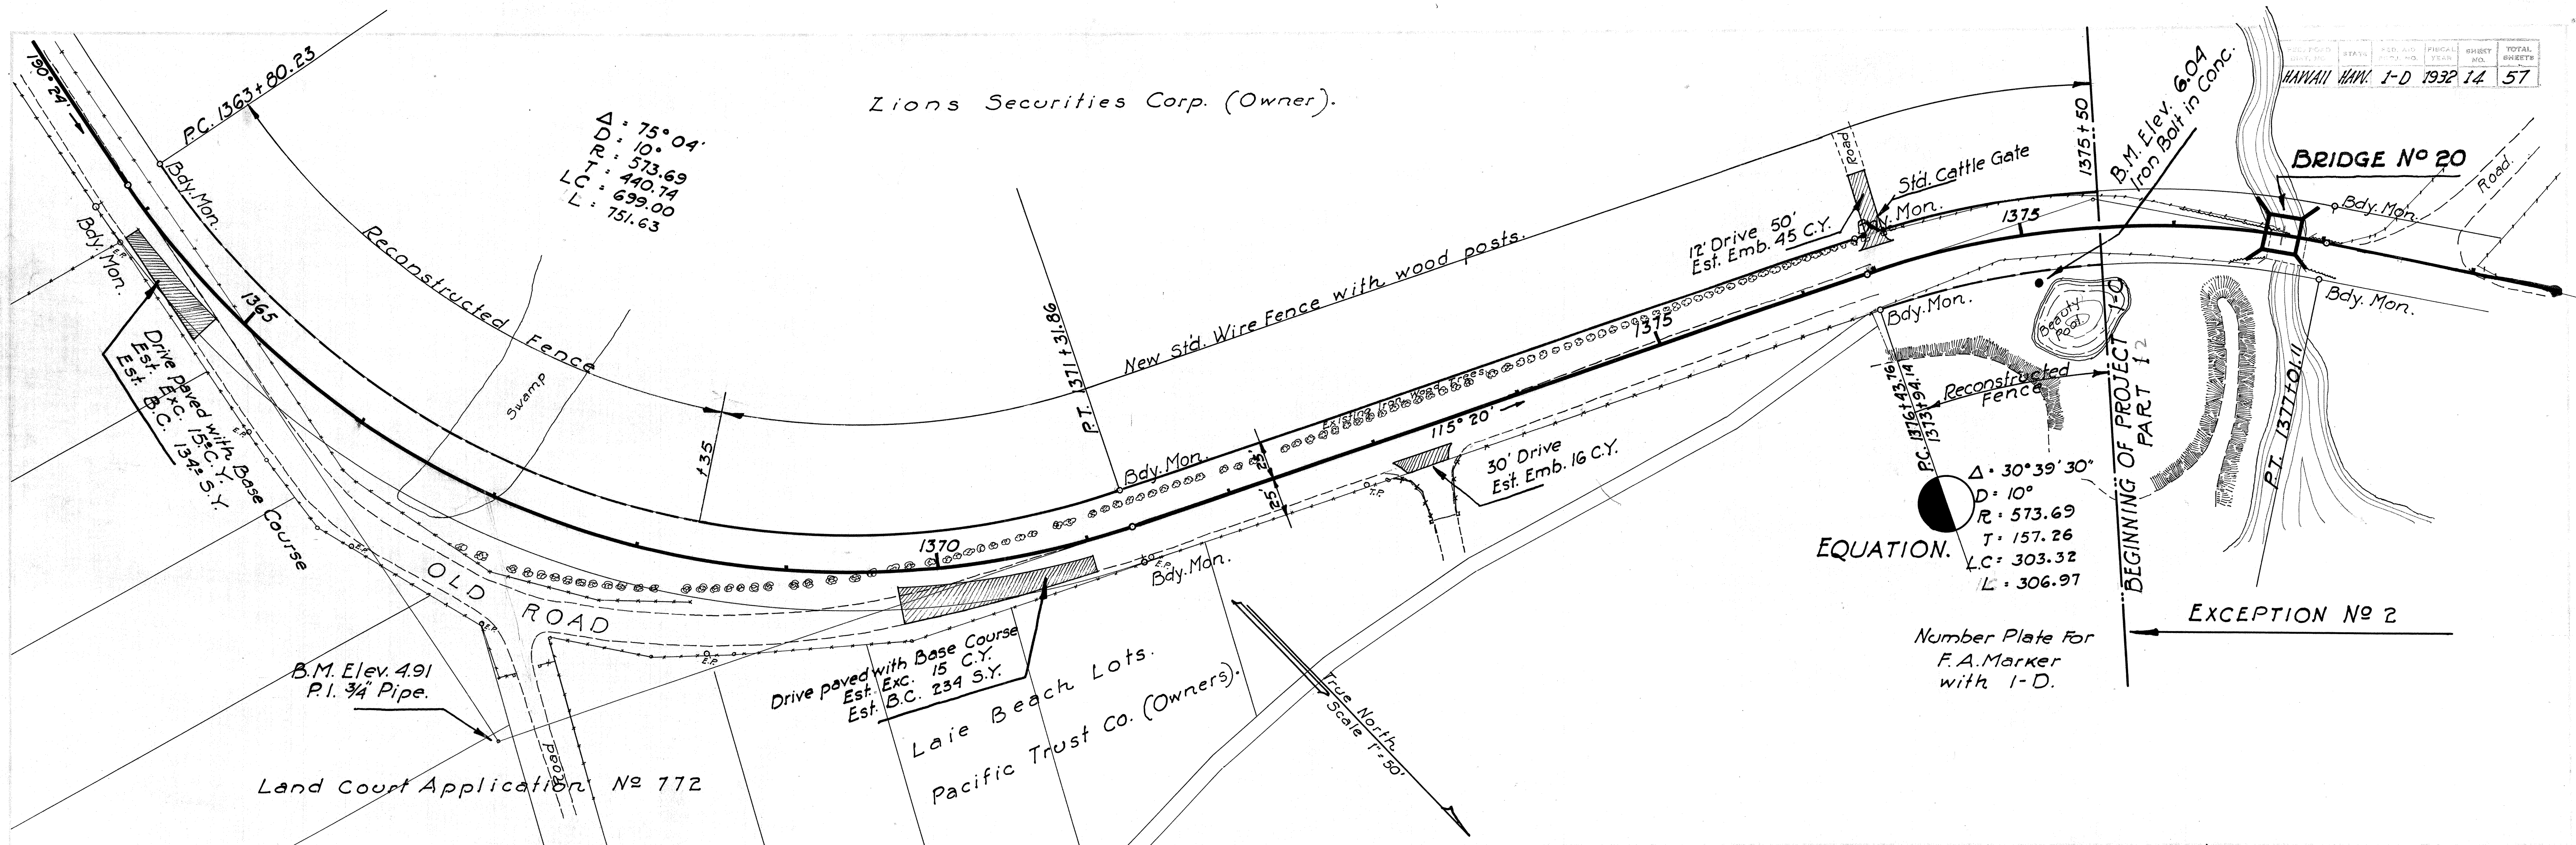

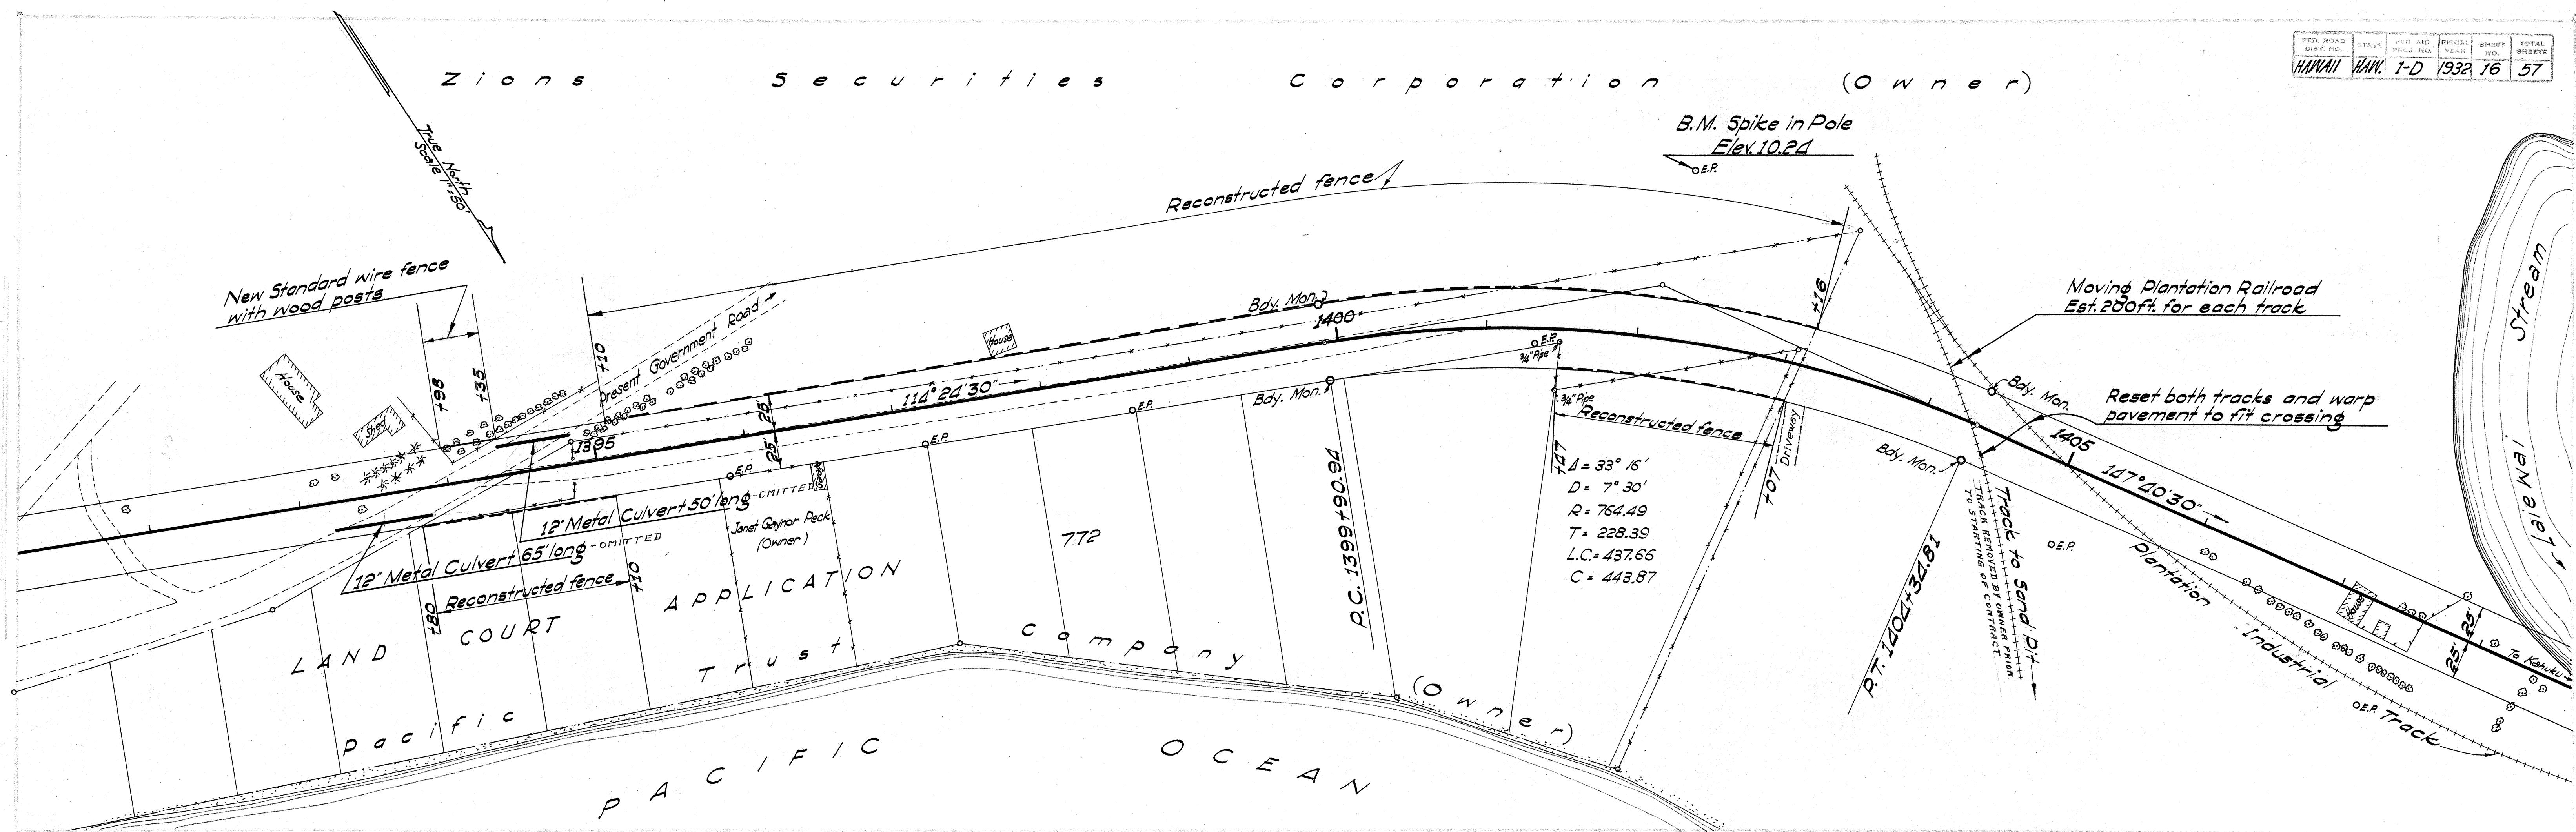


James Campbell Estate (Owner).

Note For Bureau of Public Roads
 Group A is to be constructed with \$880,000 fund.
 Group B is to be constructed with Terr. Fund and Federal Aid.
 All bridges are to be built with Terr. Fund and Federal Aid.

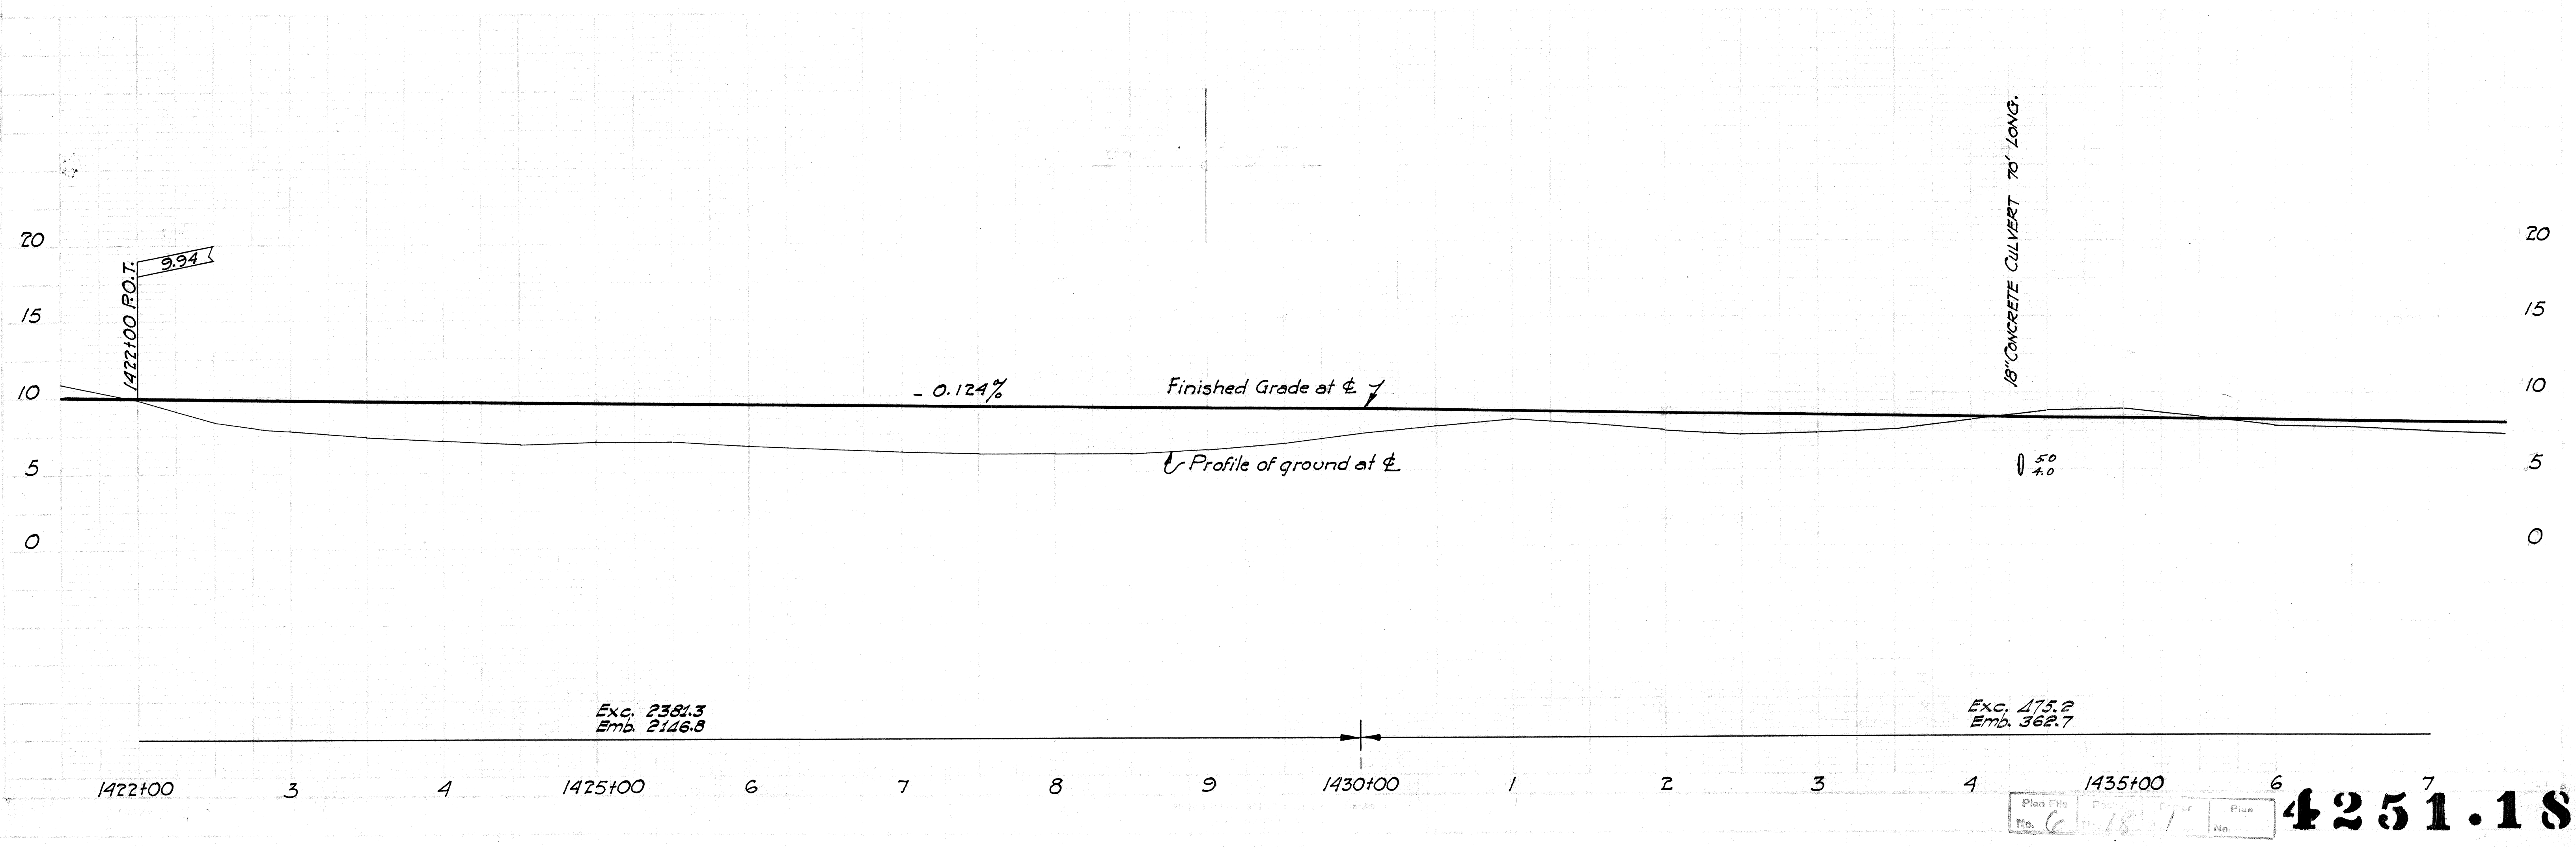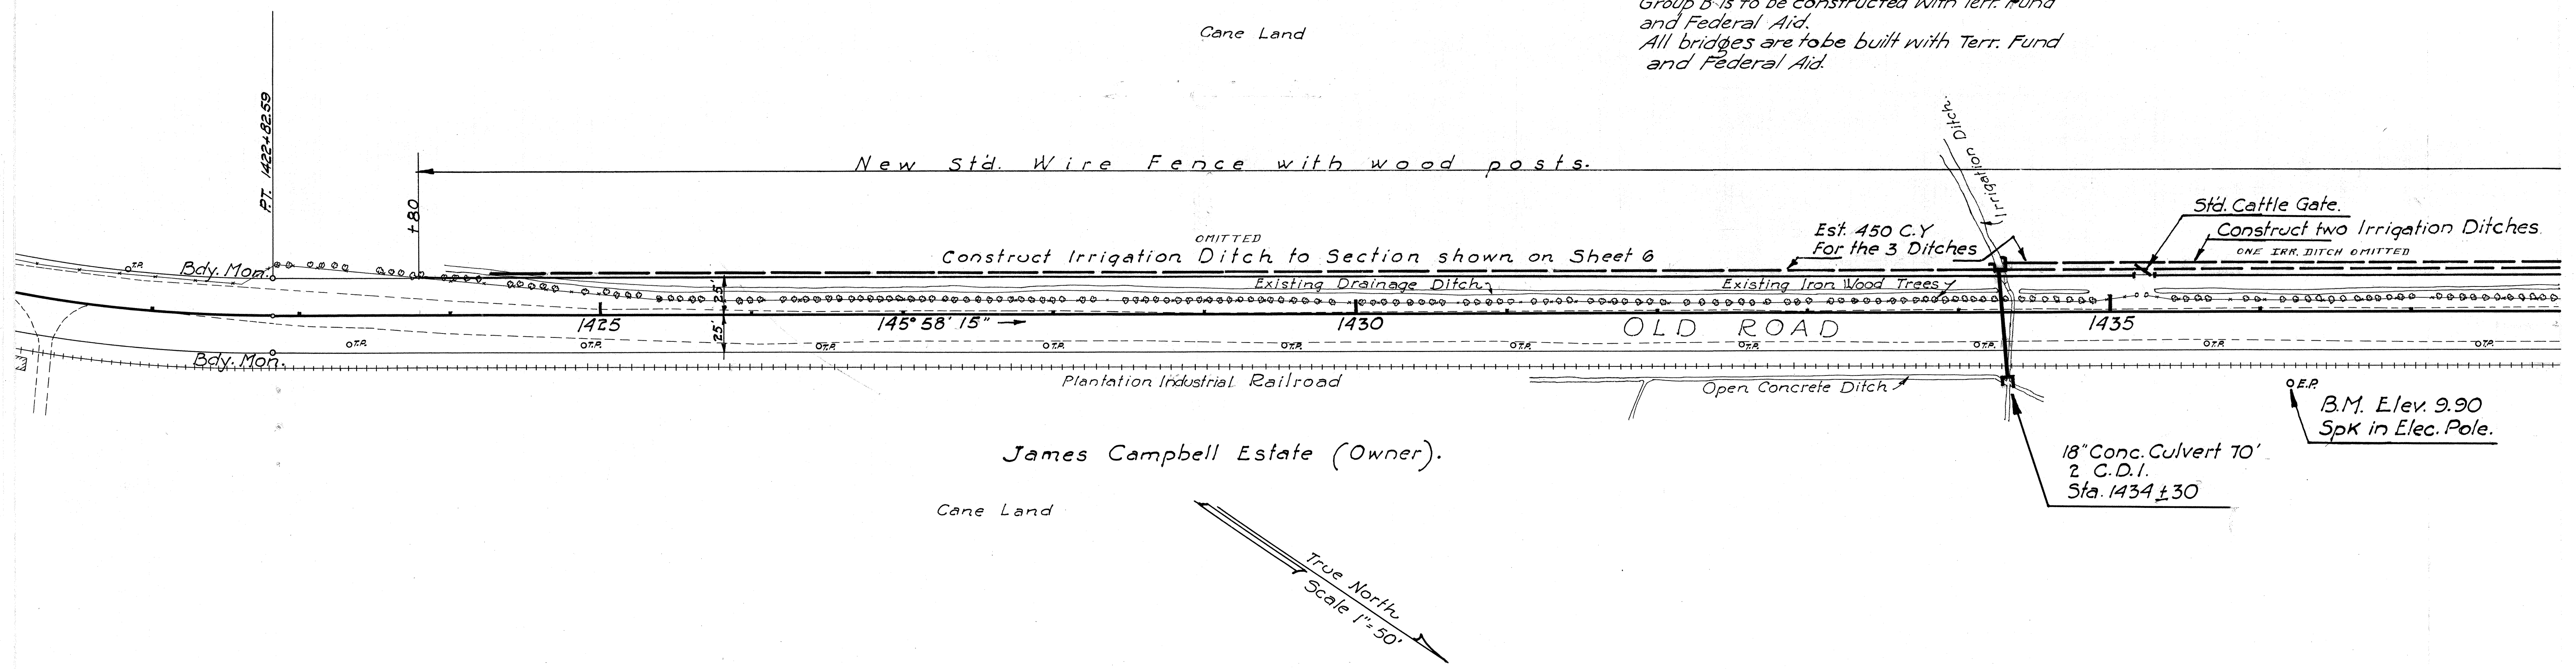


Cane Land.


James Campbell Estate (Owner).

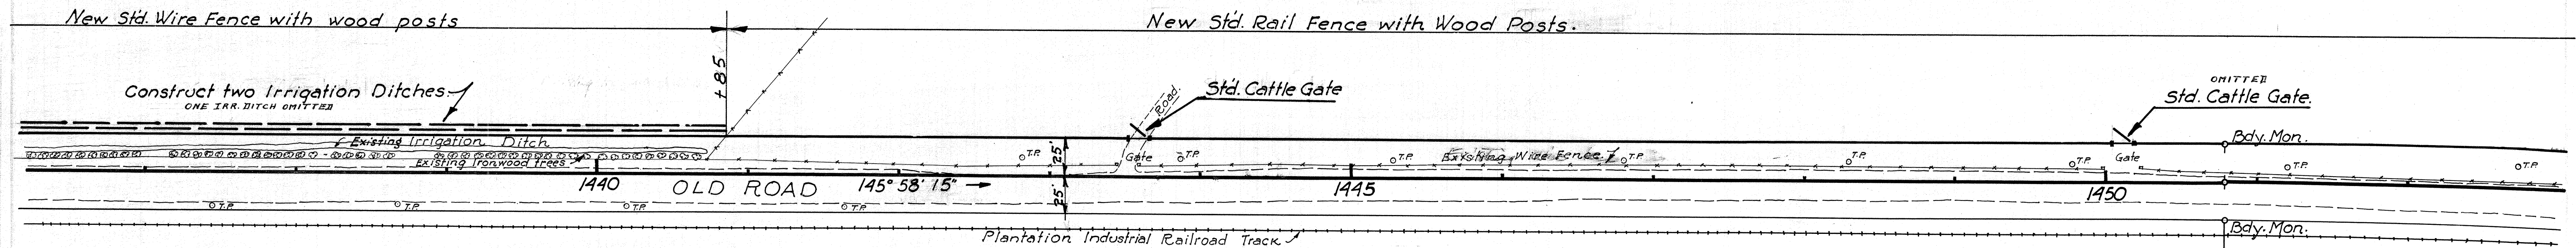



James Campbell Estate (Owner).

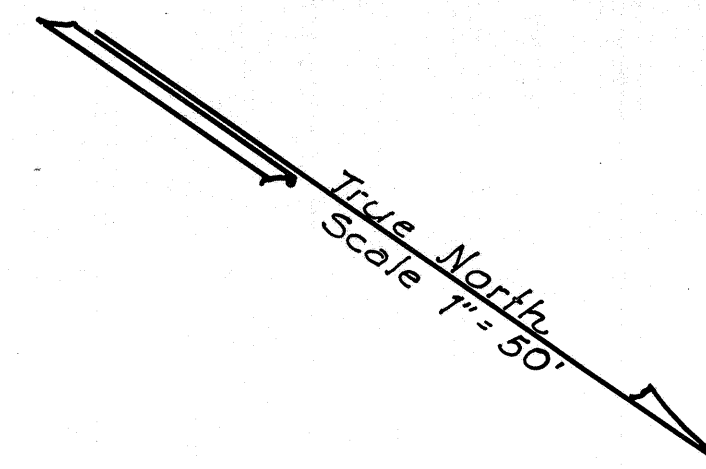

$\Delta = 6^{\circ}02'15''$
 $D = 1^{\circ}00'$
 $R = 5729.16$
 $T = 302.16$
 $L.C. = 603.48$
 $L = 603.76$

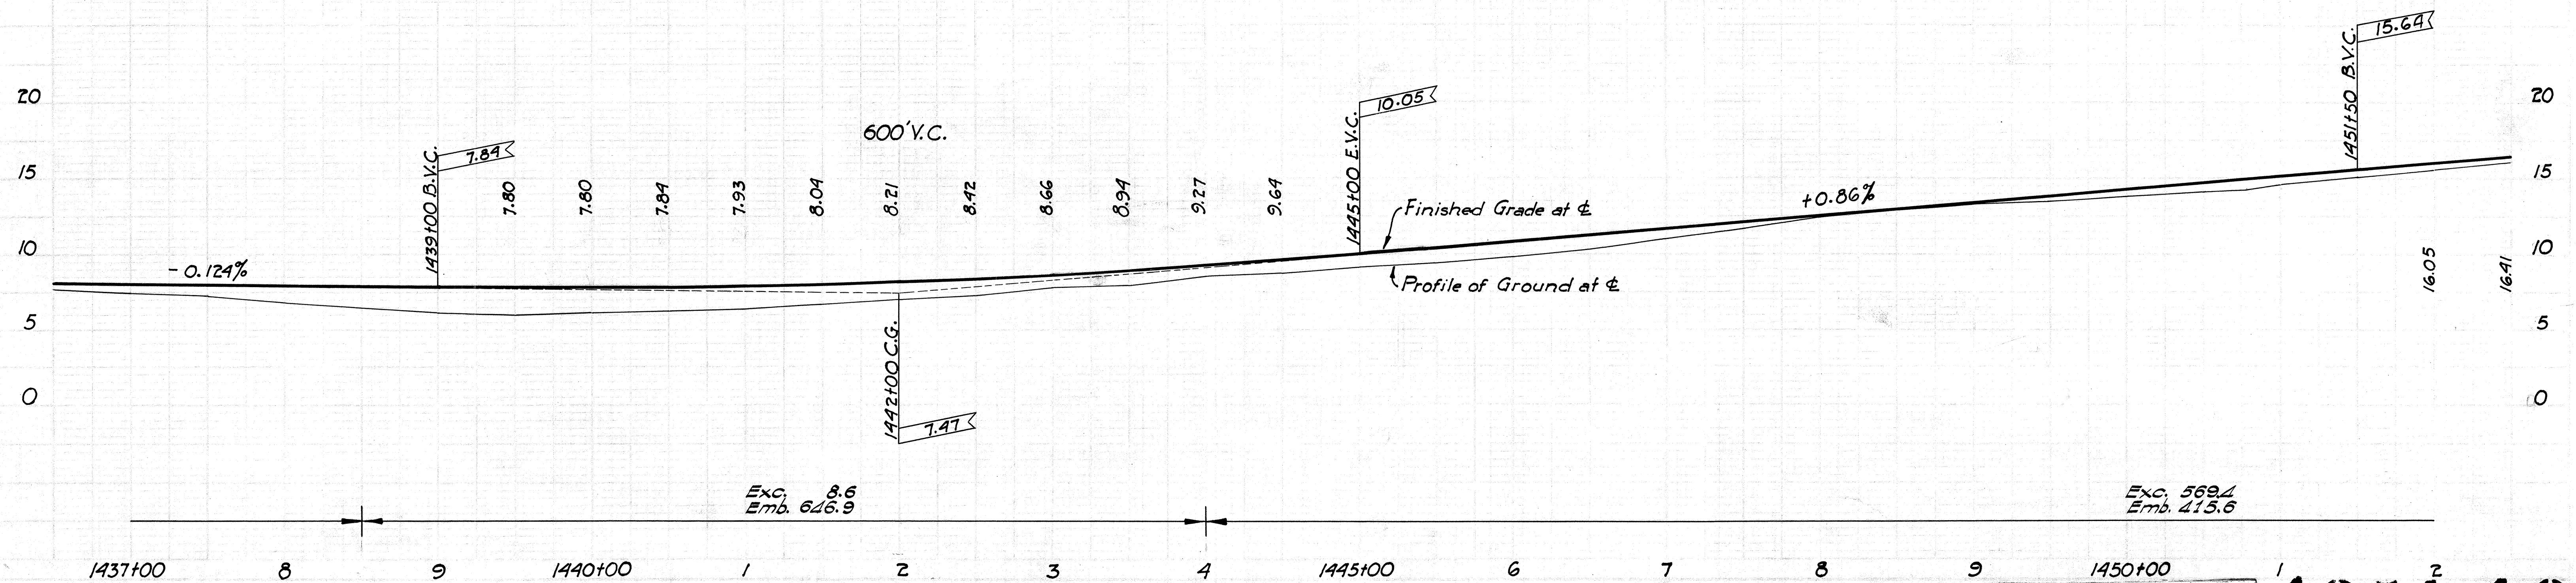


Revised 6/30/33

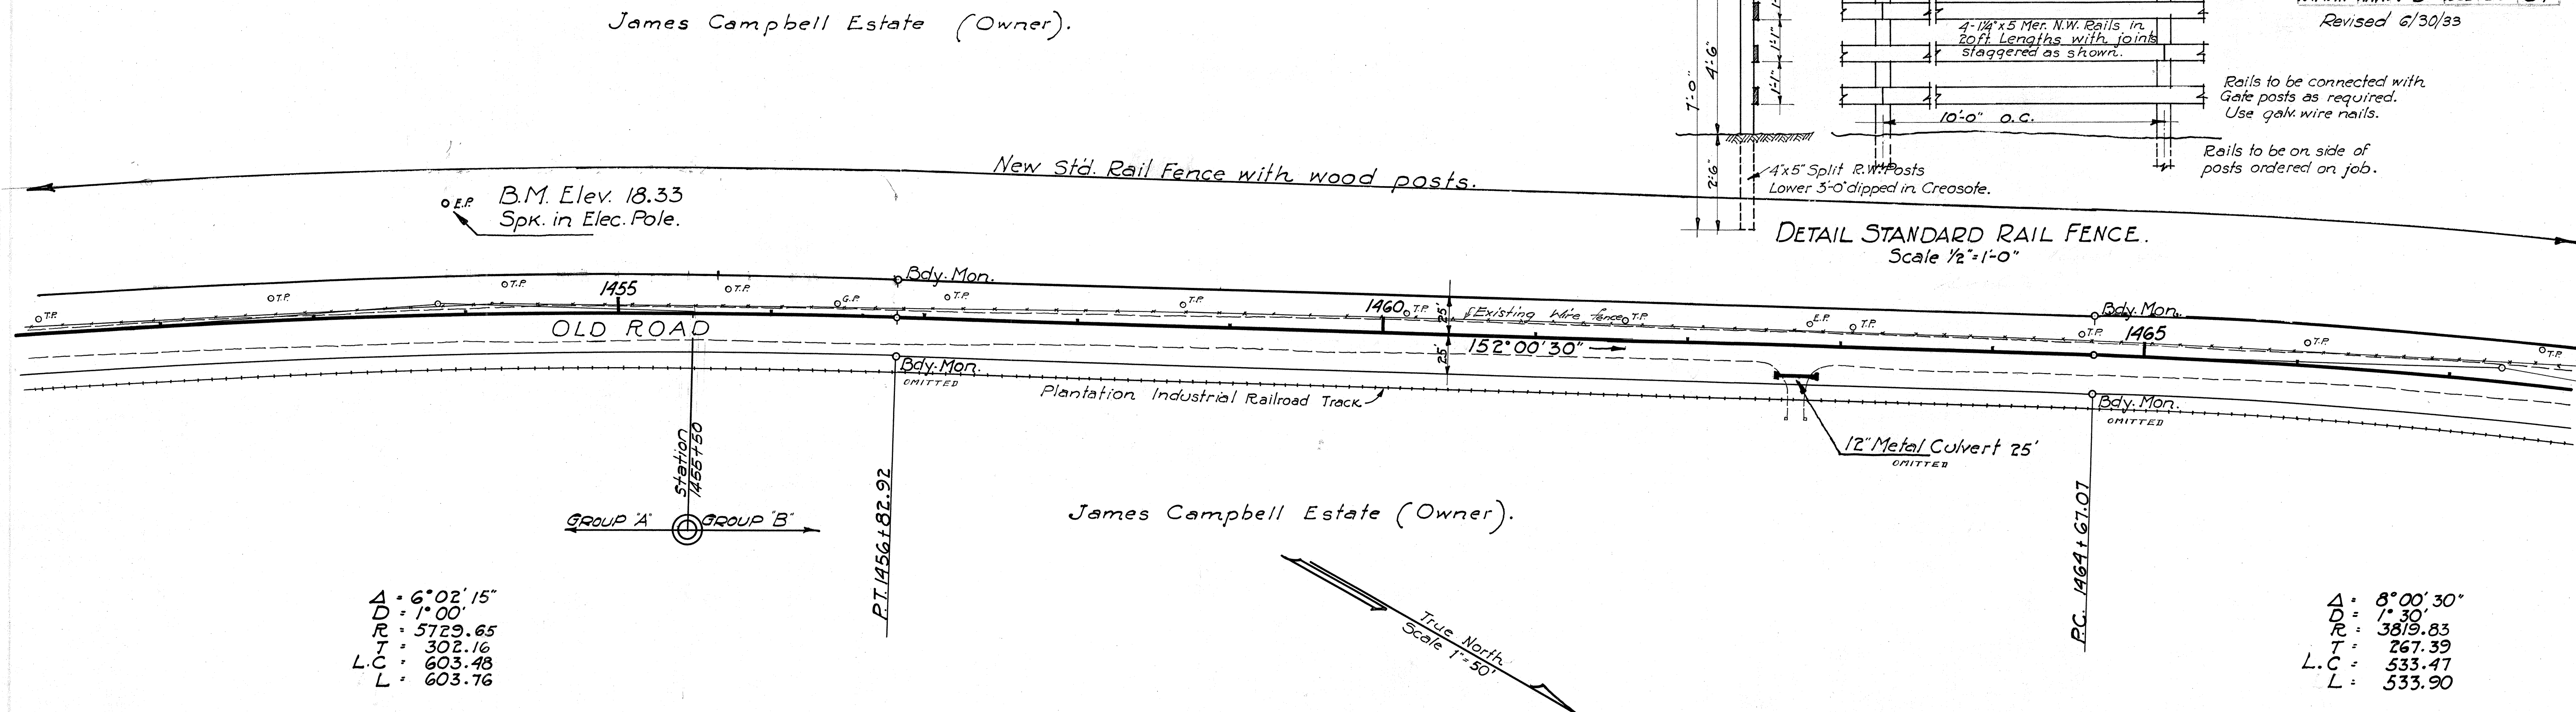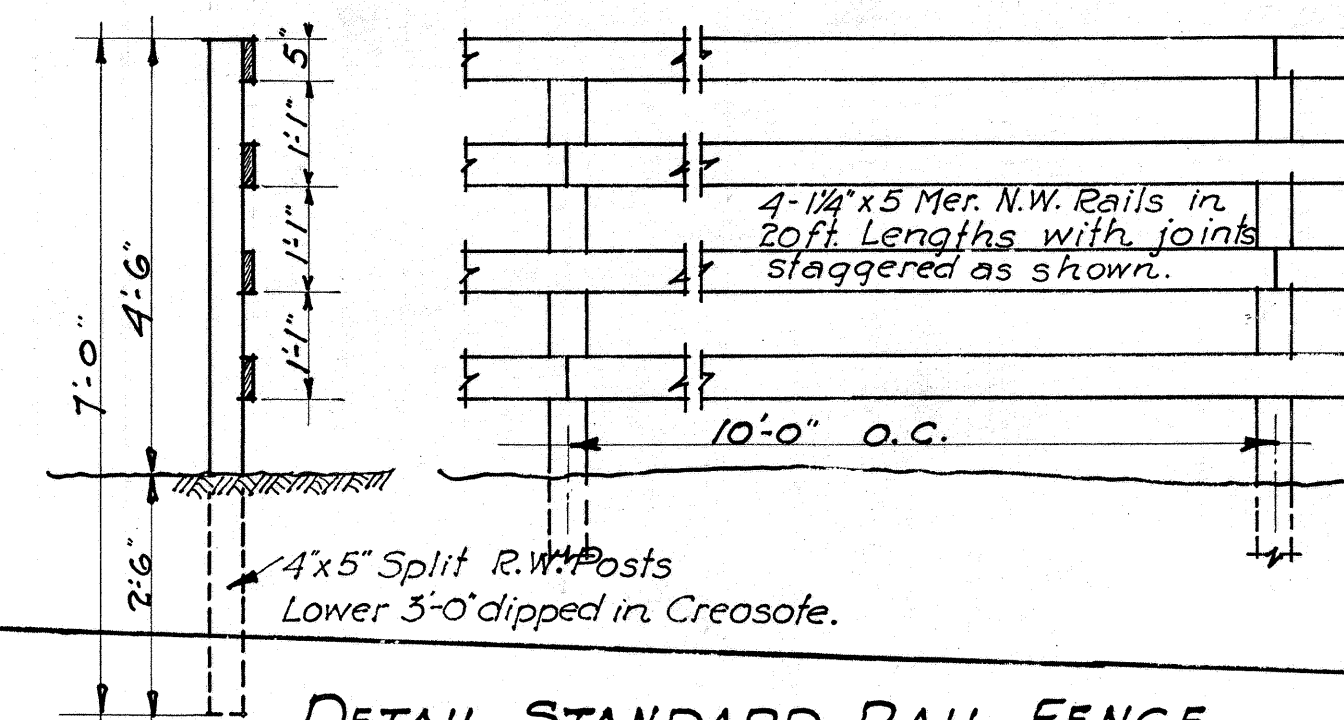

$\Delta = 6^{\circ}02'15''$
 $D = 1^{\circ}00'$
 $R = 5729.65$
 $T = 302.16$
 $L.C. = 603.48$
 $L = 603.76$

$\Delta = 8^{\circ}00'30''$
 $D = 1^{\circ}30'$
 $R = 3819.83$
 $T = 267.39$
 $L.C. = 533.47$
 $L = 533.90$

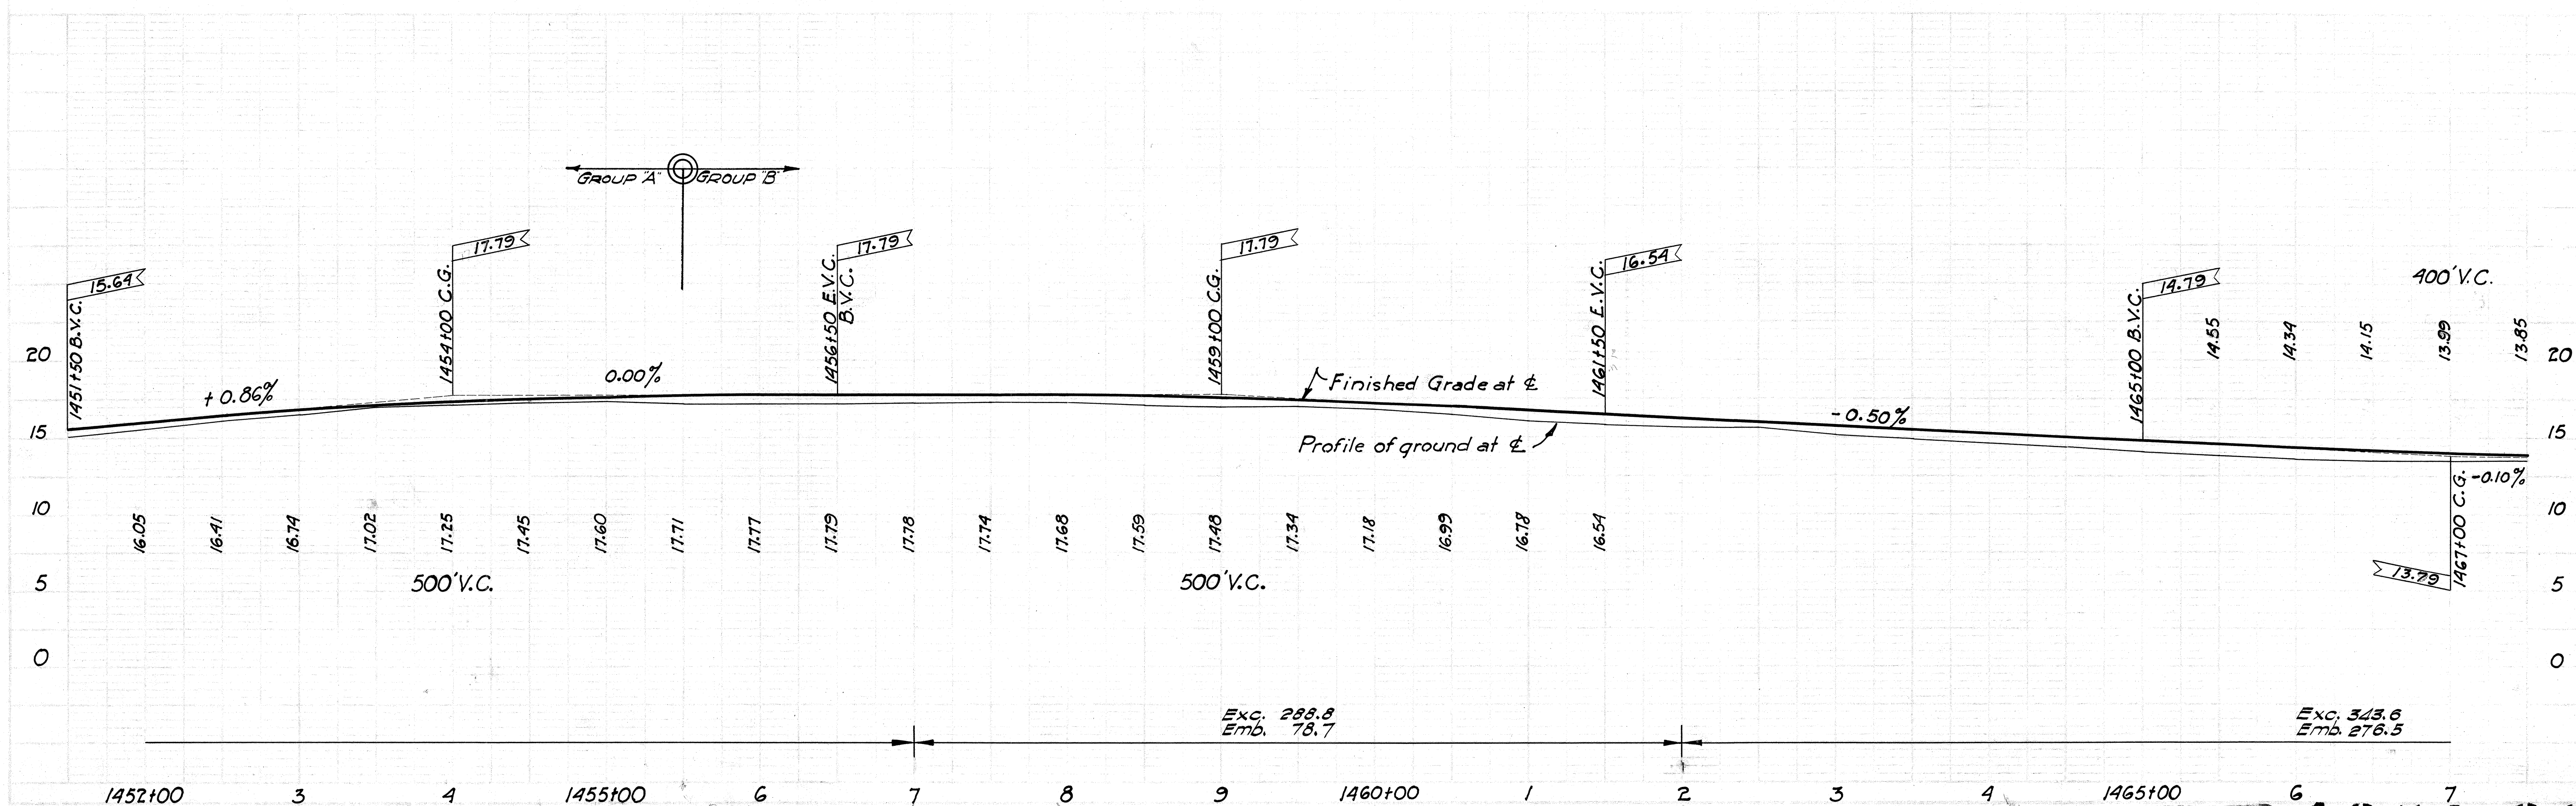


James Campbell Estate (Owner).

EQUATION.



$\Delta = 36^{\circ} 01'$
 $D = 4^{\circ} 00'$
 $R = 1432.69$
 $T = 465.74$
 $L.C. = 885.85$
 $L = 900.60$

FED. ROAD DIST. NO.	STATE	FED. AID PROJ. NO.	FISCAL YEAR	SHEET NO.	TOTAL SHEETS
	HAWAII	1-D	1932	21	57

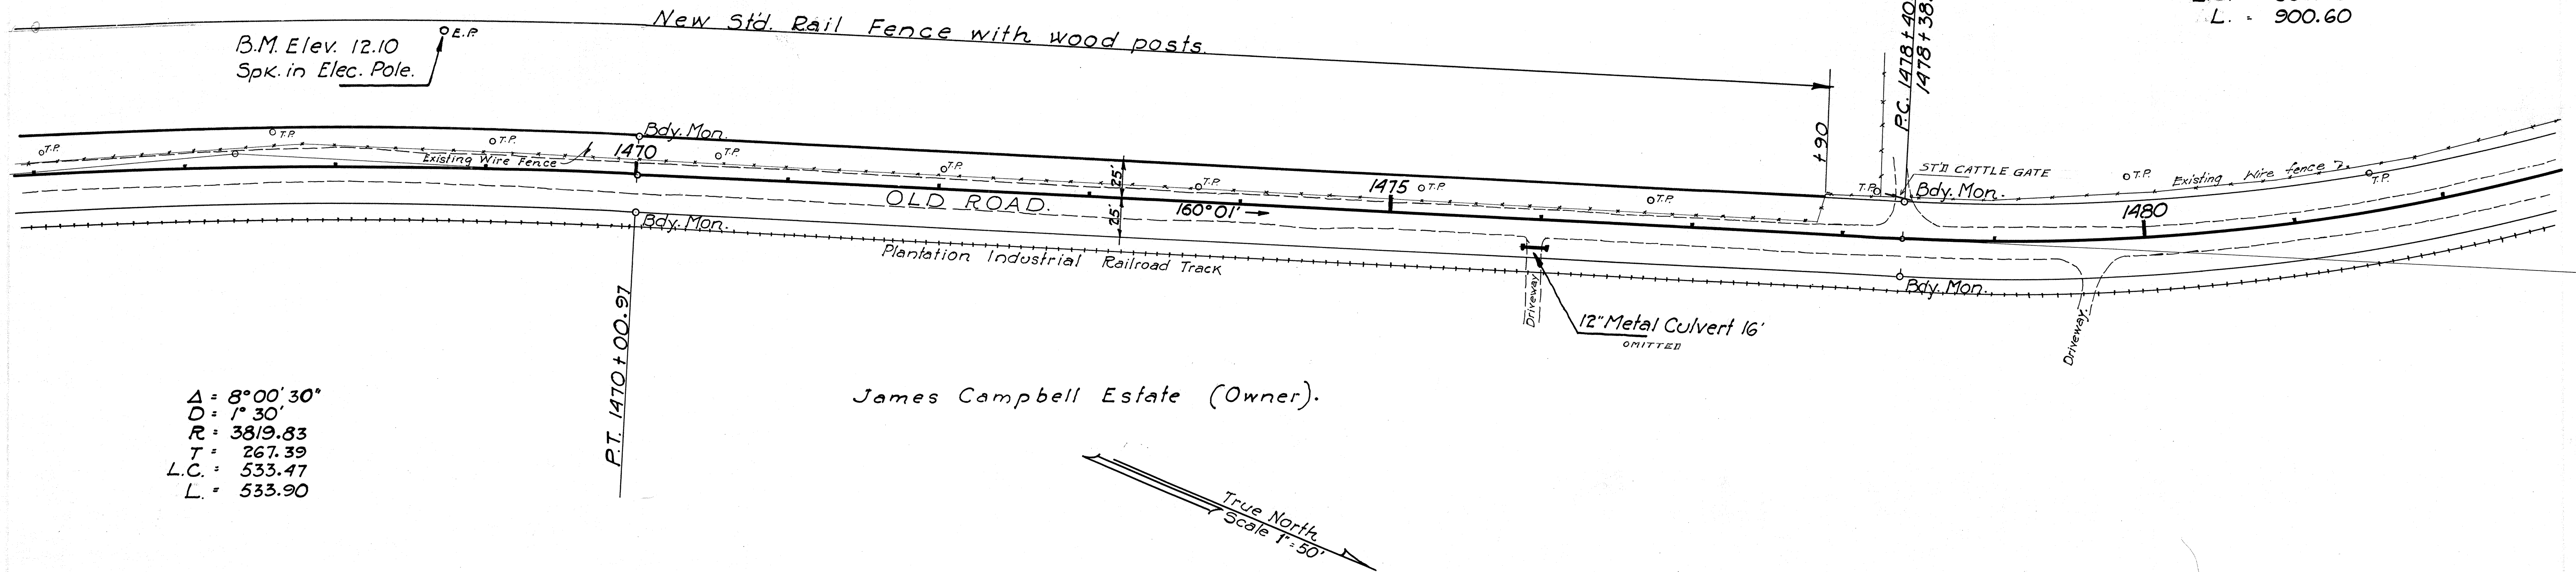

$\Delta = 8^{\circ} 00' 30''$
 $D = 1^{\circ} 30'$
 $R = 3819.83$
 $T = 267.39$
 $L.C. = 533.47$
 $L = 533.90$

James Campbell Estate (Owner).

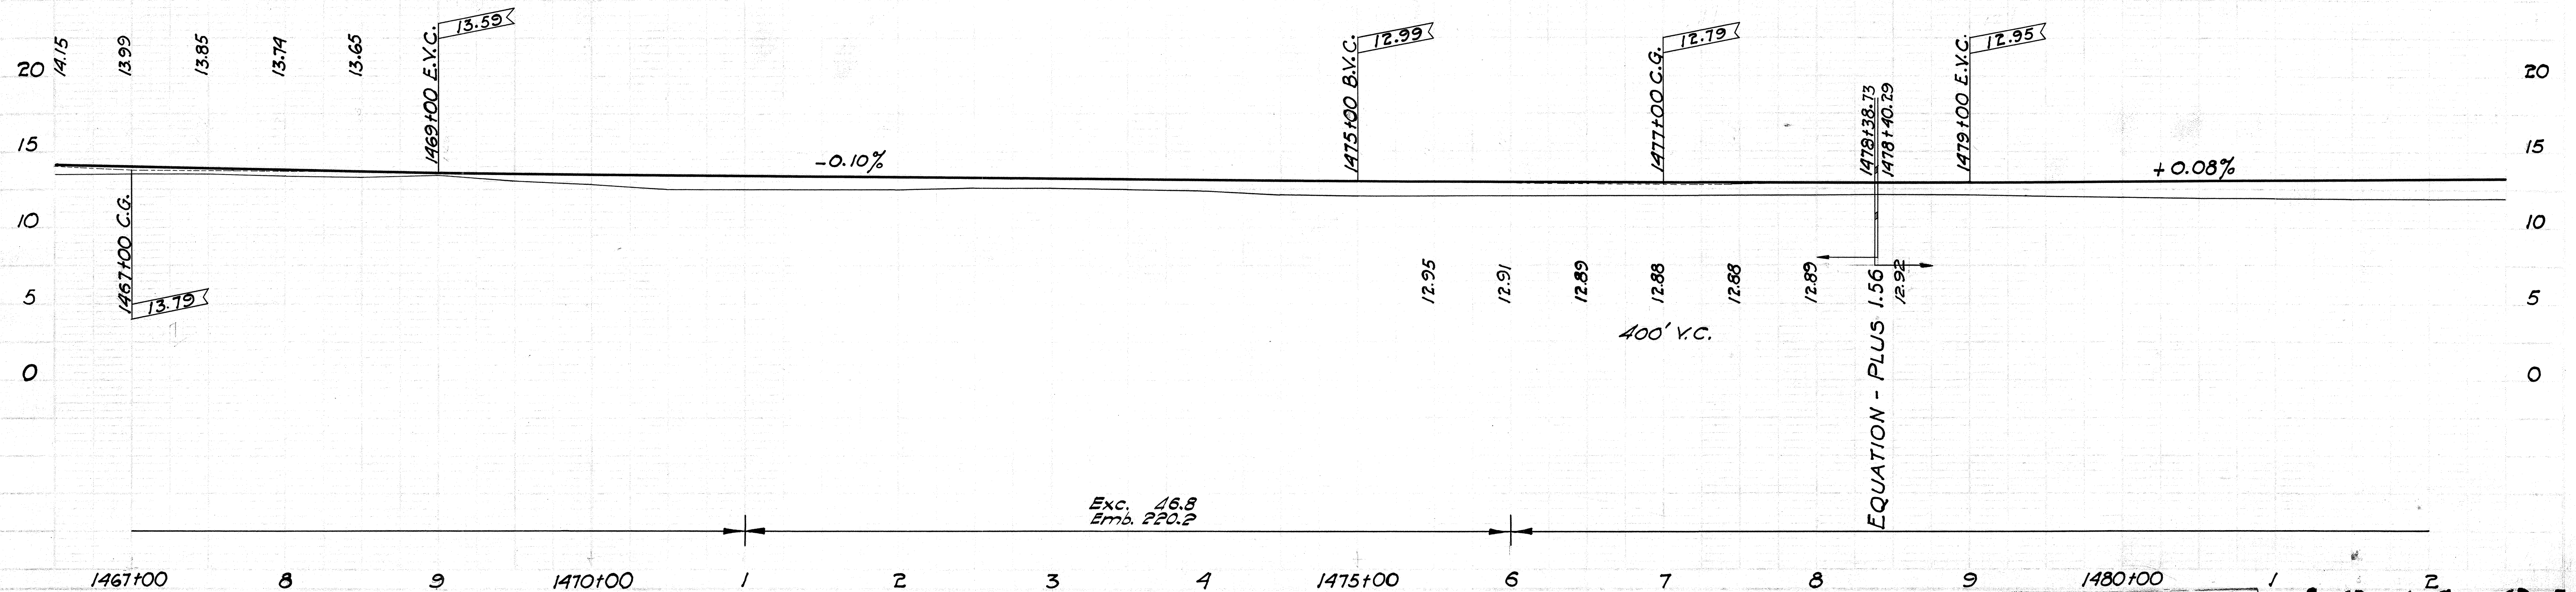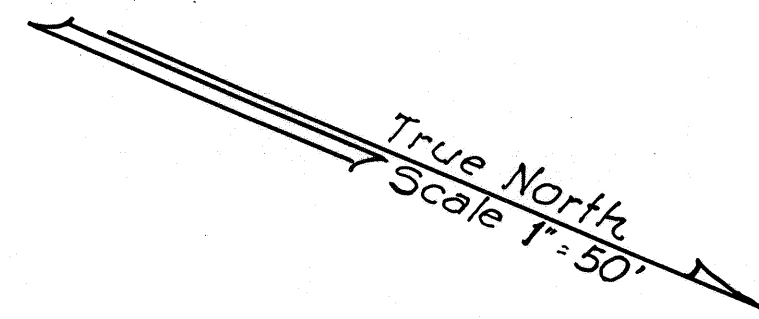

Exc. 46.8
 Emb. 220.2

