
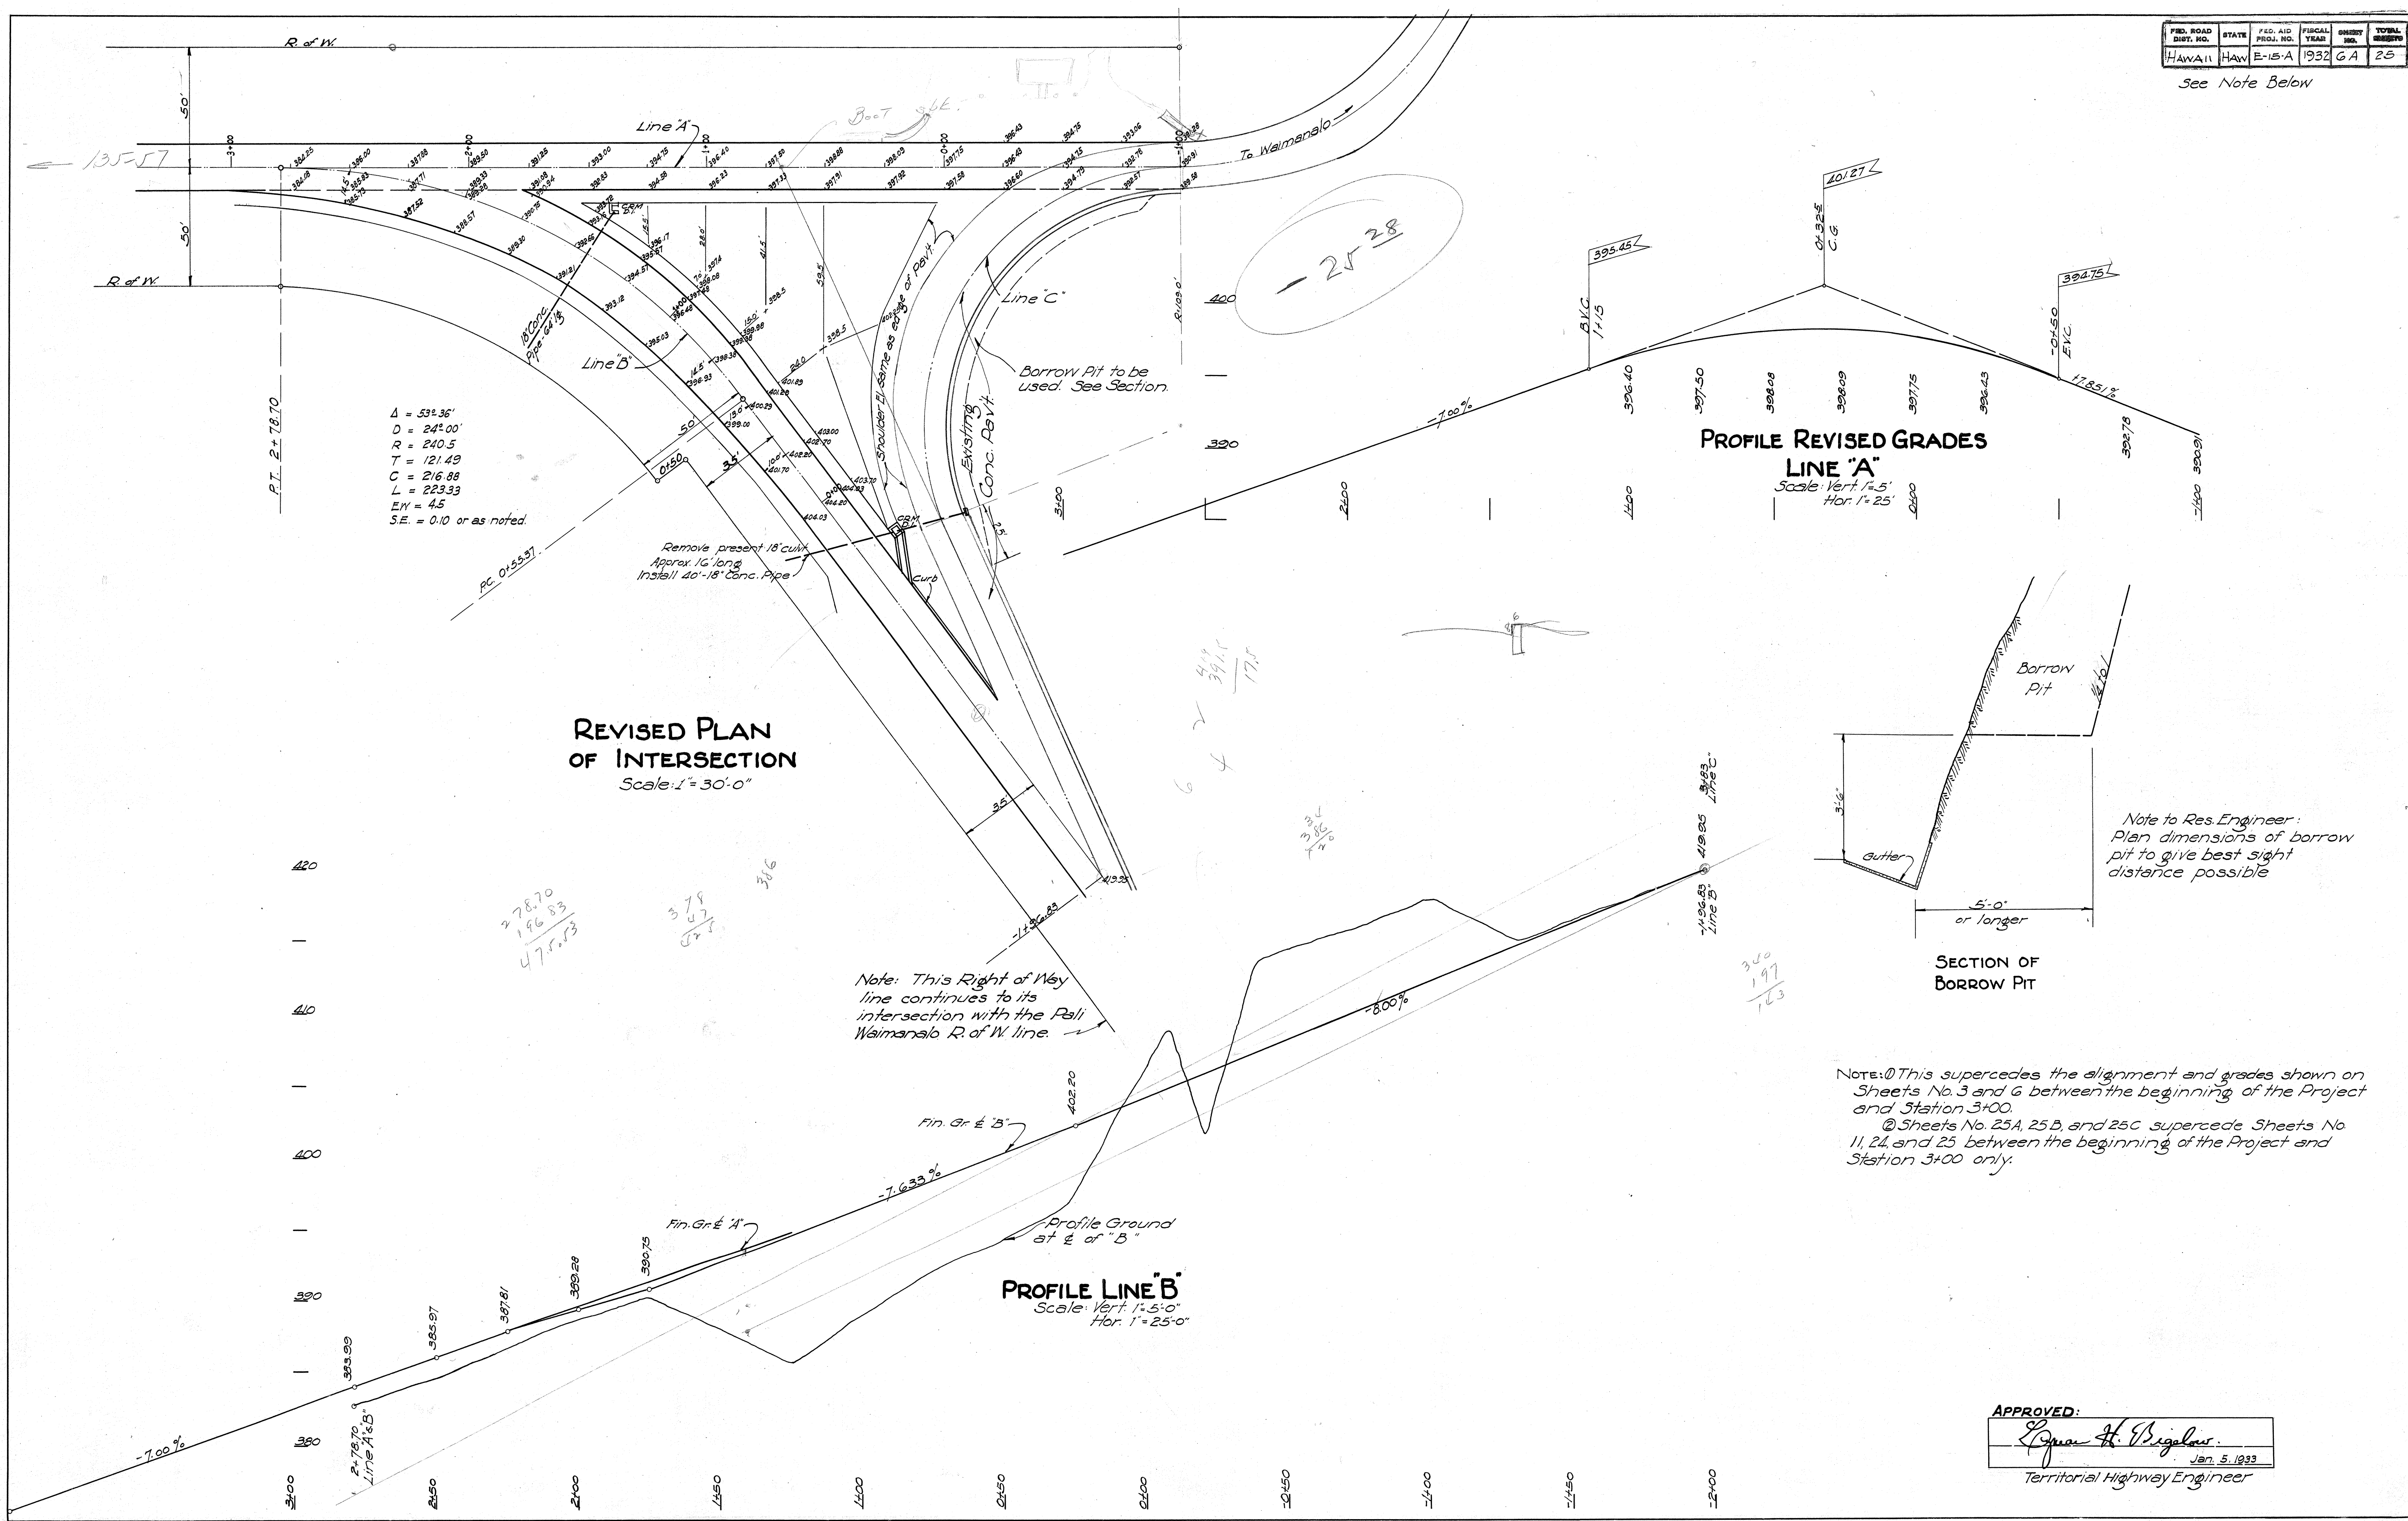


FED. ROAD DIST. NO.	STATE	FISCAL YEAR	PROJECT NO.	TOTAL SHEETS
HAWAII	HAW	E-15-A	1932 GA	25

See Note Below

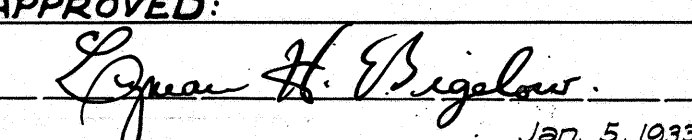

APPROVED:

 Jan. 5, 1933
 Territorial Highway Engineer