
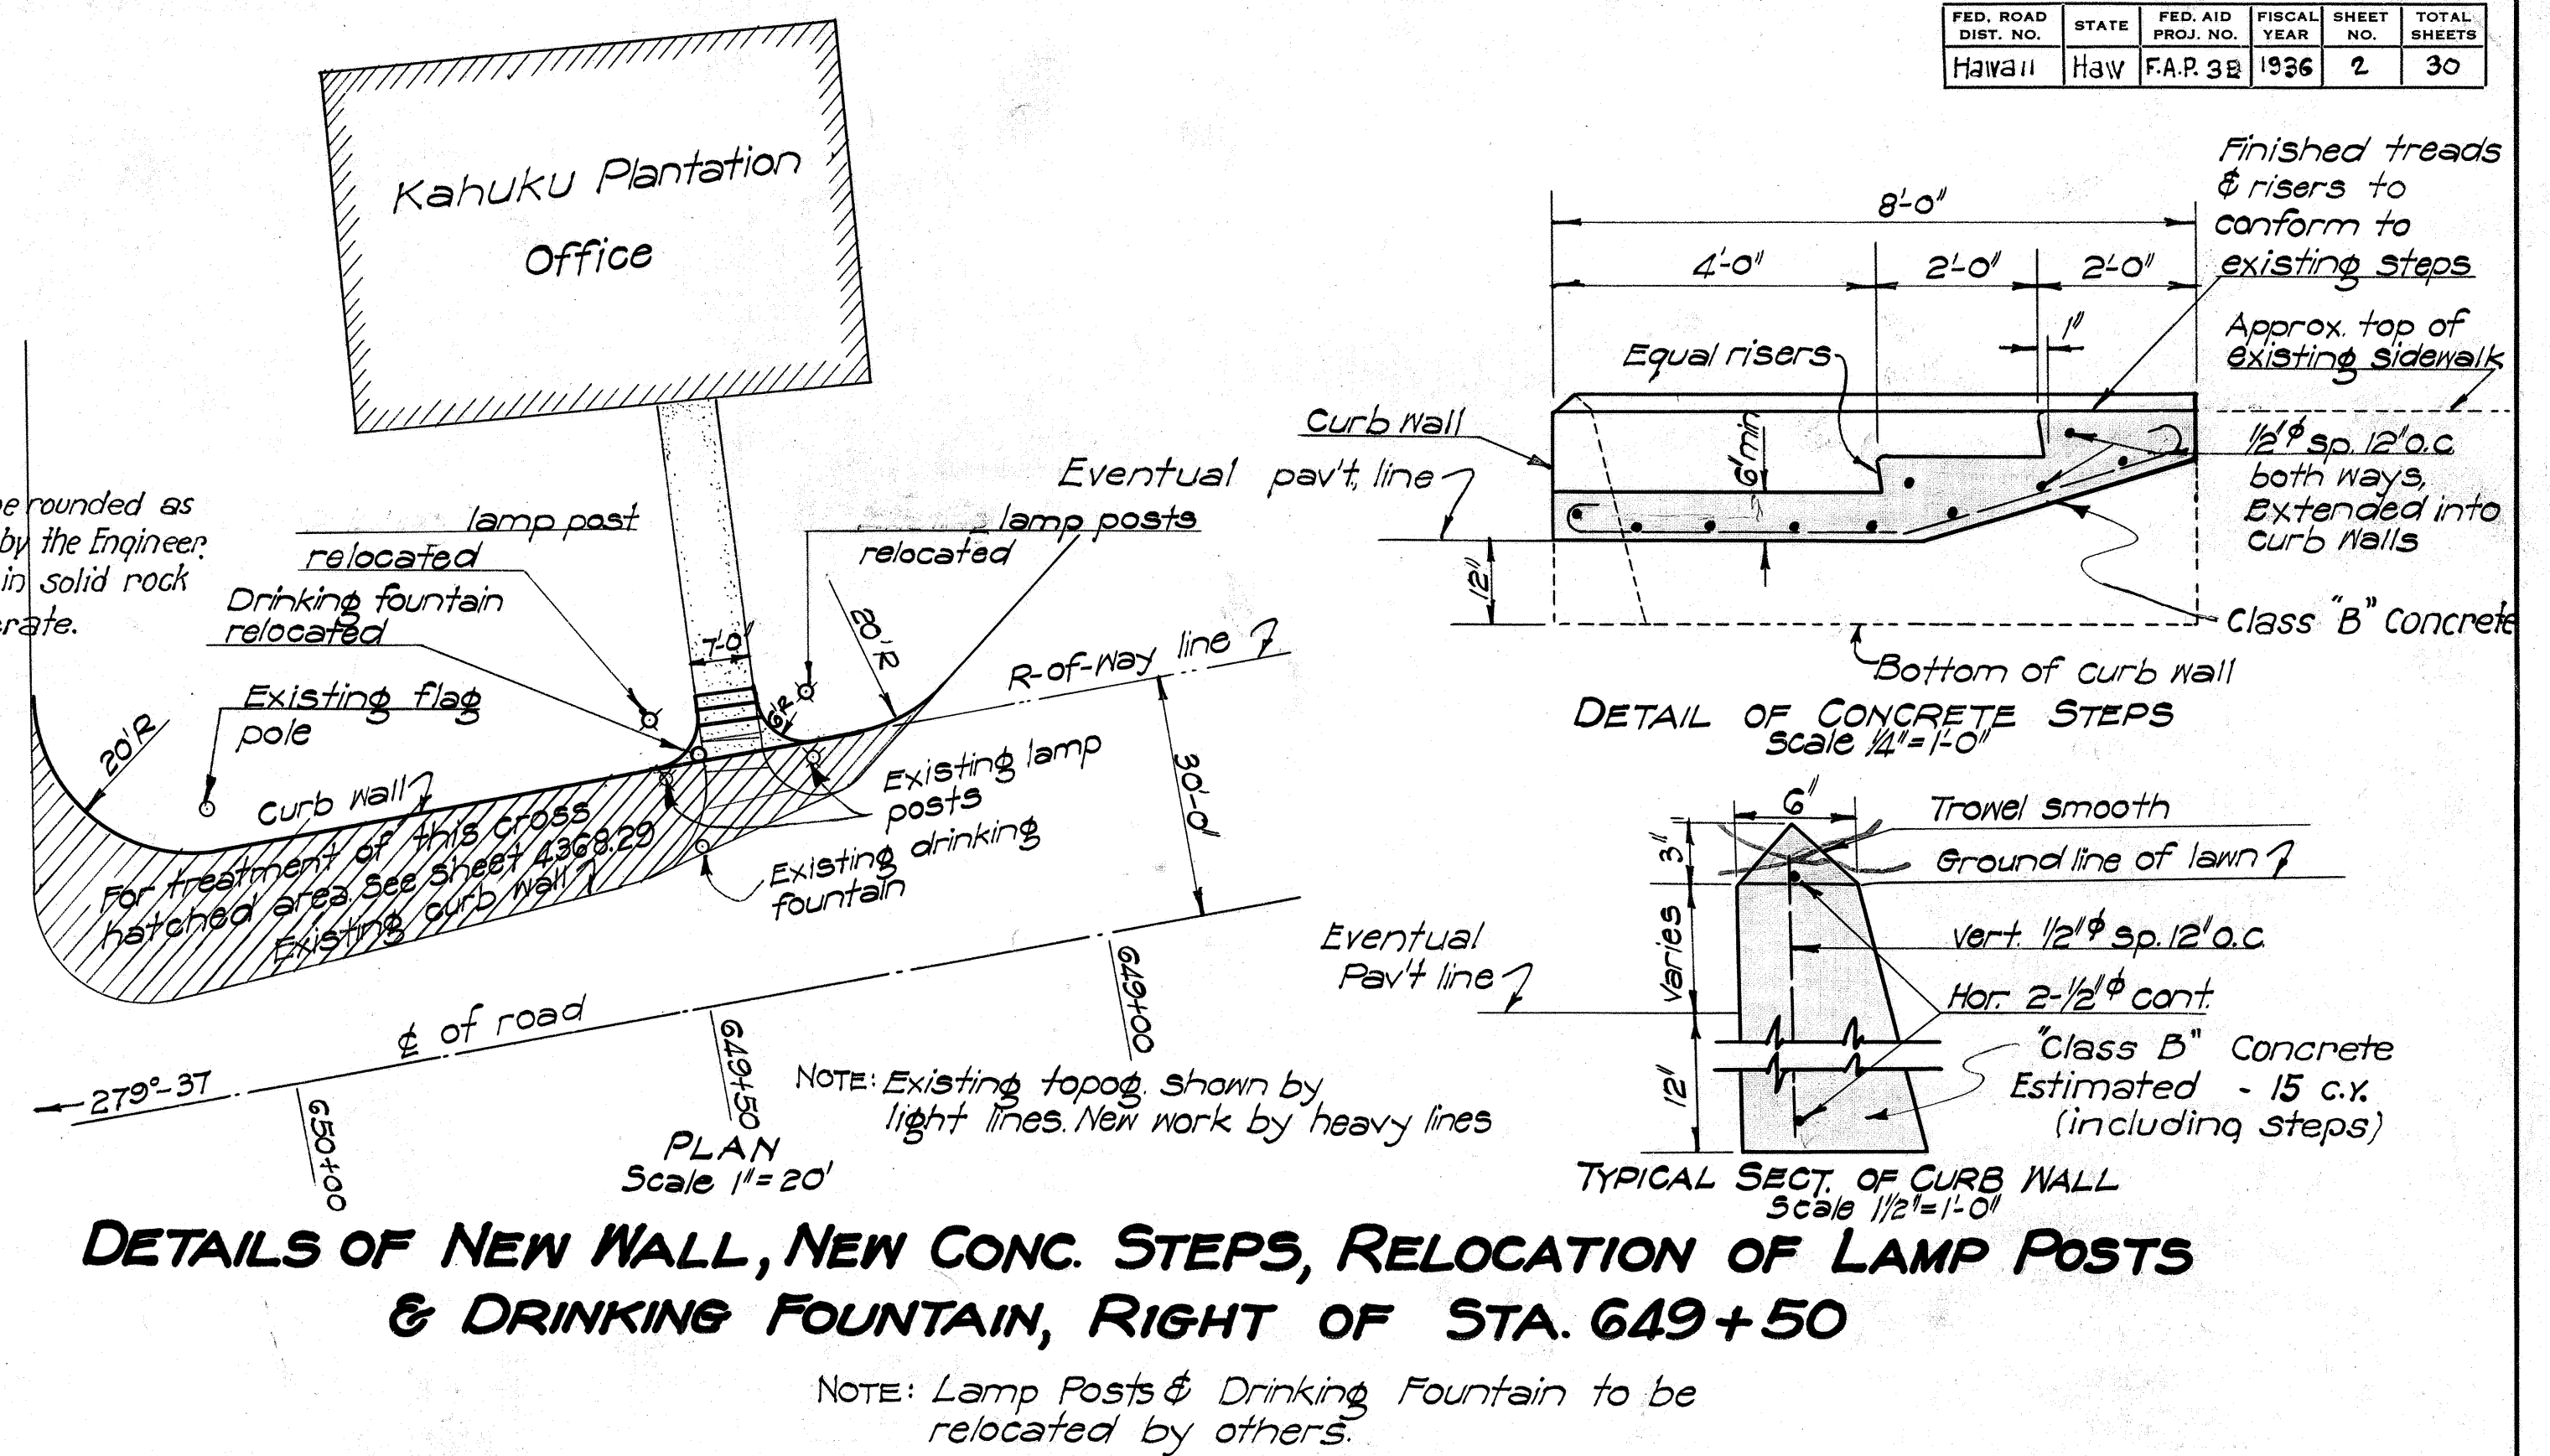


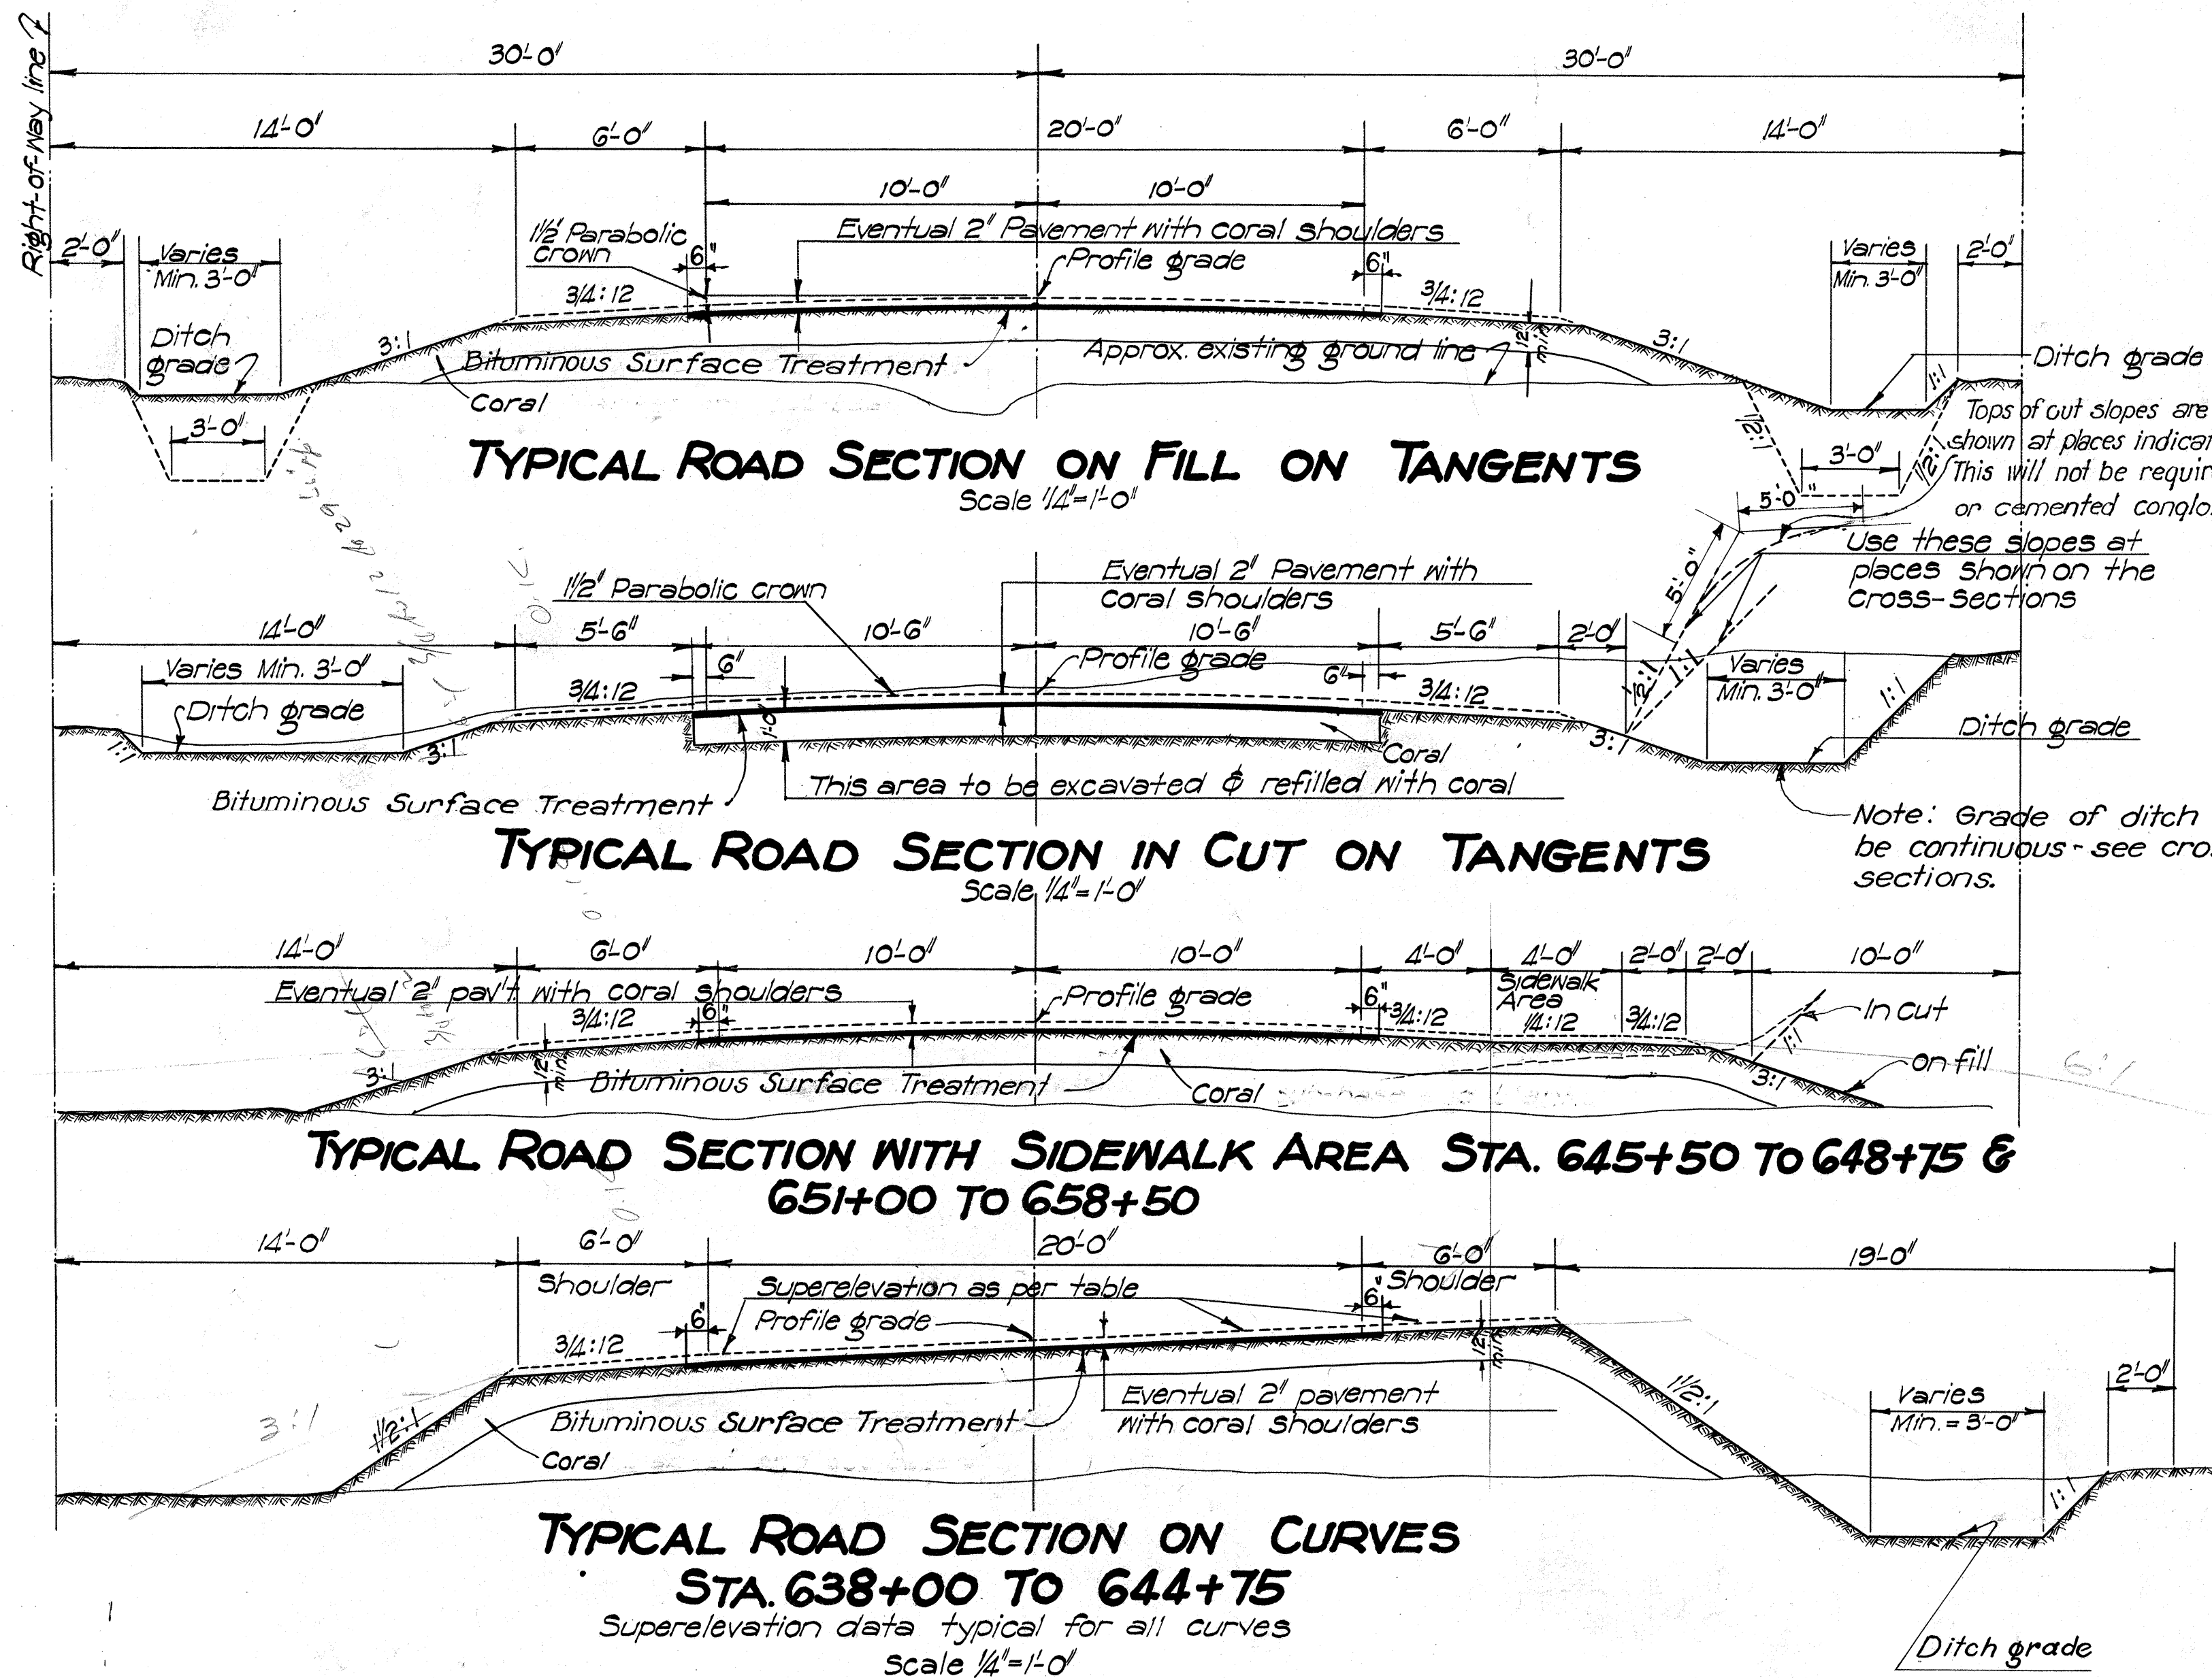

NOTE ON SUBGRADE AND SURFACE

SUBGRADE: Coral fill with 10% cement. The subgrade shall be compacted to 95% relative compaction.

BITUMINOUS SURFACE TREATMENT: Type A

GENERAL NOTE: Particular reference is made to the specifications covering these items of work.