



FED. ROAD DIST. NO.	STATE	FED. AID PROJ. NO.	FISCAL YEAR	SHEET NO.	TOTAL SHEETS
HAWAII	HAW.	7A (R)	1937	3	6

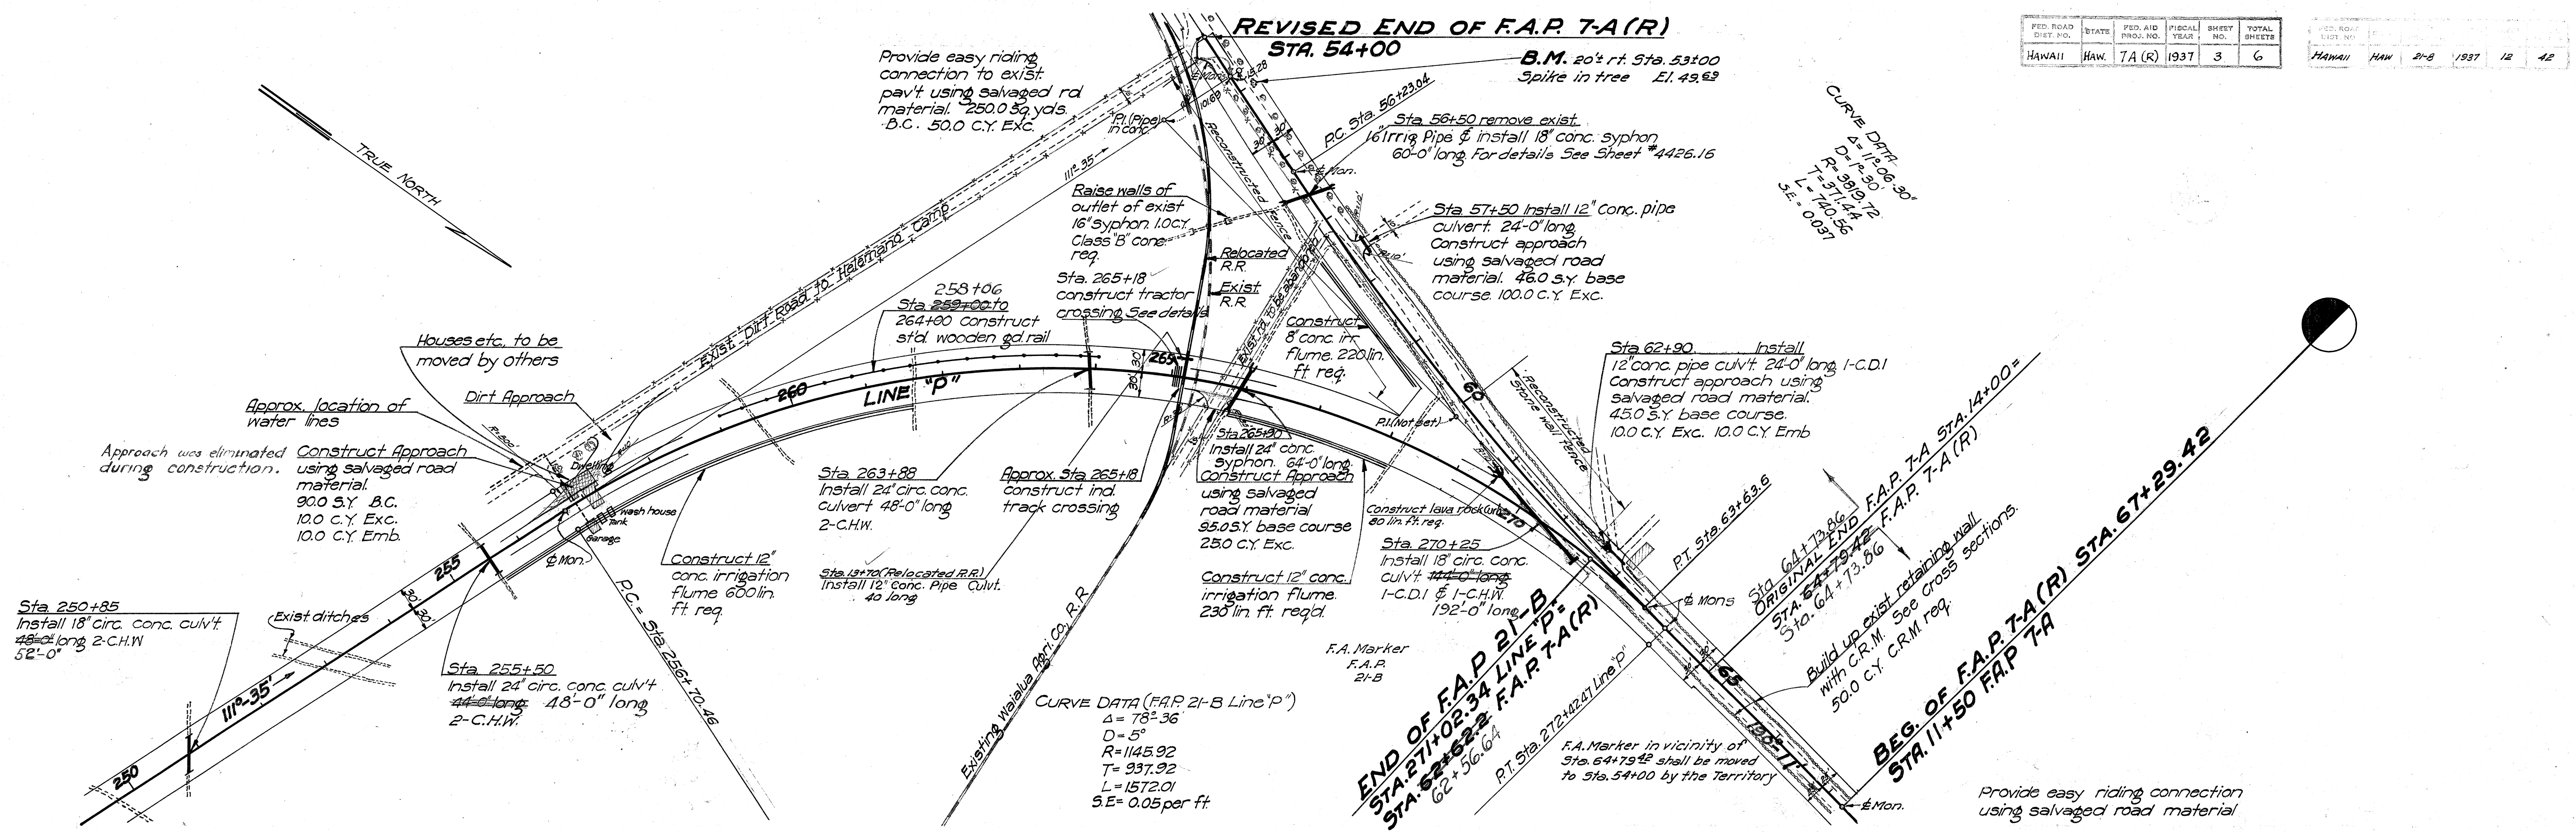

**NOTE:** For detail of gutters relocation of Plantation R.R., profile of F.A.P. 7-A(R) etc., see larger scale detail of intersection. Sheet No. 4426.13

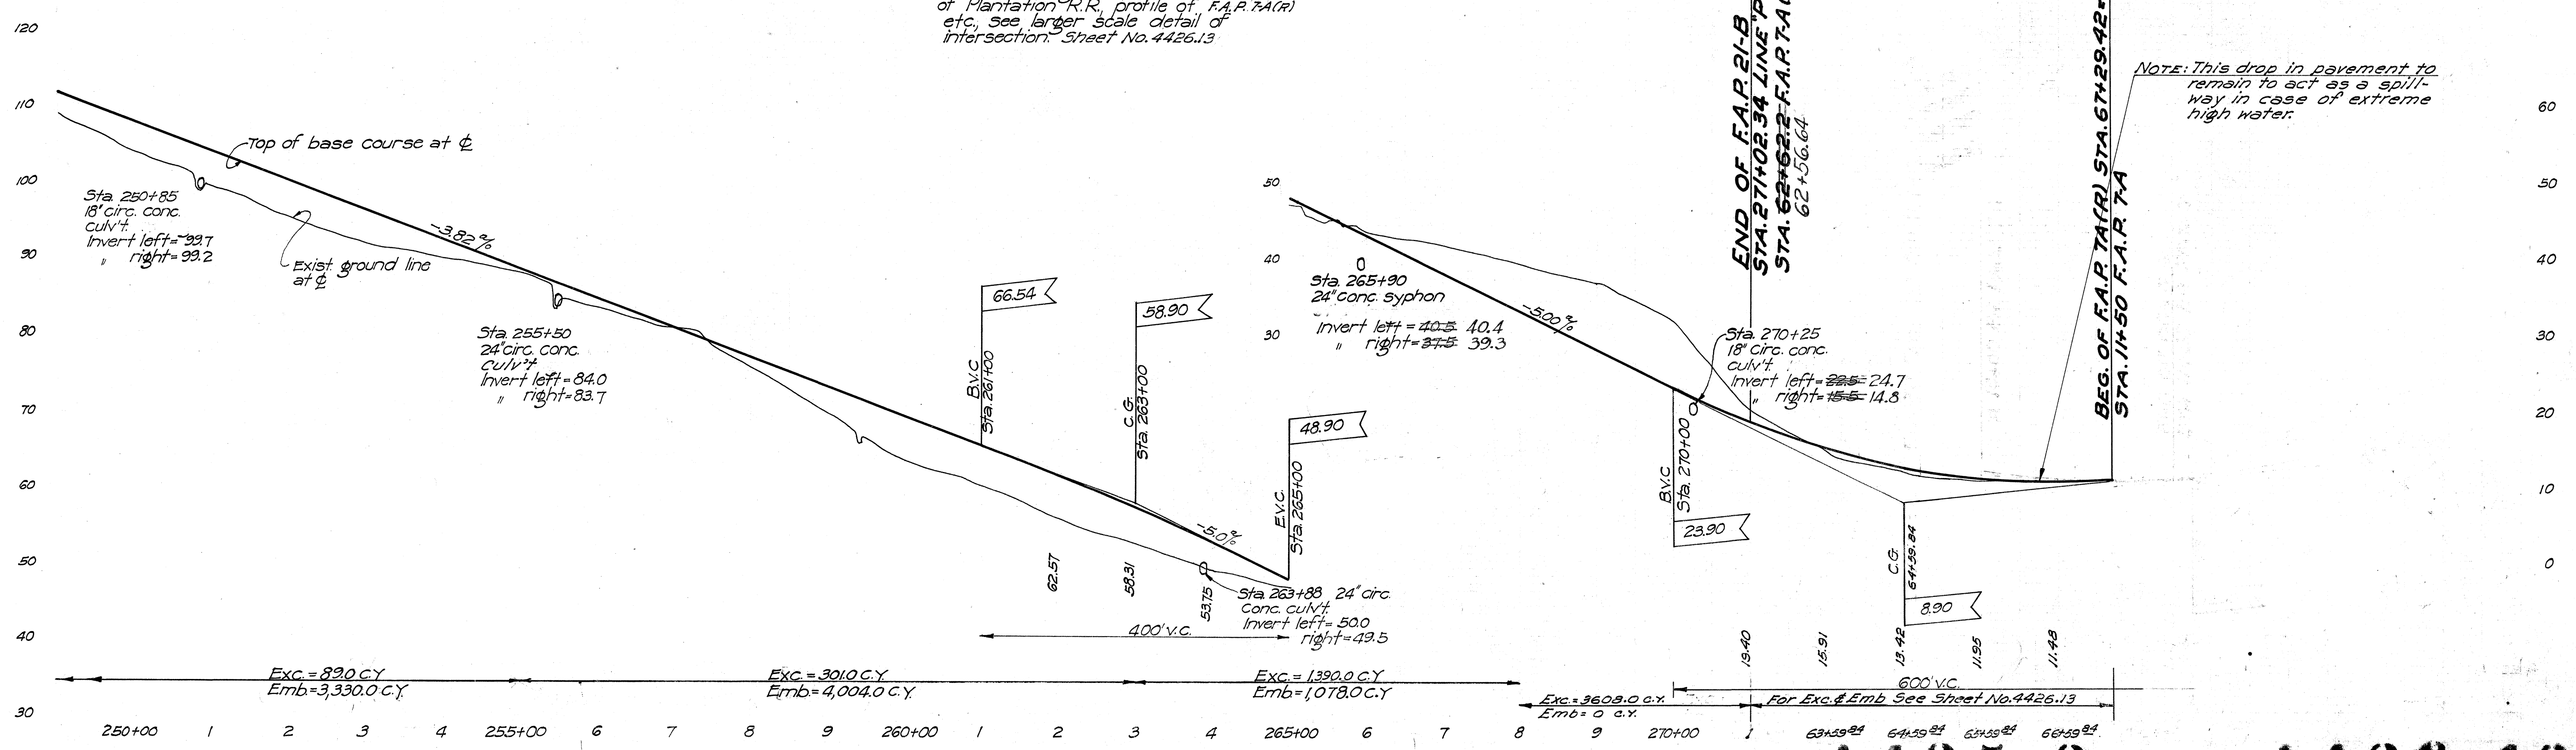



**4435.3**      **4426.12**



FED. ROAD DIST. NO.	STATE	FED. AID PROJ. NO.	FISCAL YEAR	SHEET NO.	TOTAL SHEETS
HAWAII	HAW	2-8	1937	13	42

FED. ROAD DIST. NO.	STATE	FED. AID PROJ. NO.	FISCAL YEAR	SHEET NO.	TOTAL SHEETS
HAWAII	HAW	7A(R)	1937	4	6

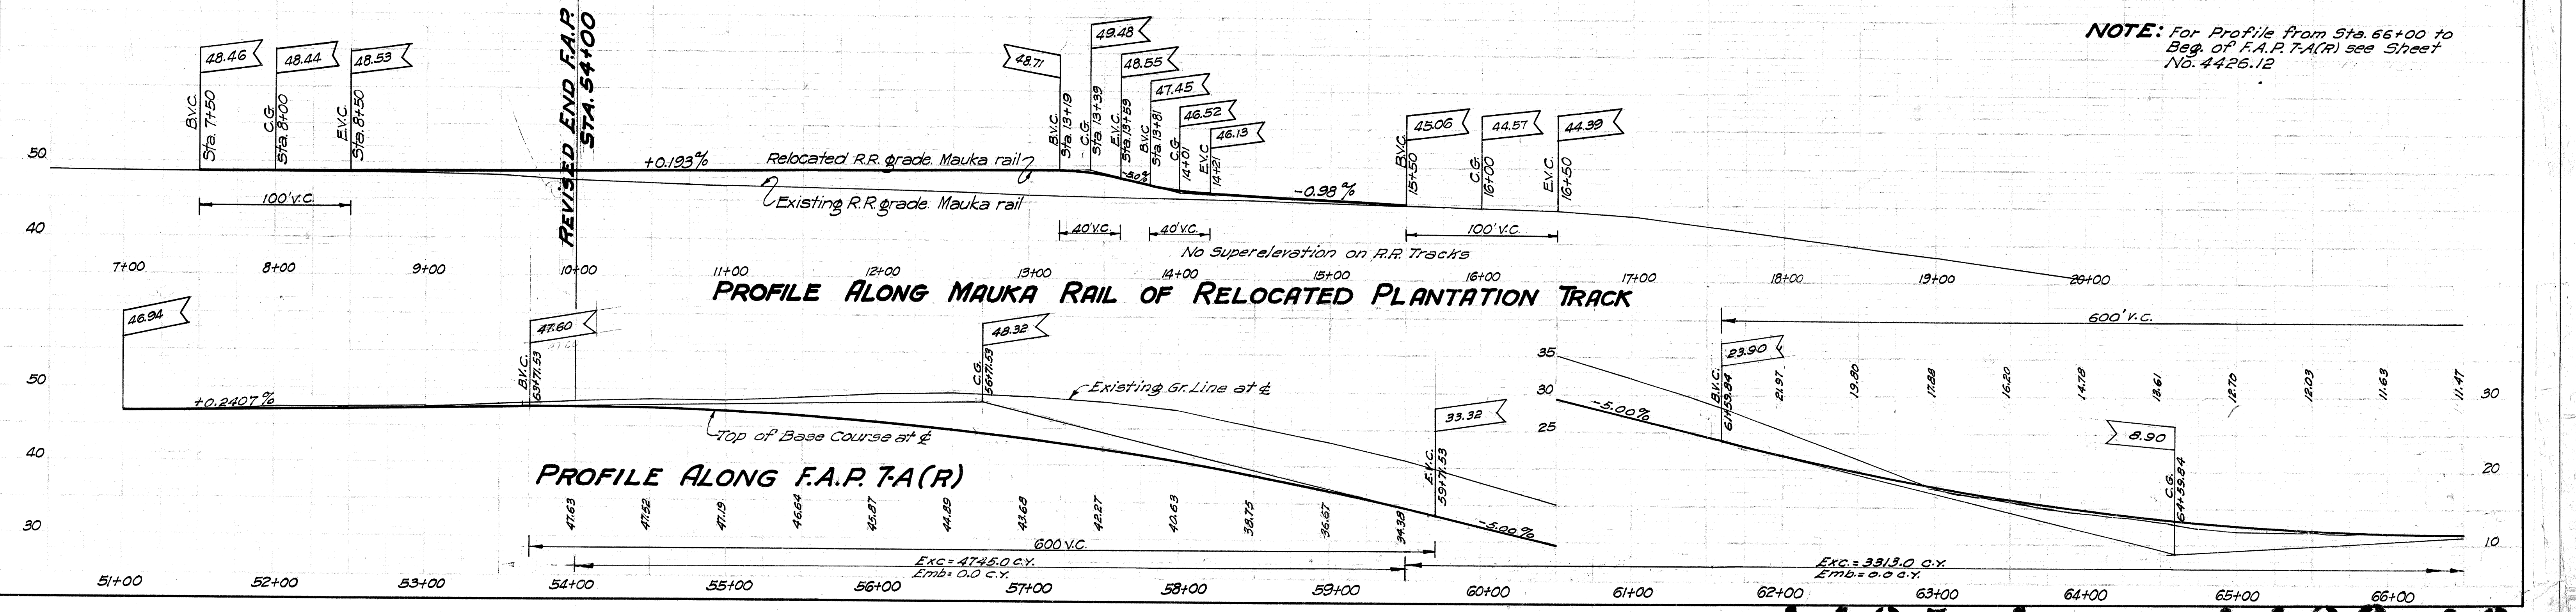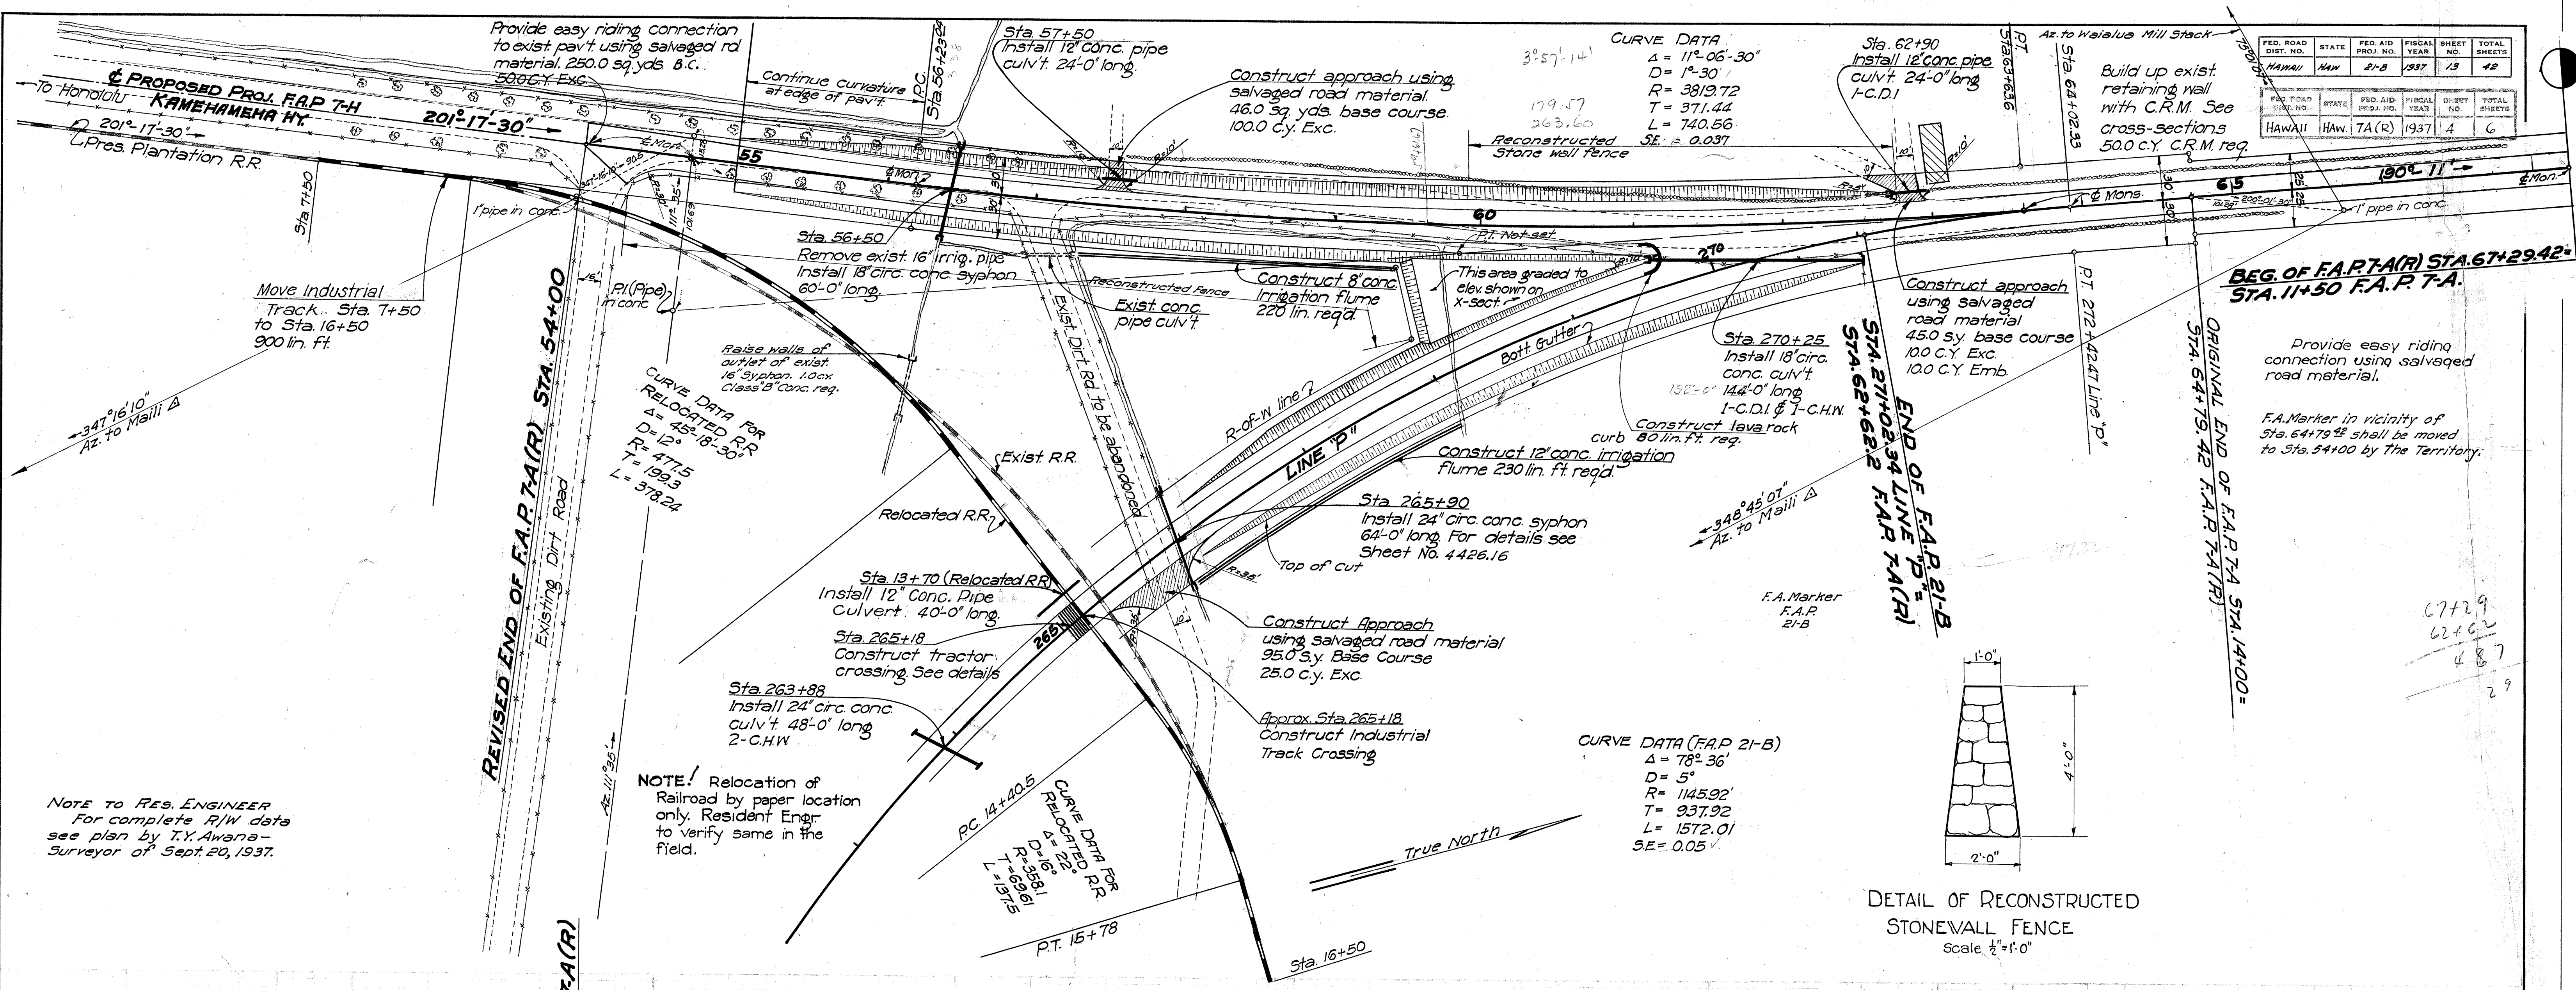

**4435.4**      **4426.13**

DESIGNED BY: \_\_\_\_\_  
 TRACED BY: \_\_\_\_\_  
 QUANTITIES BY: \_\_\_\_\_  
 CHECKED BY: \_\_\_\_\_