
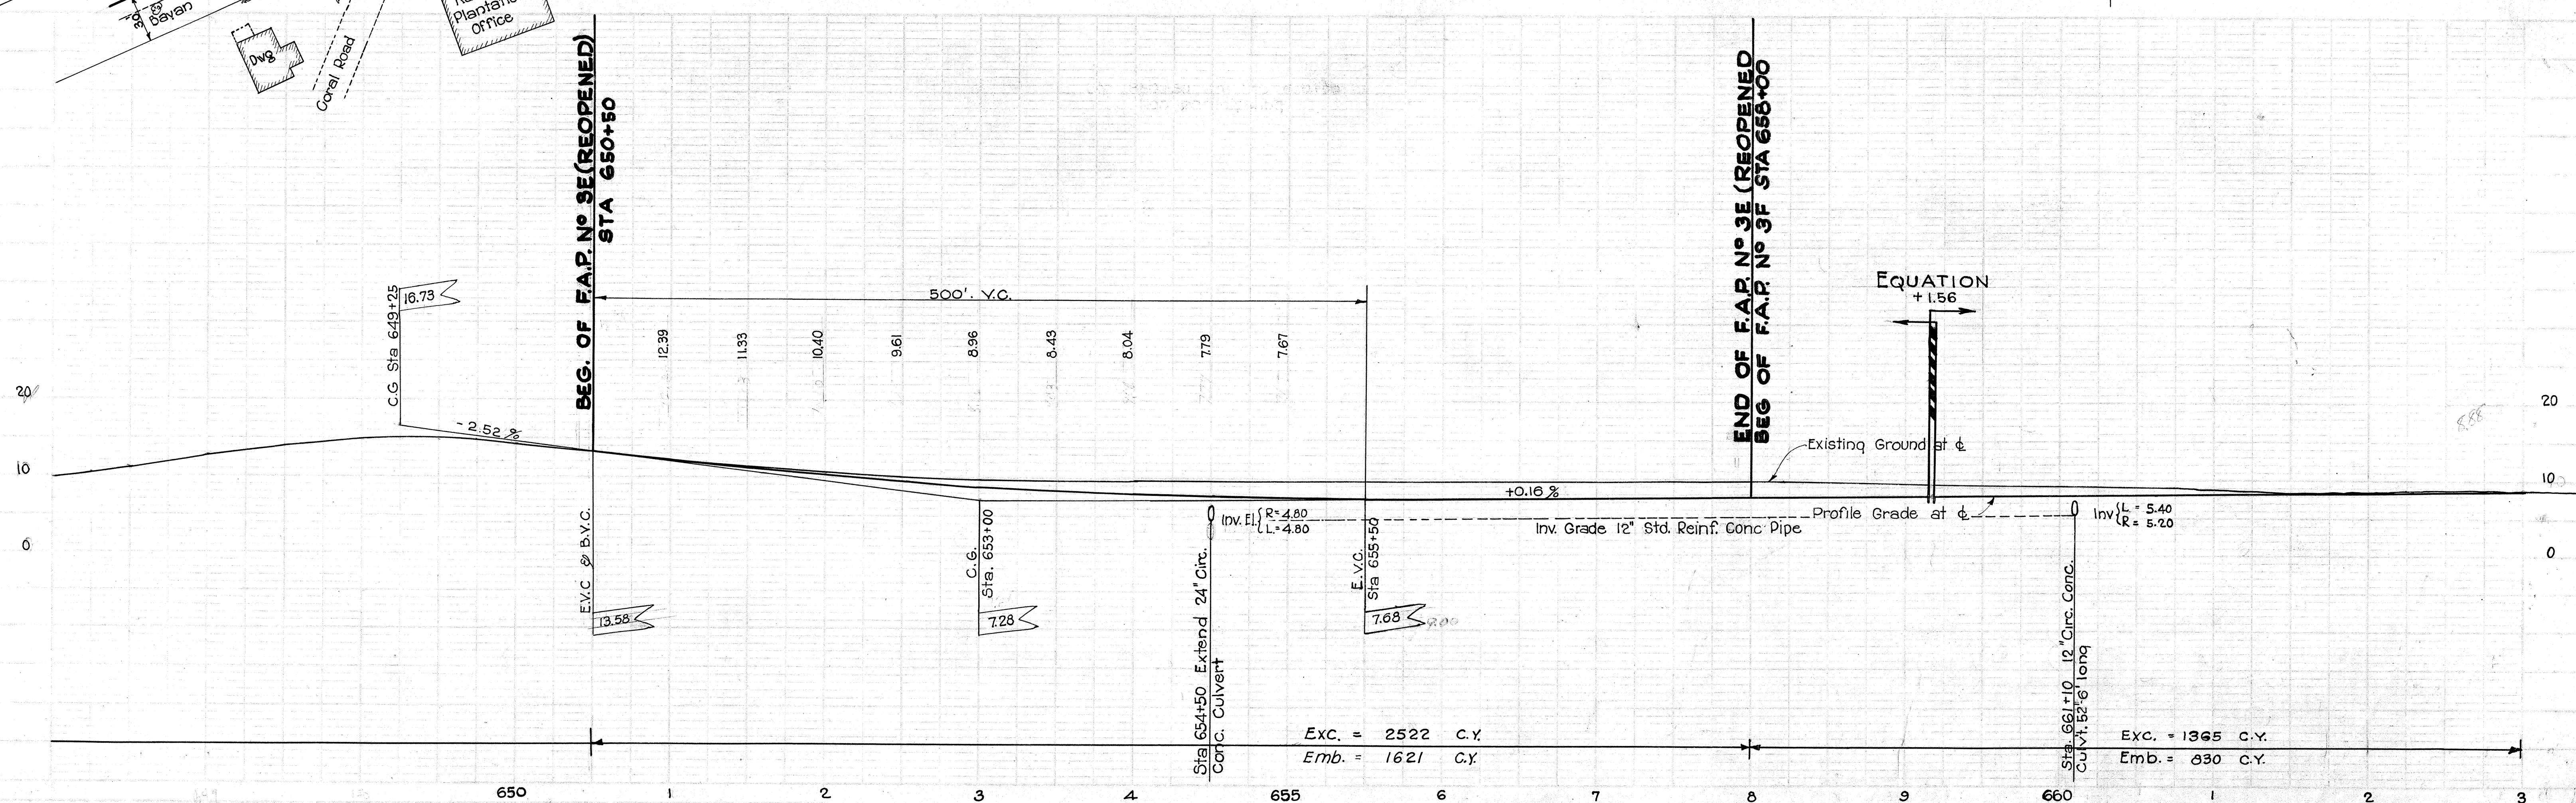


J.L.P.
3-36
11-37

J.L.P.
R.E.S.
3-36
11-37

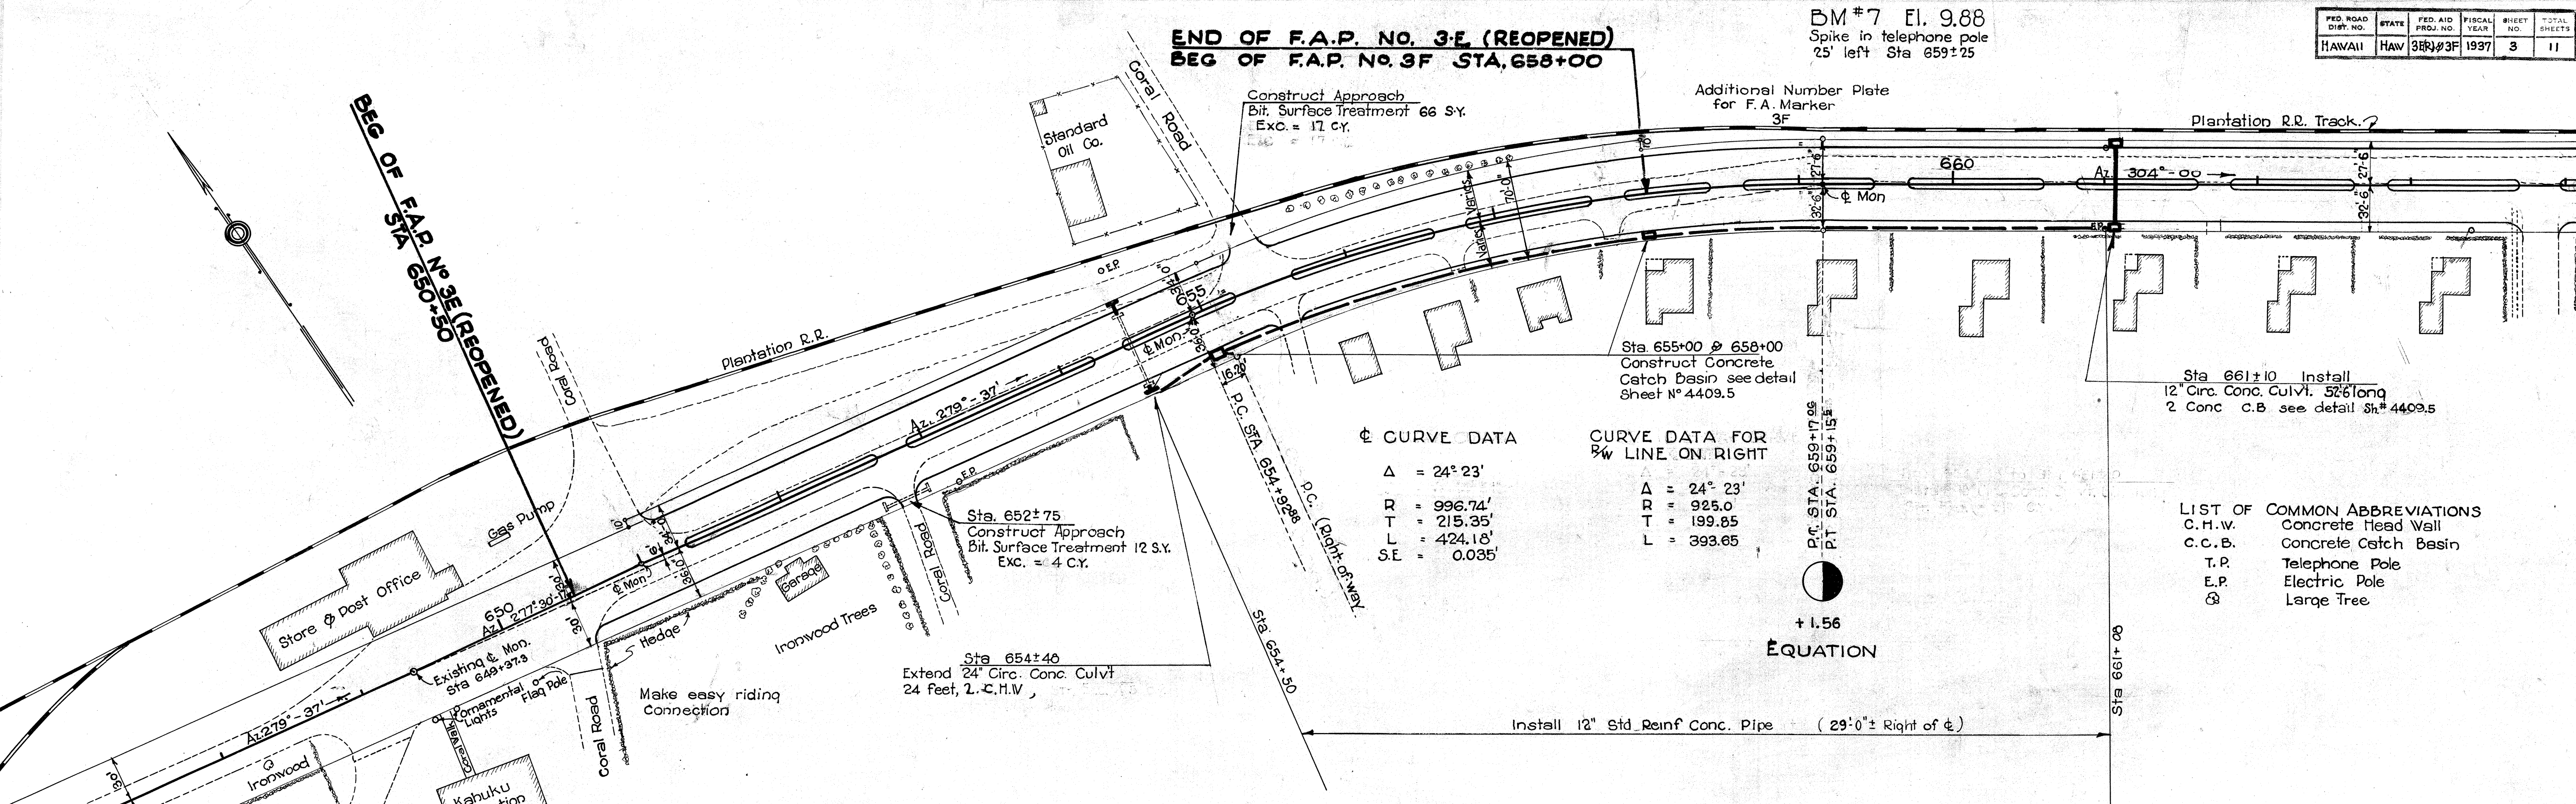

4432.3 4409.3

B.M. N° 8 El. 12.03

Spike in telephone pole 25'
left Sta. 671+32

FED. ROAD DIST. NO.	STATE	FED. AID PROJ. NO.	FISCAL YEAR	SHEET NO.	TOTAL SHEETS
HAWAII	HAW	3E(9)33F	1937	4	11

