


INDEX TO DRAWINGS	
SHEET NO.	DESCRIPTION
1	TITLE SHEET
2	TYPICAL SECTIONS
3-5	PLAN & PROFILE
6-7	STANDARD DETAIL SH.#1 & 2
8-11	CROSS SECTIONS

FED. ROAD DIST. NO.	STATE	FED. AID PROJ. NO.	FISCAL YEAR	SHEET NO.	TOTAL SHEETS
Hawaii	Haw.	3E(R)3F	1937	1	11

~~CITY AND COUNTY-SECTION-C-23~~
 TERRITORY OF HAWAII
~~TERRITORIAL HIGHWAY DEPARTMENT~~
 HONOLULU T. H.
 PLANS OF
KAMEHAMEHA HIGHWAY
 KAHUKU SECTION
~~FEDERAL AID PROJECT NO. 3E(R) & 3F~~
 KOOLAULOA DISTRICT
 OAHU, T. H.

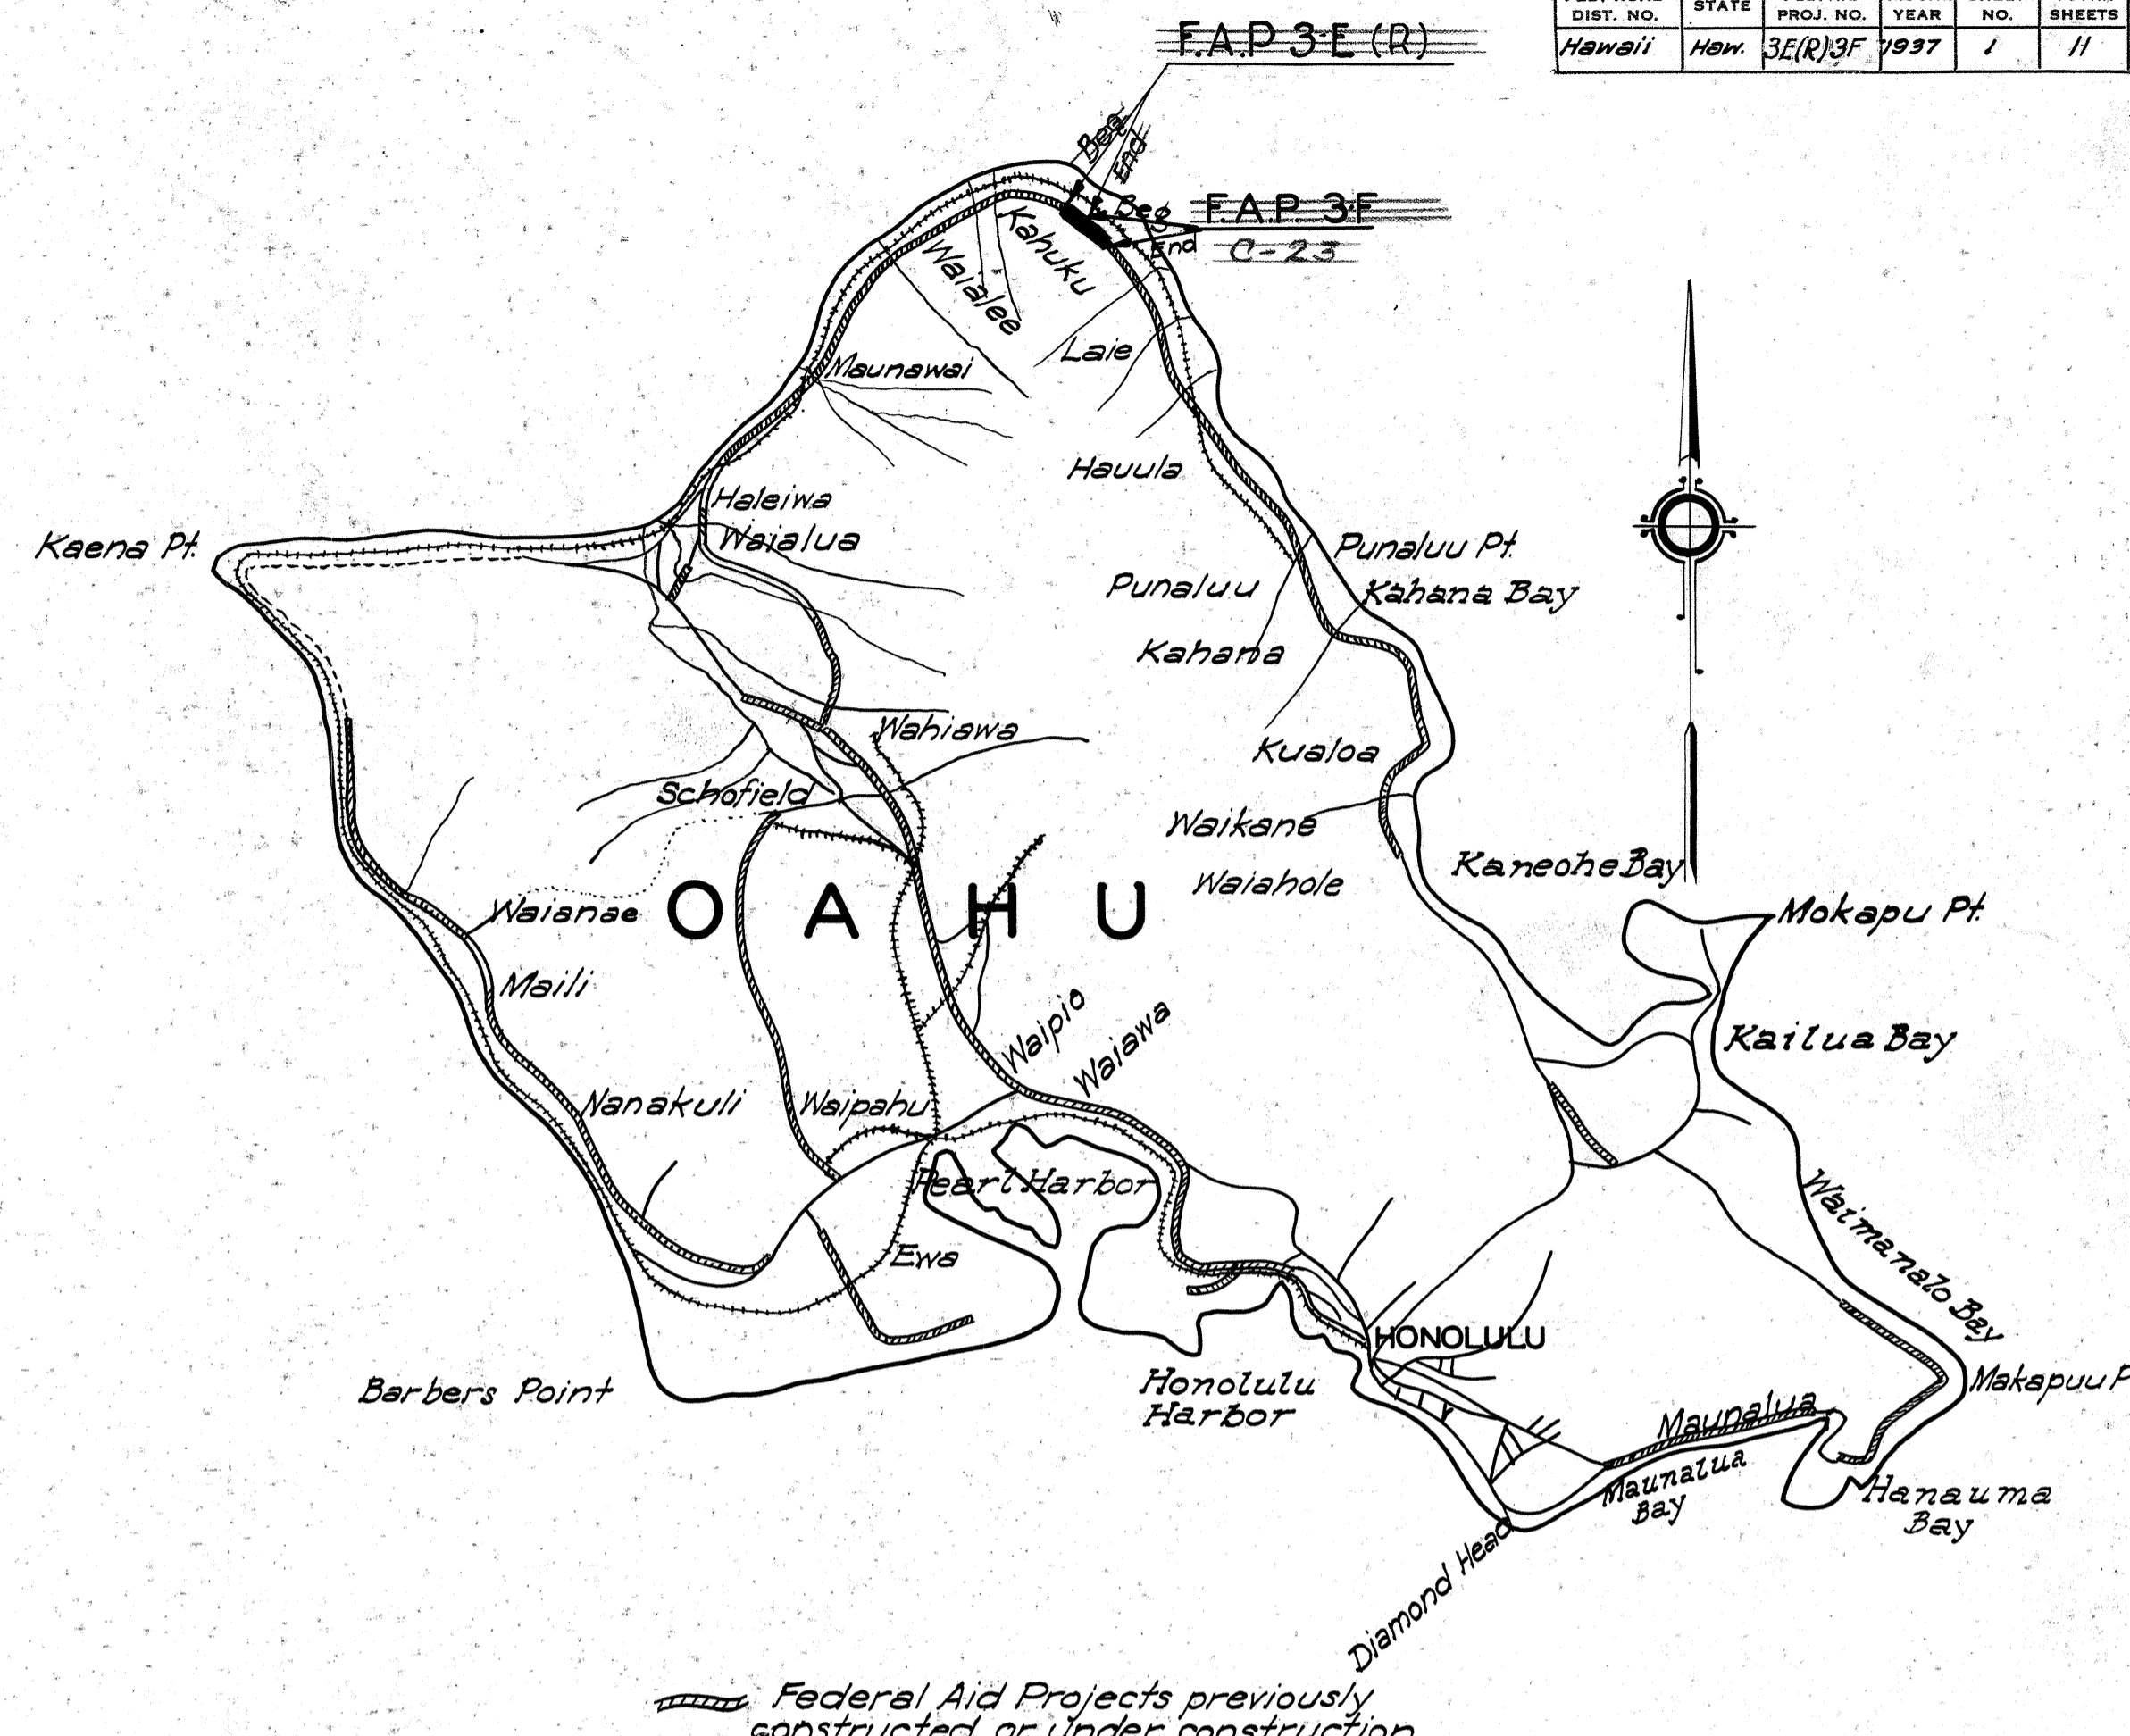


CONVENTIONAL SIGNS

Present Road	
Existing Fence	
Existing Stonewall	
Railroad Track	
Centerline	
Bridges	
Culverts	
Hedges	
Large Trees	

SCALE

PLAN	1 INCH	50 FEET
PROFILE	HOR. 1 INCH	50 FEET
	VERT. 1 INCH	10 FEET
CROSS SECTION	1 INCH	5 FEET

Note-This section was not constructed as a Federal-Aid-Project

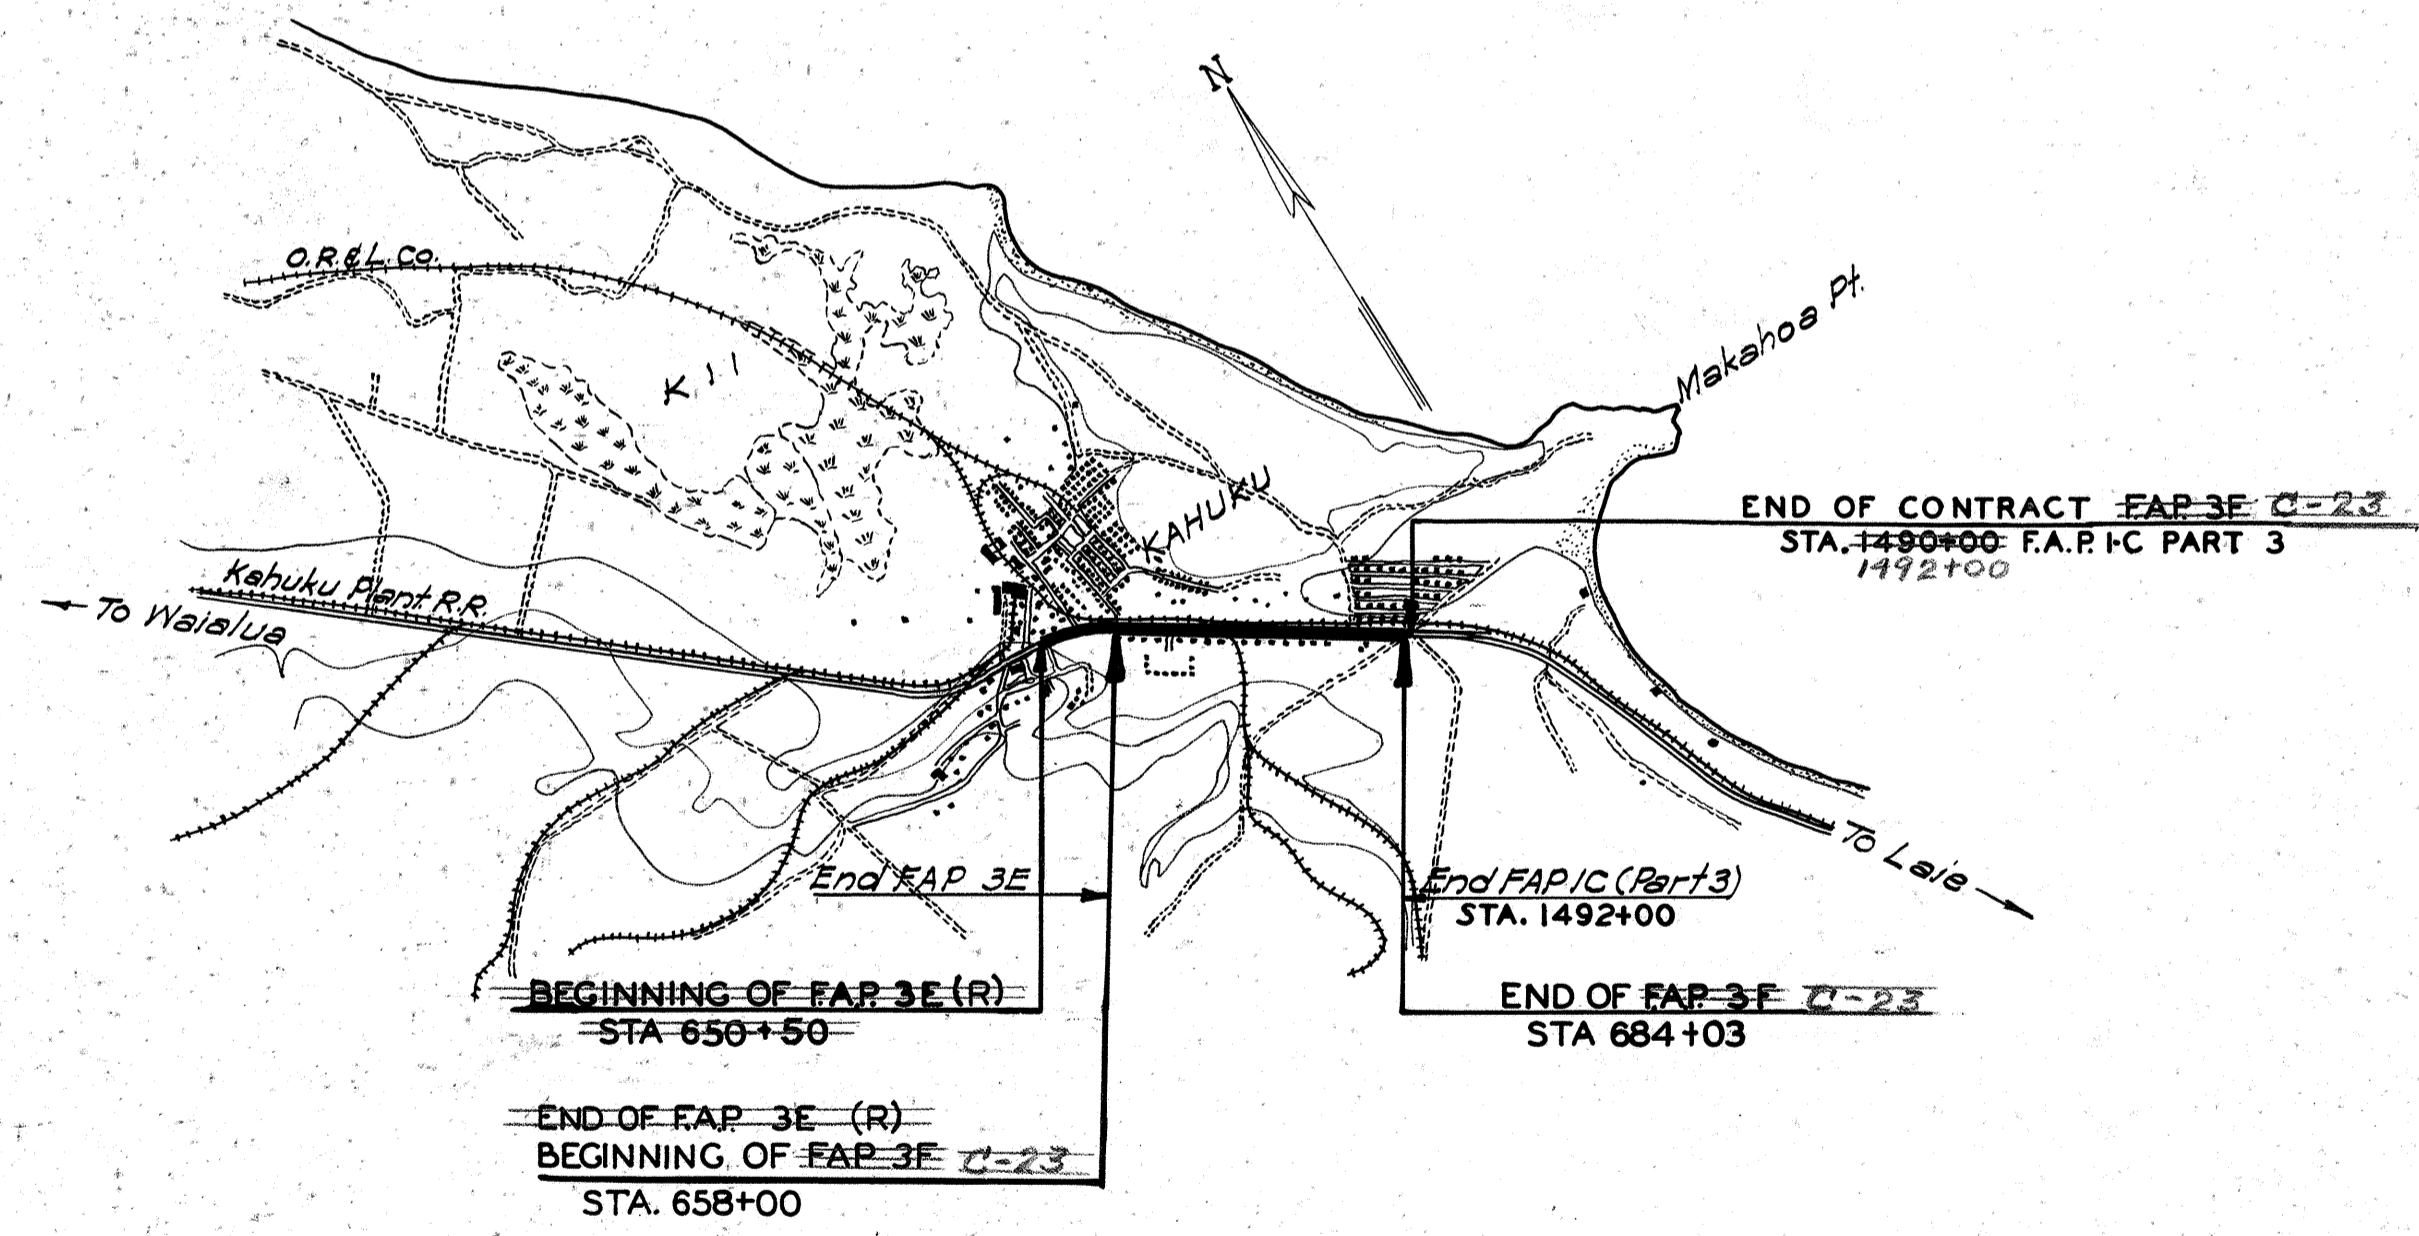

LAYOUT OF PROJECT
 Scale: 1:20000
~~Gross & Net Length Roadway = 0.742 Miles~~ ~~F.A.P. 3E(R)~~ ~~F.A.P. 3F~~
 0.493 Miles = C-23

SURVEY PLOTTED BY _____ DATE _____
 DESIGNED BY _____
 TRACED BY _____
 QUANTITIES BY _____
 CHECKED BY _____
 ORIGINAL PLAN NOTE BOOK No. _____

APPROVED

 Date: Dec. 6 1937
 TERRITORIAL HIGHWAY ENGINEER

RECOMMENDED FOR APPROVAL

 PRINCIPAL HIGHWAY ENGINEER, Bu. of Public Roads
 RECOMMENDED FOR APPROVAL

 CHIEF ENGINEER, Bureau of Public Roads
 APPROVED

 CHIEF, Bureau of Public Roads