
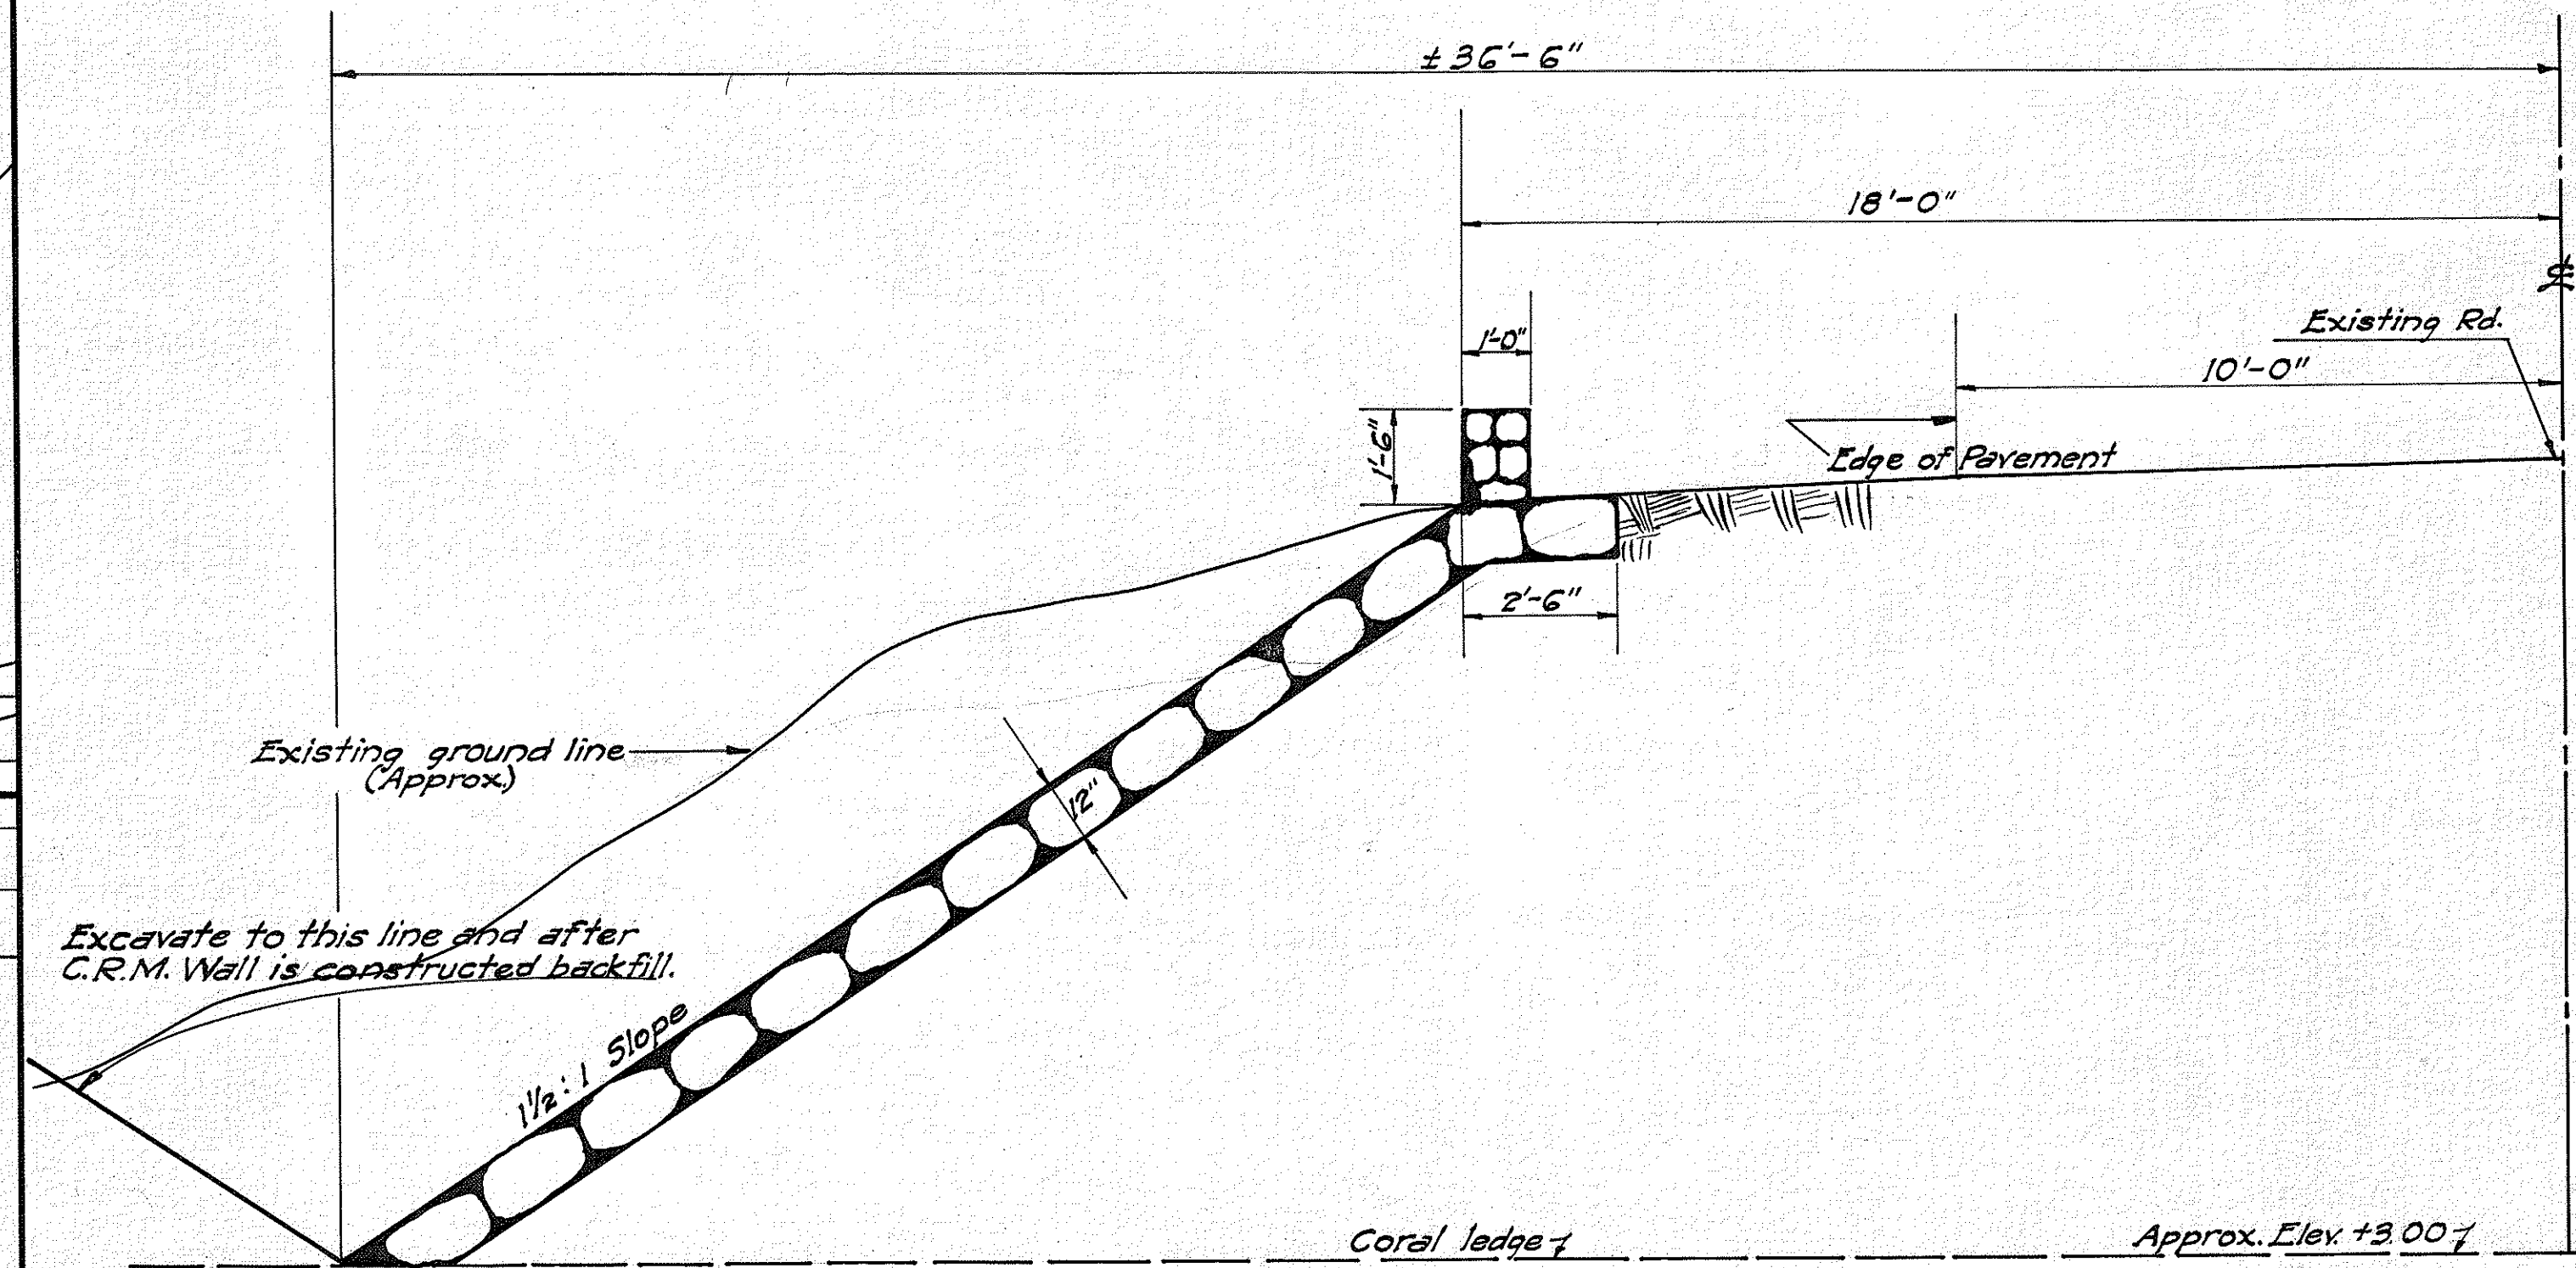


FED. ROAD DIST. NO.	STATE	FED. AID PROJ. NO.	FISCAL YEAR	SHEET NO.	TOTAL SHEETS
HAWAII	HAW.	FAP3-D(8)	1940	2	3

PLAN	SURVEYED	DATE
NOTE BOOK	ALIGNED	
NO.	BY	

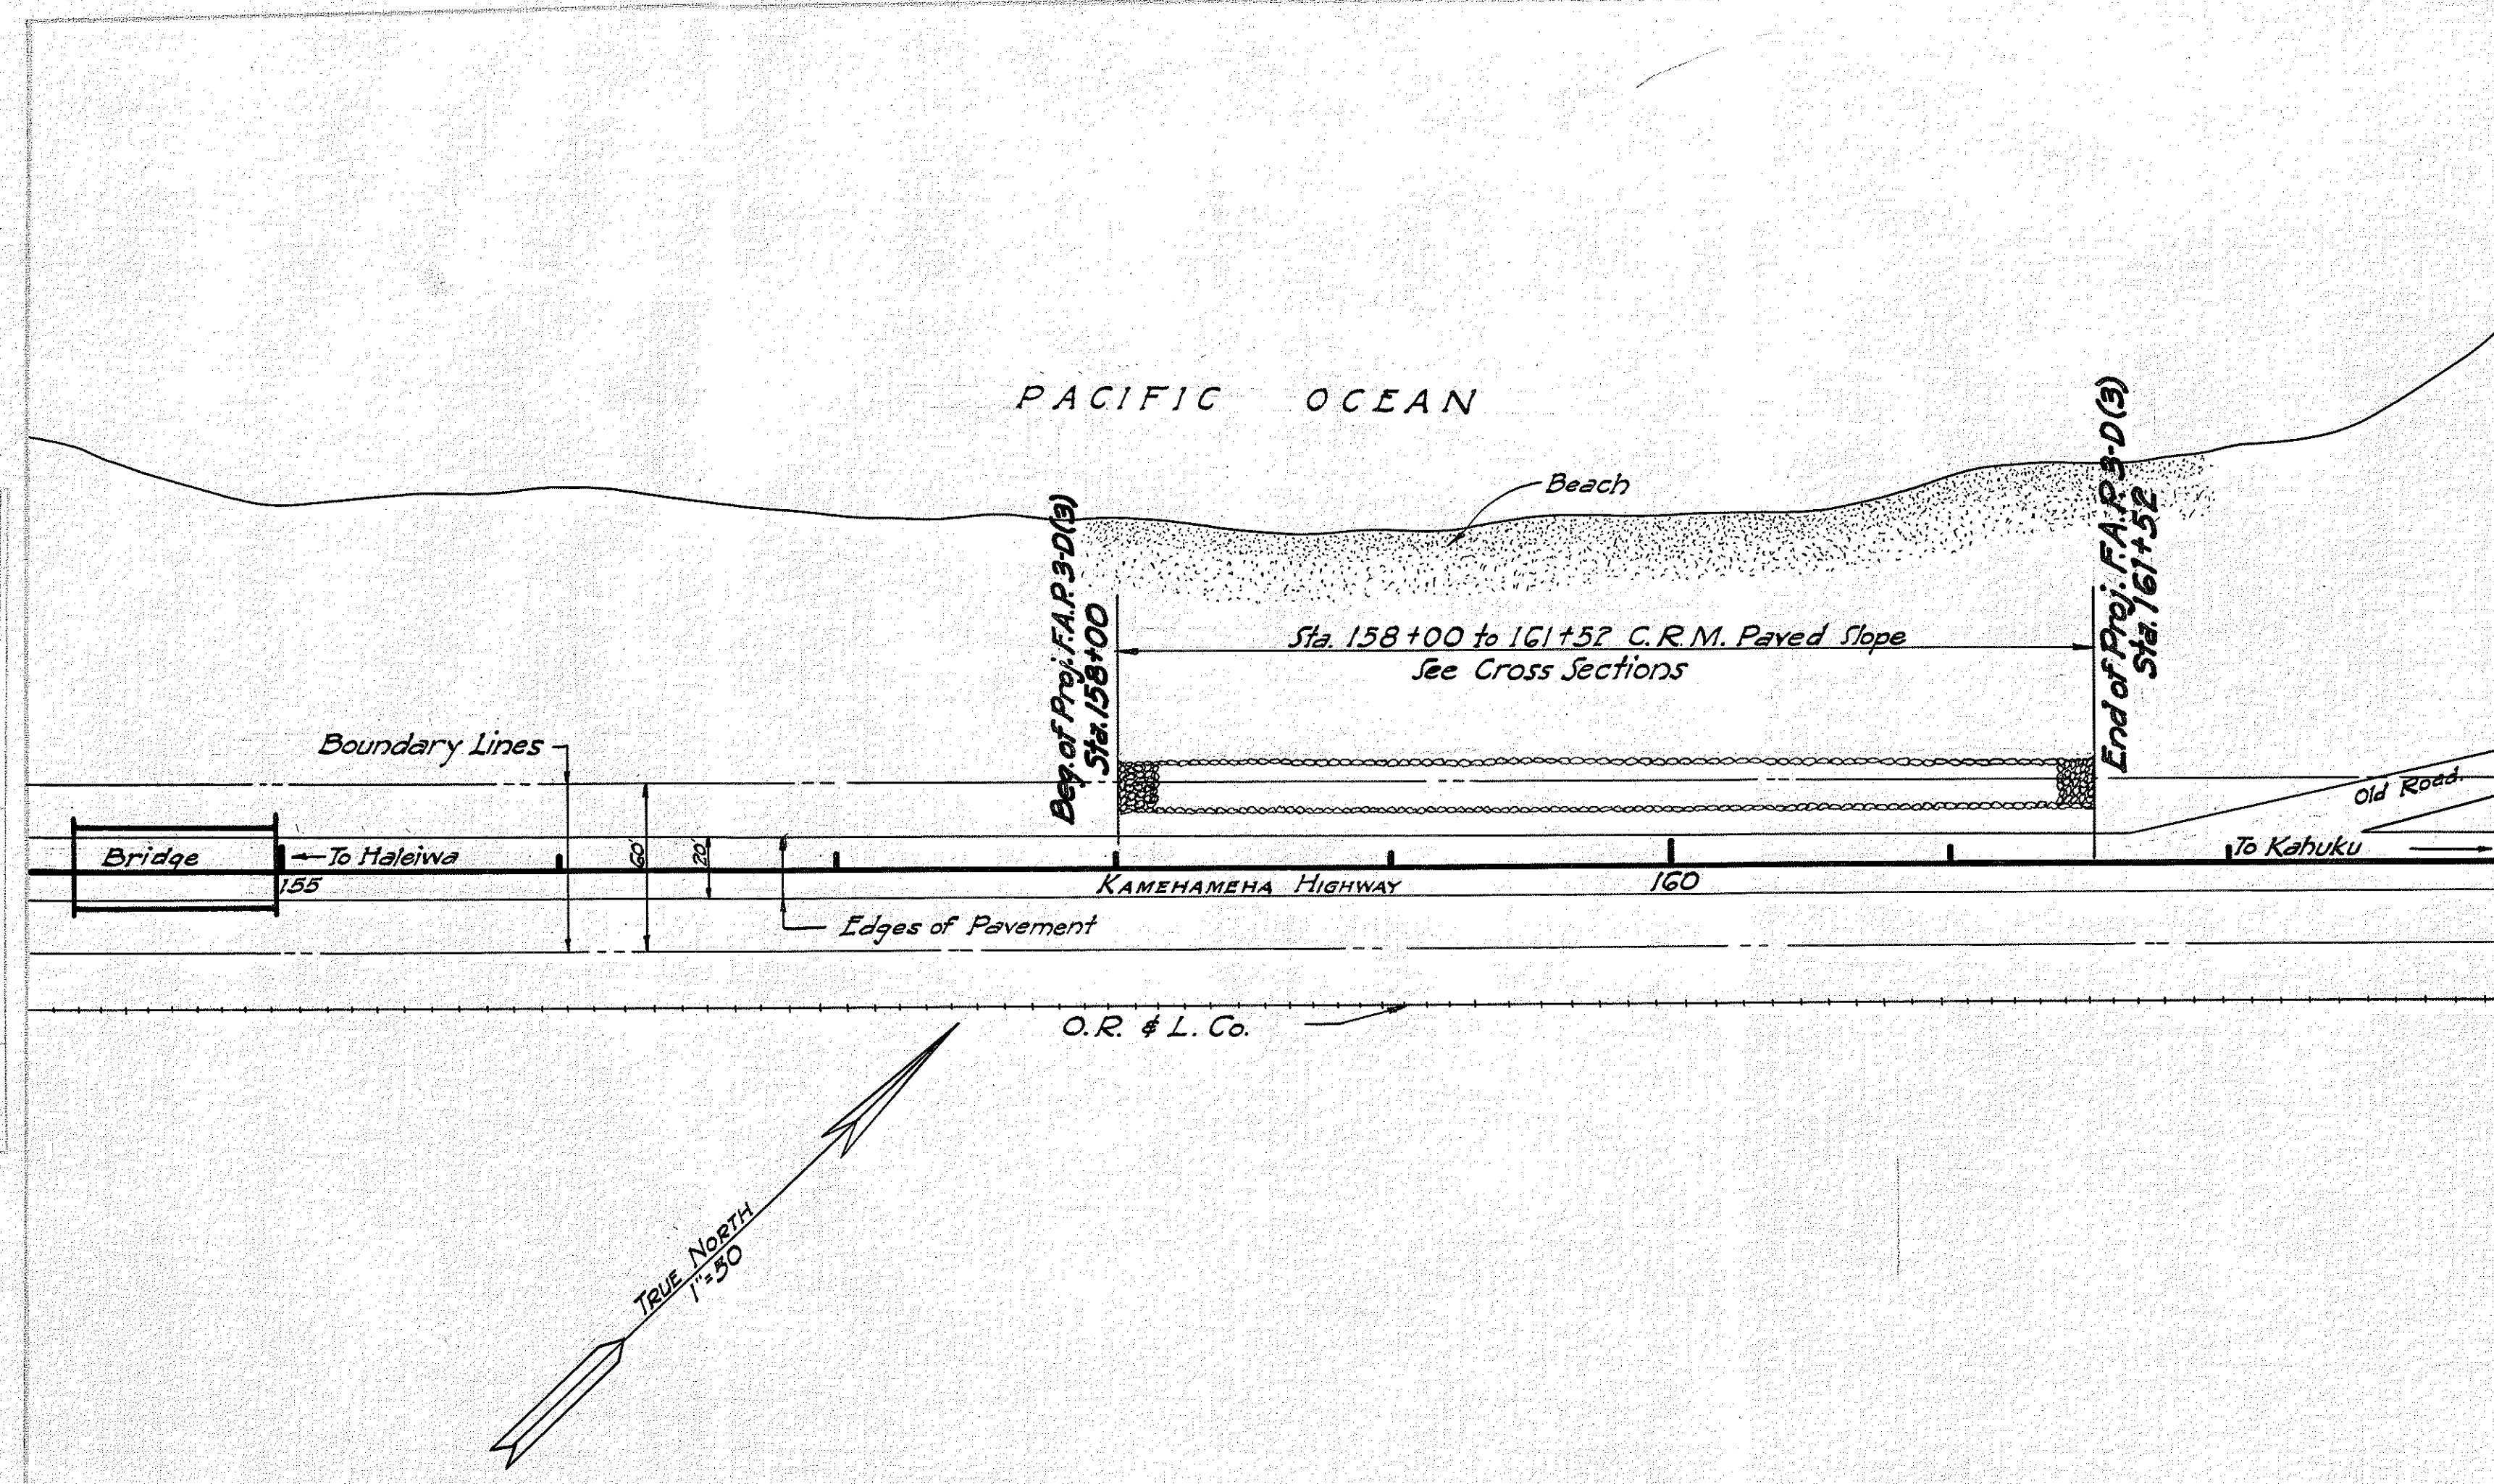

TYPICAL SECTION SHOWING
C.R.M. PAVING
SCALE = 3/8"=1'-0"

PROFILE	SURVEYED	DATE
NOTE BOOK	ALIGNED	
NO.	BY	

ESTIMATED QUANTITIES	
Excavation	1400 C.Y.
Embankment	125 C.Y.
C.R.M. Paving	327.2 C.Y.

5033.2