




TYPICAL SECTION AS ORIGINALLY CONSTRUCTED
COUNTY SECTION C21
Sta. 5+86 to Sta. 74+50
Scale: 3/8" = 1'-0"

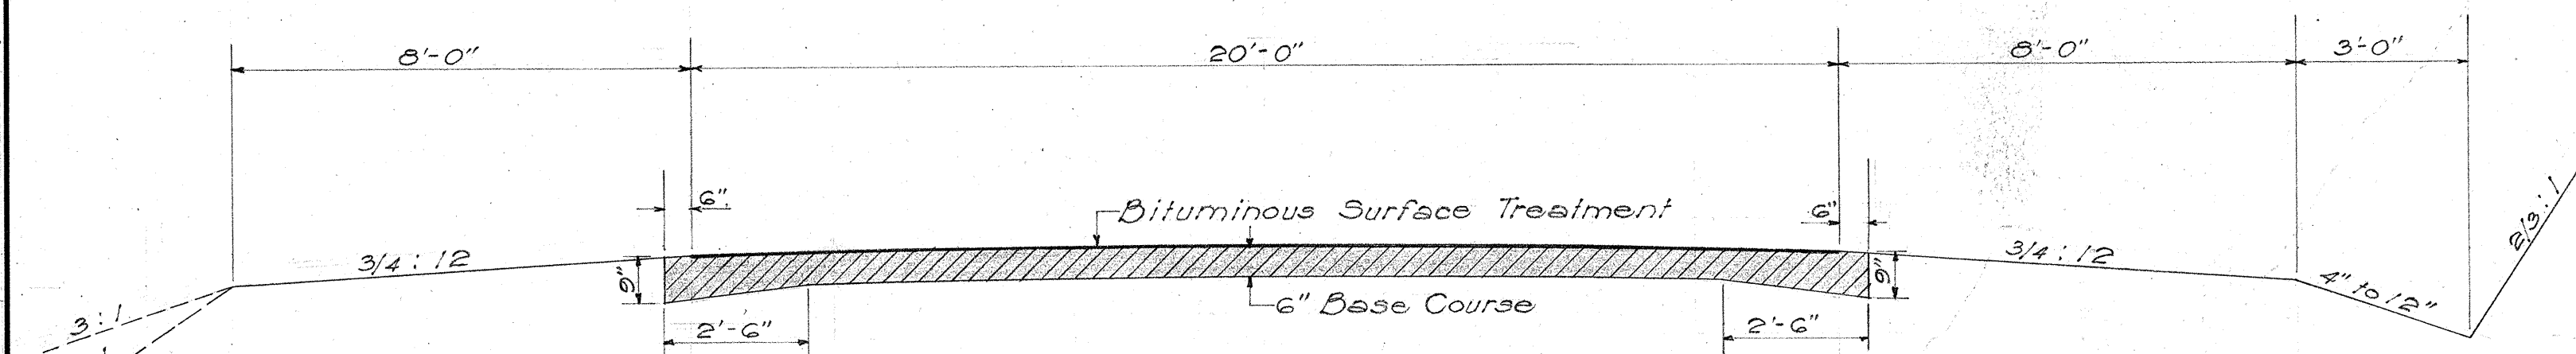


TYPICAL SECTION AS ORIGINALLY CONSTRUCTED
PROJECT No. FAP 3D
Sta. 74+50 to Sta. 212+08
Scale: 3/8" = 1'-0"

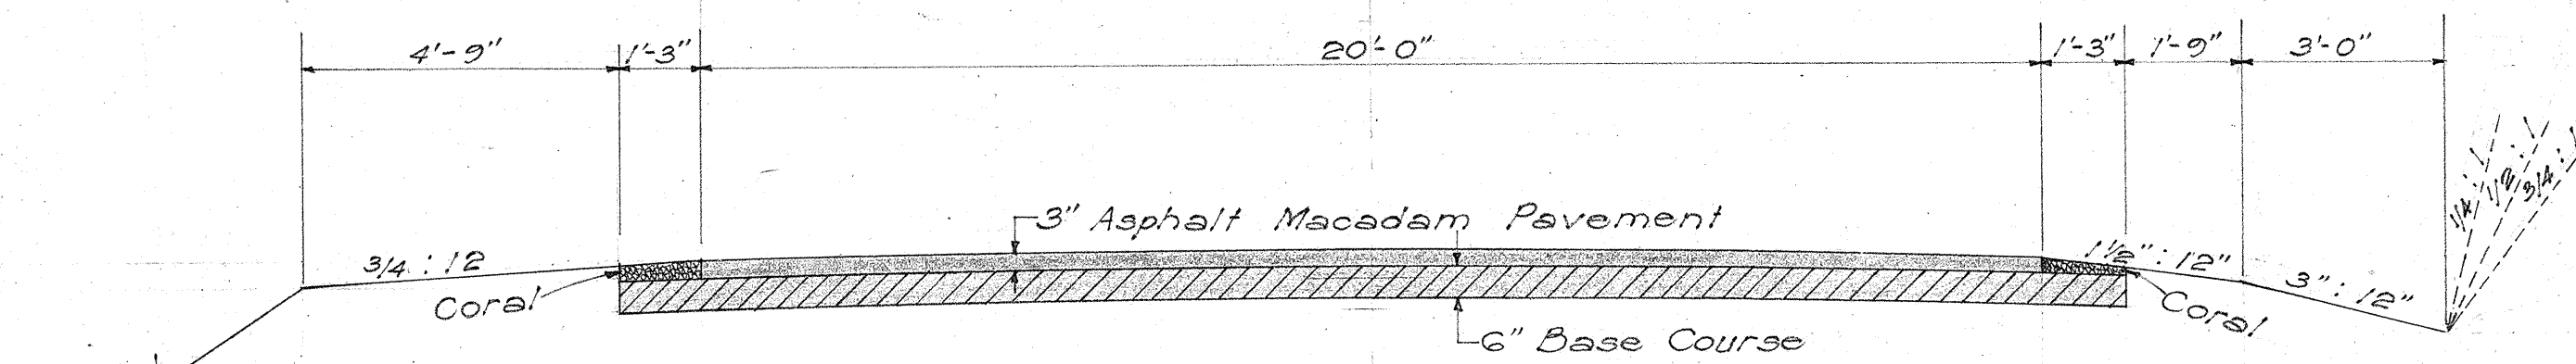

TYPICAL SECTION AS ORIGINALLY CONSTRUCTED
PROJECT No. FAP 3A
Sta. 61+00 to Sta. 321+00
Scale: 3/8" = 1'-0"

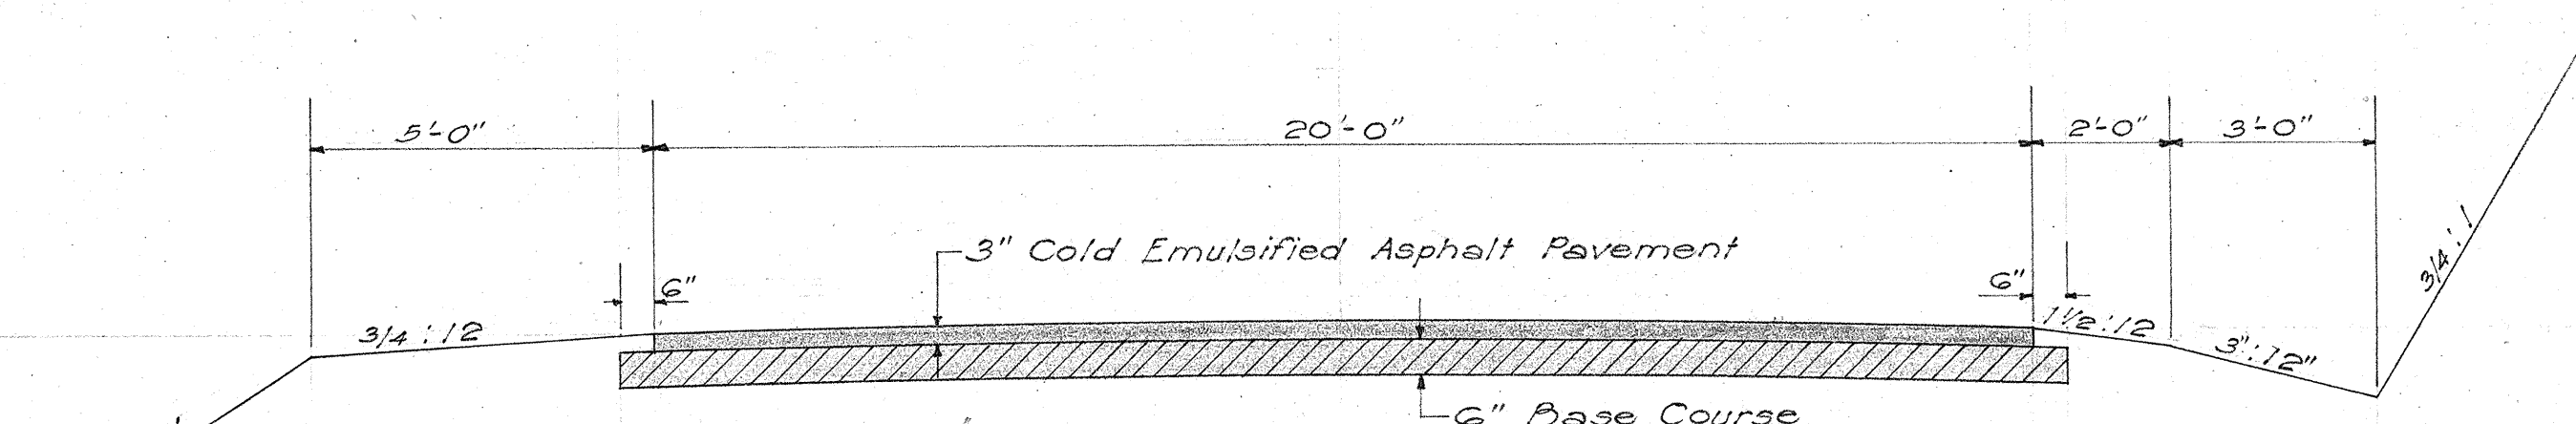


TYPICAL SECTION AS ORIGINALLY CONSTRUCTED
PROJECT No. FAP 3B
Sta. 321+00 to Sta. 376+00
Scale: 3/8" = 1'-0"

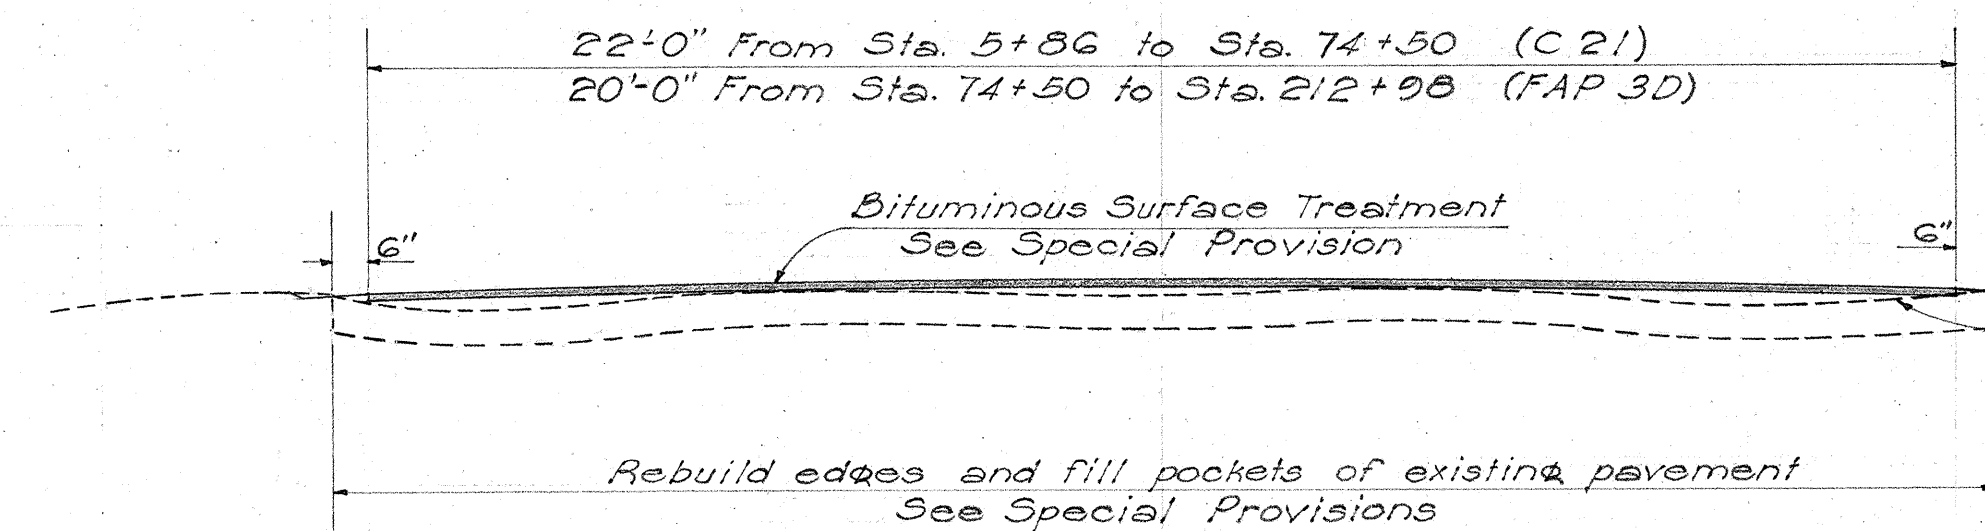

TYPICAL SECTION OF WORK TO BE DONE
BITUMINOUS SURFACE TREATMENT
Sta. 5+86 to Sta. 212+08
Scale: 3/8" = 1'-0"

NOTE:
 No shoulder grading to be performed under this contract.

Existing surface variable. Surface indicated here is entirely imaginary and not intended to represent any specific place.

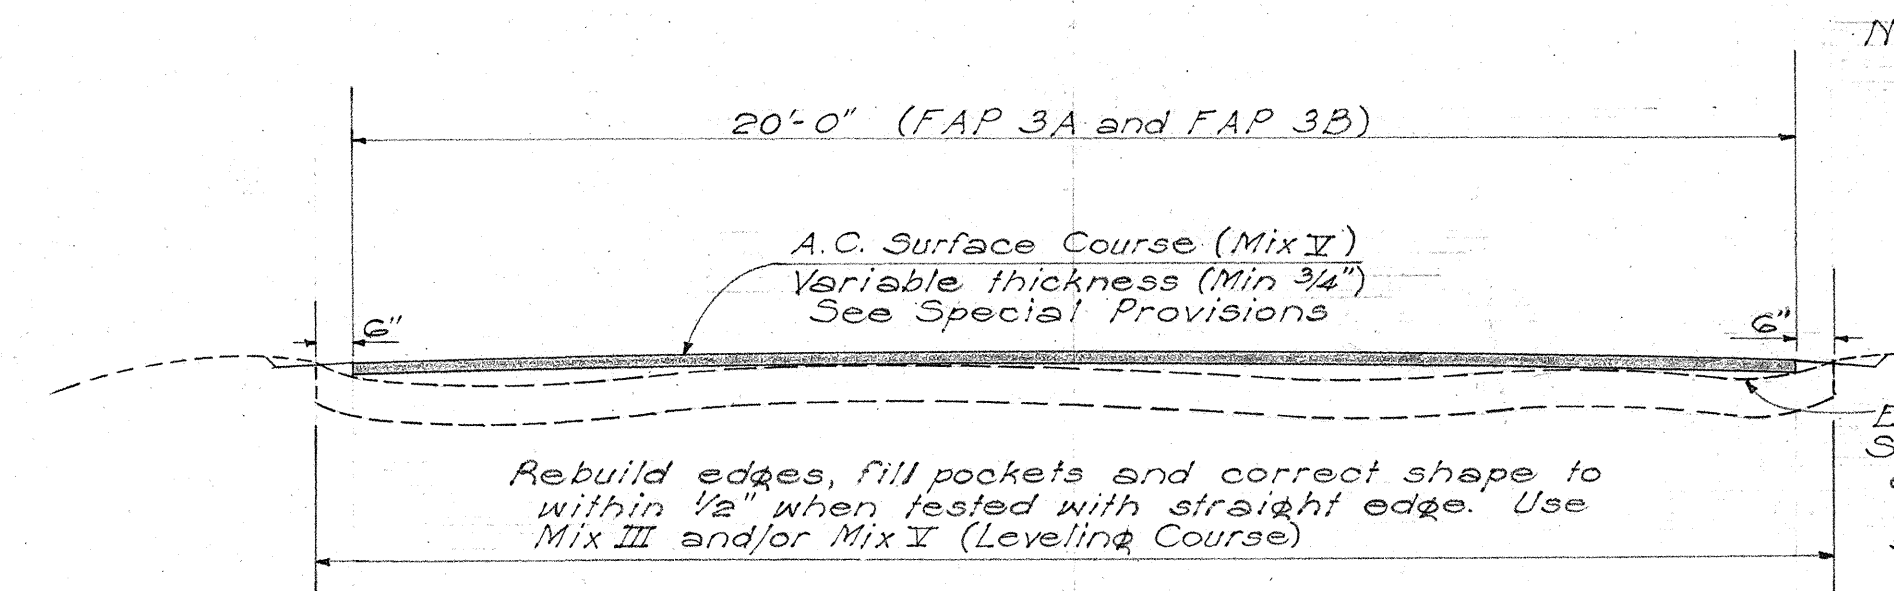

TYPICAL SECTION OF WORK TO BE DONE
ASPHALT CONCRETE RESURFACING
Sta. 61+00 to Sta. 376+00
Scale: 3/8" = 1'-0"

NOTE:
 No shoulder grading to be performed under this contract.

Existing surface variable. Surface indicated here is entirely imaginary and not intended to represent any specific place.

TERRITORIAL HIGHWAY DEPARTMENT
 TERRITORY OF HAWAII

TYPICAL SECTIONS
KAMEHAMEHA HIGHWAY
PROJECT No. WDR 3(1)

Scale: As noted Oct. 1948

SHEET NO. OF SHEETS

5363.2