
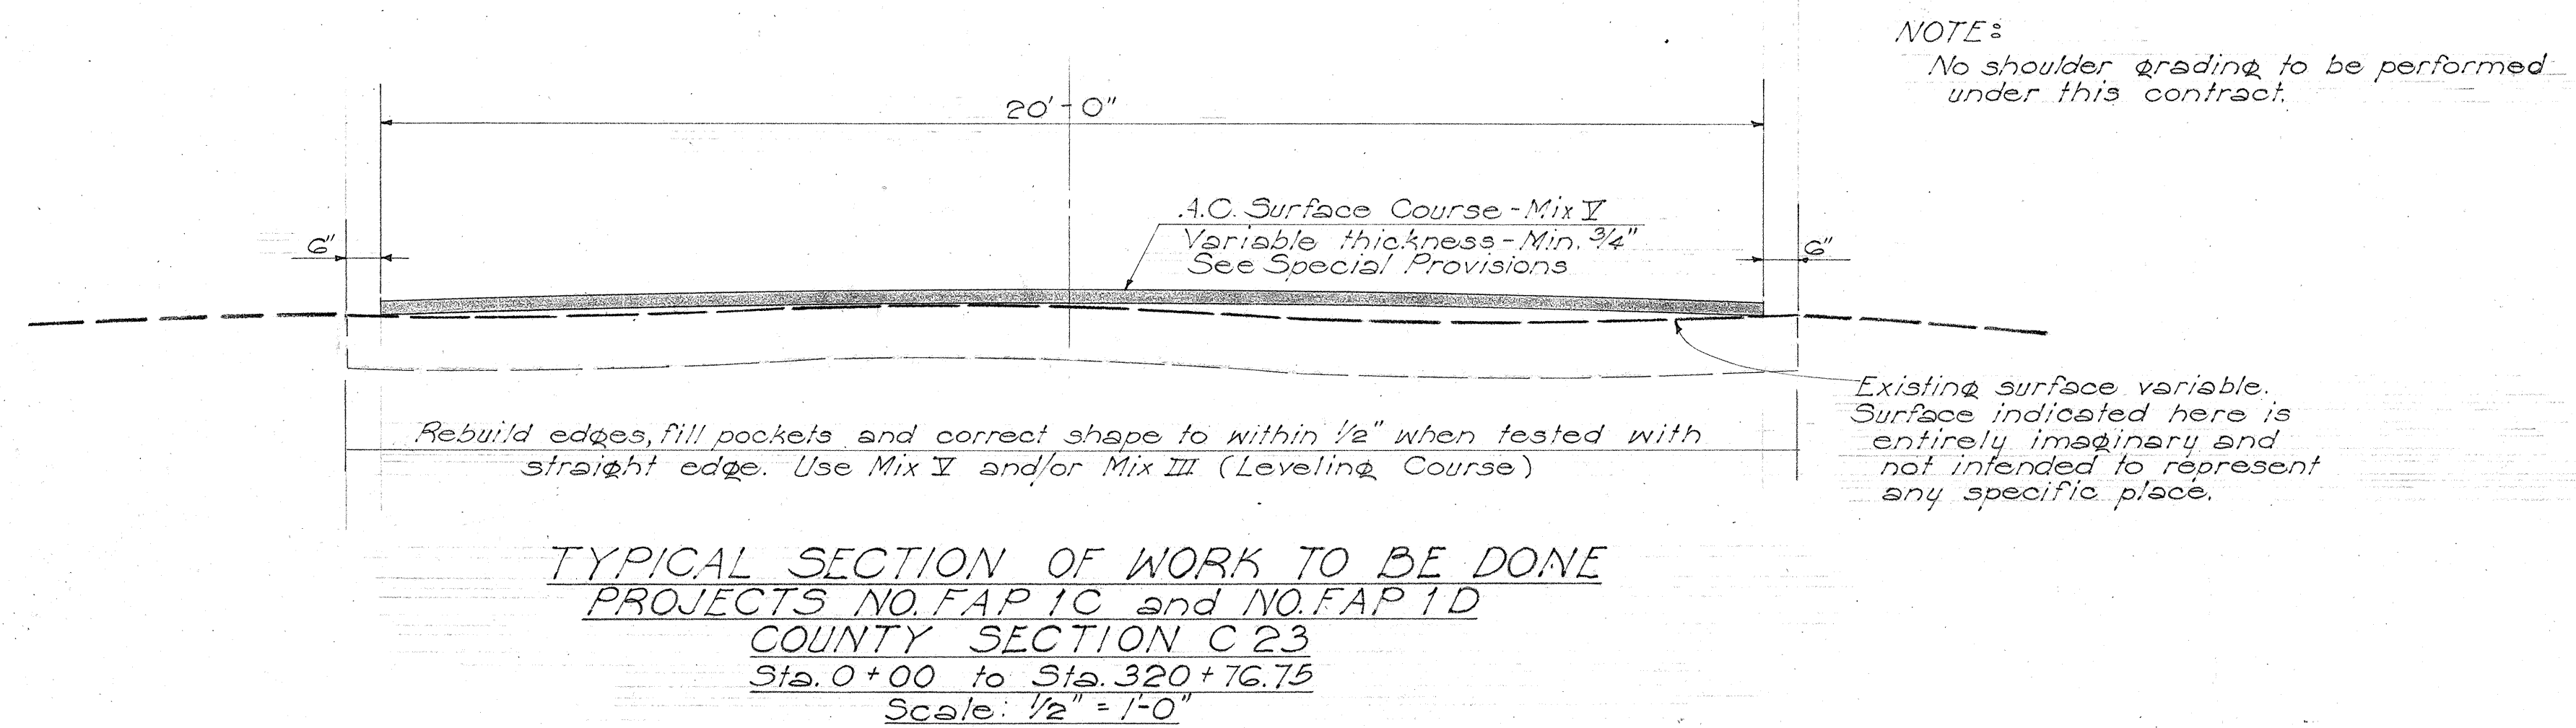
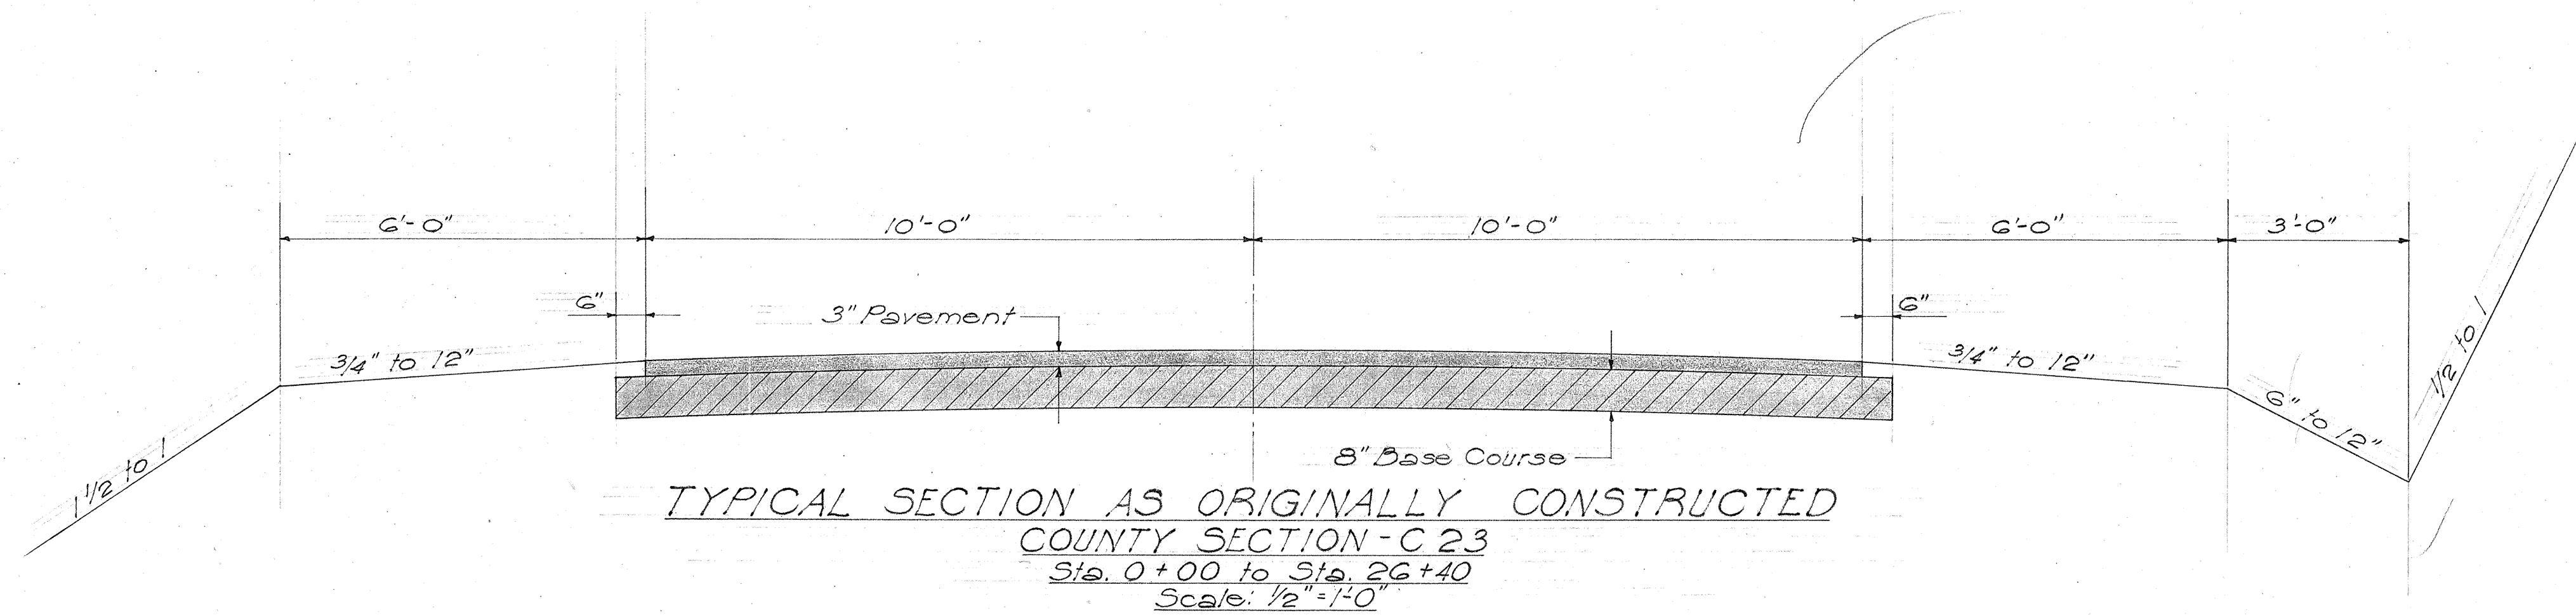


FED. ROAD DIST. NO.	STATE	FED. AID PROJ. NO.	FISCAL YEAR	SHEET NO.	TOTAL SHEETS
HAWAII	HI	WDR 15(1)	1949	2	2

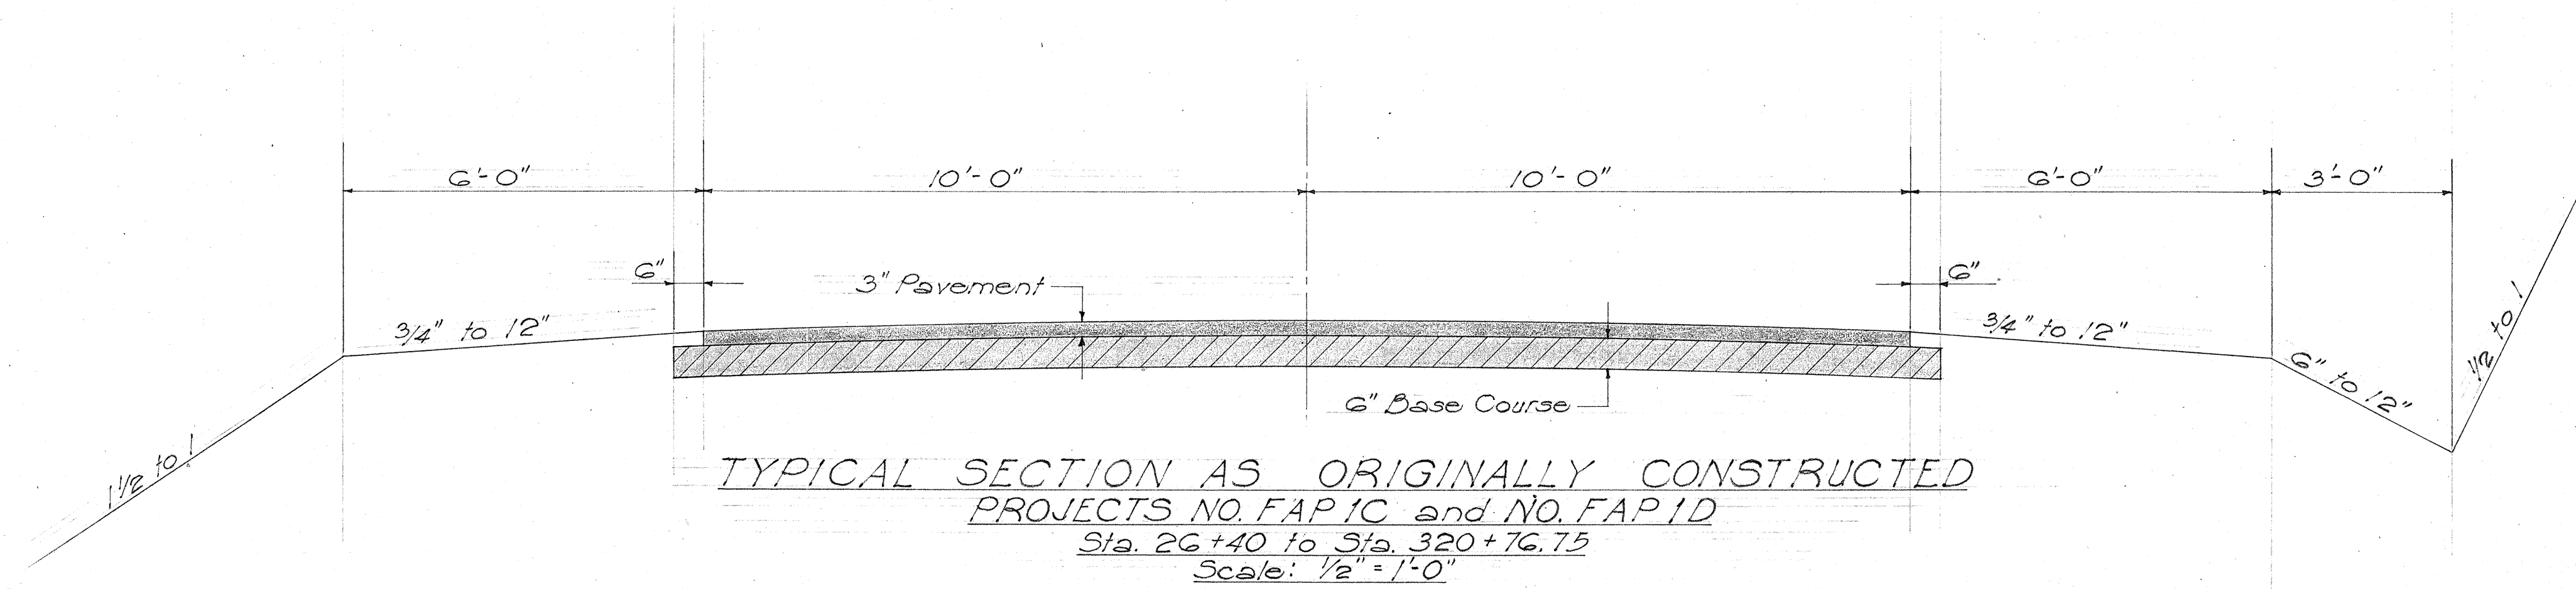

NOTE:
 No shoulder grading to be performed under this contract.

TERRITORIAL HIGHWAY DEPARTMENT
 TERRITORY OF HAWAII
TYPICAL SECTIONS
 KAMEHAMEHA HIGHWAY
 Kahuku to Hauula
 PROJECT NO. WDR 15(1)
 Scale: As noted Feb. 1949

SHEET No. OF SHEETS

5393.2

TERRITORIAL HIGHWAY DEPARTMENT

ORIGINAL PLAN	DATE
DESIGNED BY	
TRACED BY	
QUANTITIES BY	
CHECKED BY	
NOTE BOOK No.	