


INDEX TO DRAWINGS	
SHEET NO.	DESCRIPTION
1	TITLE SHEET
2-3	TYPICAL SECTION
4-6	PLAN & PROFILE
7	KANEOHE STREAM RELOC.
8-9	HIGHWAY LIGHTING SYSTEM
10-13	KANEOHE WATER SYSTEM
14-18	STANDARD DETAILS
19	STANDARD BRIDGE DETAIL
20-29	KANEOHE BRIDGE
30-42	CROSS SECTIONS


CONVENTIONAL SIGNS	
Centerline.....	125
Boundary Lines.....	or
Fences (Named).....	
Existing Roadways.....	
Circular Culvert.....	
Box Culvert.....	
Bridge.....	
Telephone Pole.....	T.P.
Electric Power Pole.....	E.P.P.
Water Main.....	W ₂ (W ₄ , 8, 12, Etc.)
Storm Drain.....	SD ₁₂ (SD ₁₈ , 24, Etc.)
Concrete Drop Intake.....	C.D.I.
Standard Catch Basin.....	S.C.B.
Standard Manhole.....	M.H.S.
Sewer Manhole.....	S.M.H.
Telephone Manhole.....	T.M.H.
Fire Hydrant.....	F.H.
Tree (Large, named).....	Mango
Railroad.....	

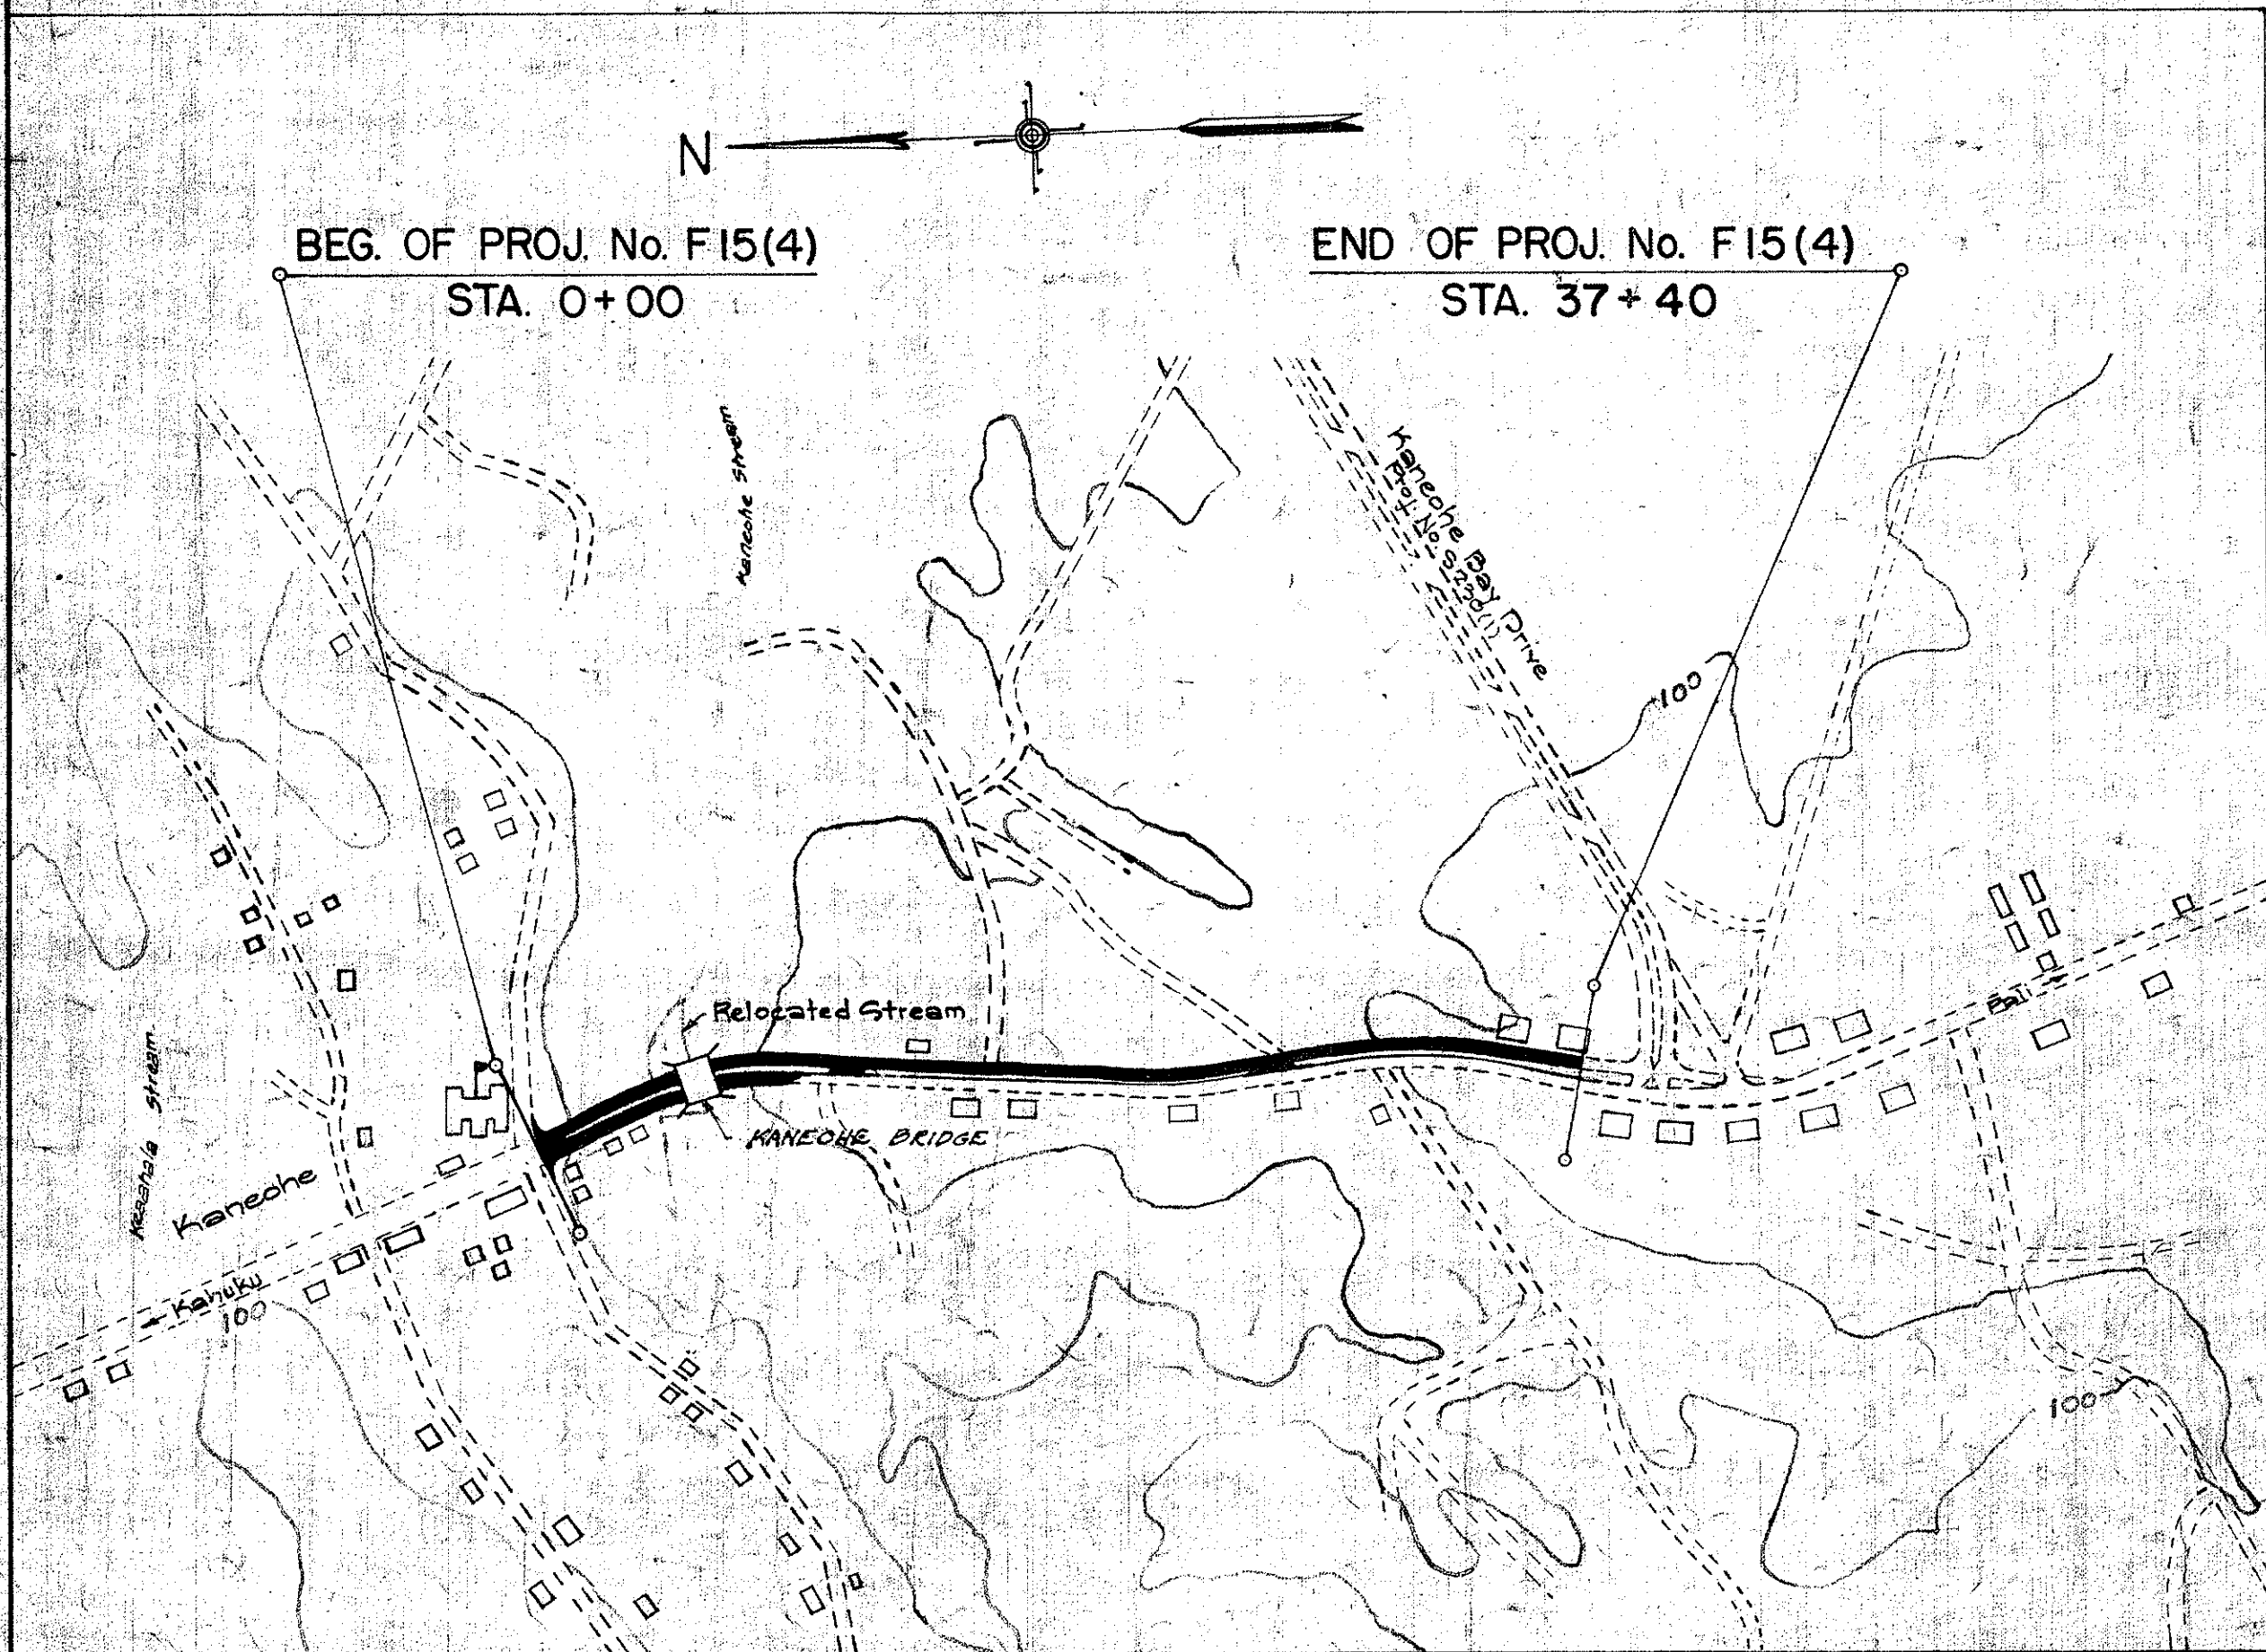

TERRITORY OF HAWAII
TERRITORIAL HIGHWAY DEPARTMENT
HONOLULU, OAHU, T. H.

PLANS OF KAMEHAMEHA HIGHWAY FEDERAL AID PROJECT No. F15(4) DISTRICT OF KOOLAUPOKO ISLAND OF OAHU

SCALES	
PLAN	1 INCH = 50 FT.
PROFILE	HOR. 1 INCH = 50 FT. VER. 1 INCH = 10 FT.
CROSS SECTION	HOR. 1 INCH = 10 FT. VER. 1 INCH = 10 FT.

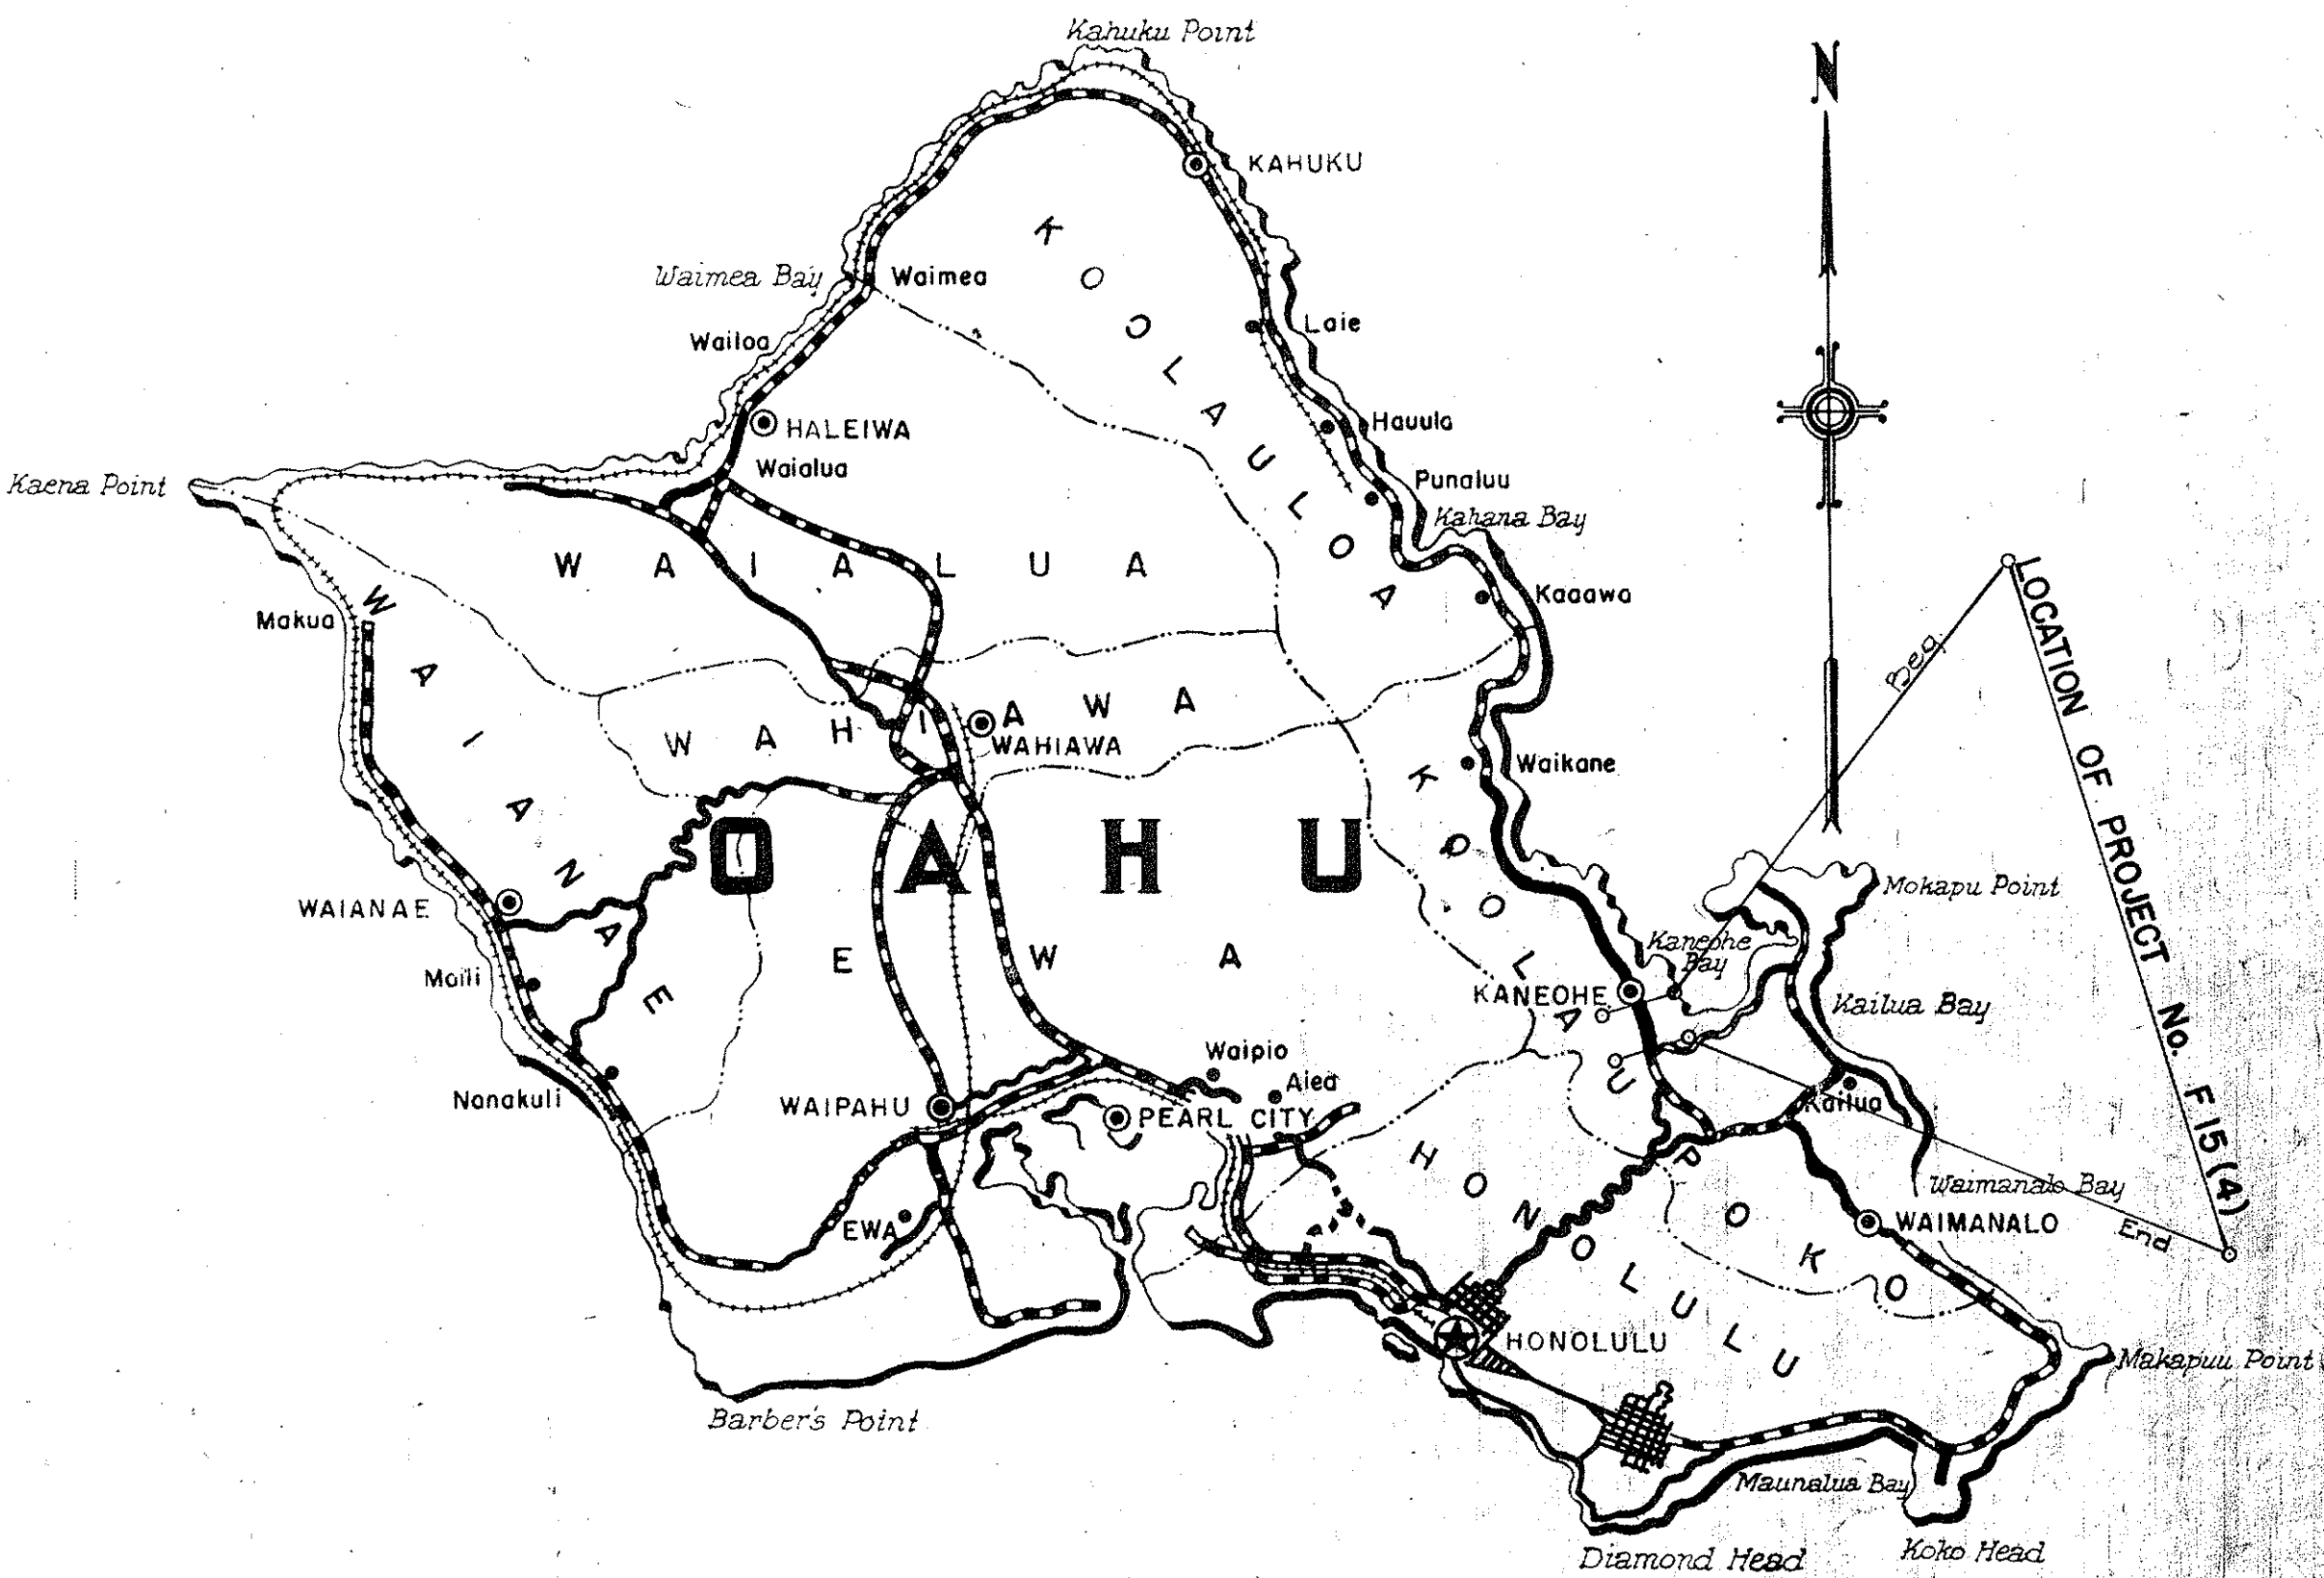

Federal Aid Projects Previously Constructed Or Under Construction

NOTE:
All changes made during construction have been noted in red on these tracings and checked
By: *[Signature]*
Project Engineer
Date: 12-5-51

LAYOUT OF PROJECT SCALE: 1" = 576'

GROSS LENGTH OF PROJECT	0.708 MILES
BRIDGES OVER 20' SPAN	0.018 MILES
NET LENGTH OF ROADWAY	0.690 MILES

APPROVED *[Signature]* DATE 12-5-51
TERRITORIAL HIGHWAY ENGINEER

DEPARTMENT OF COMMERCE
BUREAU OF PUBLIC ROADS
RECOMMENDED FOR APPROVAL
DISTRICT ENGINEER DATE
APPROVED
DIVISION ENGINEER DATE