
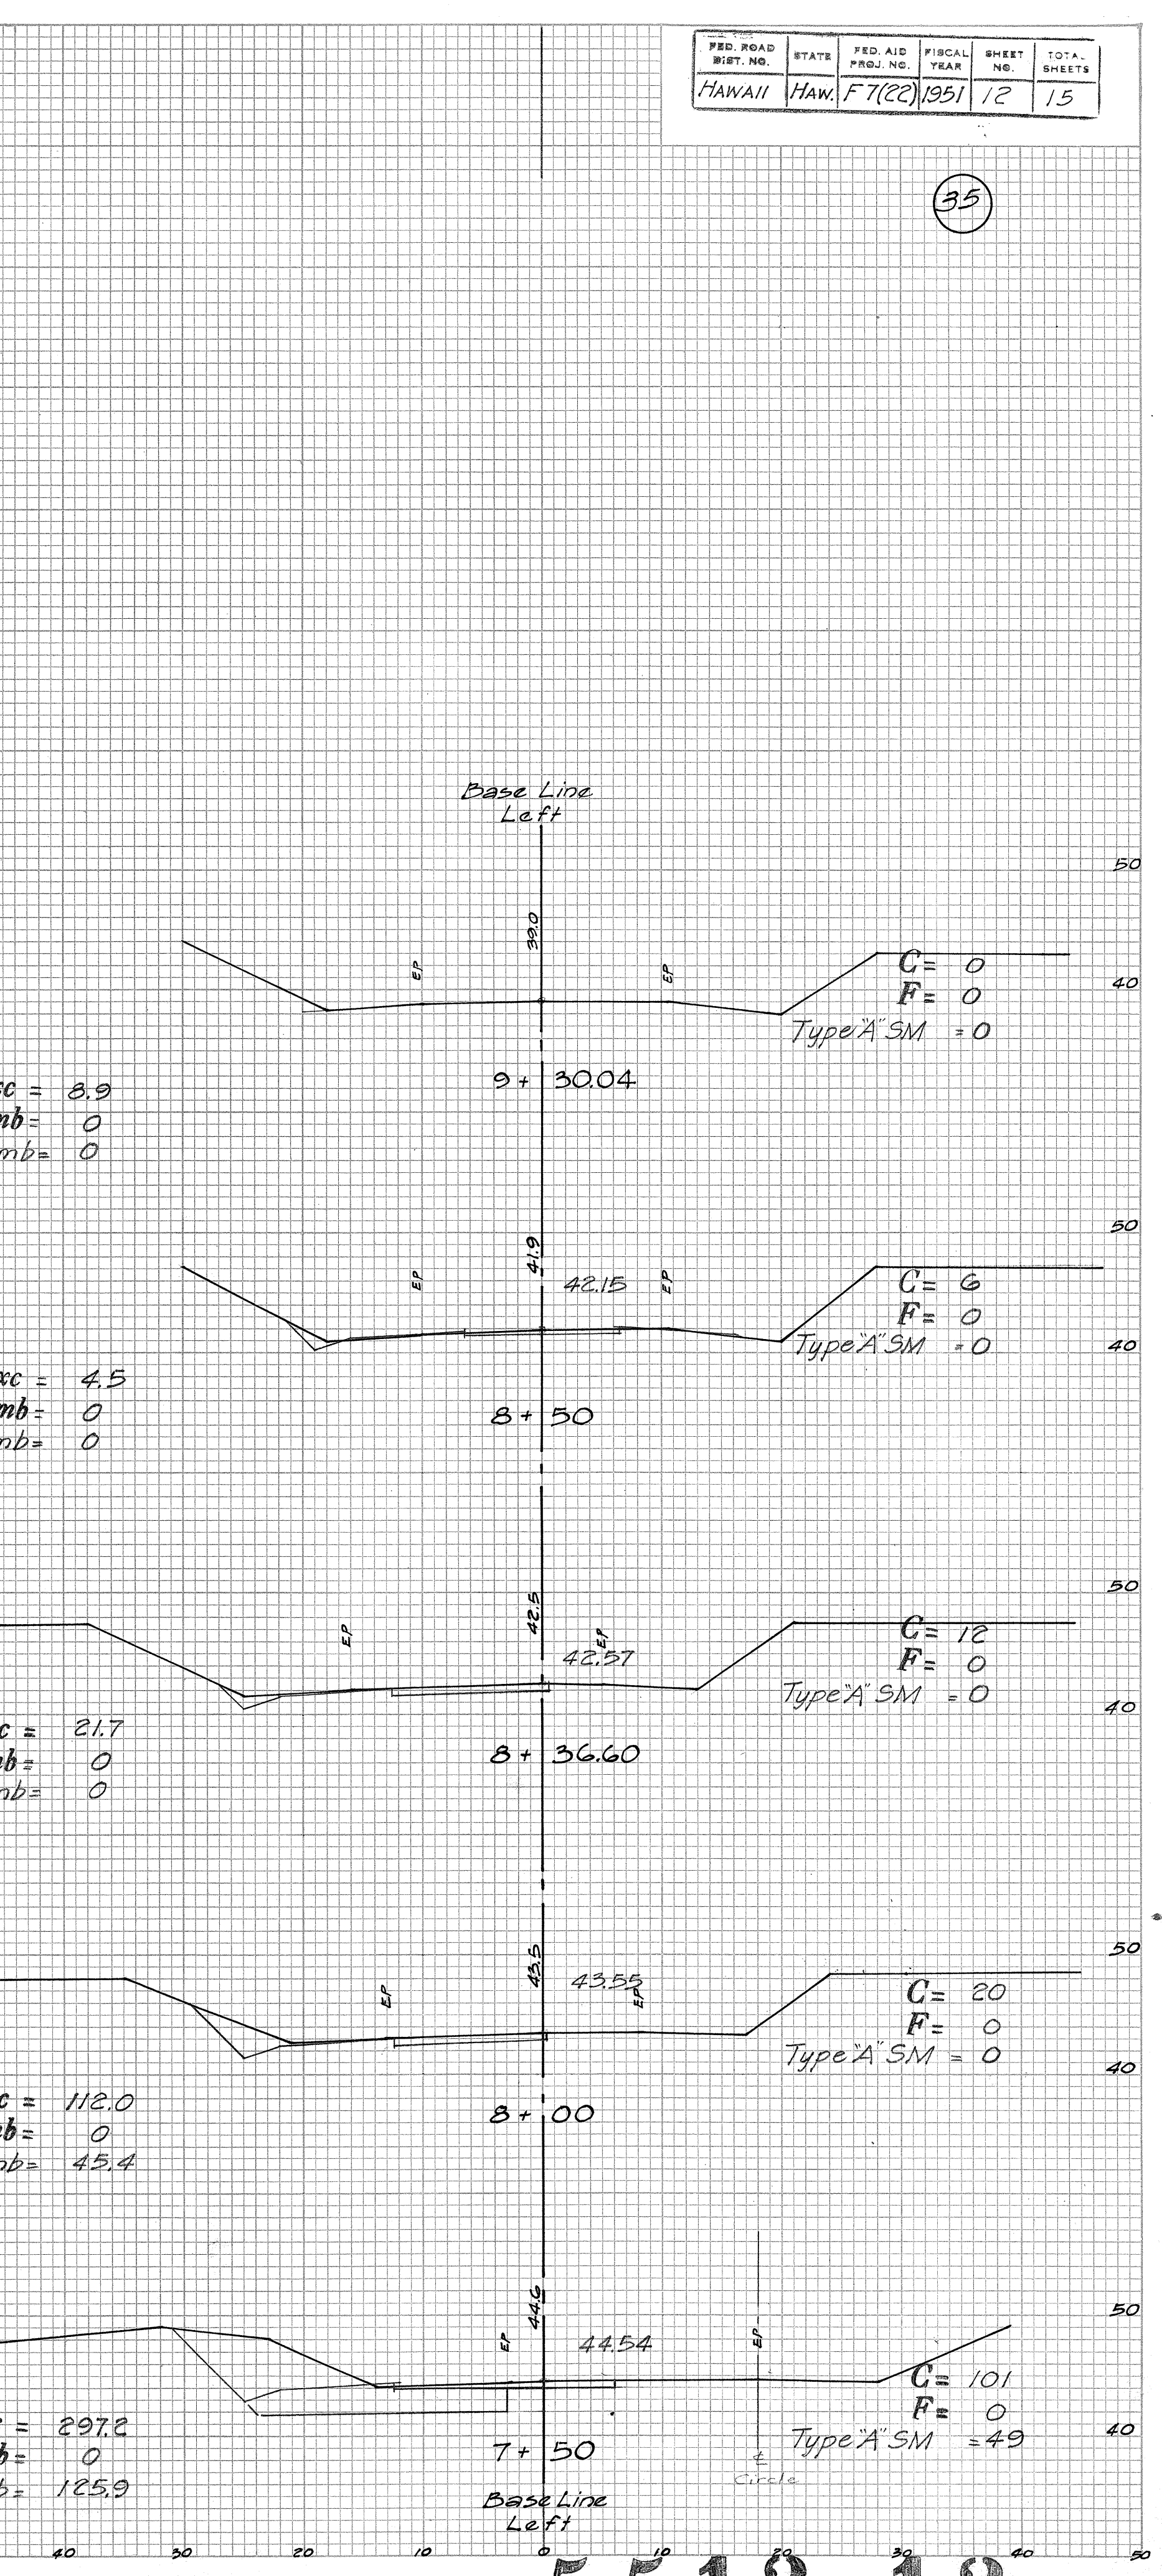
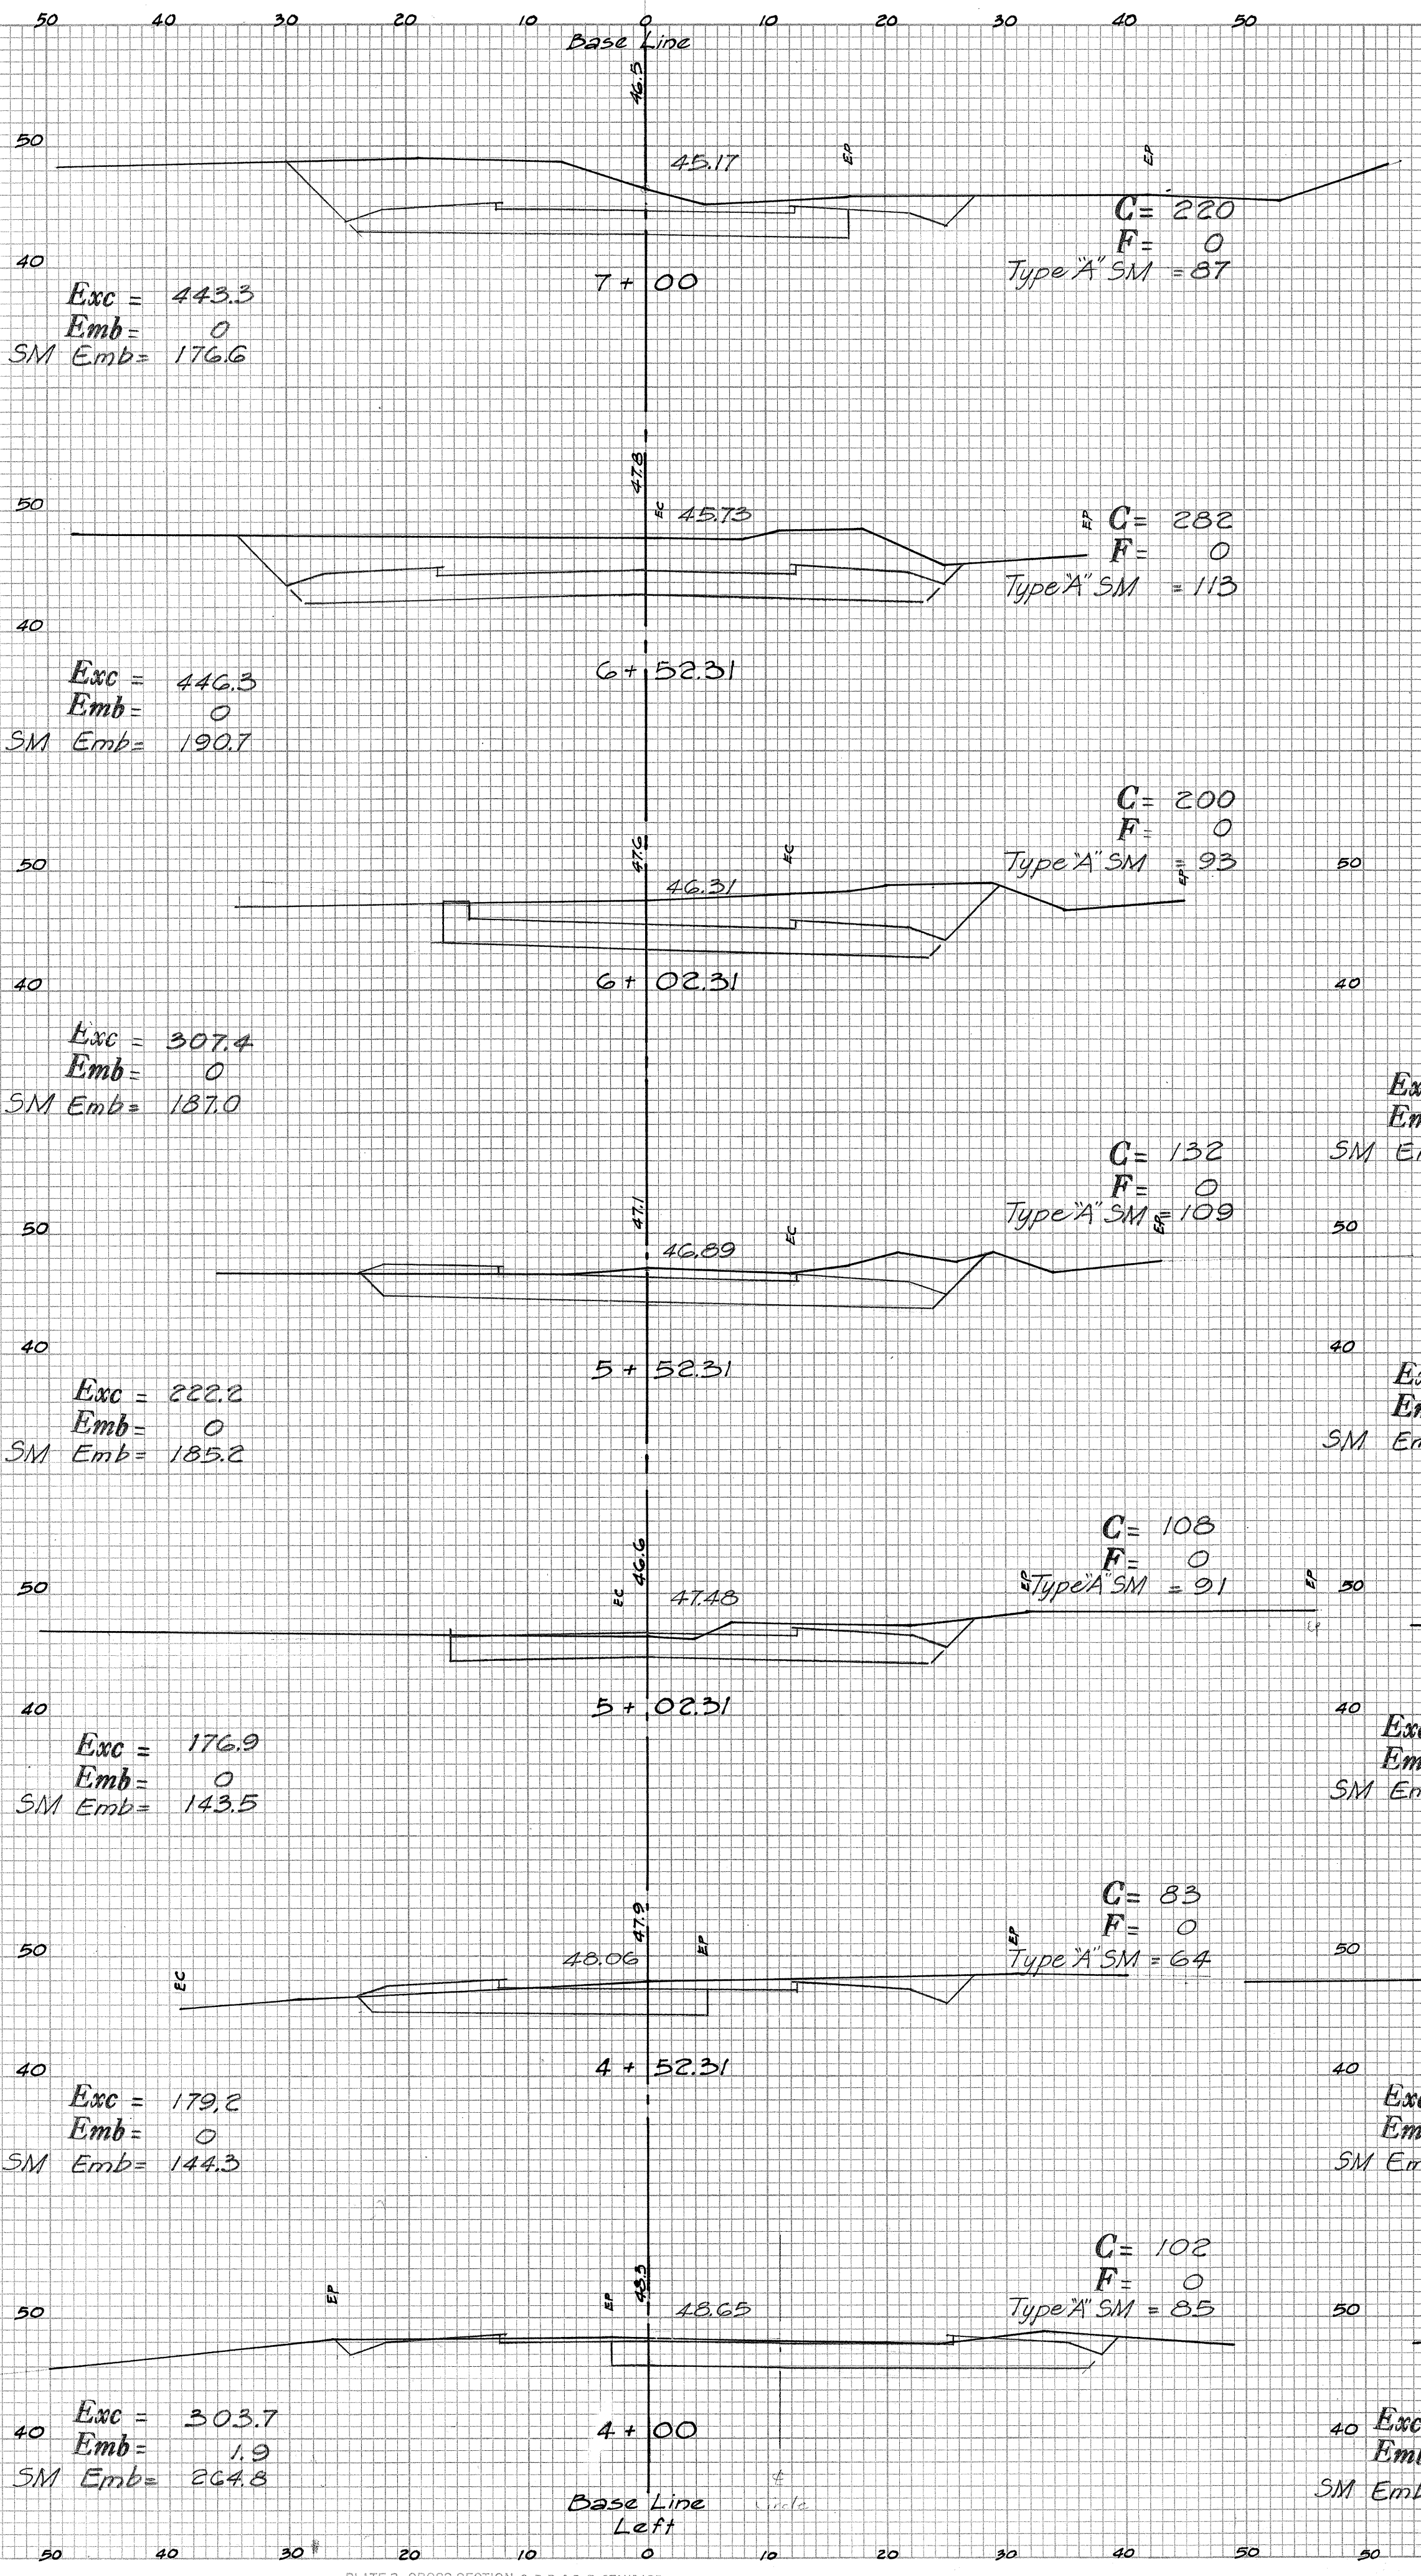


35

FINAL SURVEY
DATE
BY
NO.




ORIGINAL SURVEY
DATE
BY
NO.

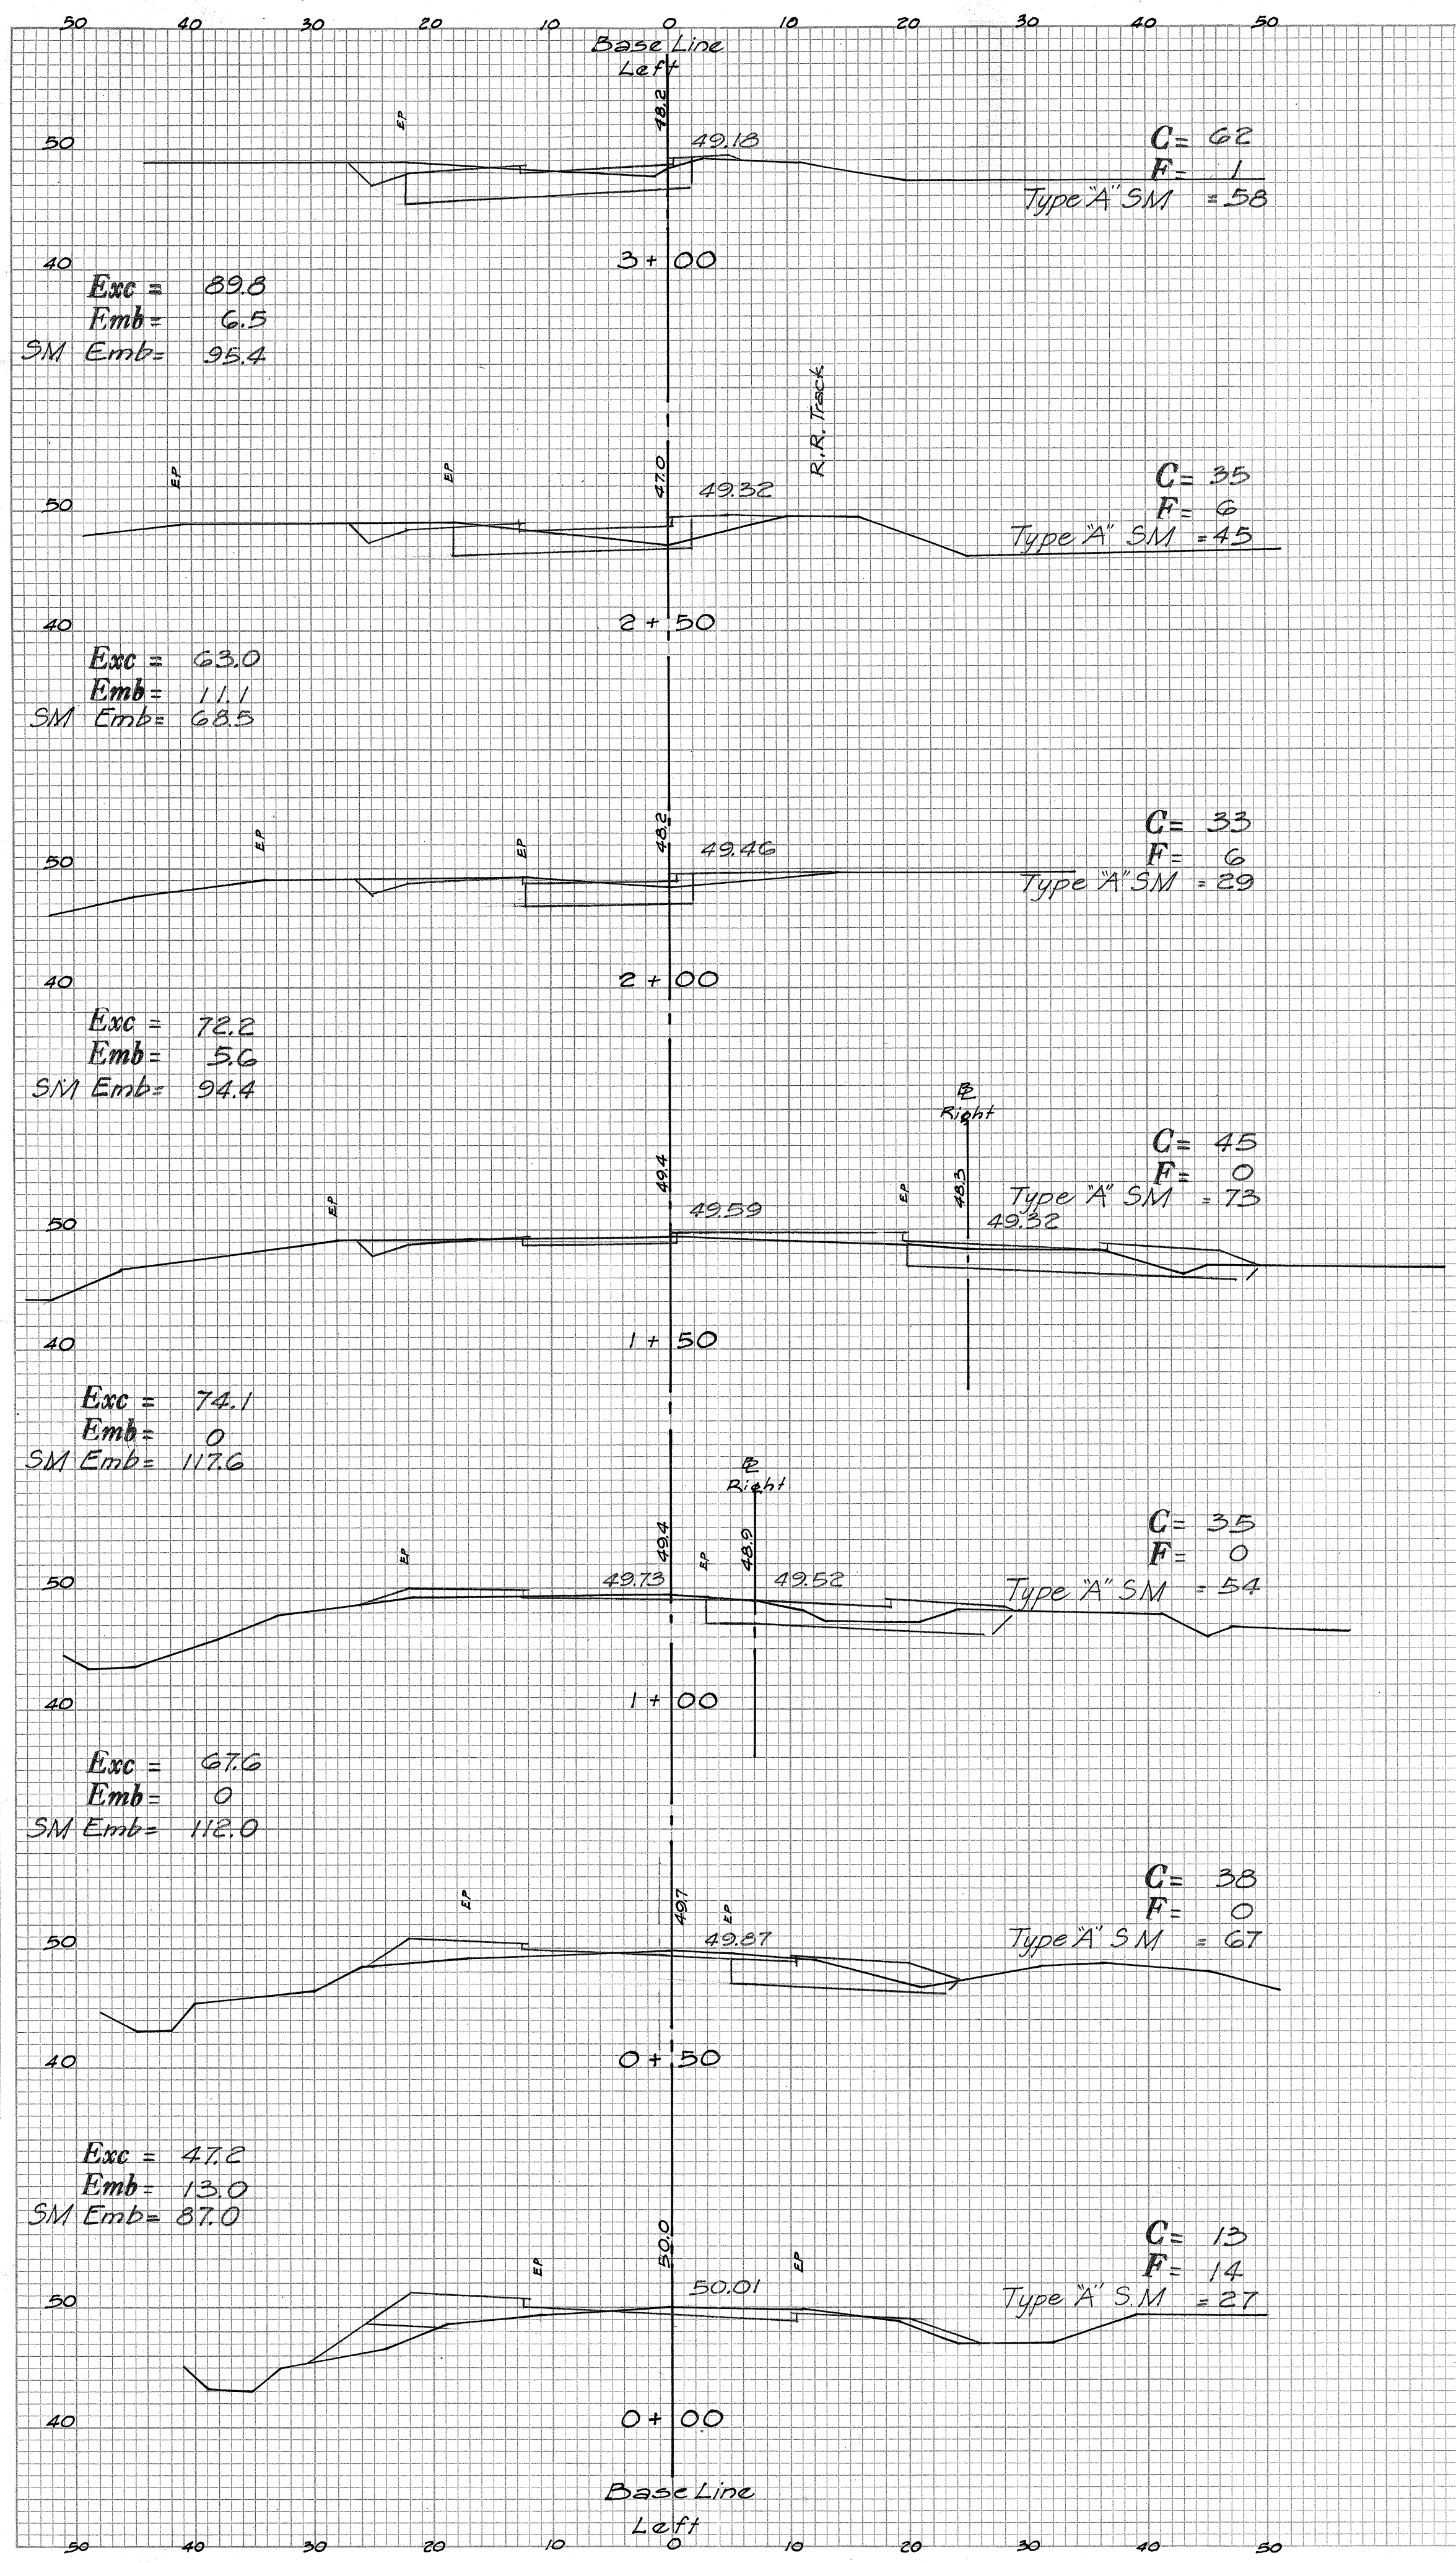



5512.12

FINAL SURVEY PLOTTED. DATE: BY: NO. AREAS CHECKED.

ORIGINAL SURVEY PLOTTED. DATE: BY: NO. AREAS CHECKED.

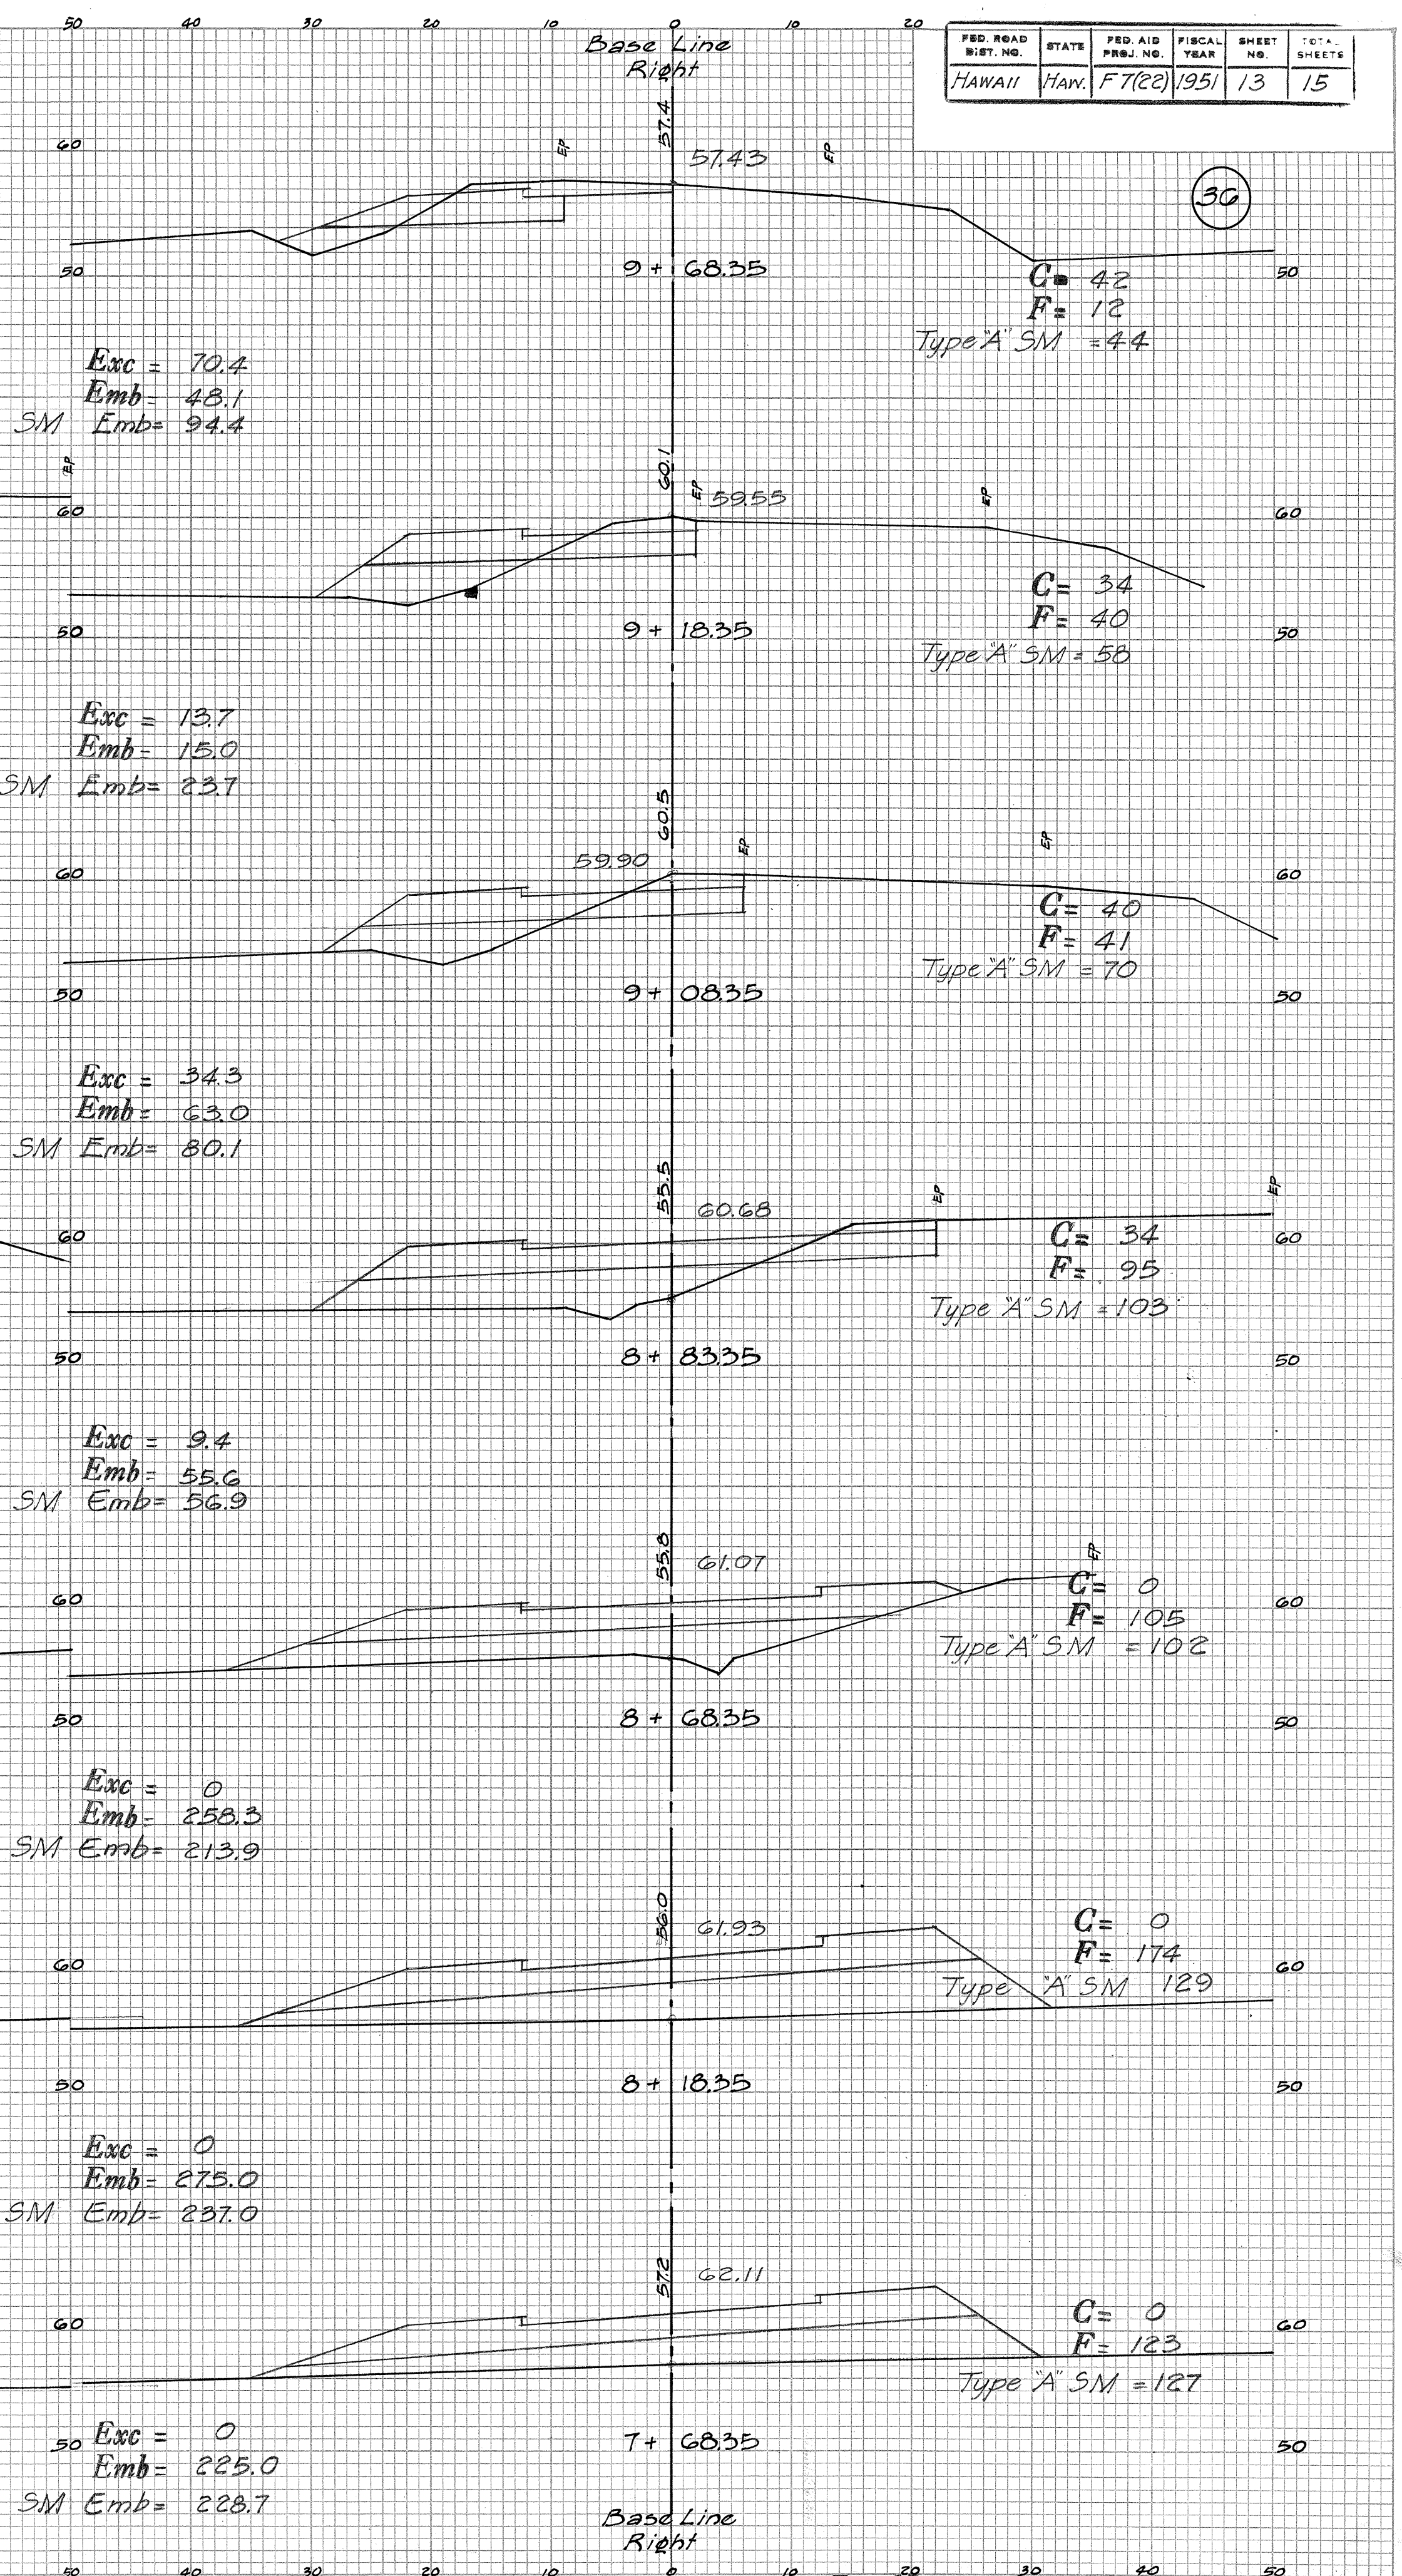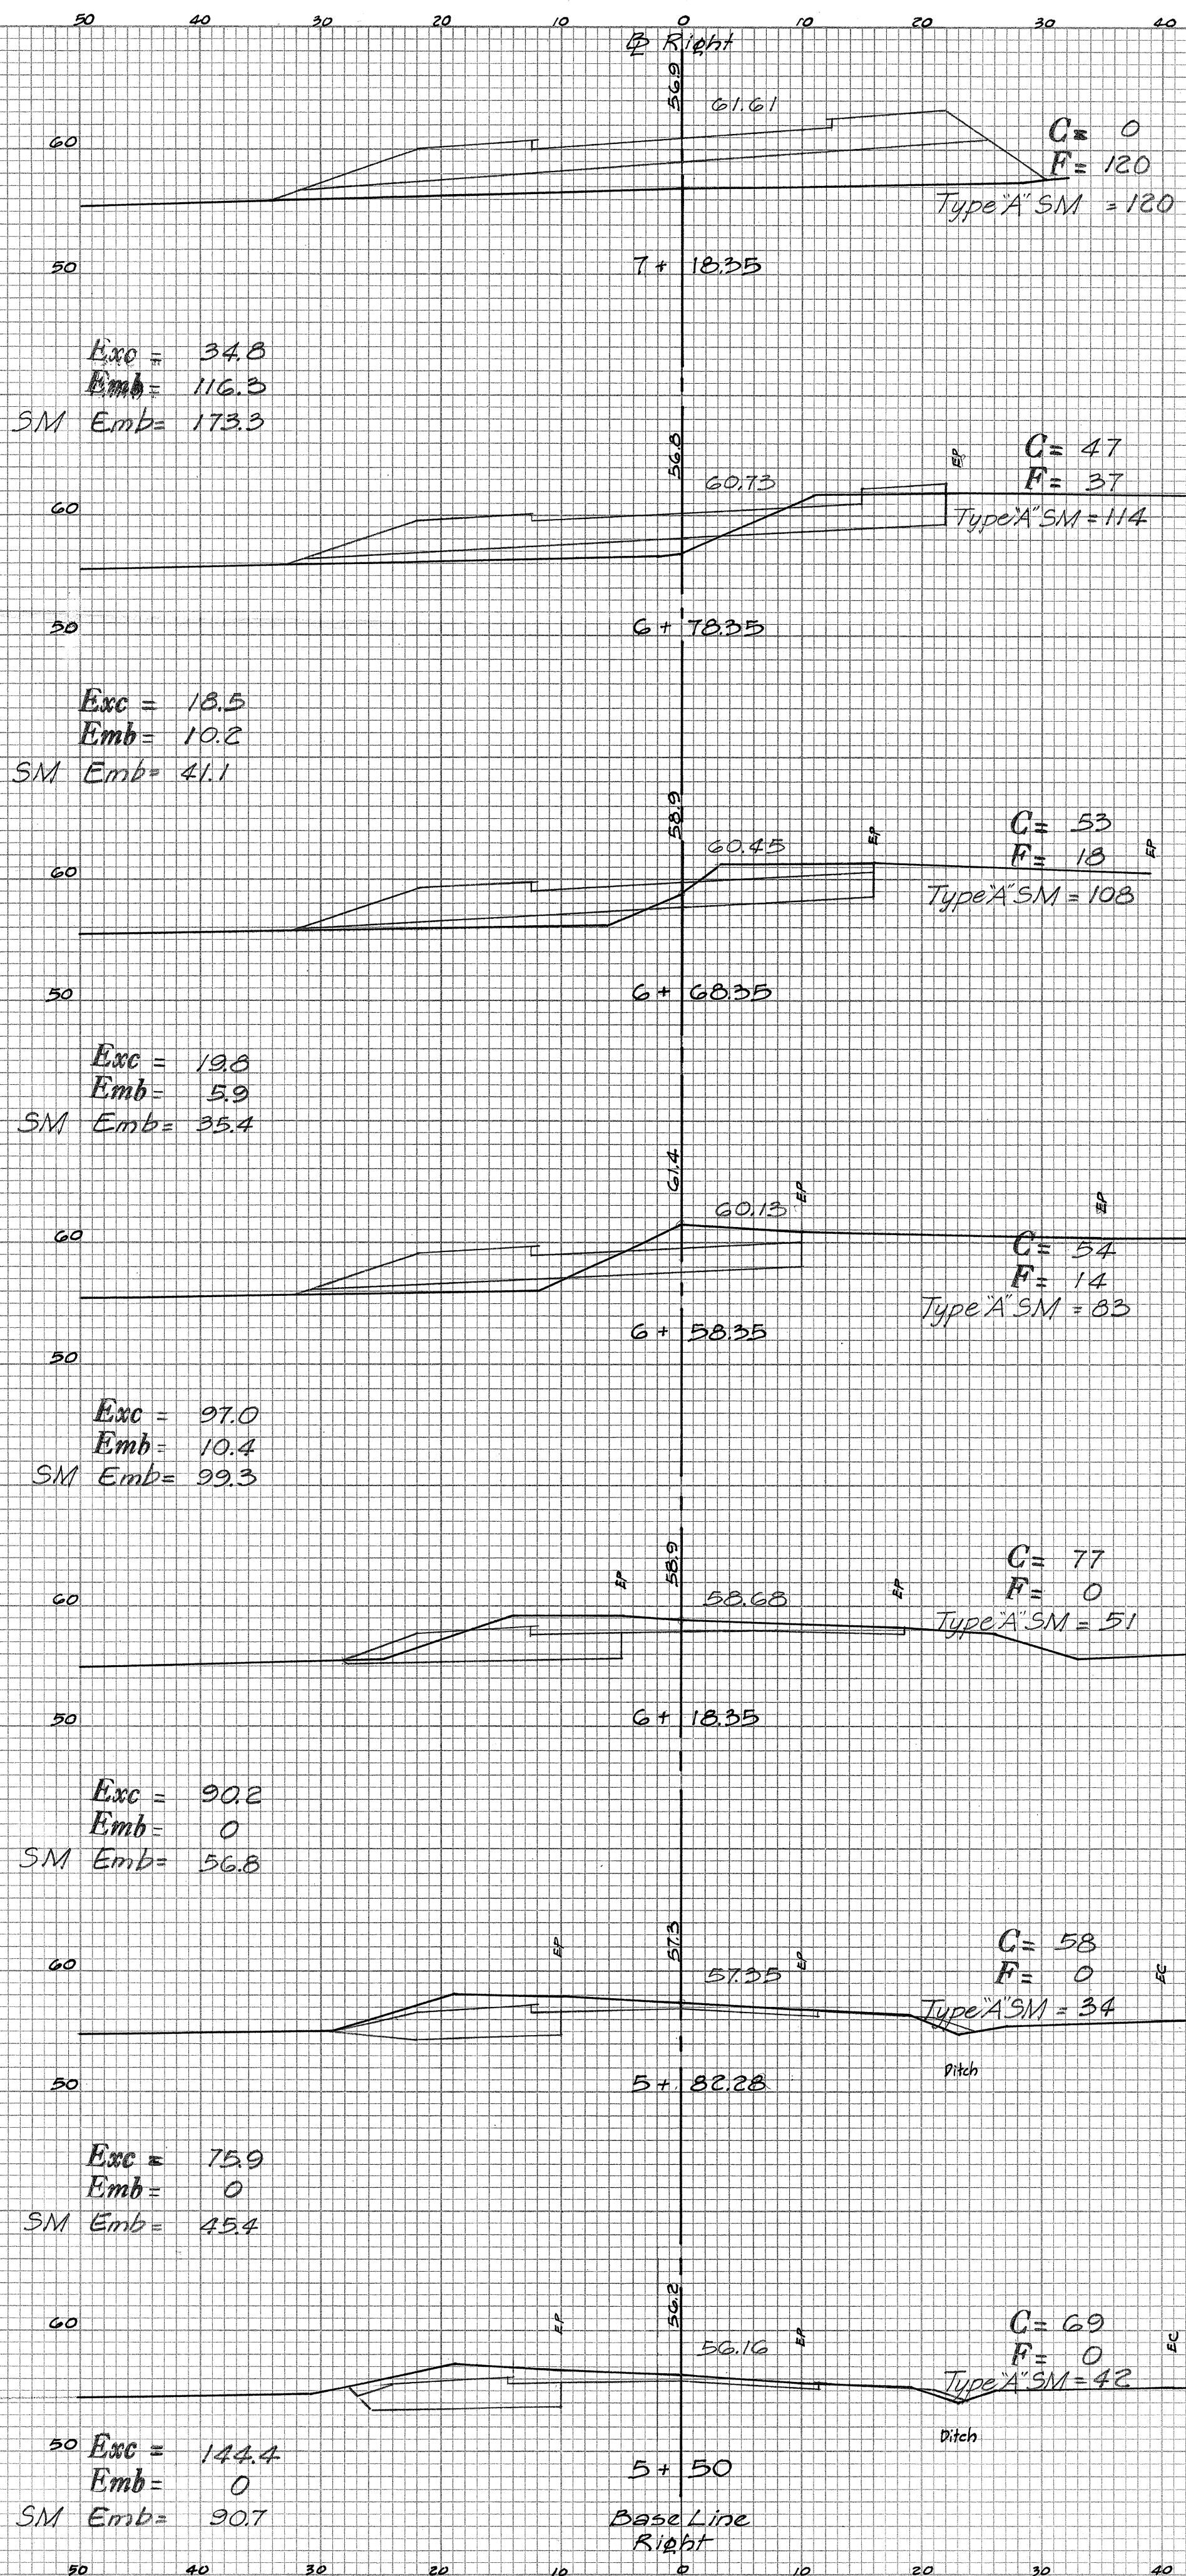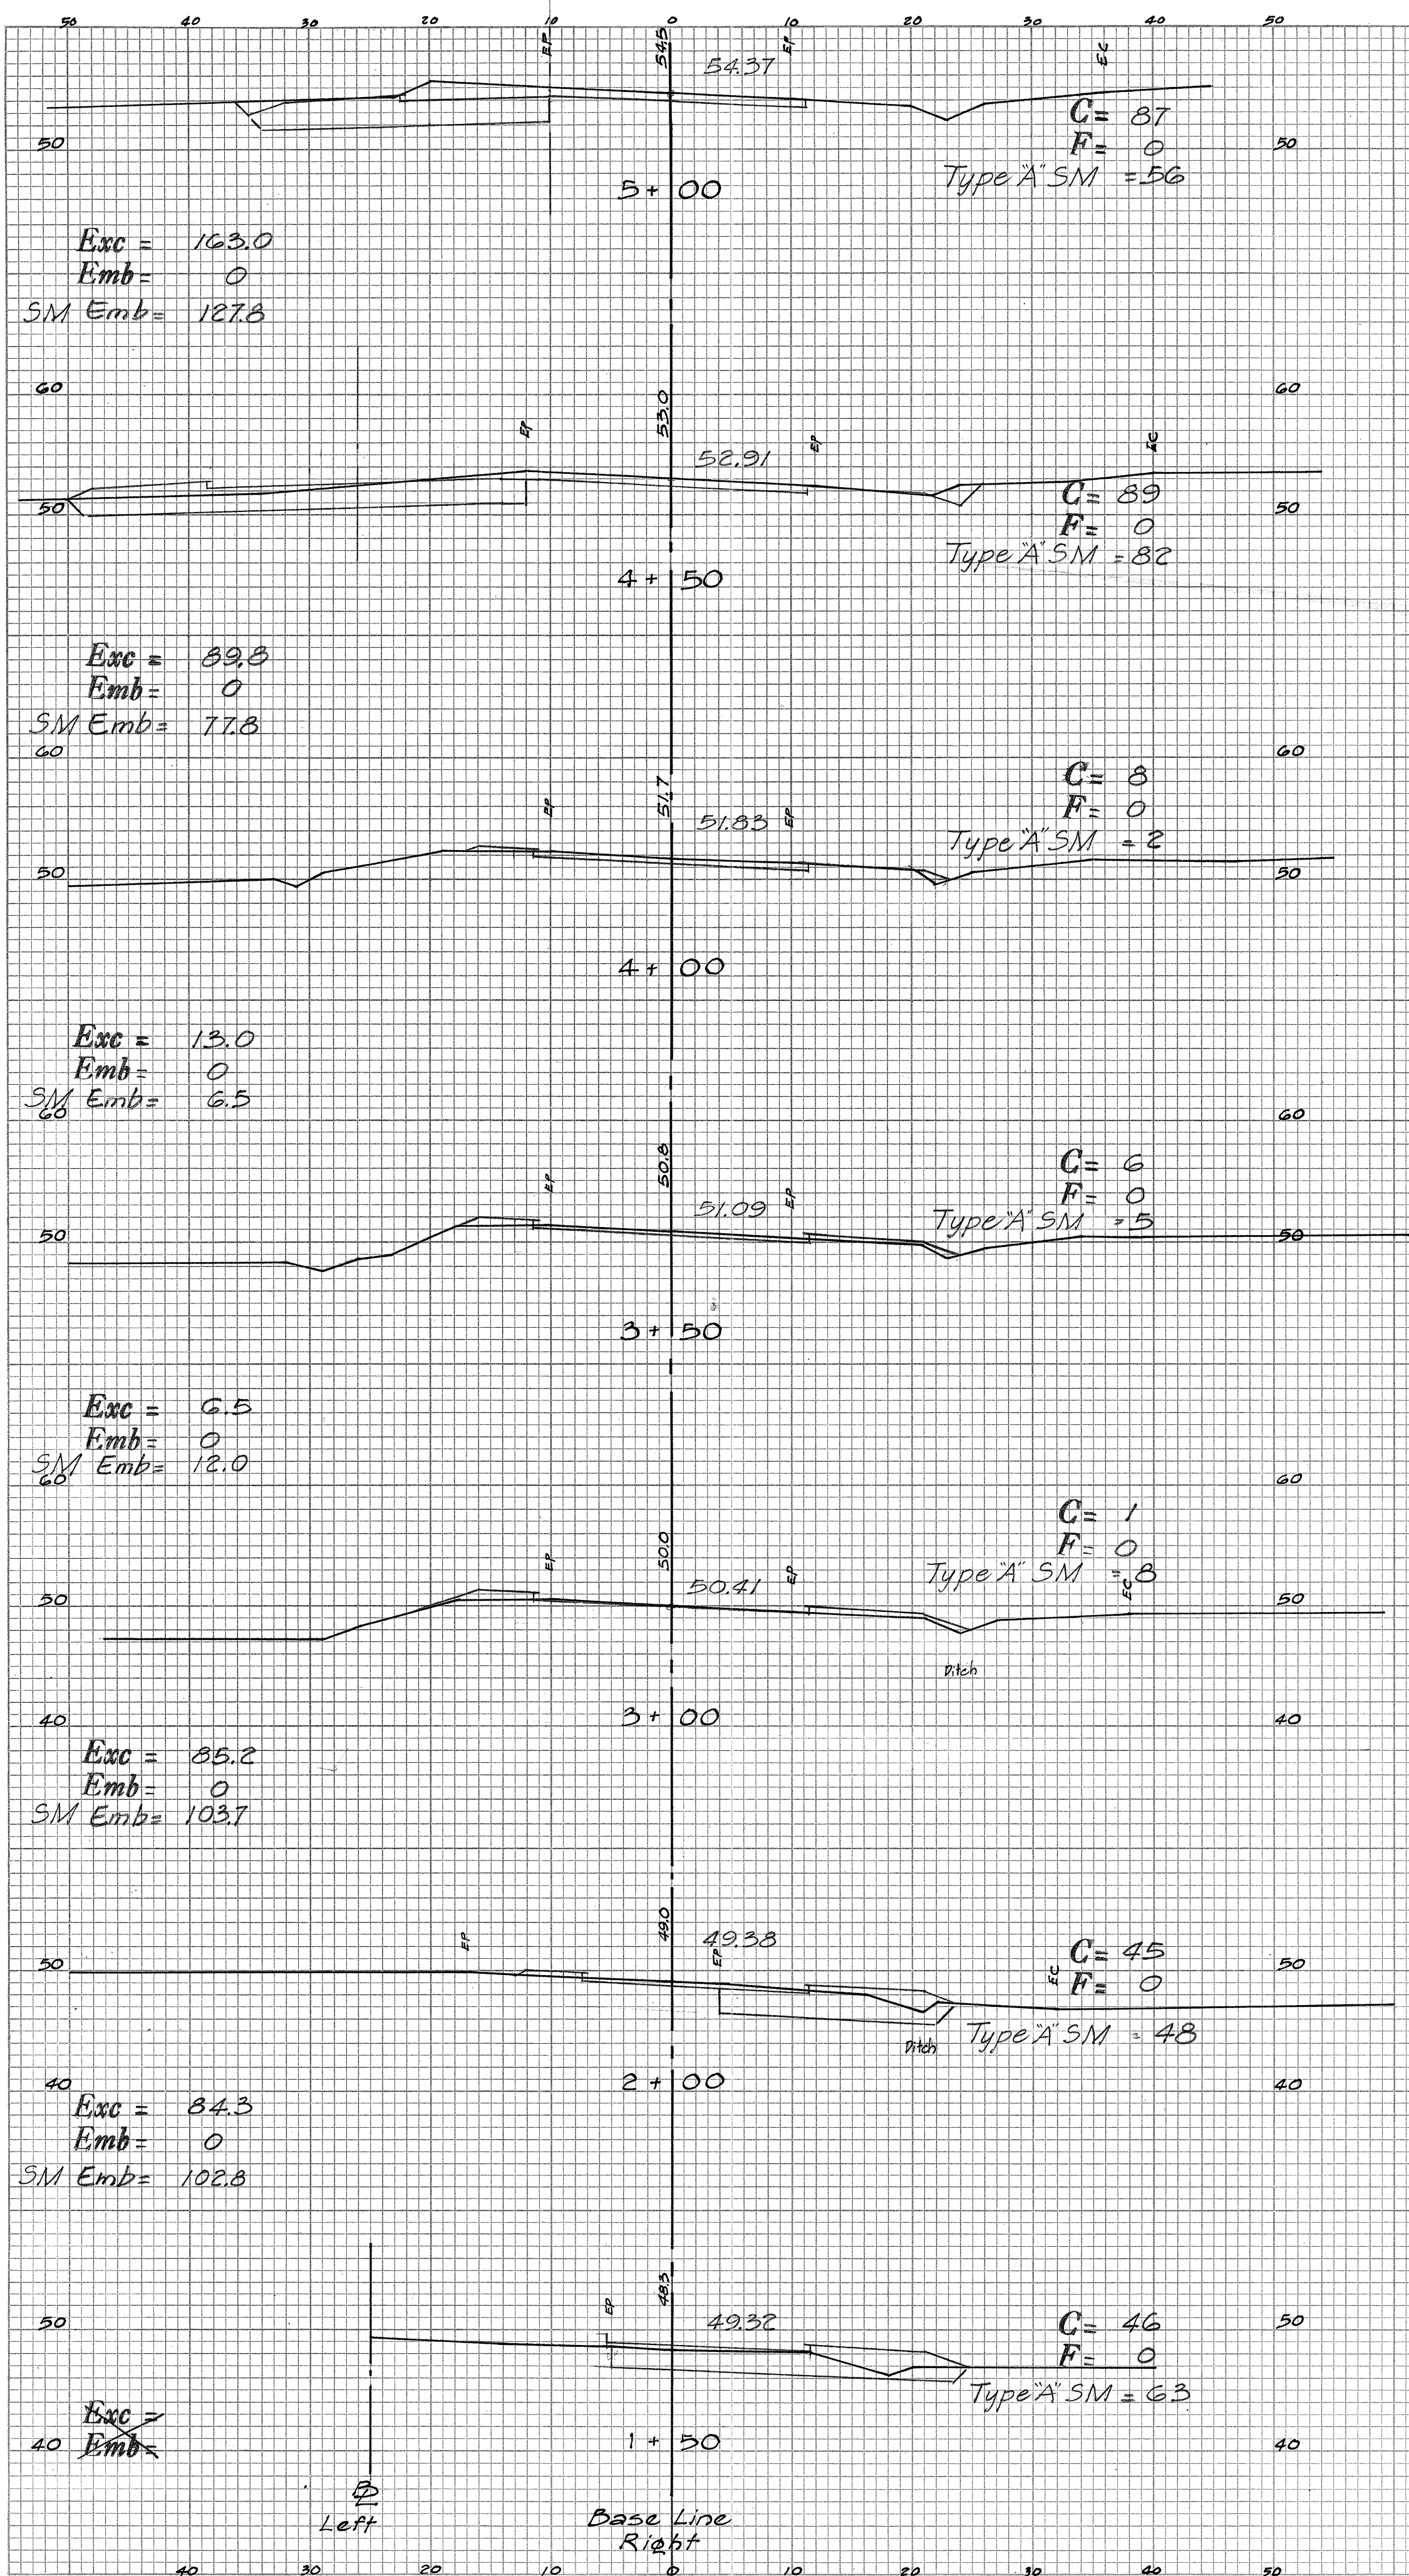

37

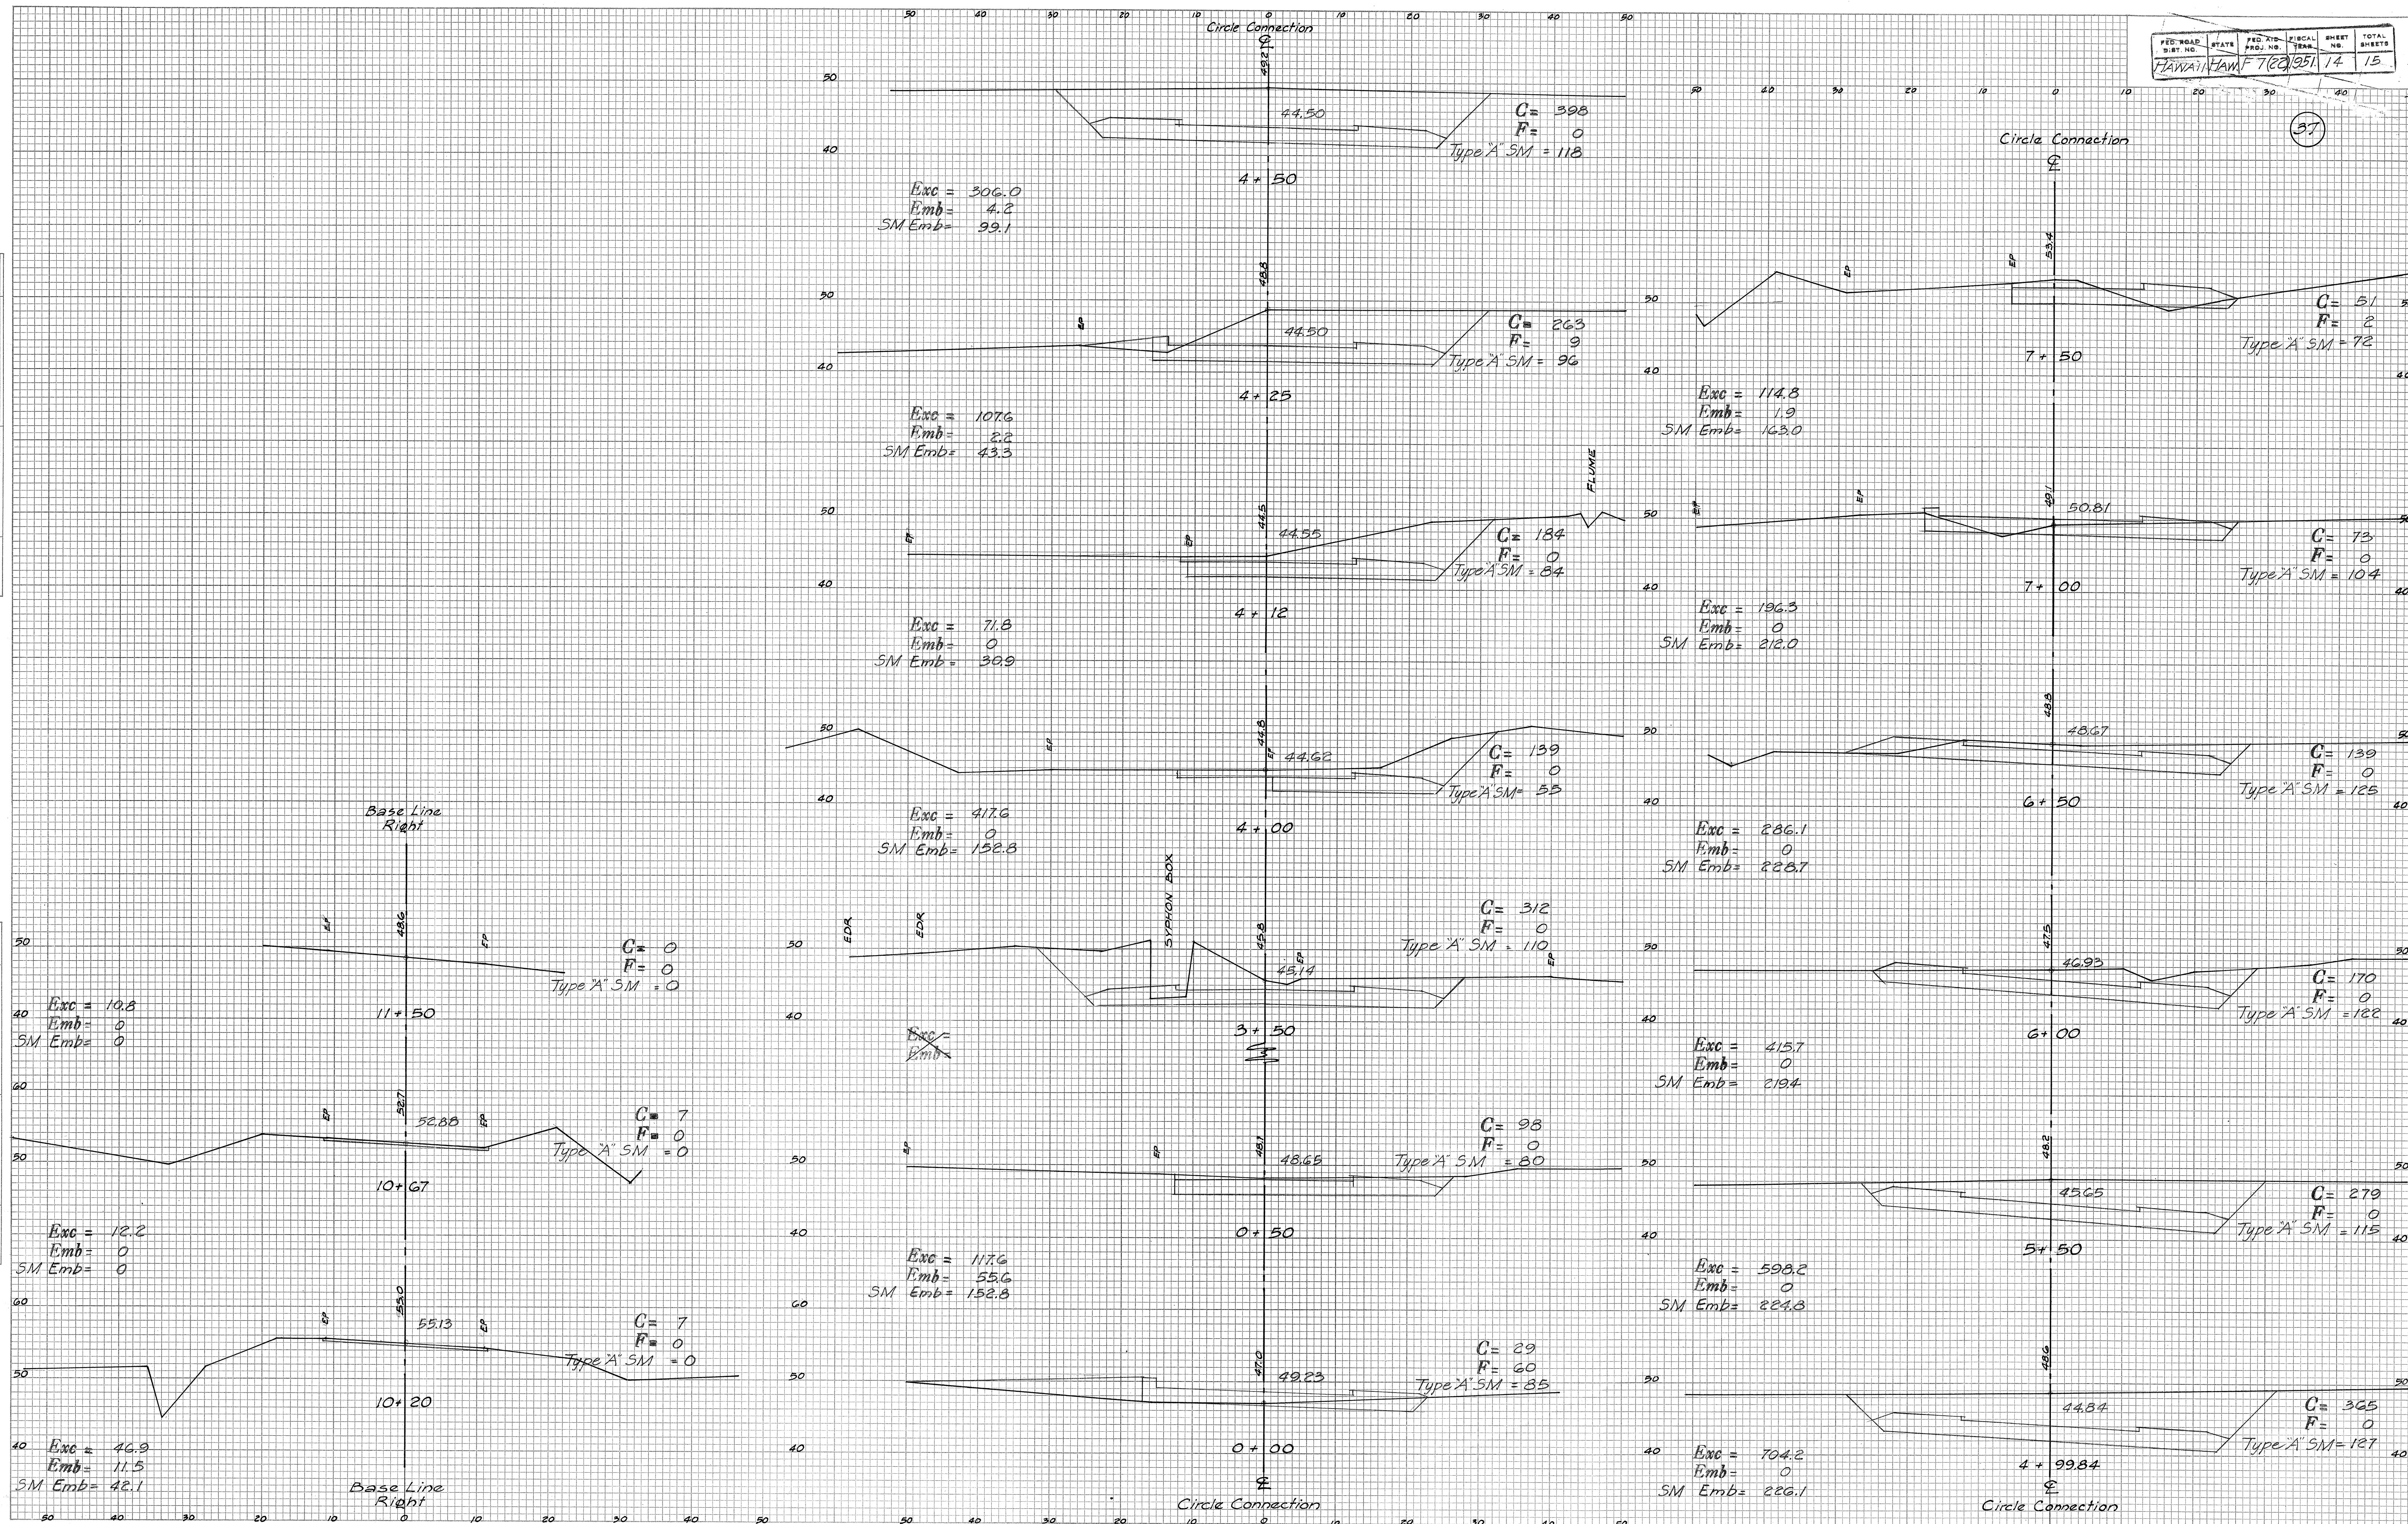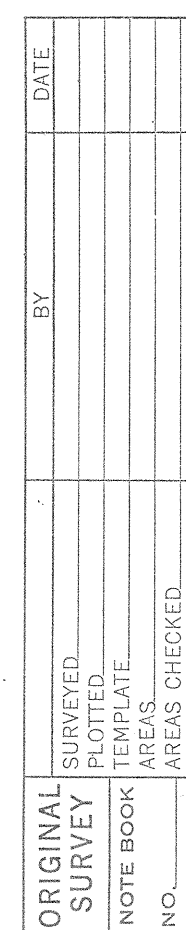

FINAL SURVEY	DATE
NO.	
BY	
SURVEYED	
NOTE BOOK	
AREAS CHECKED	

ORIGINAL SURVEY	DATE
NO.	
BY	
SURVEYED	
NOTE BOOK	
AREAS CHECKED	

