



PLAN	DATE	BY
DESIGNED BY		
CHECKED BY		
DATE		
BY		
DATE		
BY		
DATE		
BY		


PROFILE	DATE	BY
DESIGNED BY		
CHECKED BY		
DATE		
BY		
DATE		
BY		
DATE		
BY		

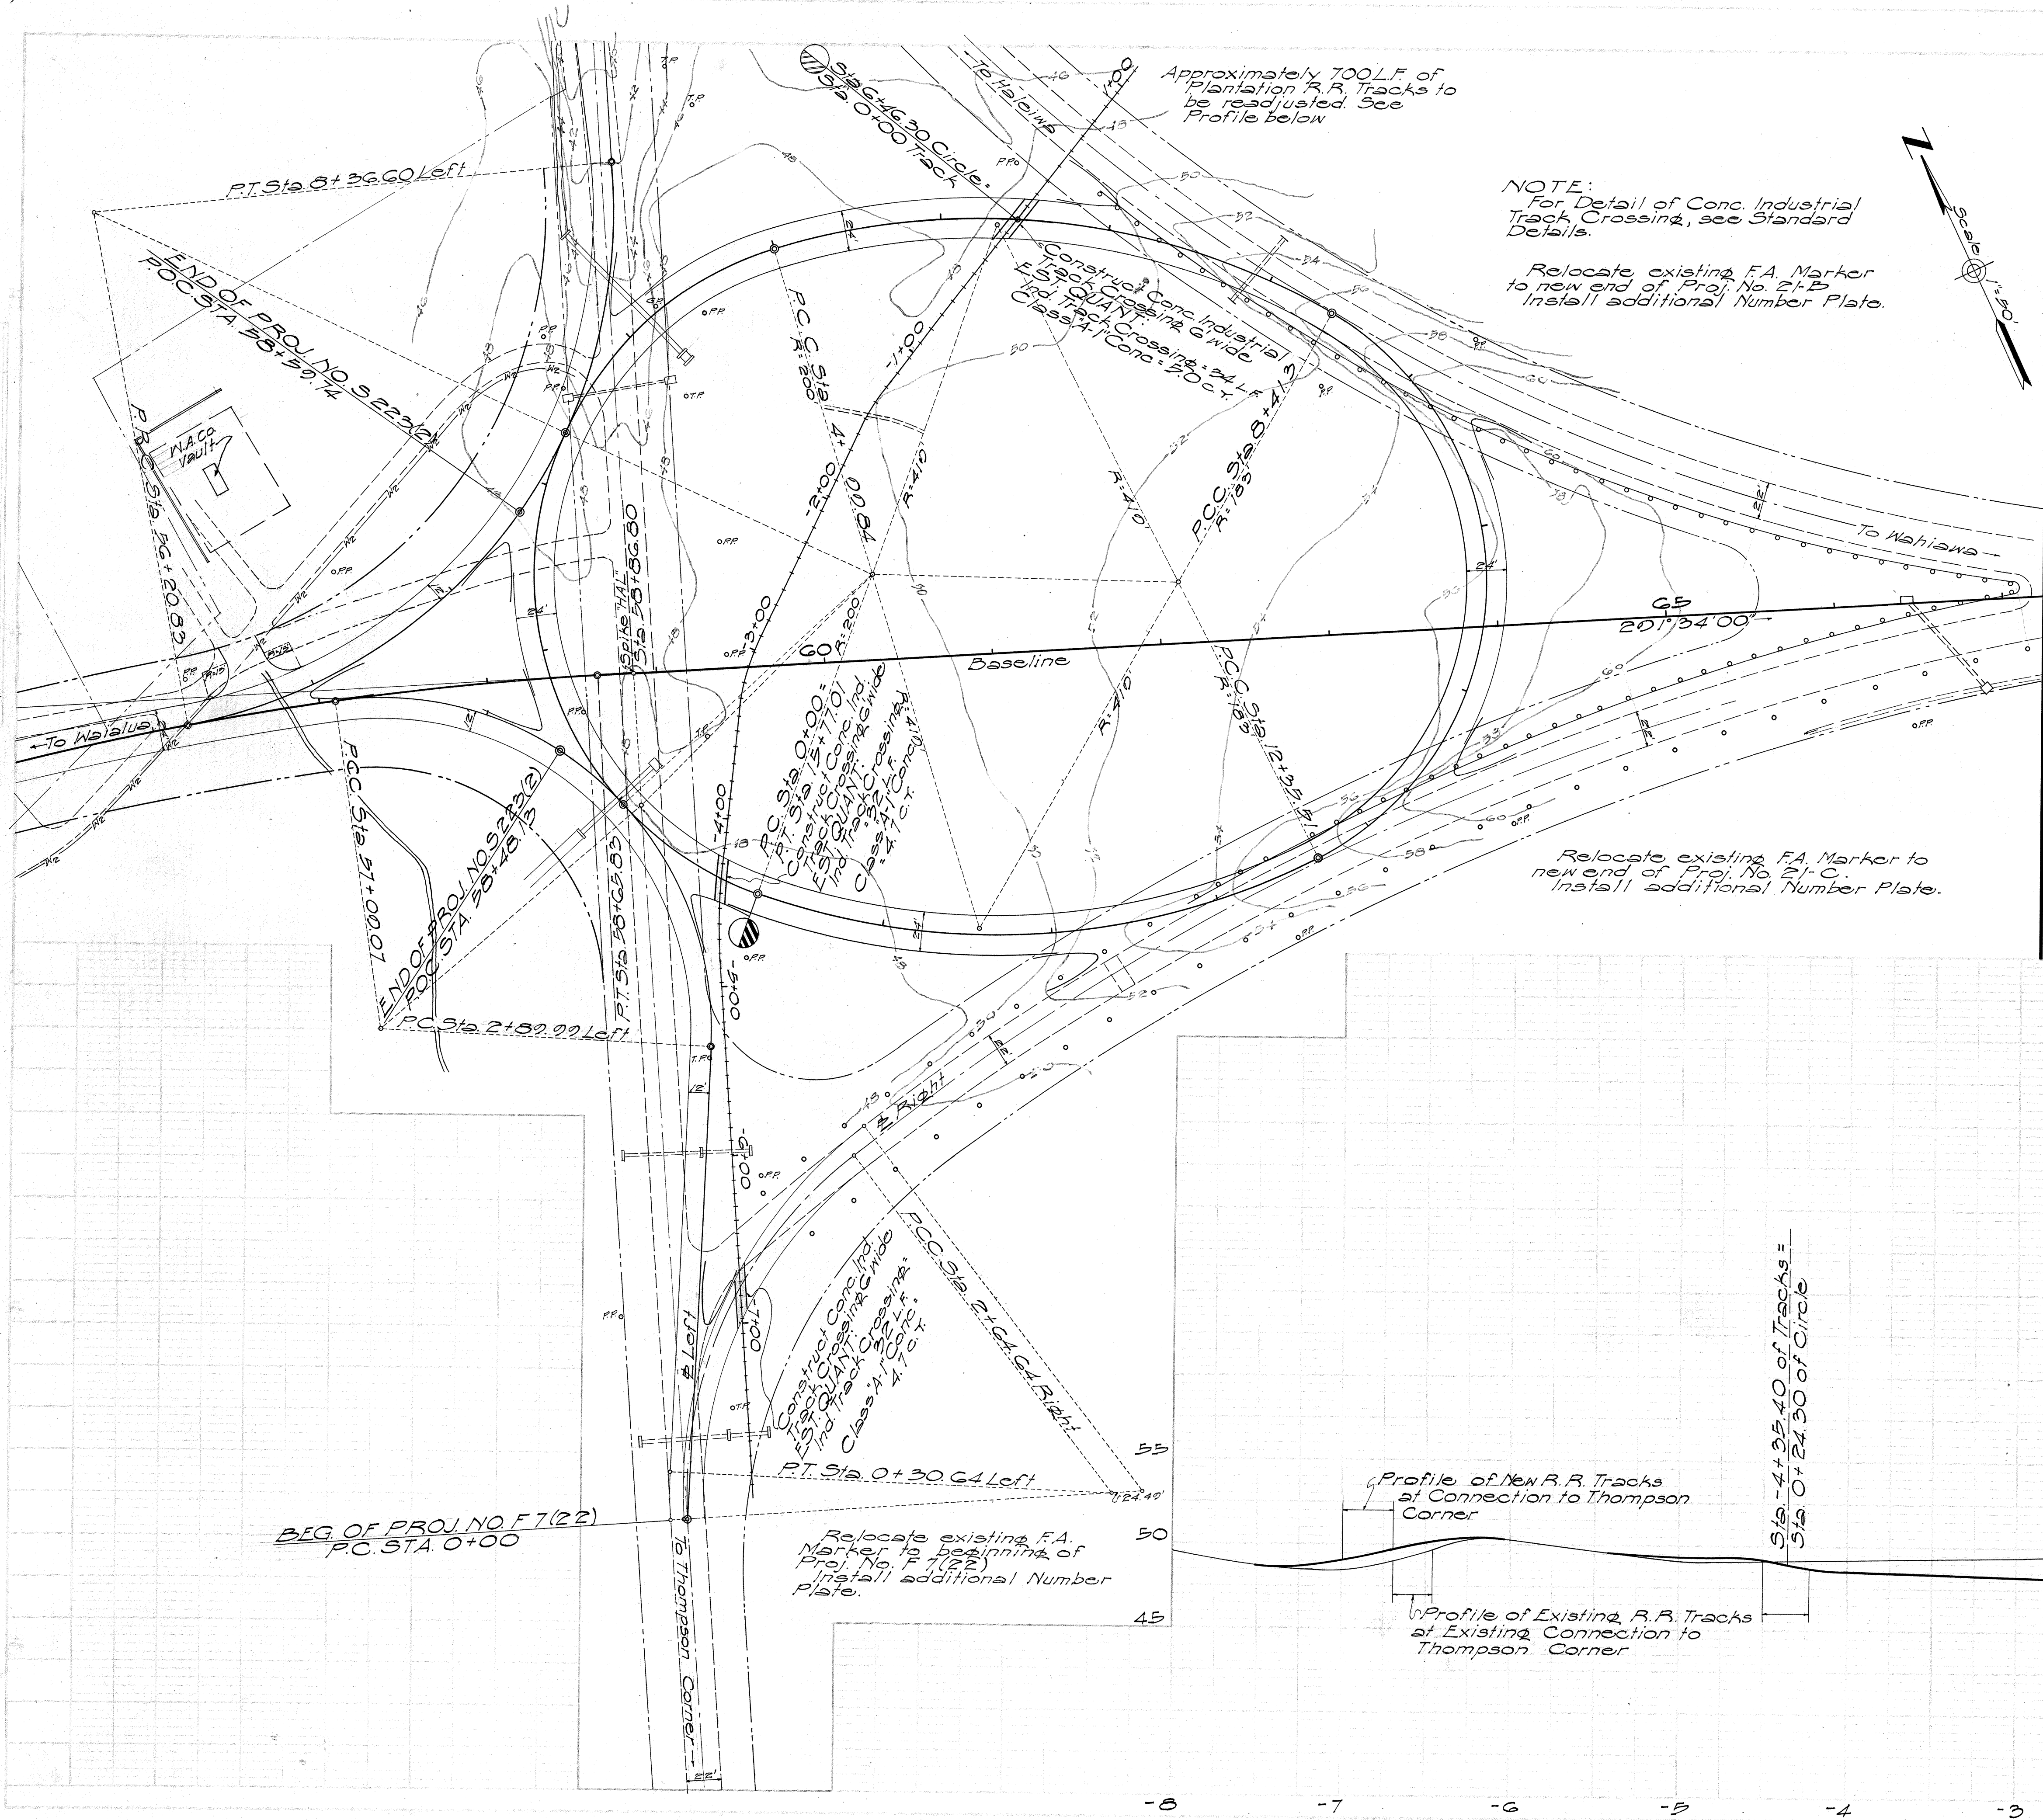

FED. ROAD DIST. NO.	STATE	FED. AID PROJ. NO.	FISCAL YEAR	SHEET NO.	TOTAL SHEETS	FED. ROAD DIST. NO.	STATE	FED. AID PROJ. NO.	FISCAL YEAR	SHEET NO.	TOTAL SHEETS
HAWAII	HAW	F 7(22)	1931	5	15	HAWAII	HAW	8223(2)	1931	0	20

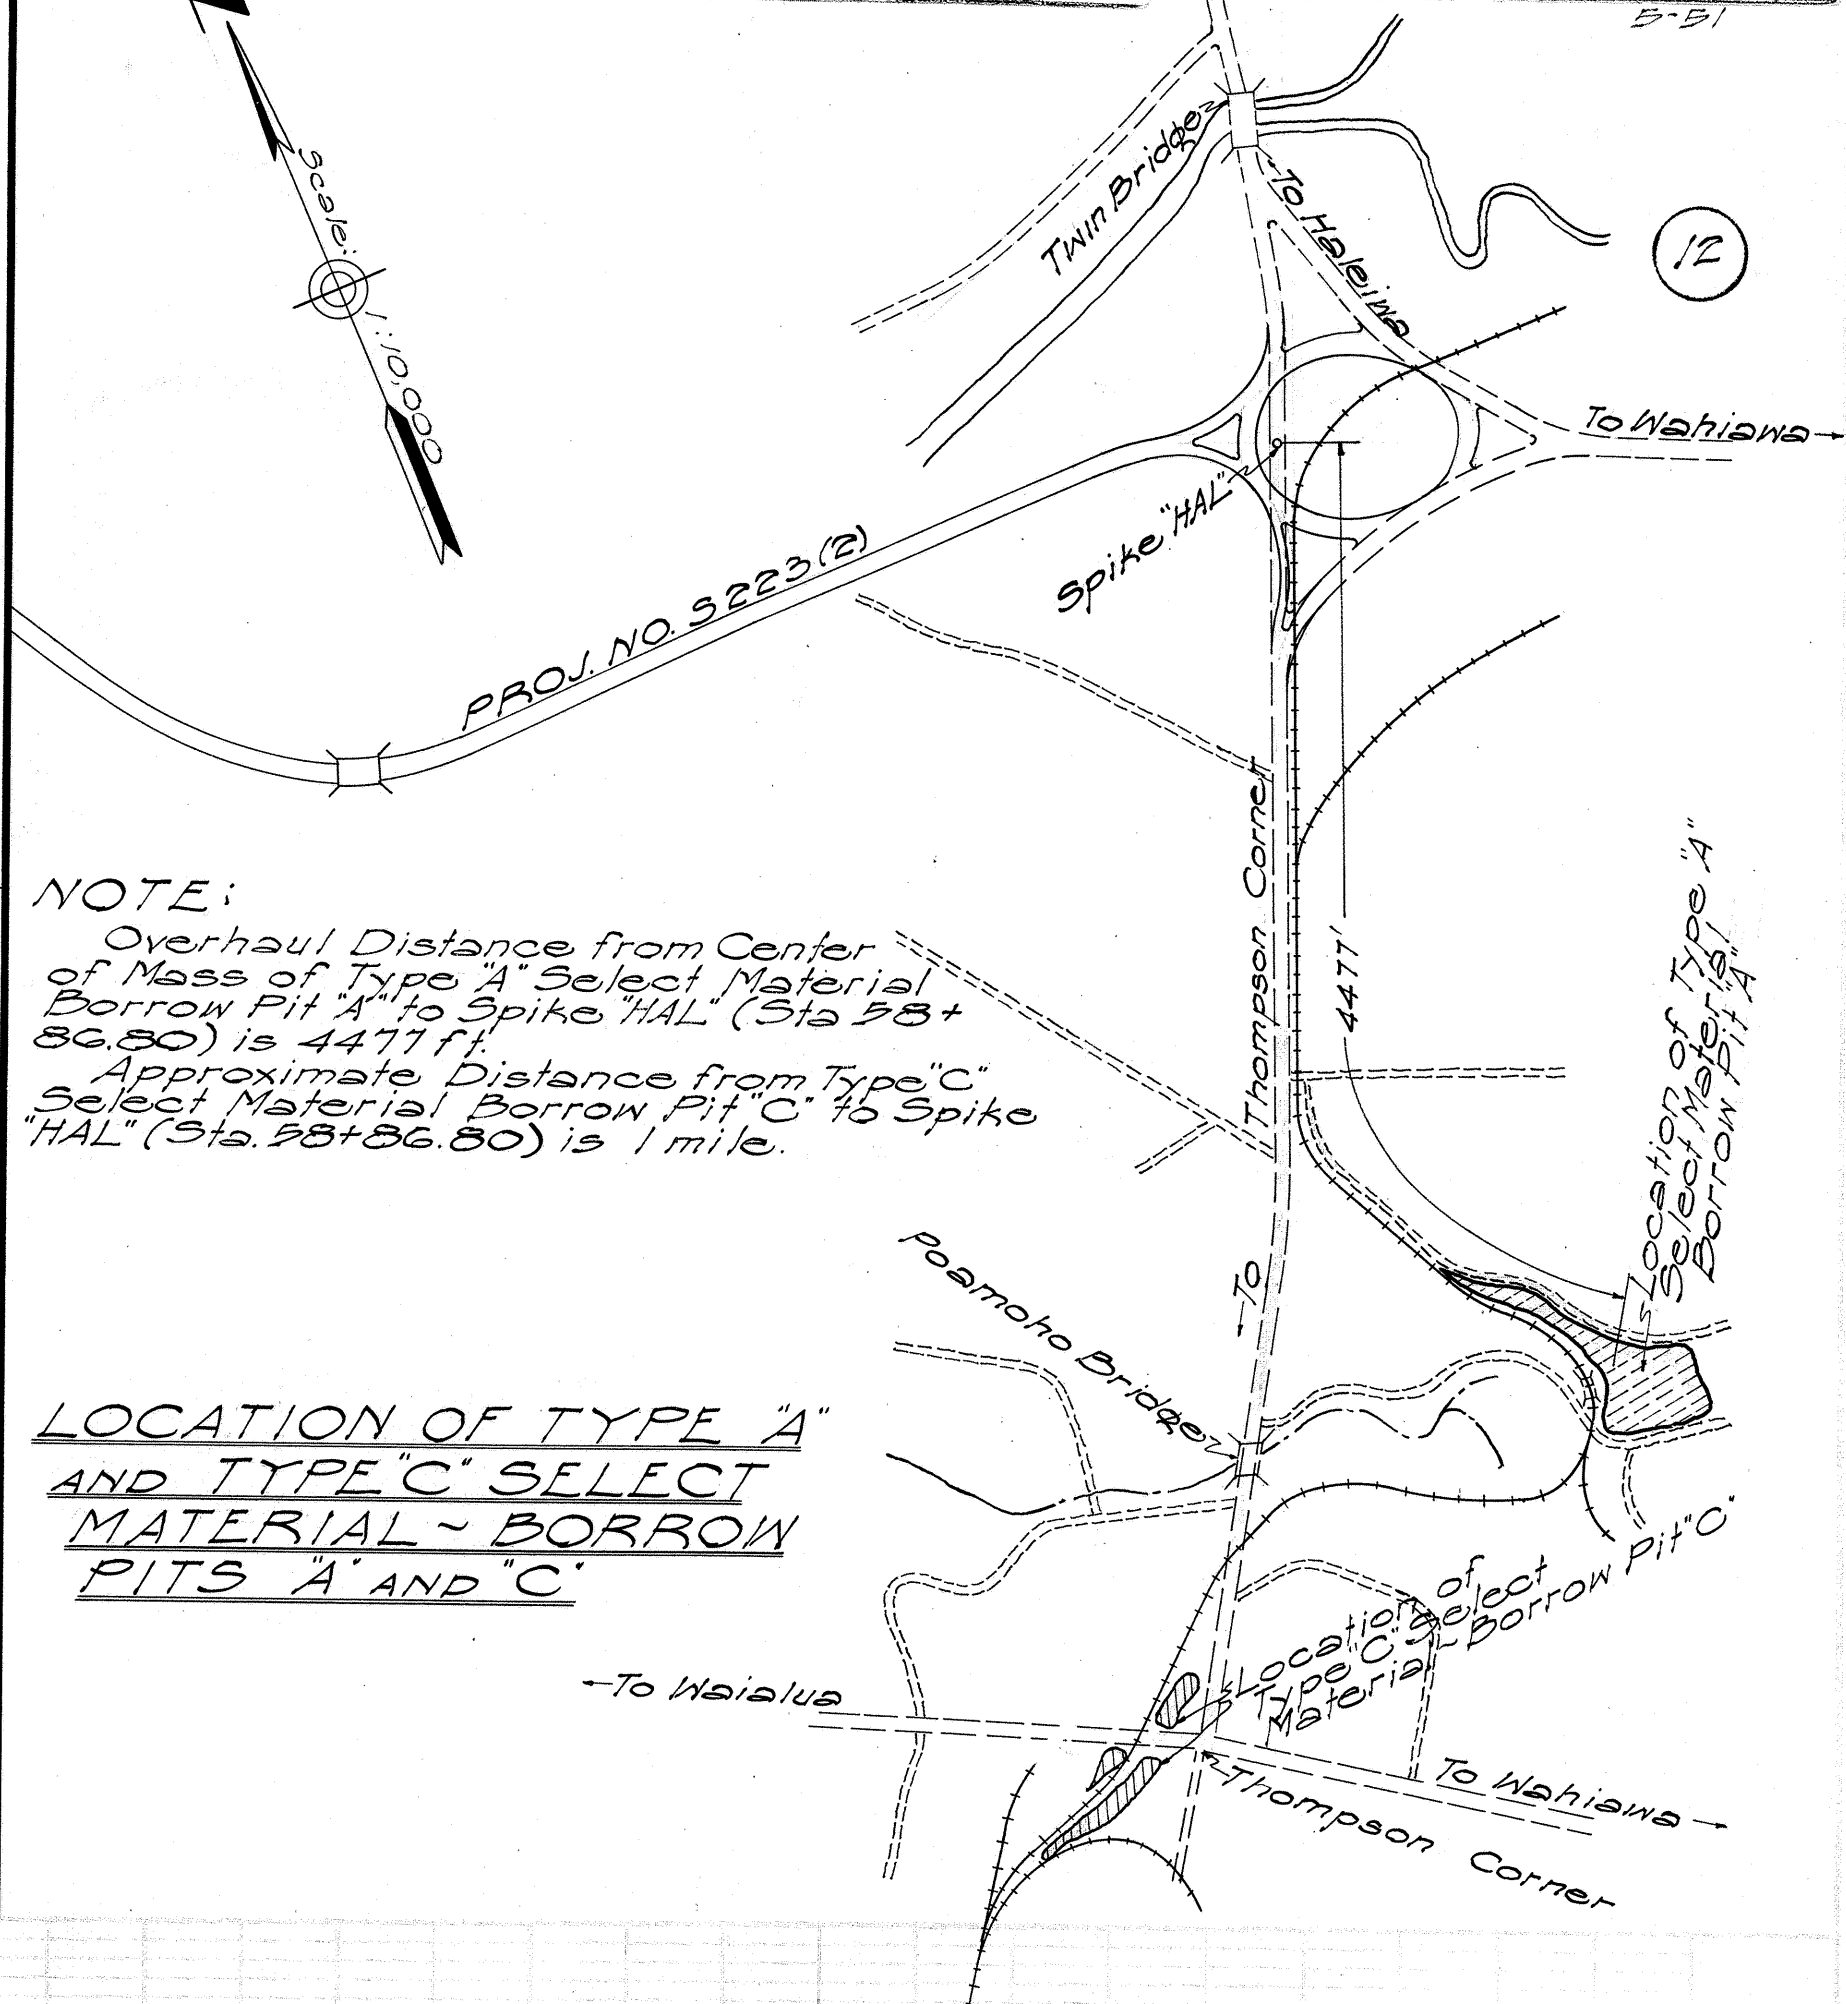

LOCATION OF TYPE "A" AND TYPE "C" SELECT MATERIAL - BORROW PITS "A" AND "C"

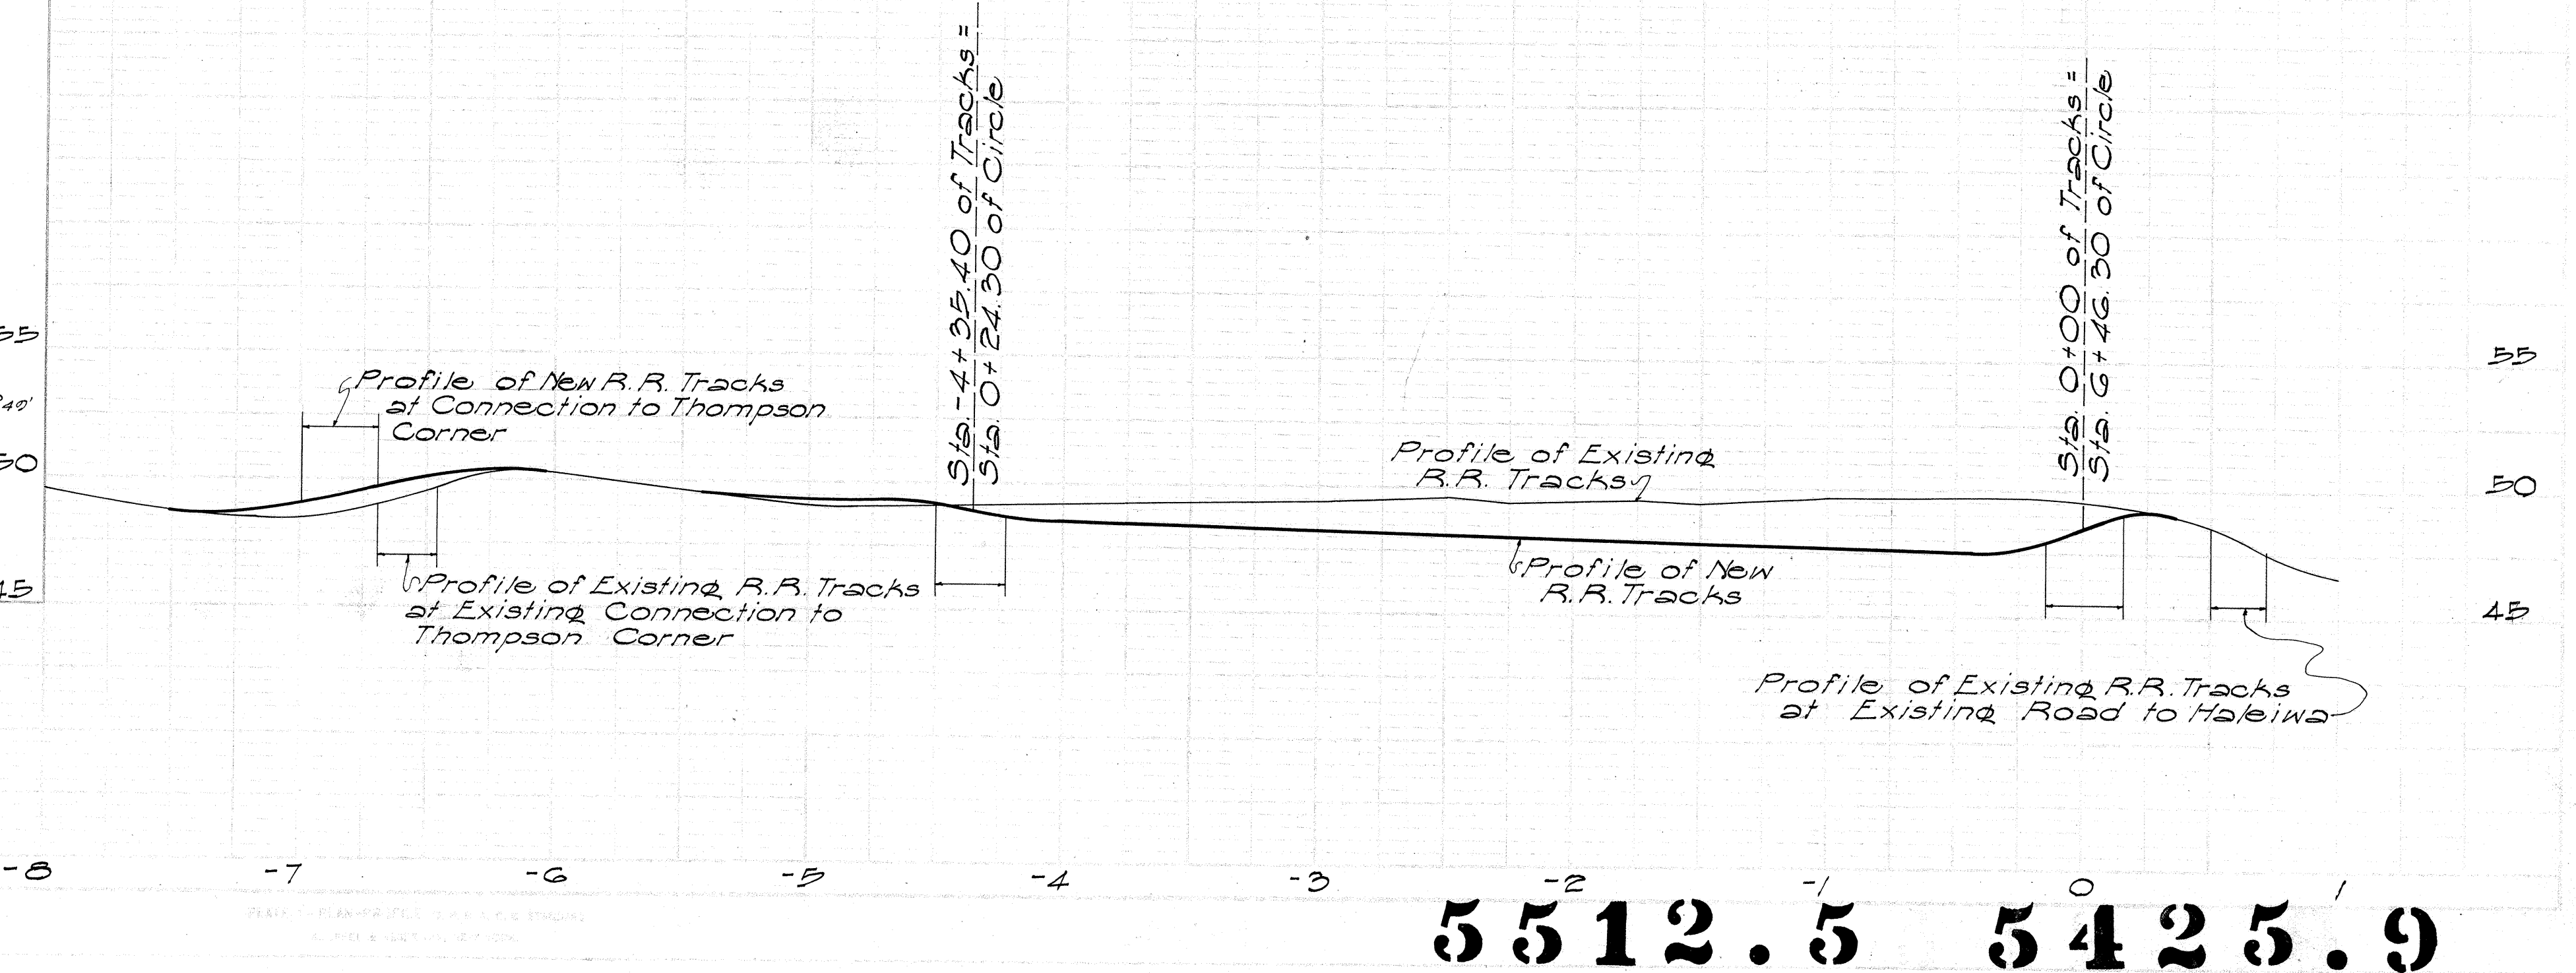

5512.5 5425.9