


INDEX TO DRAWINGS	
SHEET NO.	DESCRIPTION
1	TITLE SHEET
2	TYPICAL SECTION
3-4	PLAN & PROFILE
5	RAILROAD TRACK PROFILE & BORROW PIT LOCATION
6-11	STANDARD DETAILS
12-15	CROSS SECTIONS

CONVENTIONAL SIGNS	
Centerline	125
Boundary Lines	or
Fences (Named)	
Existing Roadways	
Circular Culvert	
Box Culvert	
Bridge	
Telephone Pole	
Electric Power Pole	
Water Main	W ₂ W ₂ (W ₄ , 8, 12, Etc.)
Storm Drain	SD ₁₂ SD ₁₂ (SD ₁₈ , 24, Etc.)
Concrete Drop Intake	C.D.I.
Standard Catch Basin	S.C.B.
Standard Manhole	M.H.S.
Sewer Manhole	S.S. S.S. S ₁₂
Telephone Manhole	T.M.H.
Fire Hydrant	F.H.
Tree (Large, named)	Mango
Railroad	
Mutual Telephone Underground Cable	M.T.C.
Water Meter	W.M.

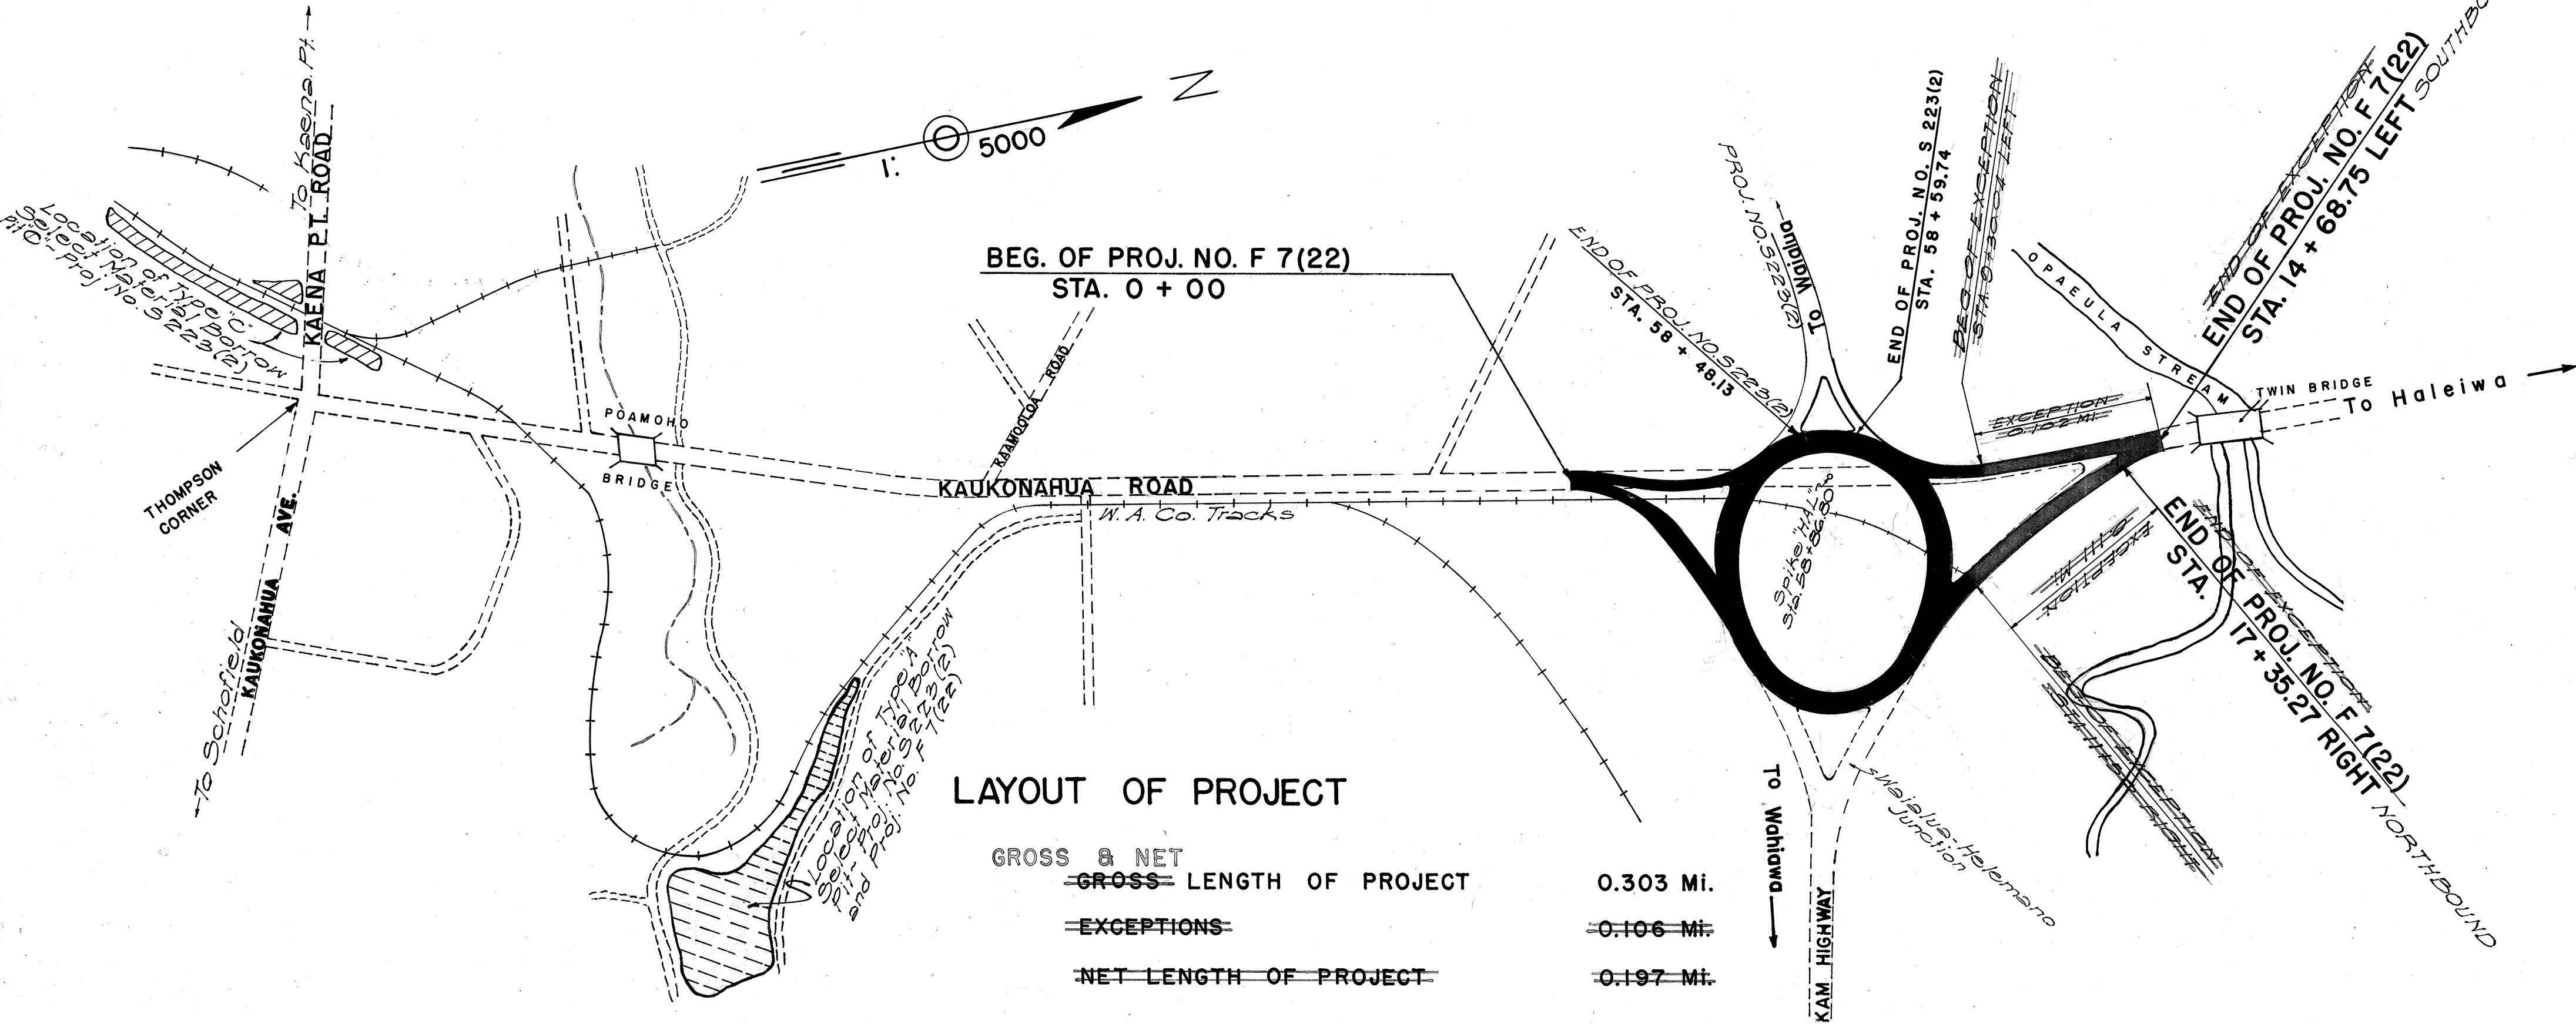

LAYOUT OF PROJECT

GROSS & NET	
GROSS LENGTH OF PROJECT	0.303 MI.
EXCEPTIONS	0.106 MI.
NET LENGTH OF PROJECT	0.197 MI.


TERRITORY OF HAWAII
TERRITORIAL HIGHWAY DEPARTMENT
HONOLULU, OAHU, T. H.

PLANS OF KAMEHAMEHA HIGHWAY FEDERAL AID PROJECT NO. F7(22)

DISTRICT OF WAIALUA
ISLAND OF OAHU

SCALES	
PLAN	1 IN. = 50 FT.
PROFILE	HOR. 1 IN. = 50 FT. VERT. 1 IN. = 5 FT.
CROSS SECTION	HOR. 1 IN. = 10 FT. VERT. 1 IN. = 10 FT.

Location Of Project
No. F 7(22)

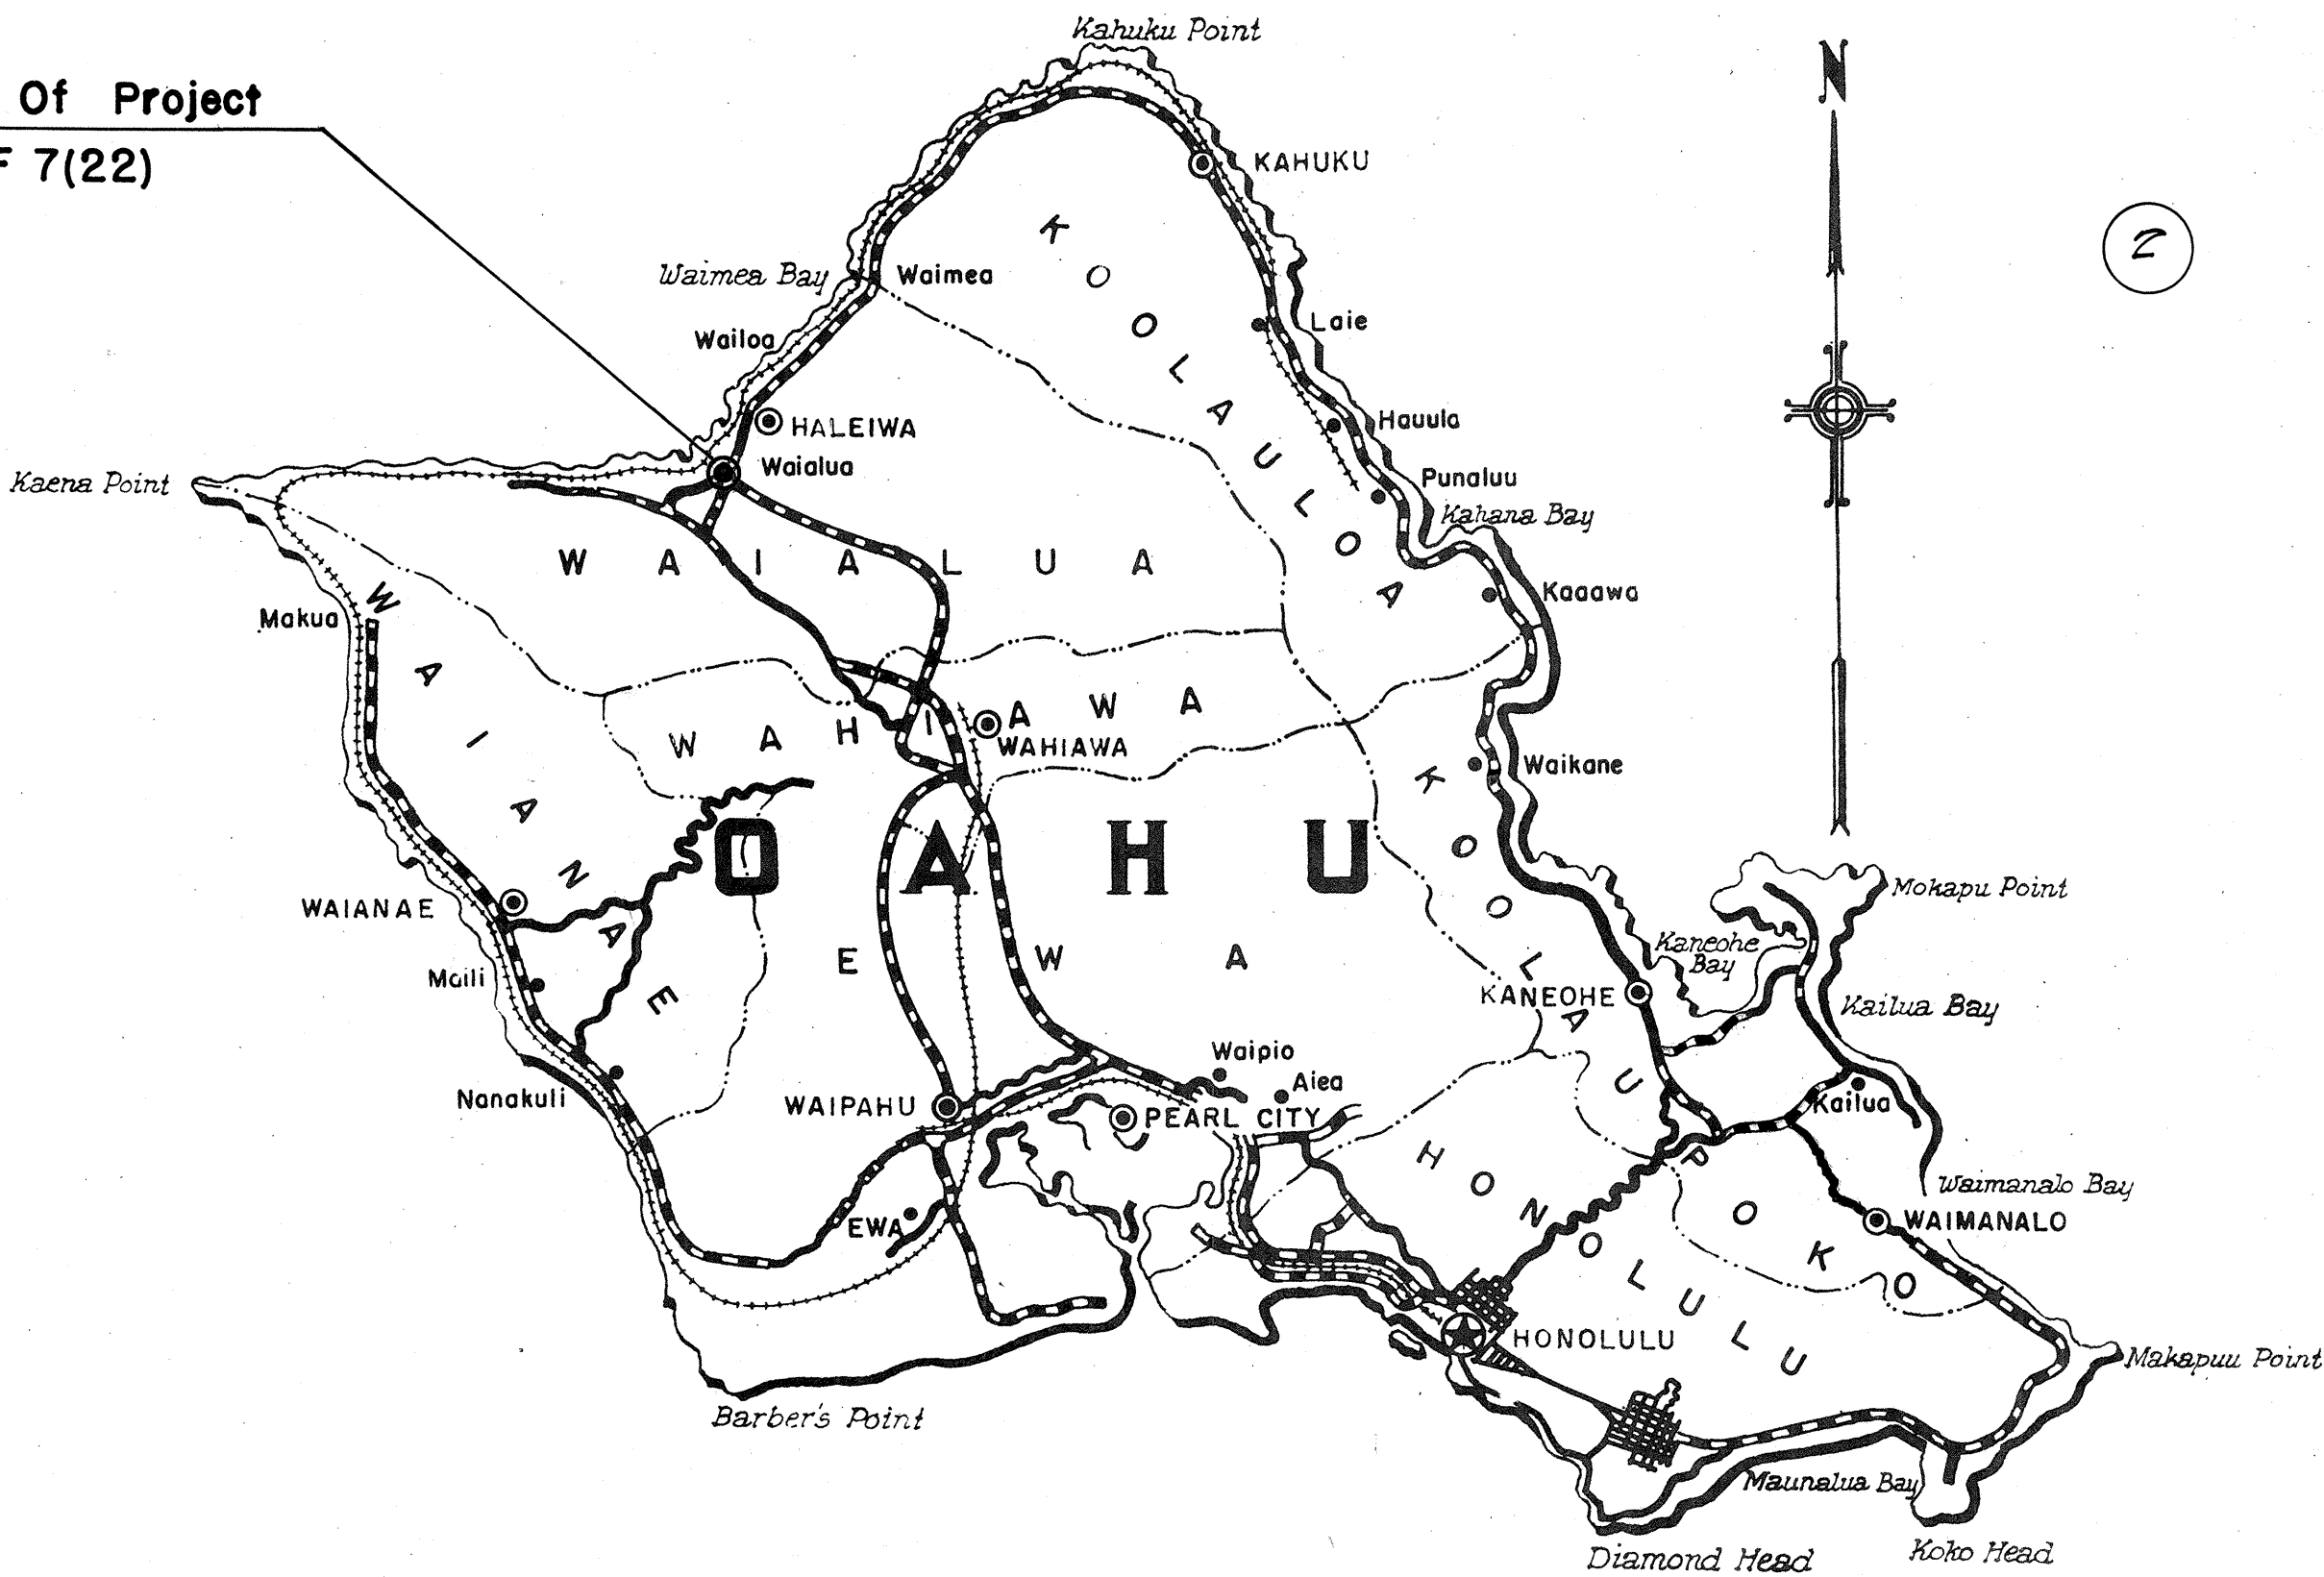

Federal Aid Projects Previously Constructed Or Under Construction

NOTE:
ALL CHANGES MADE DURING CONSTRUCTION
HAVE BEEN NOTED IN RED ON THESE TRACINGS
AND CHECKED BY:

Albert C. Hesse
RESIDENT ENGINEER

9-15-52
DATE

APPROVED
[Signature]
TERRITORIAL HIGHWAY ENGINEER

DEPARTMENT OF COMMERCE BUREAU OF PUBLIC ROADS	
RECOMMENDED FOR APPROVAL:	
DISTRICT ENGINEER	DATE
APPROVED:	
DIVISION ENGINEER	DATE