 


TERRITORY OF HAWAII
TERRITORIAL HIGHWAY DEPARTMENT
HONOLULU, T. H.
PLANS FOR RESURFACING OF
KAMEHAMEHA HIGHWAY
WAIHAOLE-HAUULA SECTION
KOOLAULO & KOOLAUPOKO DISTRICTS
OAHU, T. H.
JOB NO. 5616

Previous A.C. Resurfacing 
New Section to be
Resurfaced under Job 5616 
Section to be Resurfaced
in Future 

BEG. OF JOB NO. 5616
BEG. PROJ. 1A -0.105 mi.


LAYOUT OF PROJECT
Scale: 1" = 1500'

Length of project ~~4.513~~ ^{5.524} mi.
Resurfacing to be done on
shaded sections only.

Sheet 1 of 1 sheet

5616.1

END OF JOB NO. 5616
END OF 1A 12.8 mi.

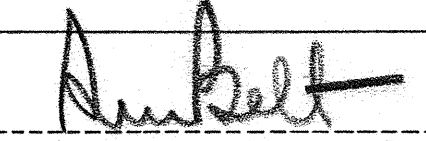Approved: 
Territorial Highway Engineer
Date: 8/13/52