


FED. ROAD DIST. NO.	STATE	FED. AID PROJ. NO.	FISCAL YEAR	SHEET NO.	TOTAL SHEETS
HAWAII	HAW.	F 022-1(1)	1955	5	30

PROJECT NO F15(3)

NOTE: All Plants within borrow area will be transplanted by Maintenance.

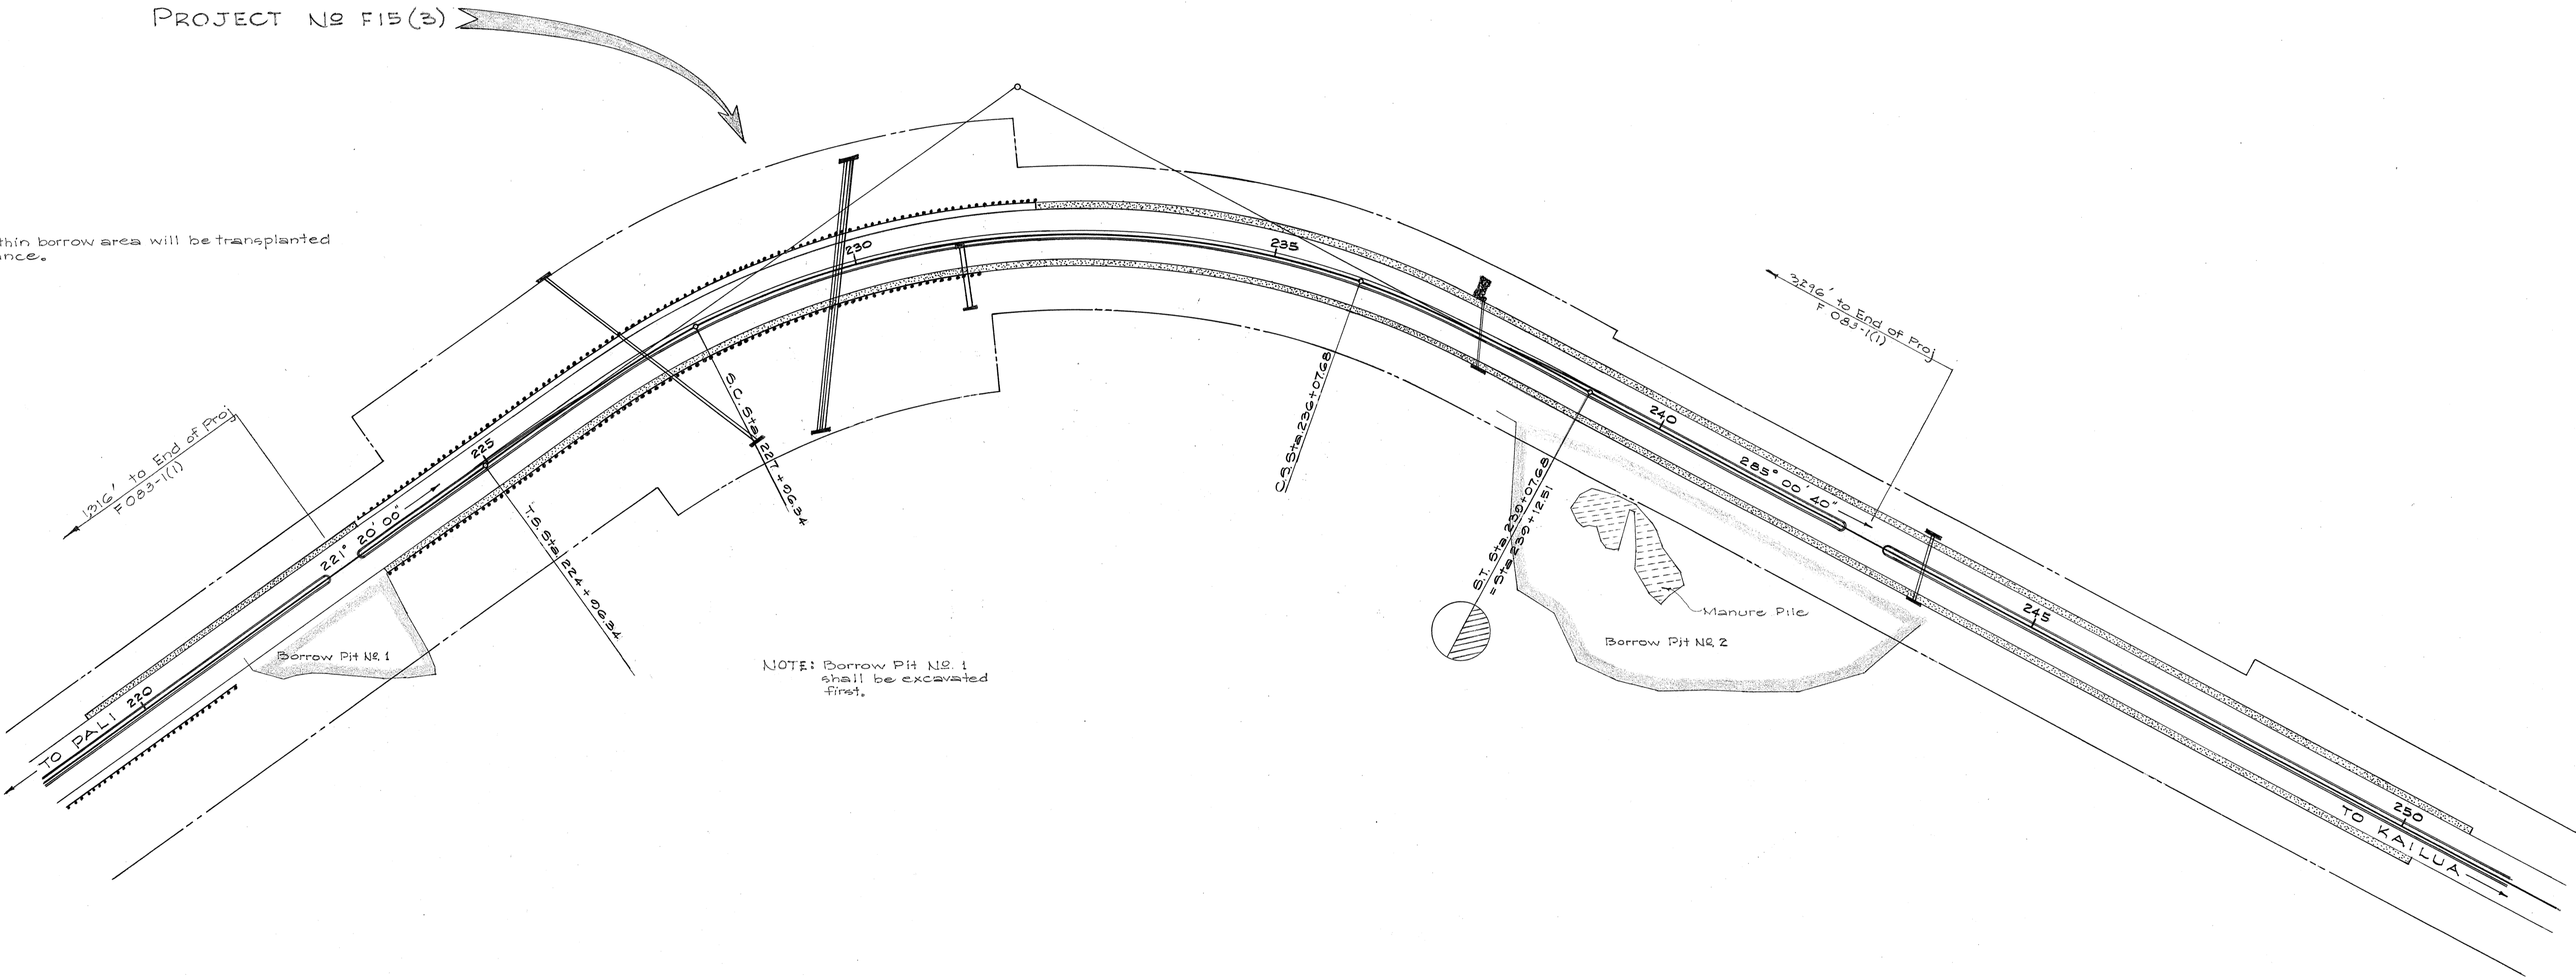

ORIGINAL PLAN	DATE
DESIGNED BY	" "
DRAWN BY	" "
CHECKED BY	" "
NOTE BOOK	" "
NO.	" "

TERRITORIAL HIGHWAY DEPARTMENT  
TERRITORY OF HAWAII

LOCATION of BORROW PIT  
PROJ. NO. F 022-1(1)  
KAMEHAMEHA HIGHWAY

Scale: 1"=100'-0"  
June 1953