


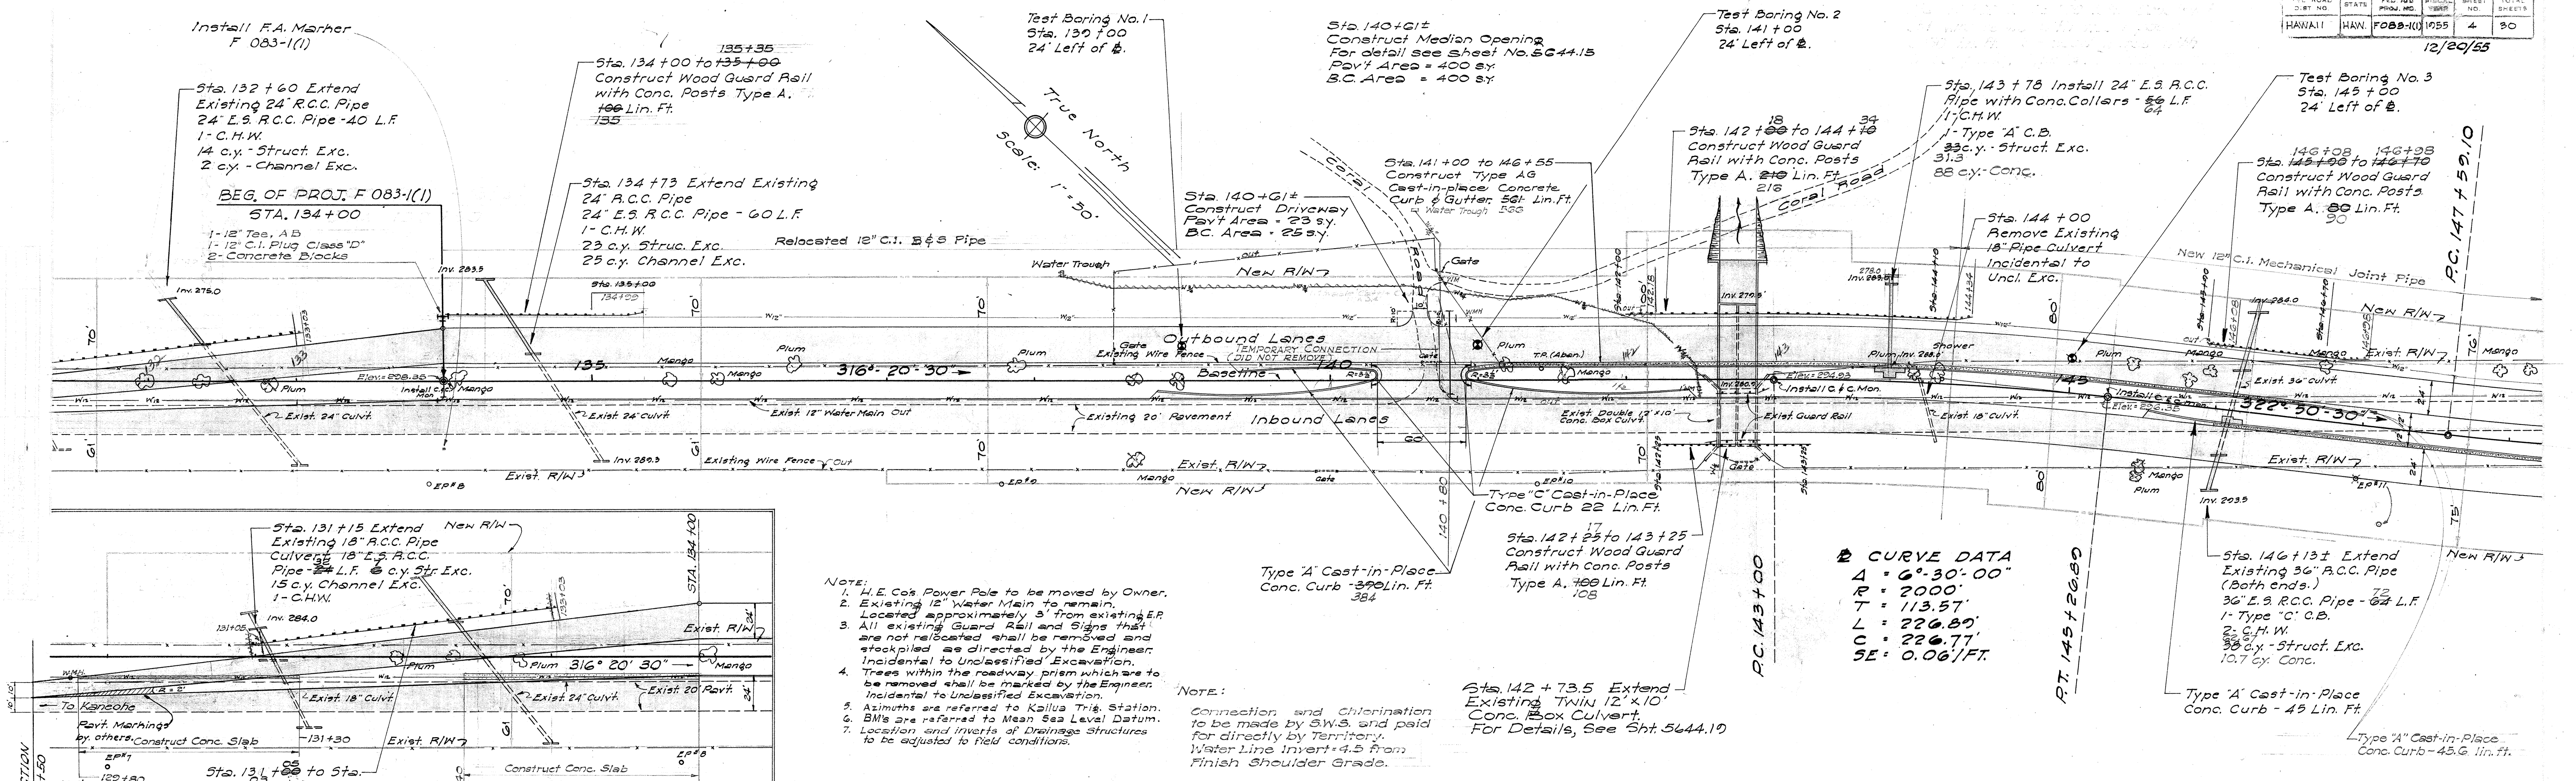

- NOTE:
- H.E. Co's Power Pole to be moved by Owner.
 - Existing 12" Water Main to remain. Located approximately 3' from existing E.P.
 - All existing Guard Rail and Signs that are not relocated shall be removed and stockpiled as directed by the Engineer. Incidental to Unclassified Excavation.
 - Trees within the roadway prism which are to be removed shall be marked by the Engineer. Incidental to Unclassified Excavation.
 - Azimuths are referred to Kailua Tri. Station.
 - B.M's are referred to Mean Sea Level Datum.
 - Location and inverts of Drainage Structures to be adjusted to field conditions.
- NOTE:
- Connection and Chlorination to be made by S.W.S. and paid for directly by Territory. Water Line Invert = 4.5' from Finish Shoulder Grade.

EARTHWORK SUMMARY PROJ. NO. F 083-1(1)	
1ST PHASE (New Construction)	2ND PHASE Widening
BORROW = 26,896 CY	1,143 CY
FREEHAUL = 16,832 CY	1,924 CY
TOTAL EMB. = 36,024 CY	2,556 CY
TOTAL EXC. = 16,832 CY	1,924 CY

