

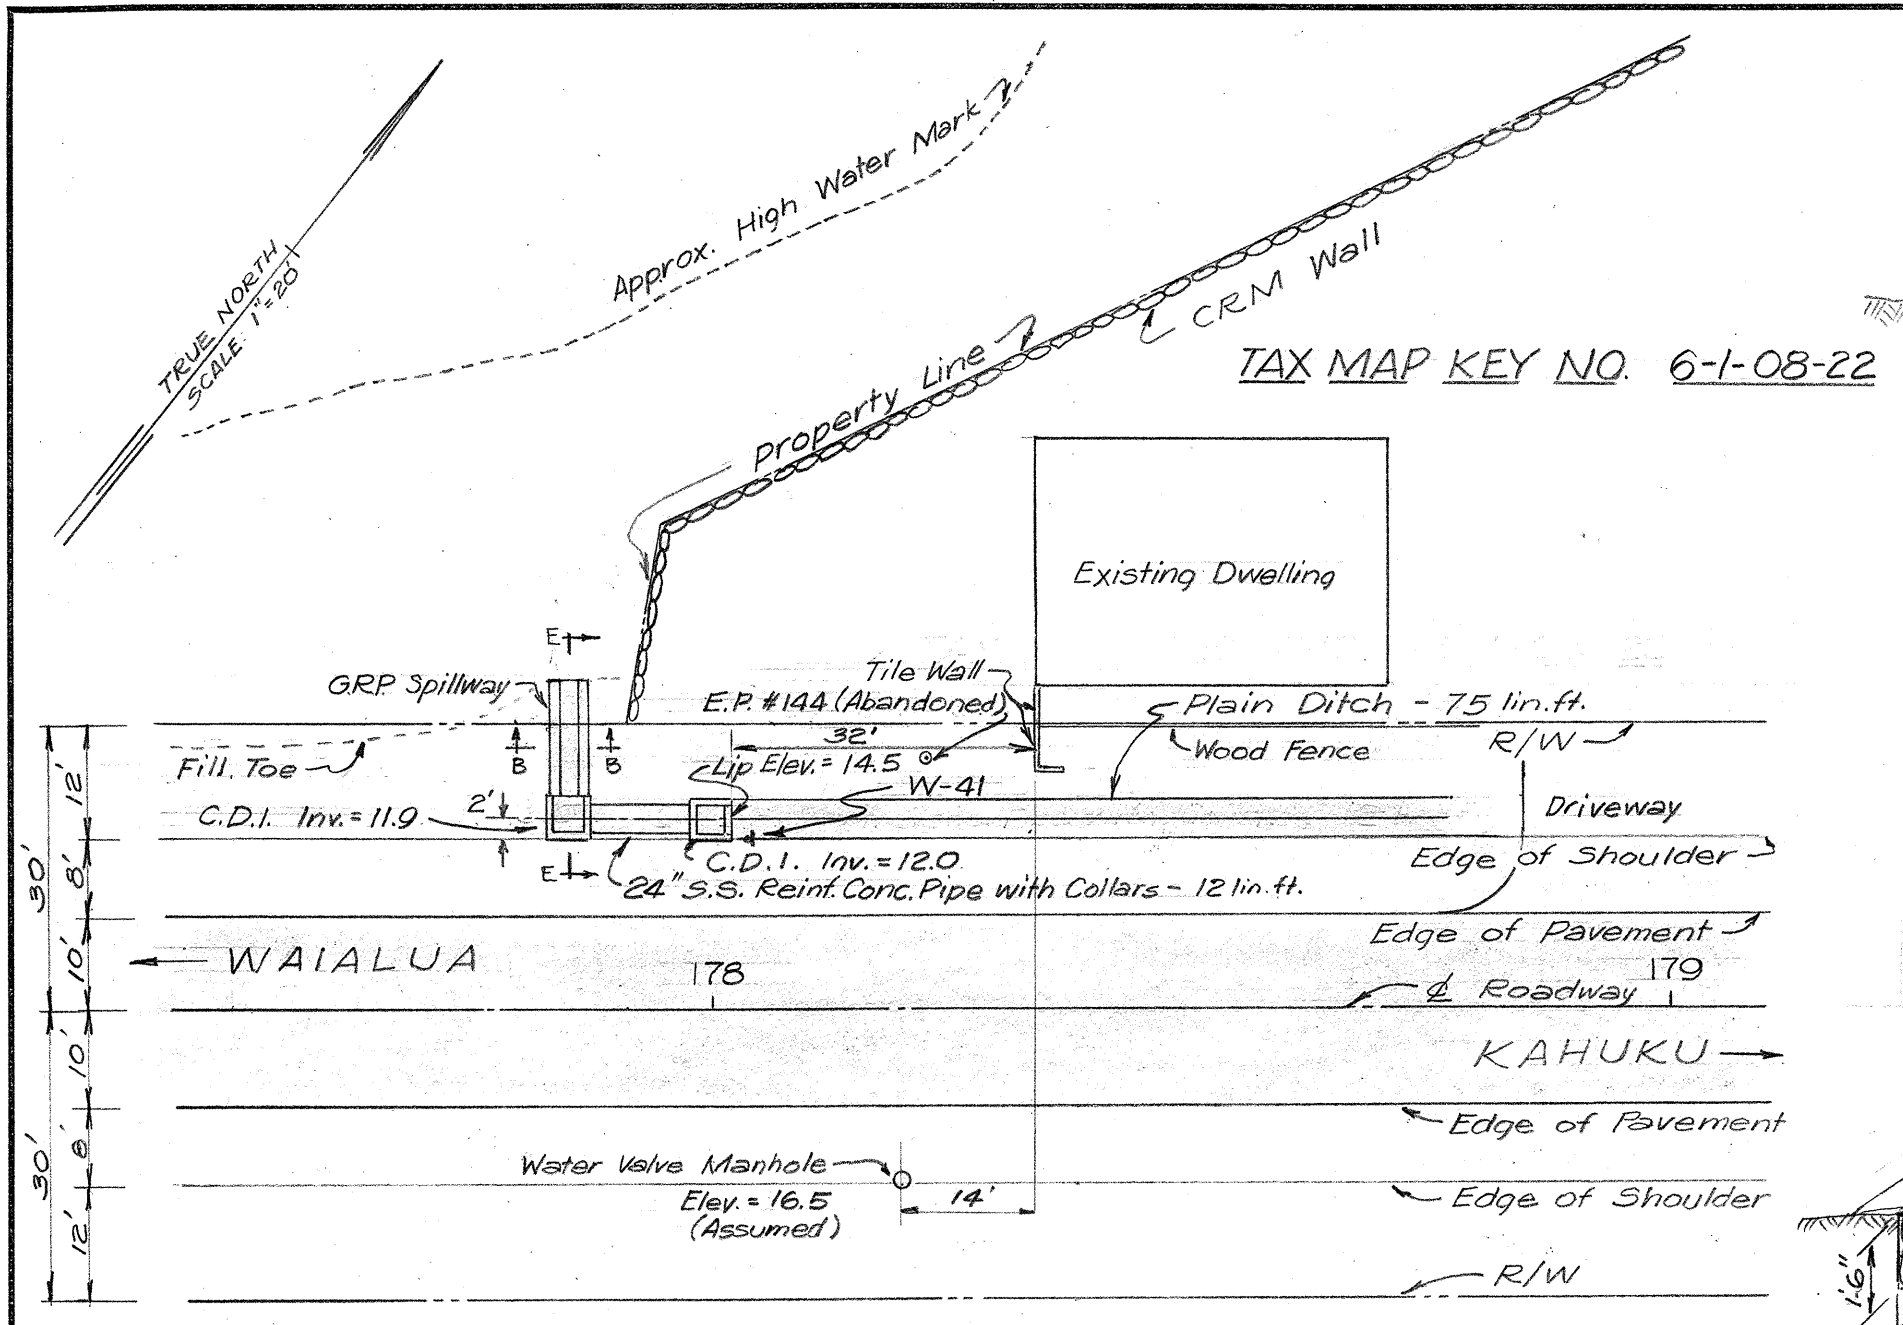



FED. ROAD DIST. NO.	STATE	FED. AID PROJ. NO.	FISCAL YEAR	SHEET NO.	TOTAL SHEETS
			1956	3	12

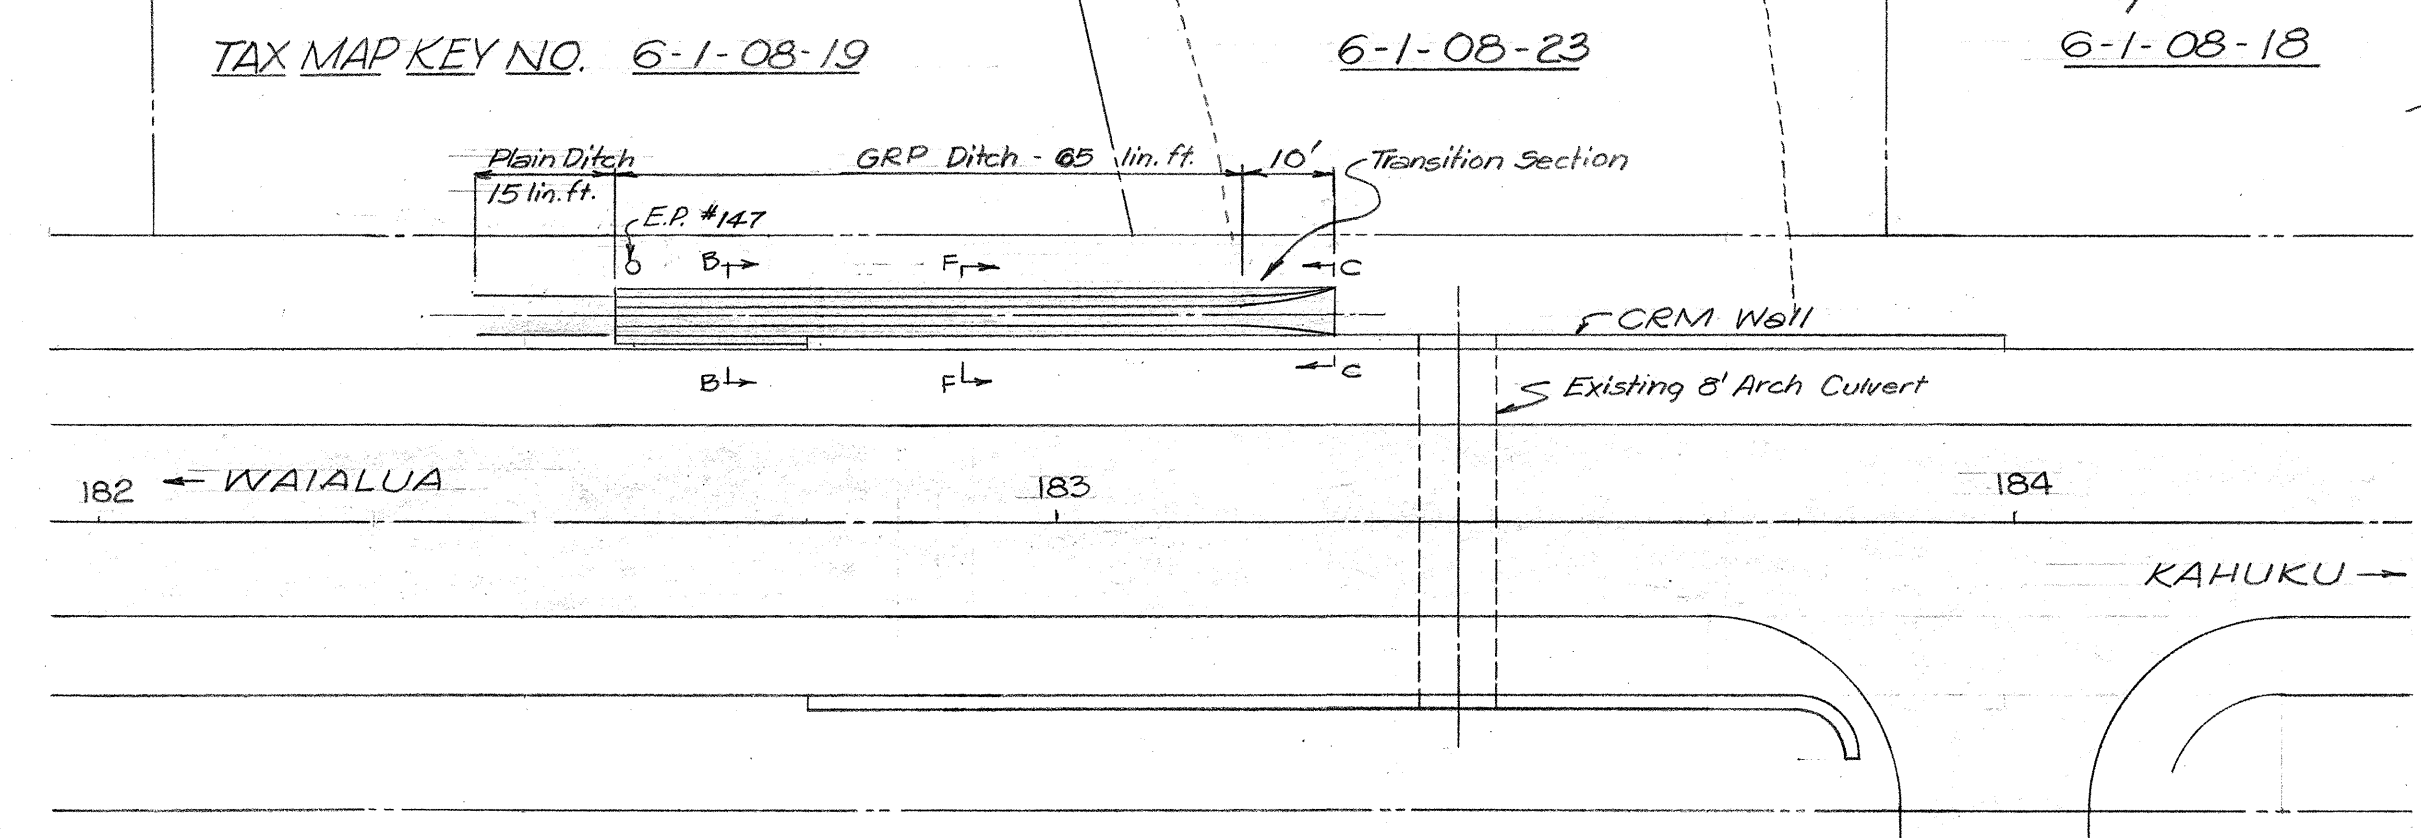


PLAN - Sta 178+00±
Scale: 1" = 20'-0"

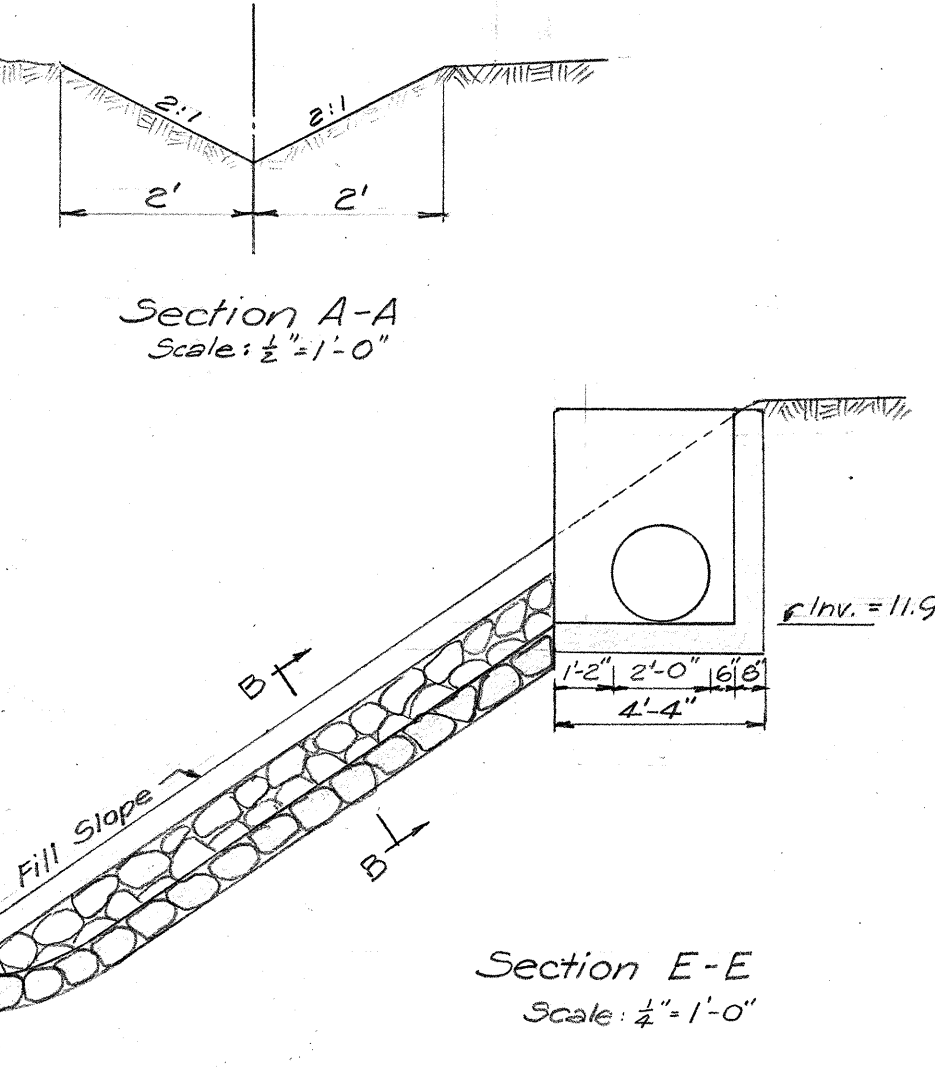


PLAN - Sta 183+00±
Scale: 1" = 20'-0"

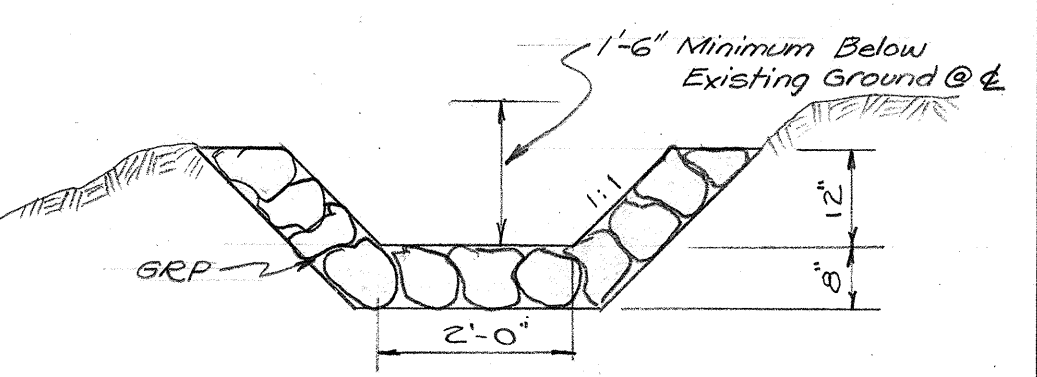


Section B-B
Scale: 1/2" = 1'-0"

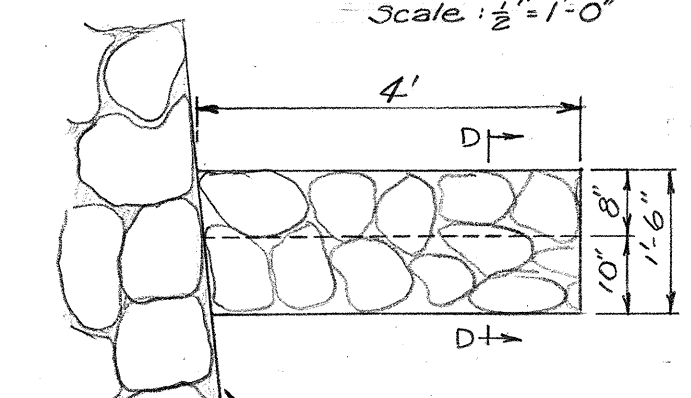


Section C-C
Scale: 1/2" = 1'-0"

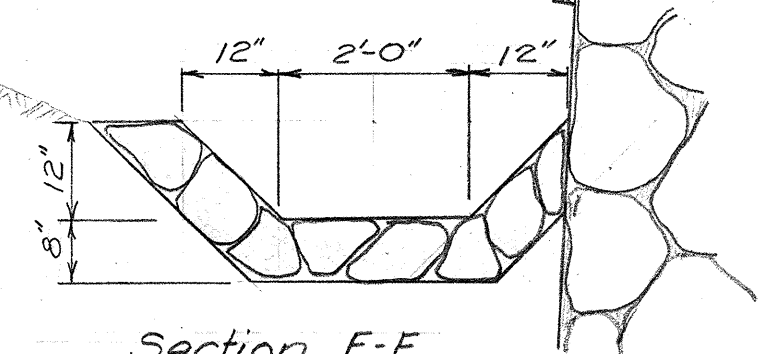


Section F-F
Scale: 1/2" = 1'-0"

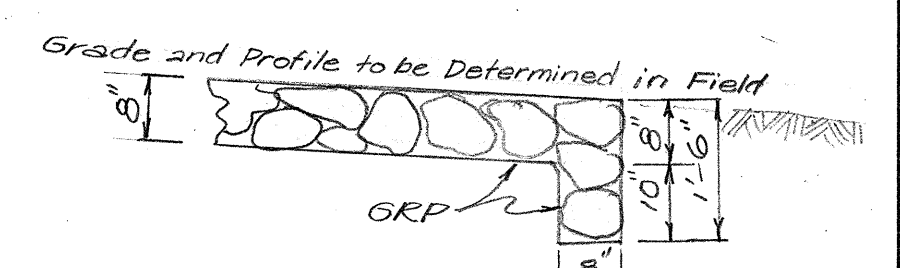


Section D-D
Scale: 1/2" = 1'-0"

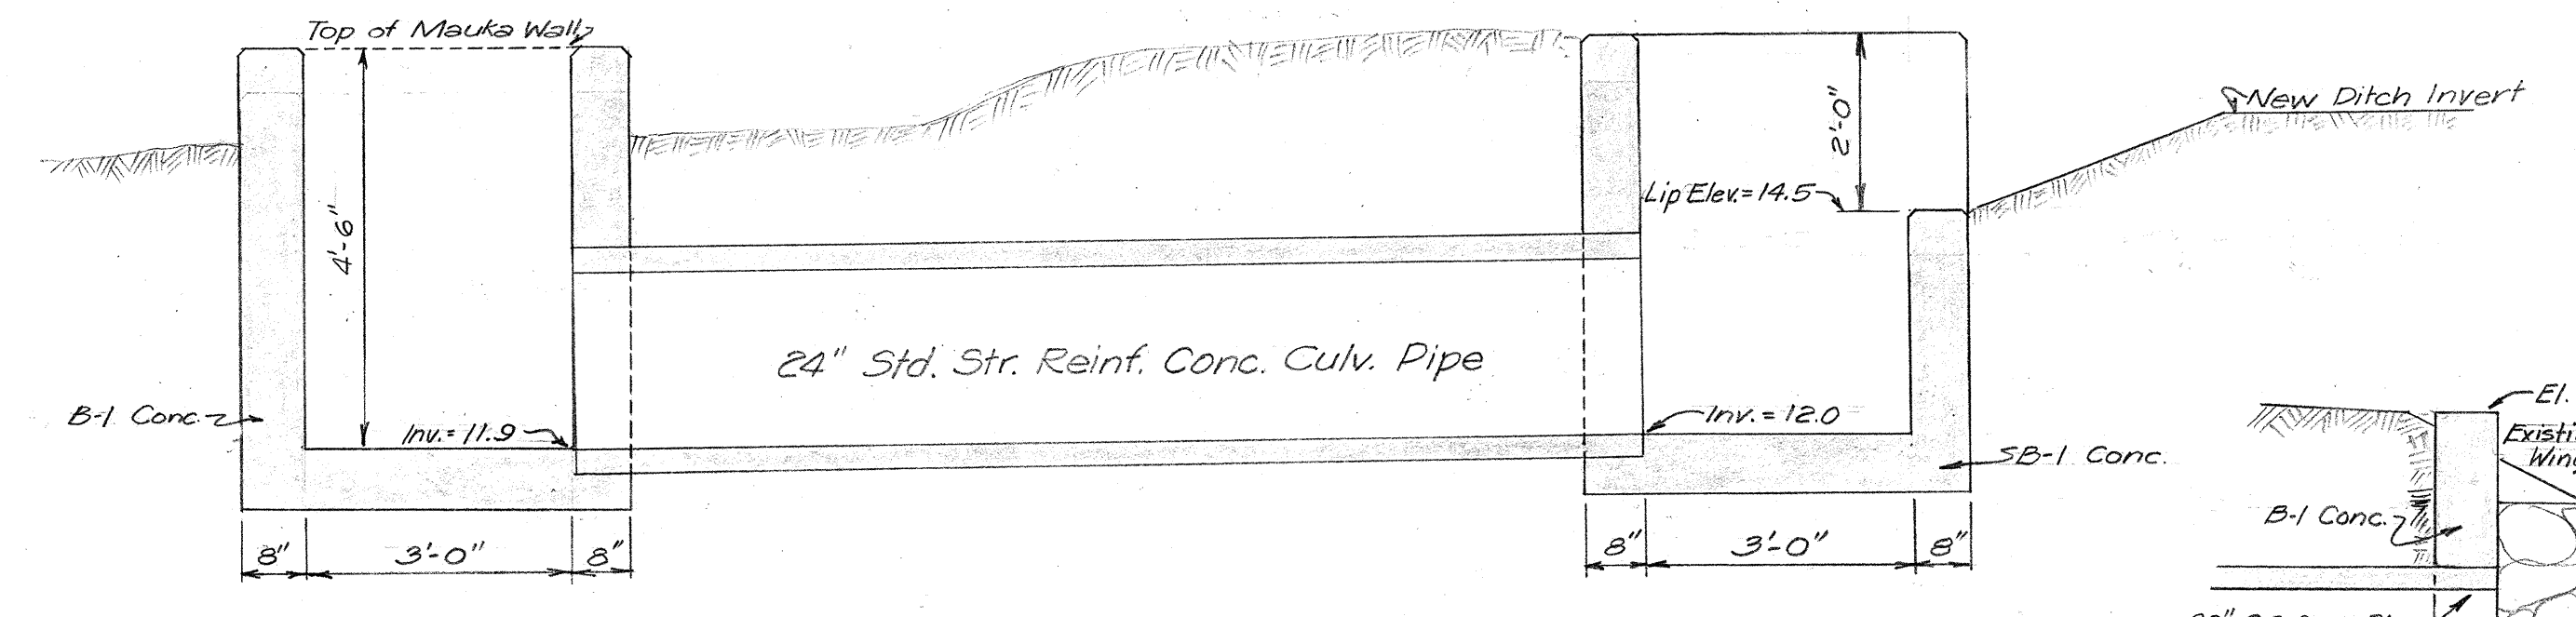


SECTION THRU C. OF CULVERT
Scale: 1/2" = 1'-0"

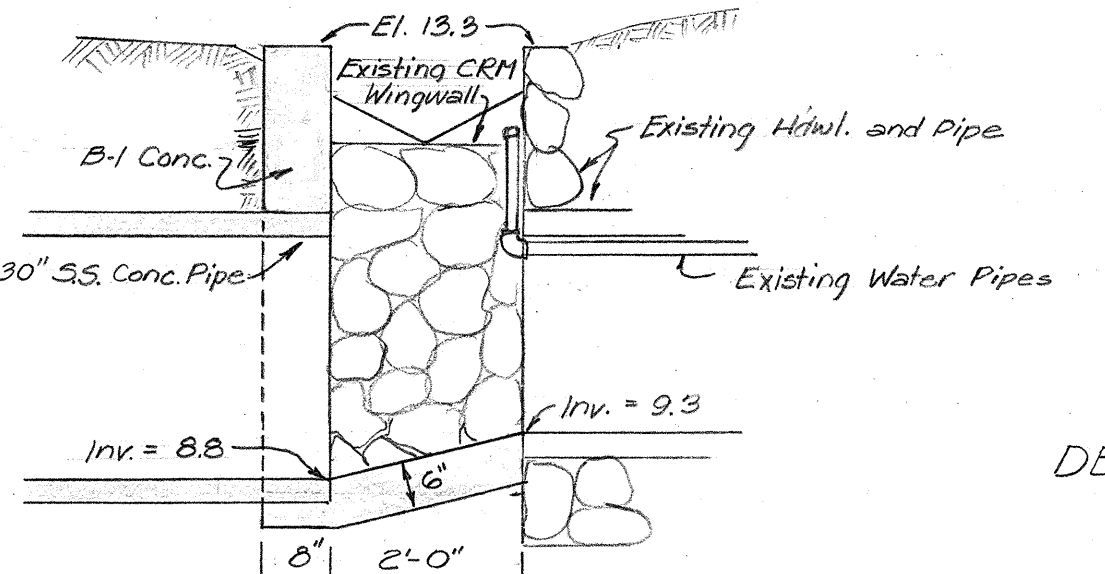


Section G-G
Scale: 1/2" = 1'-0"

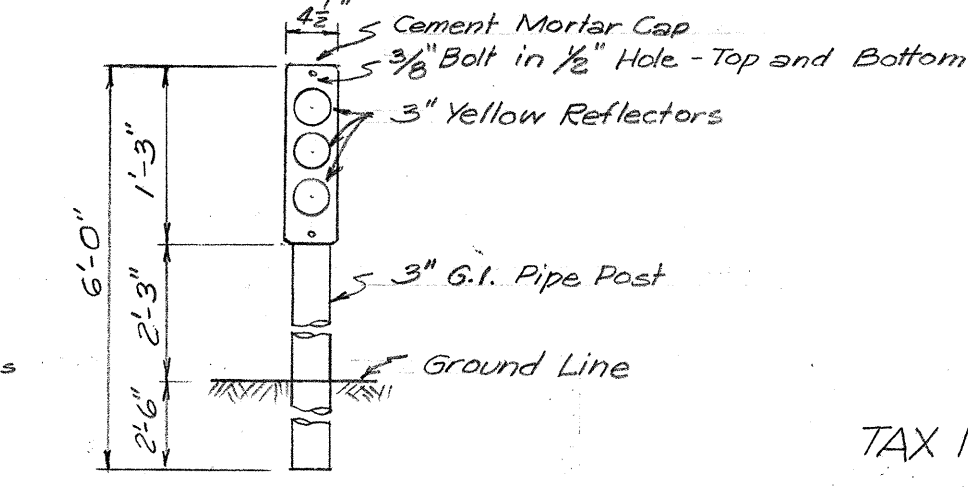


DETAIL OF W-41 MARKER
Scale: 1/2" = 1'-0"

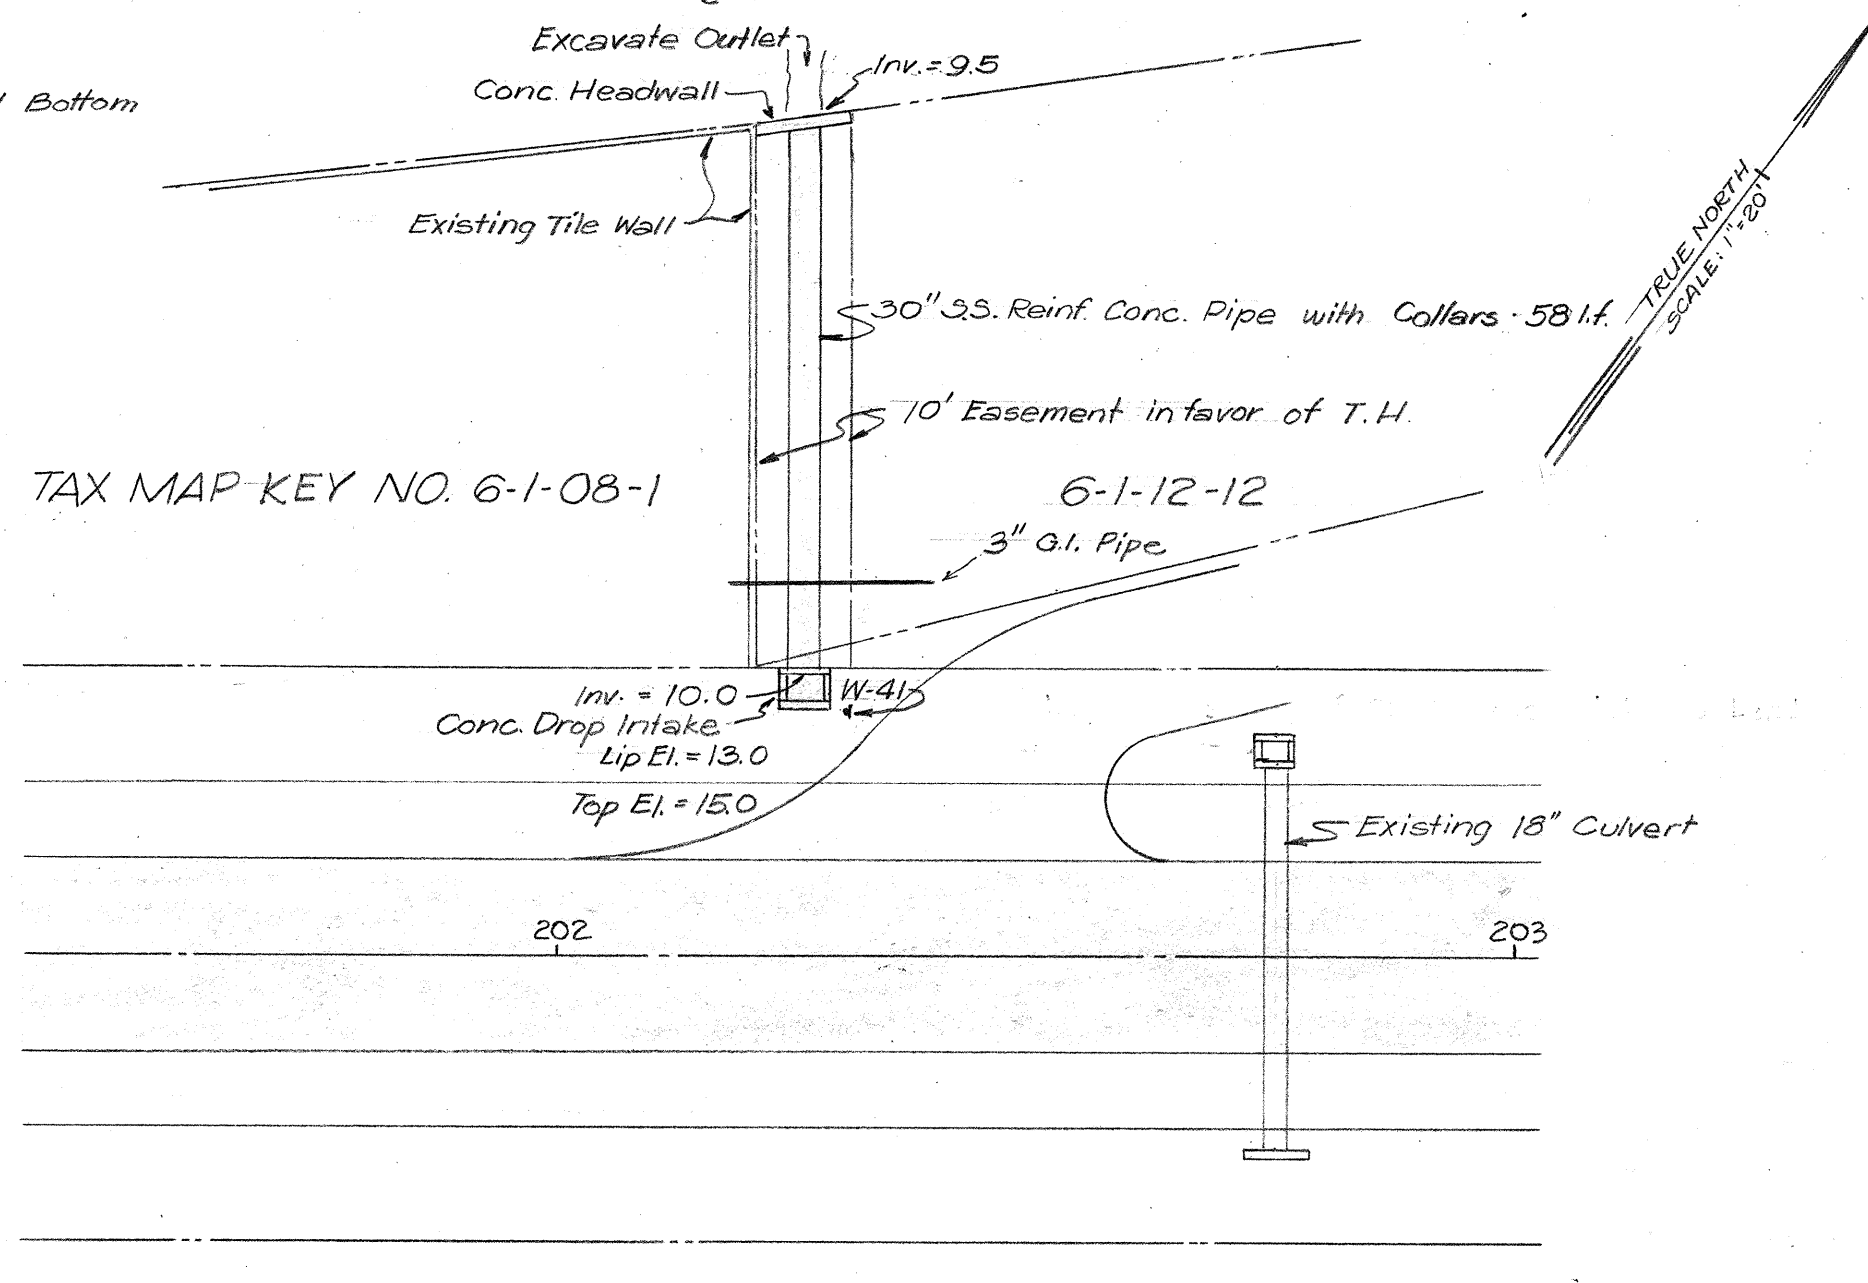


PLAN - Sta 202+26±
Scale: 1" = 20'-0"

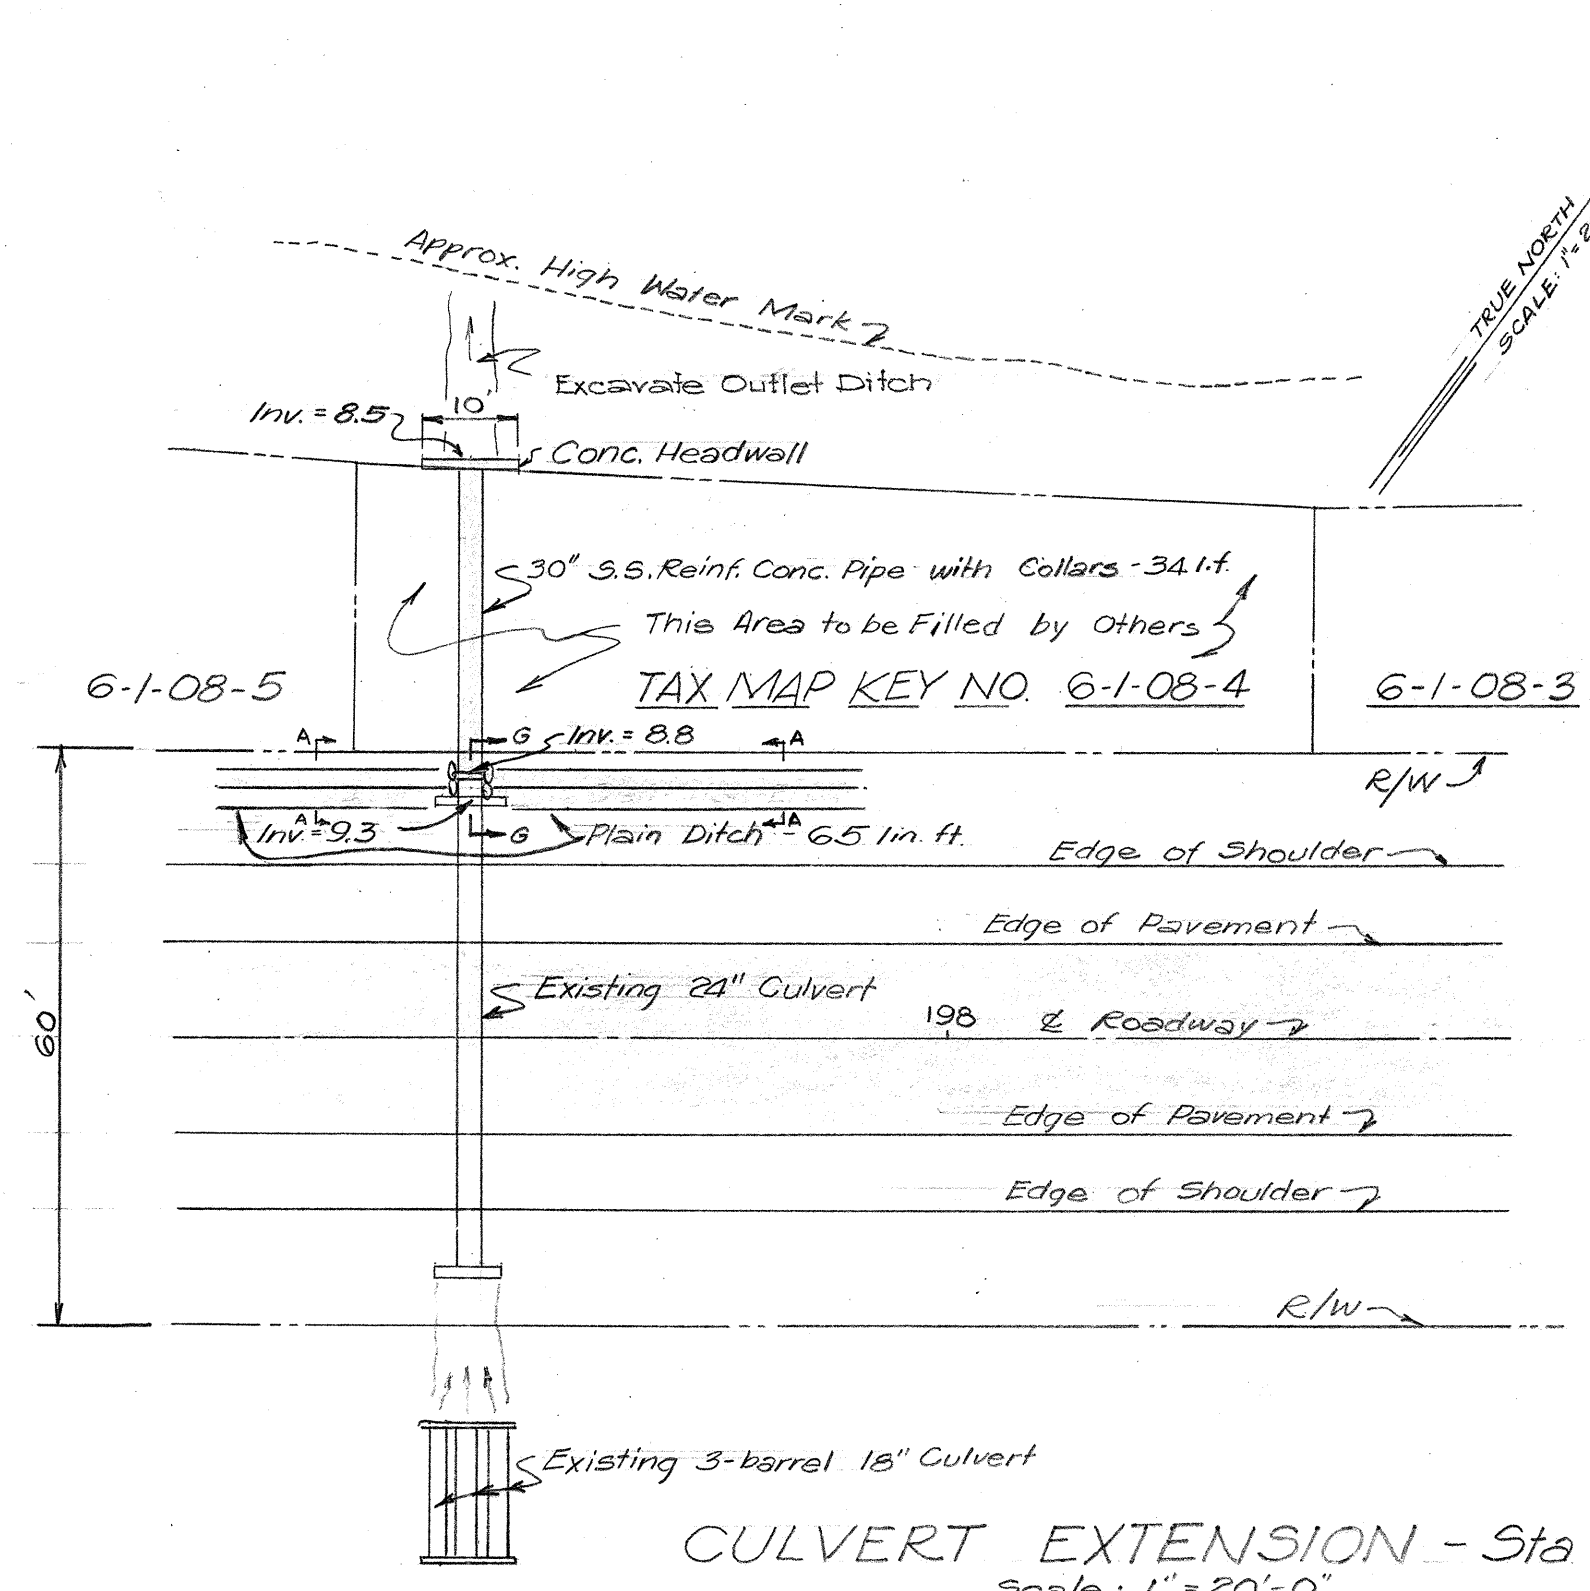

CULVERT EXTENSION - Sta 197+50±
Scale: 1" = 20'-0"

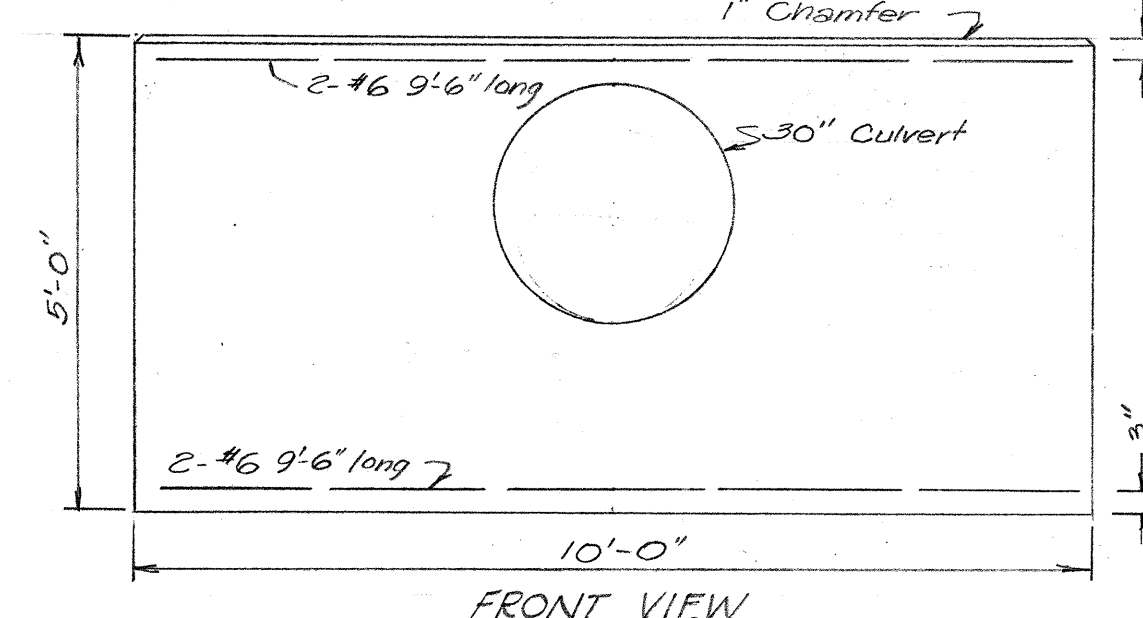

CONCRETE HEADWALL DETAIL
Scale: 1/2" = 1'-0"

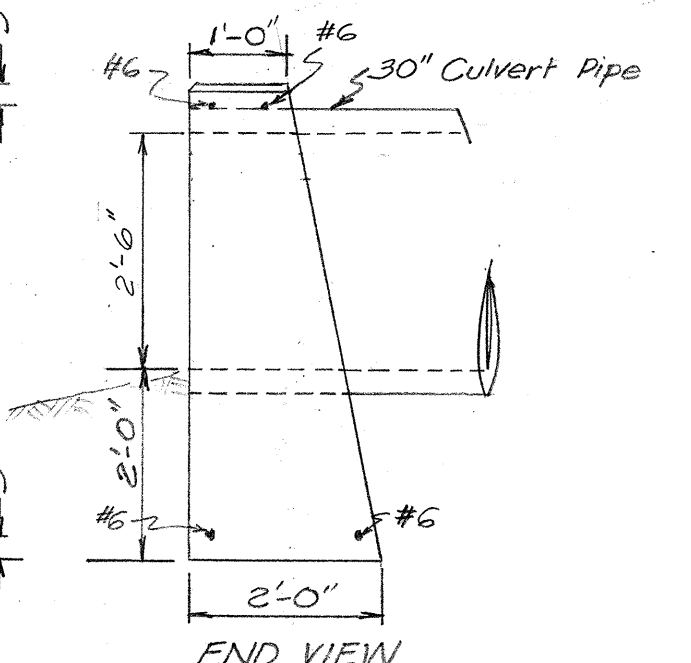

END VIEW

		ESTIMATED QUANTITIES							
Station	Uncl. Exc.	Str. Exc.	B-1 Conc.	Reinf. Steel	24" S.S. Pipe	30" S.S. Pipe	G.R.P.	W-41 Marker	
178+00	6 cy.	12.0 cy.	3.9 cy.		12 lin. ft.		4.3 cy.	1	
183+00	2	31.0					20.7		
197+50	10	26.5	4.0	60 lb.		34 lin. ft.			
202+26	2	55.2	3+9.1	60		58-62		1	
TOTAL	20 cy.	124.7 cy.	17.0	120 lb.	12 lin. ft.	92 lin. ft.	25.0 cy.	2 only	

- GENERAL NOTES
- Roadway stations refer to Fed. Aid Project 3D.
 - All concrete shall be Class B-1.
 - Inverts noted are approximate and final locations are to be adjusted in the field.

TERRITORIAL HIGHWAY DEPARTMENT
TERRITORY OF HAWAII
KAWAIILOA BEACH LOTS
ADJUSTMENT OF DRAINAGE
KAM HIGHWAY
Scale: As Noted June 1956

SHEET NO. OF SHEETS

5867.3