




| FED. ROAD DIST. No. | STATE | FED. AID PROJ. No. | FISCAL YEAR | SHEET No. | TOTAL SHEETS |
|---------------------|-------|--------------------|-------------|-----------|--------------|
|                     |       |                    | 1956        | 5         | 12           |

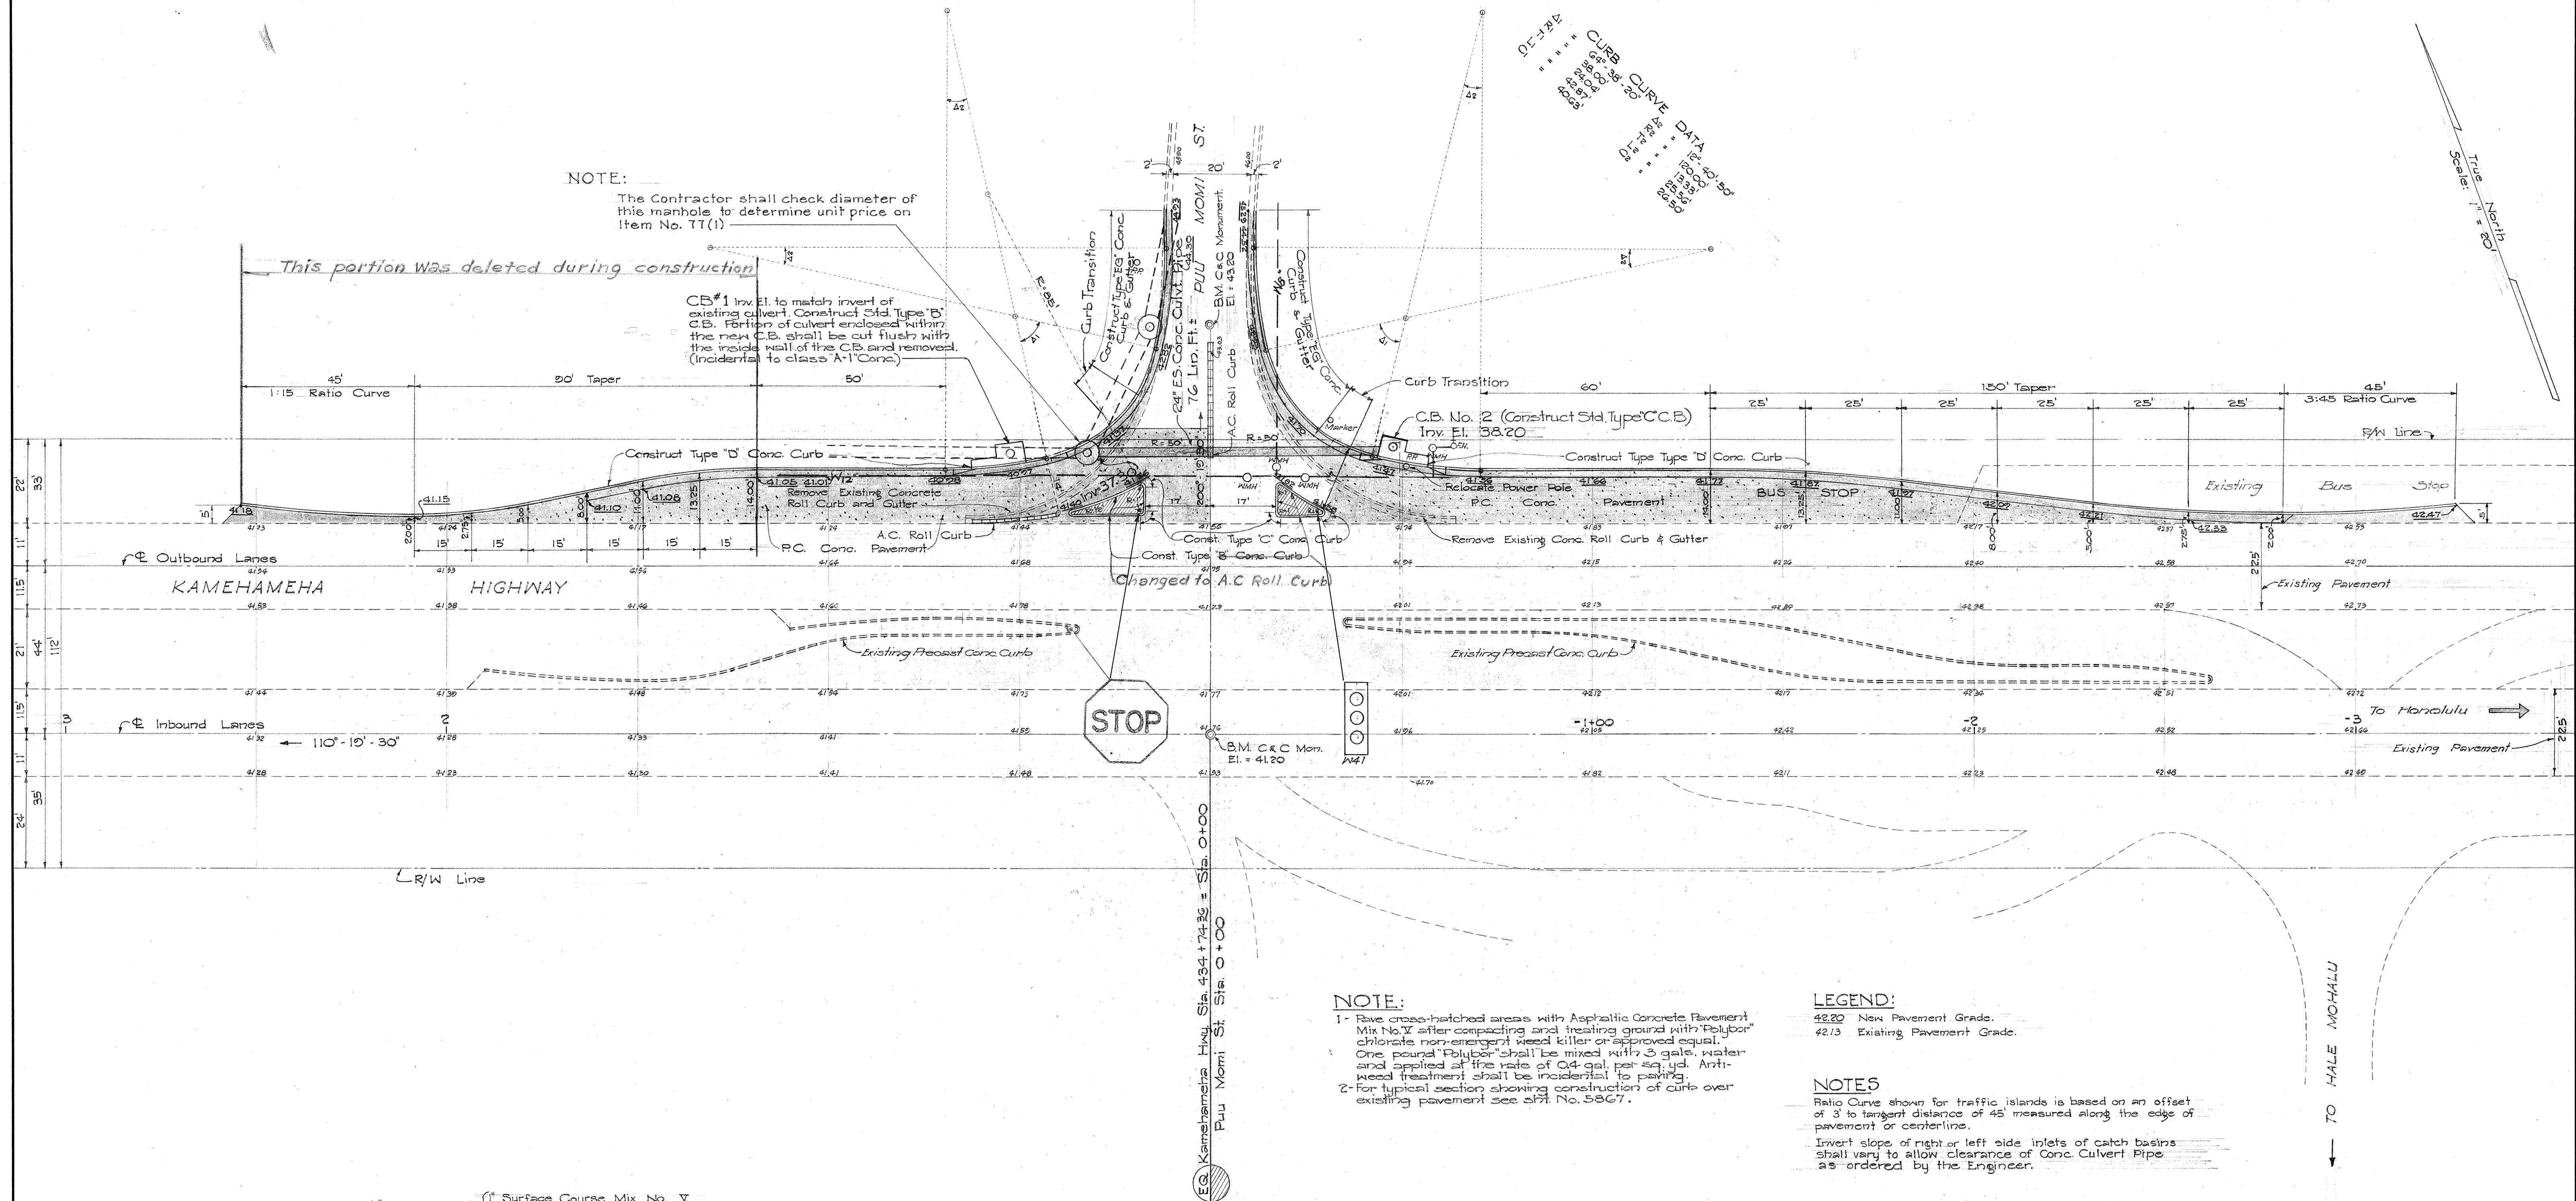

|             |      |
|-------------|------|
| DESIGNED BY | DATE |
| DRAWN BY    |      |
| CHECKED BY  |      |
| NOTE BOOK   |      |
| NO.         |      |

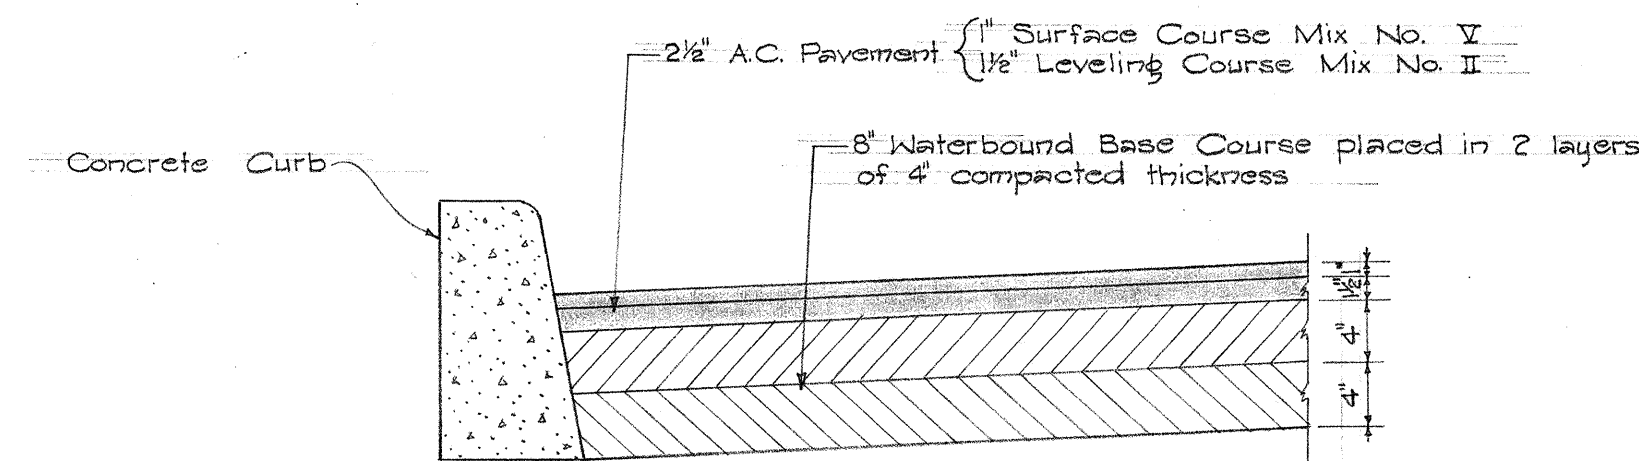

TYPICAL SECTION OF A.C. PAVEMENT  
Scale: 1" = 1'-0"

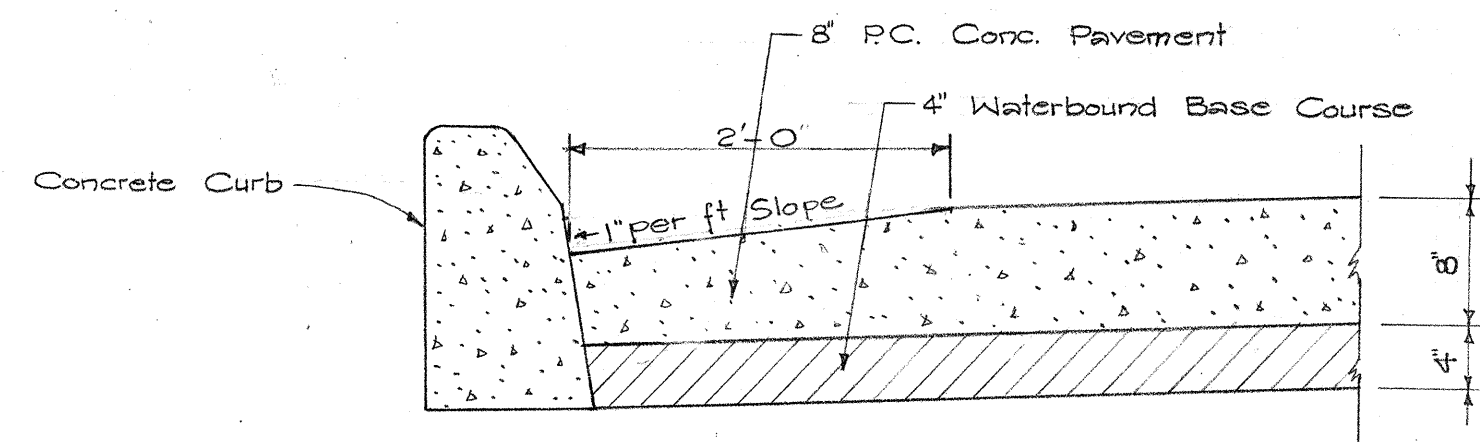

TYPICAL SECTION OF P.C. CONC. PAVEMENT  
Scale: 1" = 1'-0"

TERRITORIAL HIGHWAY DEPARTMENT  
TERRITORY OF HAWAII

INTERSECTION DETAIL  
KAMEHAMEHA HIGHWAY &  
PUU MOMII STREET  
PEARL CITY HEIGHTS

Scale: 1" = 20'

June, 1954

SHEET No. 5 OF 12 SHEETS

| FILE | PROJECT | FOLDER | NO. |
|------|---------|--------|-----|
| 1    | 1       | 3      | 6   |


5867.5



# GENERAL NOTES

- 1- Asphalt Concrete Pavement shall be of thicknesses shown fully compacted. If Mix No. III is used instead of Mix No. II for leveling course, the tonnage of Mix No. III used shall be paid for under contract item No. 42(1).
- 2- Surface of Existing Pavement shall be broomed and given a tack coat of 0.15 gal. per sq. yd. of Emulsified Asphalt before laying variable thickness of A.C. Mix No. II of leveling course or A.C. Mix No. V surface course wherever the latter mix is placed directly on existing pavement.
- 3- Prime Coat; Slow Curing Liquid Asphalt for Prime Coat shall be applied to the surface of Base Course at the rate of 0.35 gal. per sq. yd. before placing leveling course.
- 4- All manholes in the roadway prism shall be reset to new grades as directed by the Engineer.
- 5- Where new concrete curbs of various types are to be connected to reconstructed curbs or to existing curbs, the new curbs shall have transition of not less than 10'-0" to match the curb faces and height.
- 6- Where new concrete curbs change from one type to another type, the heights and faces of concrete curbs shall have transition of not less than 10'-0" unless otherwise shown.
- 7- Top slab of drainage structures shall be in line with the adjacent curbs and shall be sloped to the finished grade of sidewalk, shoulder, or median strip as the case may be.
- 8- Where catch basins are to be constructed the face of all conc. curbs other than type "D" curb (cast-in-place or precast) adjacent to the catch basins shall have transition of not less than 10'-0".

| FED. ROAD DIST. No. | STATE | FED. AID PROJ. No. | FISCAL YEAR | SHEET No. | TOTAL SHEETS |
|---------------------|-------|--------------------|-------------|-----------|--------------|
|                     |       |                    | 1956        | 6         | 12           |

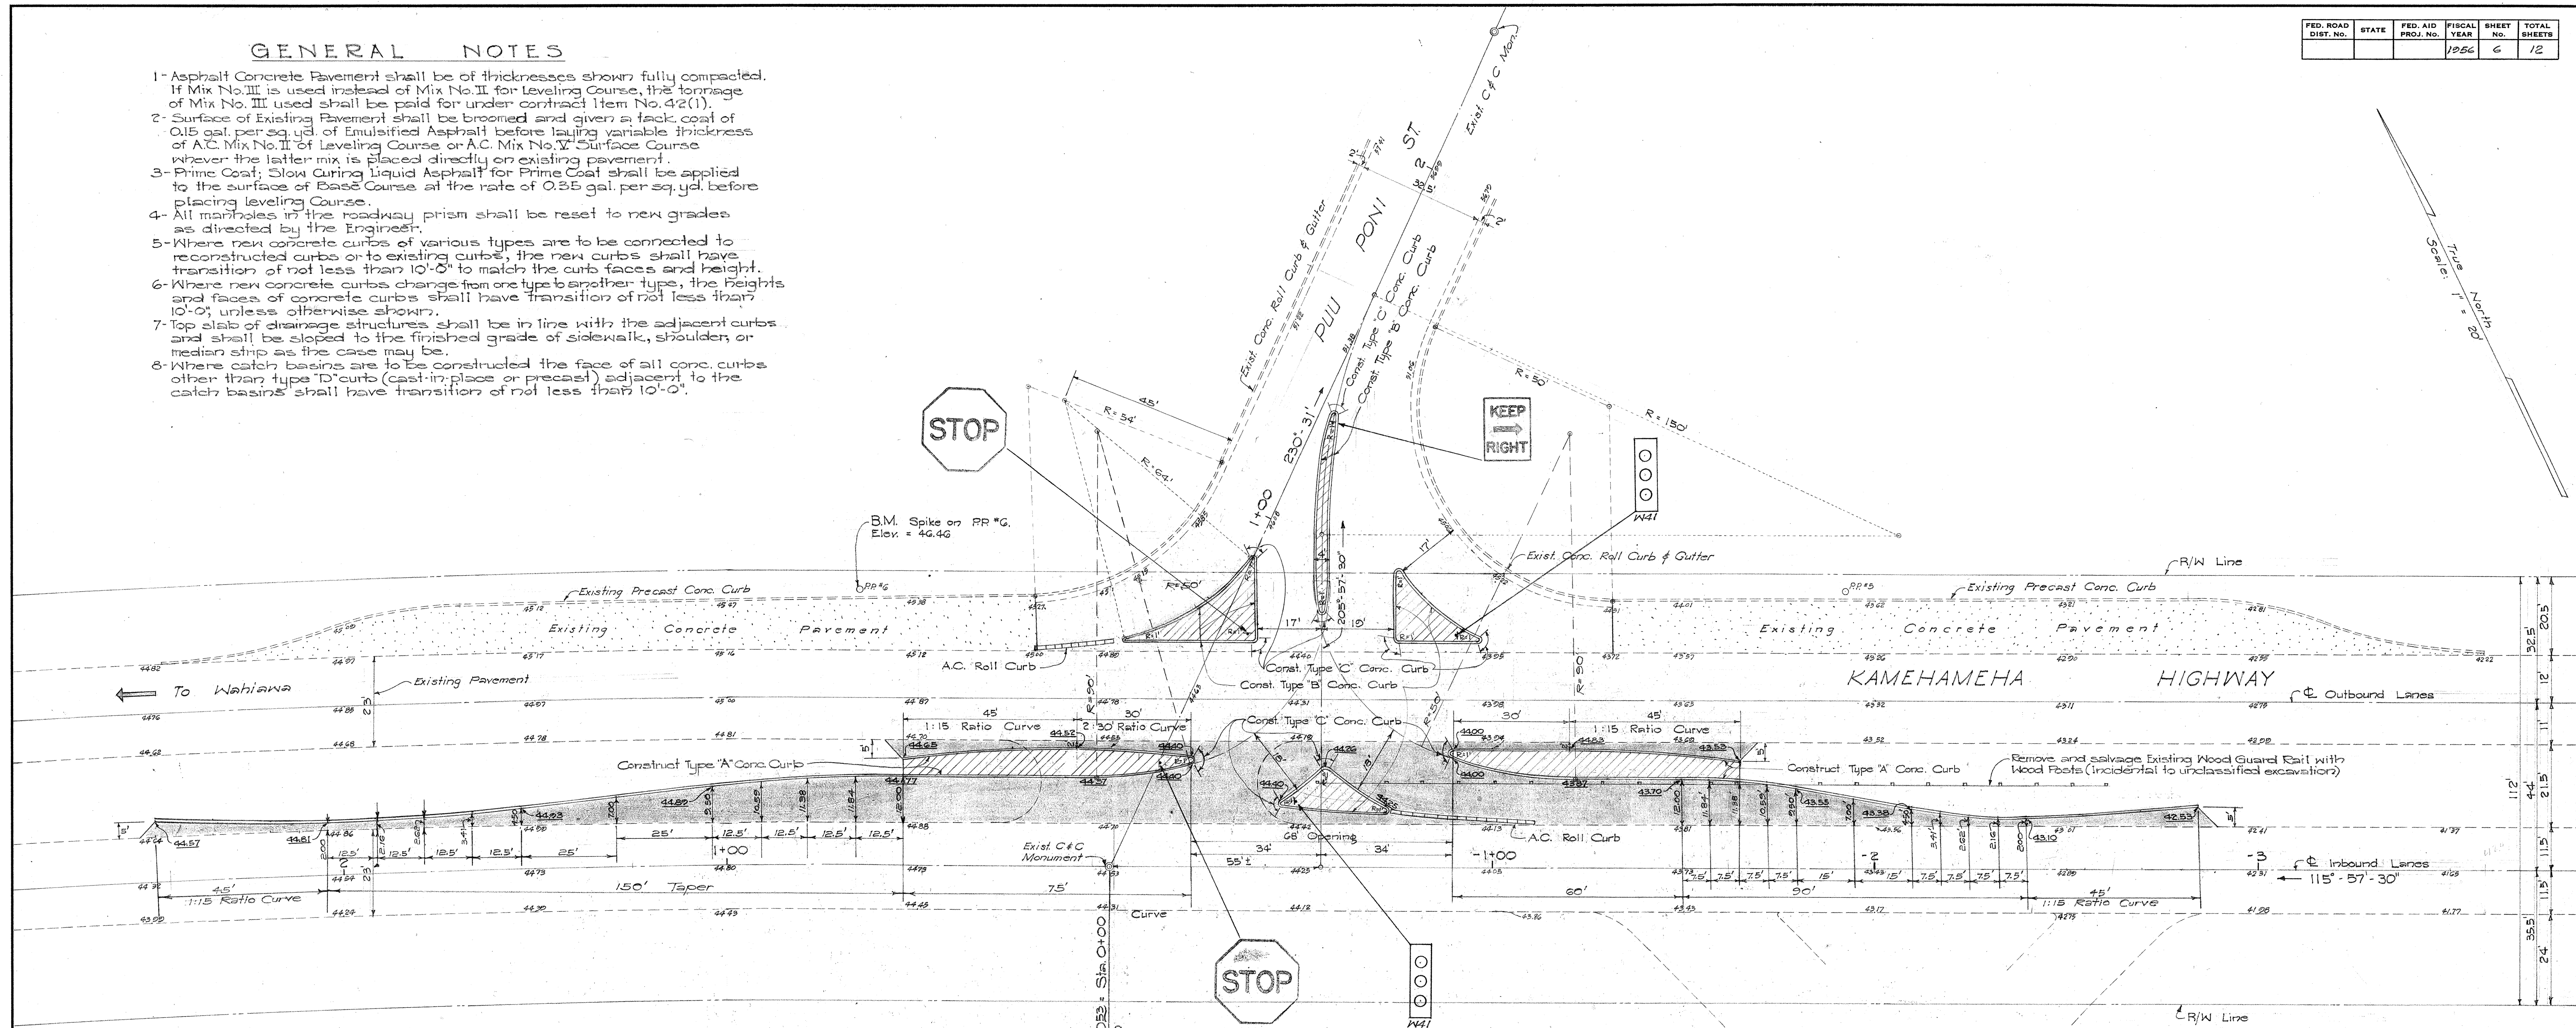

## NOTE:

- 1- Pave cross-hatched areas with Asphaltic Concrete Pavement Mix No. V after compacting and treating ground with 'Polybor' chlorate non-emergent weed killer or approved equal. One pound 'Polybor' shall be mixed with 3 gals. water and applied at rate of 0.4 gal. per sq. yd. Anti-weed treatment shall be incidental to paving.
- 2- For typical section showing construction of curb over existing pavement see sheet No. 5867.


## LEGEND:

- 43.05 New Pavement Grade.  
43.01 Existing Pavement Grade.

## NOTE:

Ratio Curve shown for traffic islands is based on an offset of 3' to tangent distance of 45' measured along the edge of pavement or centerline.

|                       |      |
|-----------------------|------|
| SURVEY PLATTED BY     | DATE |
| DESIGNED BY           |      |
| DRAWN BY              |      |
| CHECKED BY            |      |
| QUANTITIES CHECKED BY |      |
| NOTE BOOK No.         |      |

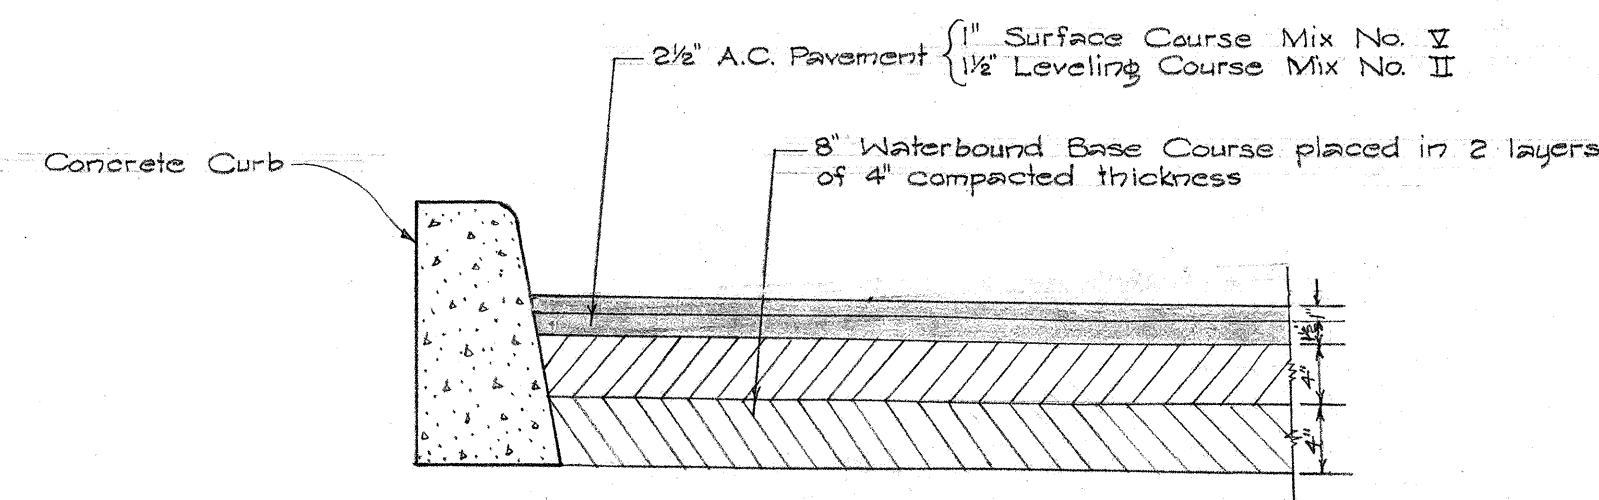

TYPICAL SECTION OF AC PAVEMENT

Scale: 1" = 1'-0"

| TERRITORIAL DEPARTMENT OF PUBLIC WORKS |   |   |   |
|----------------------------------------|---|---|---|
| DISPATCH ENGINEER - OAHU               |   |   |   |
| 1                                      | 1 | 3 | 7 |

TERRITORIAL HIGHWAY DEPARTMENT  
TERRITORY OF HAWAII

INTERSECTION DETAIL  
KAMEHAMEHA HIGHWAY &  
PUU PONII STREET  
PEARL CITY HEIGHTS

Scale: 1" = 20'

June, 1954


SHEET No. OF SHEETS

5867.6



| FED. ROAD DIST. NO. | STATE | FED. AID PROJ. NO. | FISCAL YEAR | SHEET NO. | TOTAL SHEETS |
|---------------------|-------|--------------------|-------------|-----------|--------------|
|                     |       |                    | 1954        | 7         | 12           |

True North  
Scale: 1" = 80'

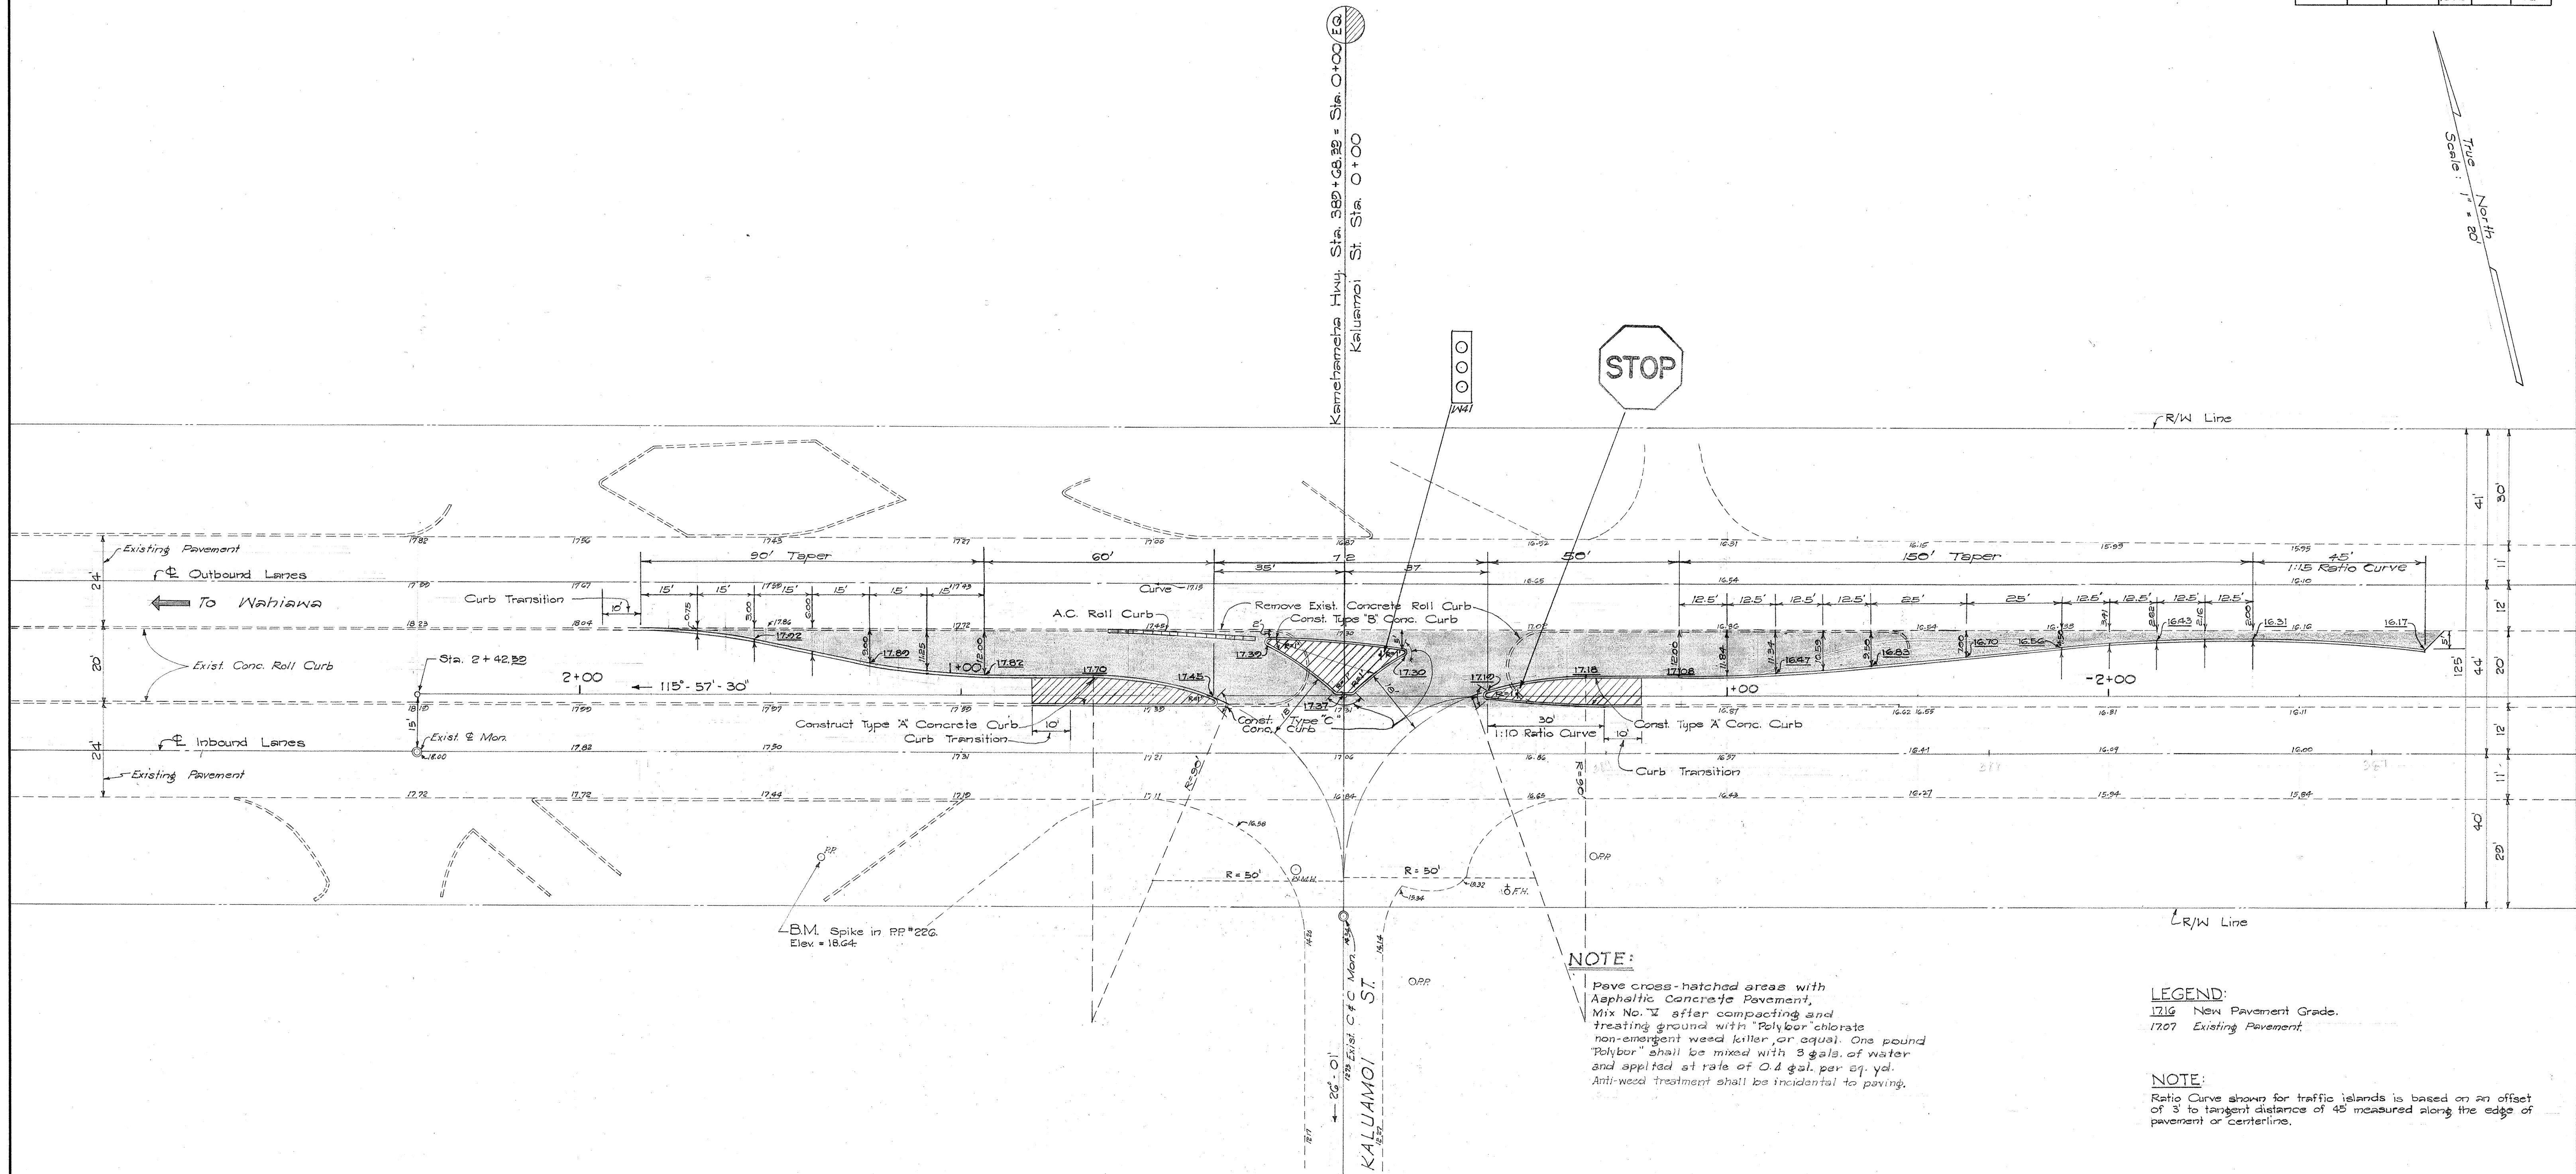

**NOTE:**

Pave cross-hatched areas with Asphaltic Concrete Pavement, Mix No. X after compacting and treating ground with "Polybor" chlorate non-emergent weed killer, or equal. One pound "Polybor" shall be mixed with 3 gals. of water and applied at rate of 0.4 gal. per sq. yd. Anti-weed treatment shall be incidental to paving.


**LEGEND:**

1716 New Pavement Grade.  
1707 Existing Pavement.


**NOTE:**

Ratio Curve shown for traffic islands is based on an offset of 3' to tangent distance of 45' measured along the edge of pavement or centerline.

|                       |      |
|-----------------------|------|
| SURVEY PLOTTED BY     | DATE |
| DRAWN BY              |      |
| CHECKED BY            |      |
| QUANTITIES CHECKED BY |      |
| NOTE BOOK NO.         |      |

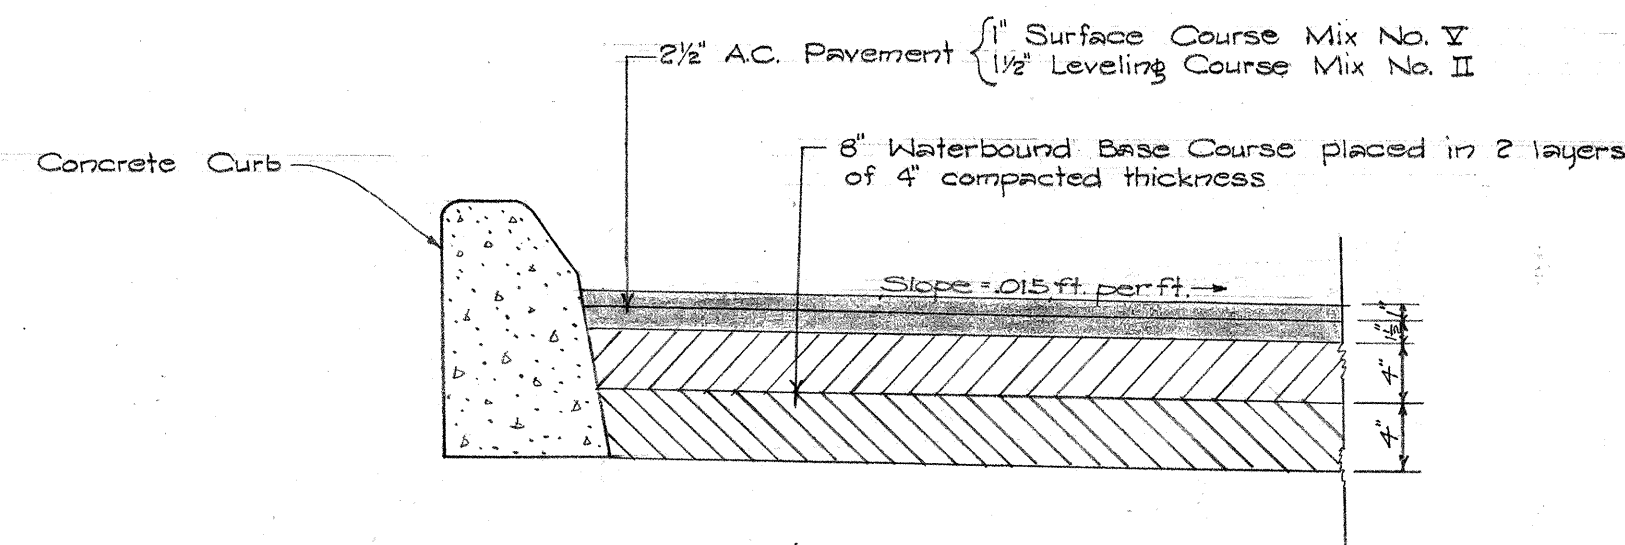

TYPICAL SECTION OF PAVEMENT  
Scale: 1" = 1'-0"

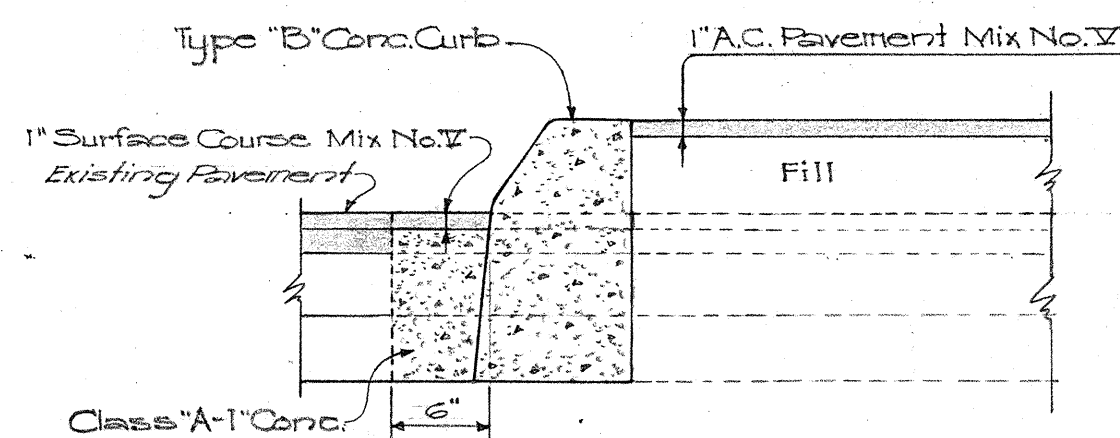

TYPICAL SECTION SHOWING CONSTRUCTION OF TRAFFIC ISLAND OVER EXISTING PAVEMENT  
Scale: 1" = 1'-0"

TERRITORIAL HIGHWAY DEPARTMENT  
TERRITORY OF HAWAII

INTERSECTION DETAIL  
KAMEHAMEHA HIGHWAY AND  
KALUAMOI STREET


Scale: 1" = 20' June, 1954

SHEET NO. OF SHEETS

5867




| FED. ROAD DIST. NO. | STATE | FED. AID PROJ. NO. | FISCAL YEAR | SHEET NO. | TOTAL SHEETS |
|---------------------|-------|--------------------|-------------|-----------|--------------|
|                     |       |                    | 1956        | 8         | 12           |

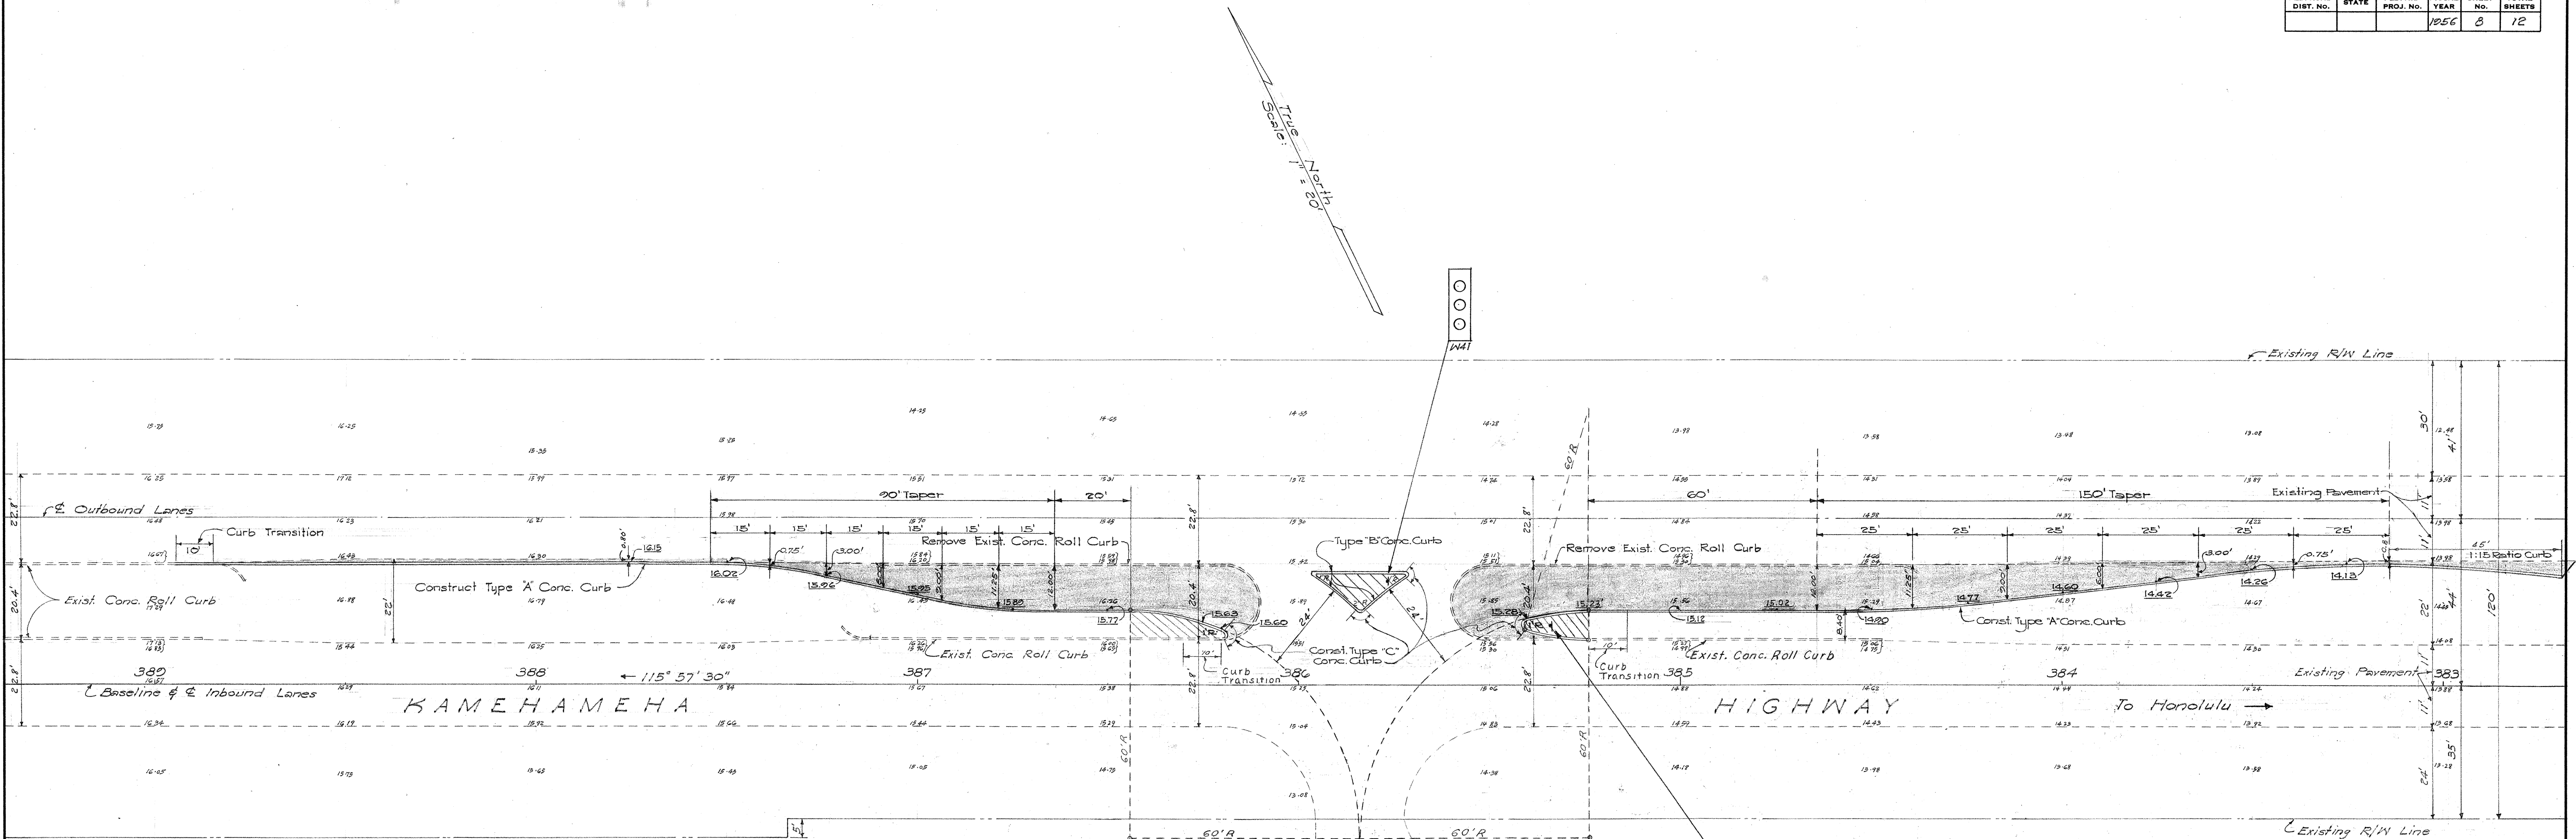

LEGEND:  
 14.57 New Pavement Grade  
 14.30 Existing Pavement

NOTE:  
 1- Pave cross-hatched areas with Asphaltic Concrete Pavement, Mix No. V after compacting and treating ground with Polybor Chlorate non-emergent weed killer, or equal. One pound "Polybor" shall be mixed with 3 gals. of water and applied at a rate of 0.4 gals. per sq. yd. Anti-weed treatment shall be incidental to paving.  
 2- For typical section showing construction of curb over existing pavement see sht. No. 5867

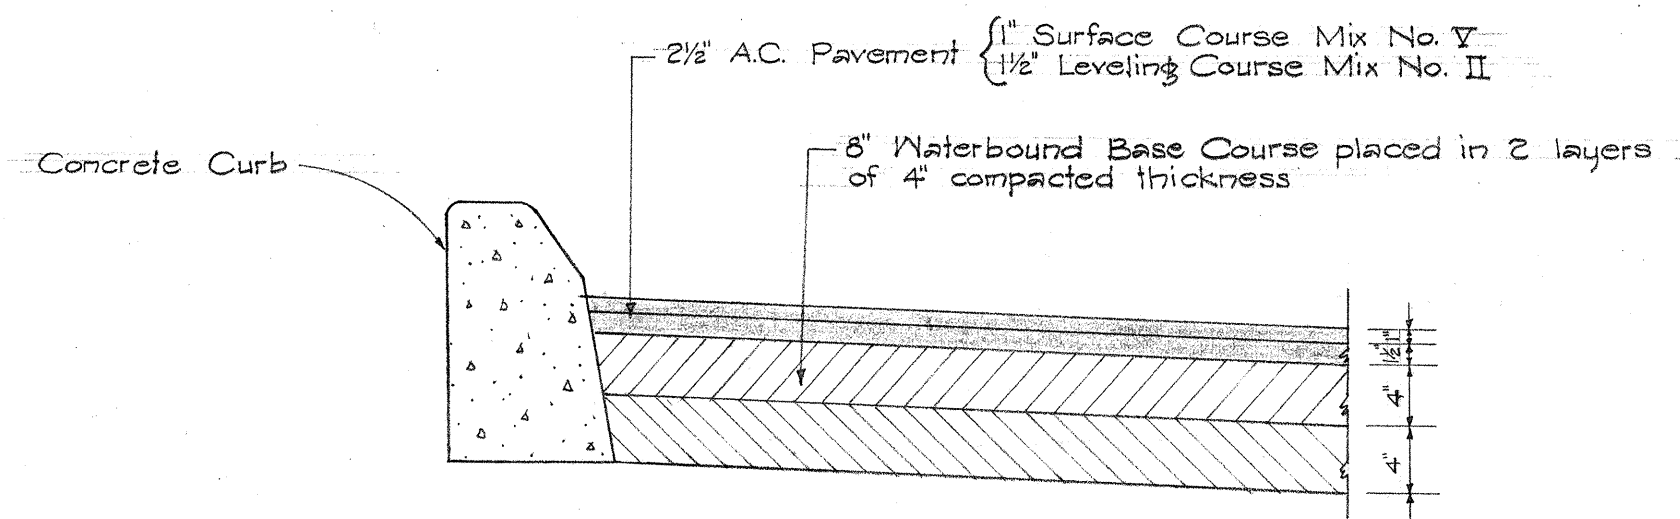

TYPICAL SECTION OF PAVEMENT  
 Scale: 1" = 1'-0"

TERRITORIAL HIGHWAY DEPARTMENT  
 TERRITORY OF HAWAII  
 INTERSECTION DETAIL  
 KAMEHAMEHA HIGHWAY AND  
 ENTRANCE TO WAIMALLI DRUM STORAGE  
 Scale: 1" = 20' July, 1956


SHEET No. OF SHEETS

5867.8


| DATE        | BY |
|-------------|----|
| DESIGNED BY |    |
| DRAWN BY    |    |
| CHECKED BY  |    |
| NOTE BOOK   |    |
| NO.         |    |



| FED. ROAD DIST. No. | STATE | FED. AID PROJ. No. | FISCAL YEAR | SHEET No. | TOTAL SHEETS |
|---------------------|-------|--------------------|-------------|-----------|--------------|
|                     |       |                    | 1954        | 2         | 12           |

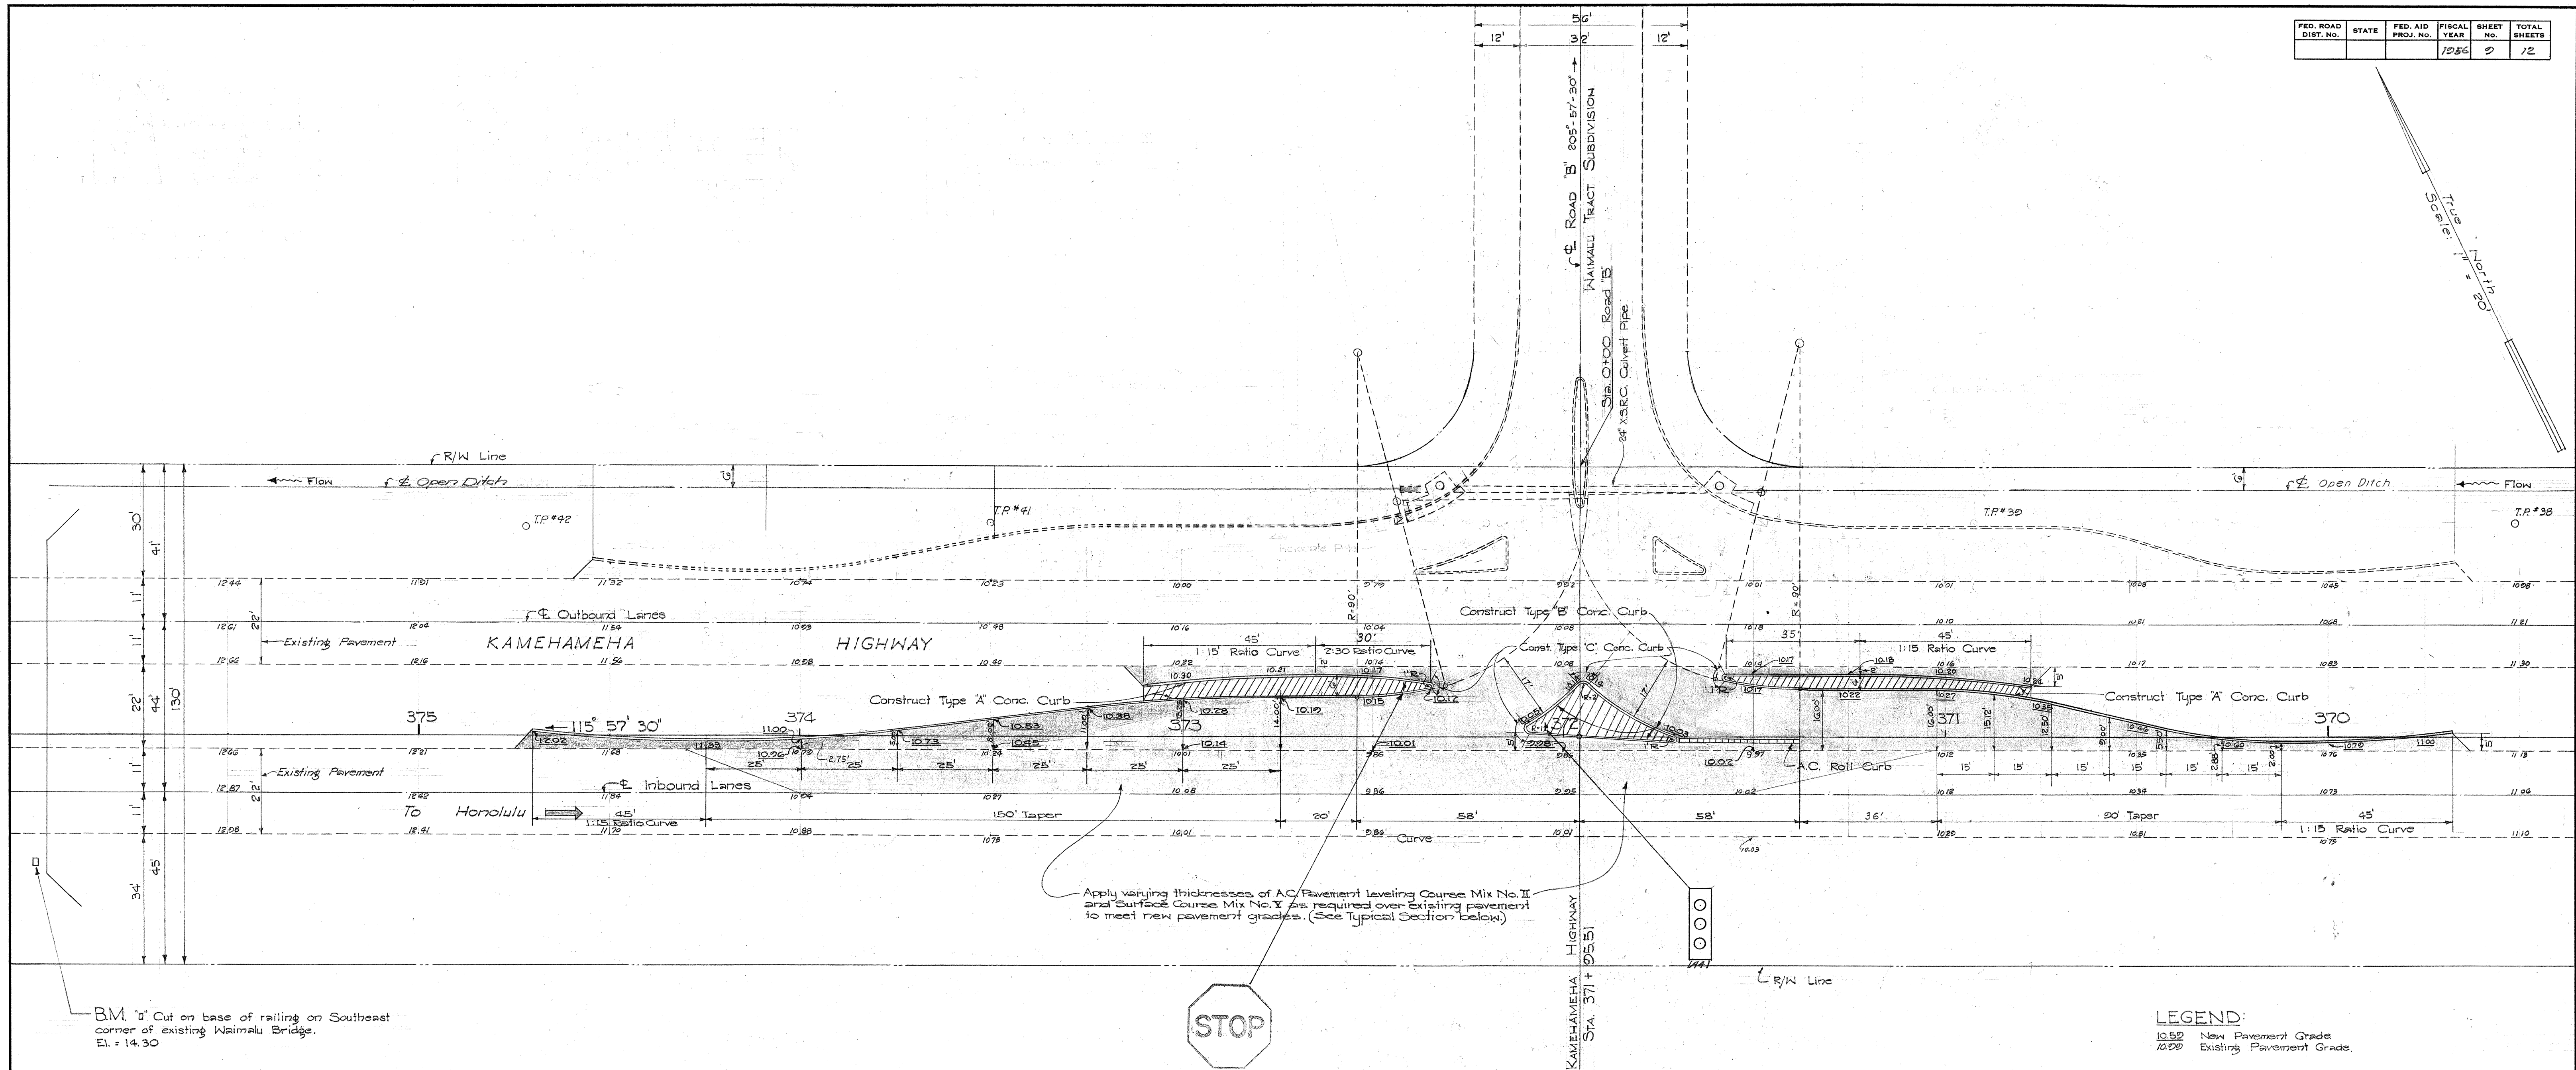

BM "b" Cut on base of railing on Southeast corner of existing Waimalu Bridge. El. = 14.30

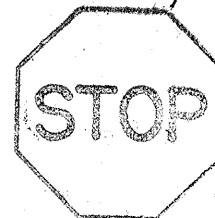

#### LEGEND:

10.50 New Pavement Grade  
10.00 Existing Pavement Grade

#### NOTE:

Ratio Curve shown for traffic islands is based on an offset of 3' to tangent distance of 45' measured along the edge of pavement or centerline.

#### NOTE:

Pave cross-hatched areas with Asphaltic Concrete Pavement Mix No. V after compacting and treating ground with "Polybor" chlorate non-emergent weed killer or equal. One pound "Polybor" shall be mixed with 5 gals. of water and applied at rate of 0.4 gal. per sq. yd. Anti-weed treatment shall be incidental to paving.

#### TYPICAL SECTION OF PAVEMENT

Scale: 1" = 1'-0"

#### TYPICAL SECTION SHOWING RESURFACING OF EXISTING PAVEMENT

Scale: 1/2" = 1'-0"

TERRITORIAL HIGHWAY DEPARTMENT  
TERRITORY OF HAWAII

INTERSECTION DETAIL  
KAMEHAMEHA HIGHWAY &  
WAIMALU TRACT ROAD "B"

Scale: 1" = 20'

June, 1954

SHEET No. OF SHEETS

5867.9

|                       |      |
|-----------------------|------|
| SURVEY PLANNED BY     | DATE |
| DESIGNED BY           |      |
| DRAWN BY              |      |
| CHECKED BY            |      |
| QUANTITIES CHECKED BY |      |
| NOTE BOOK No.         |      |

| TERRITORIAL DEPARTMENT OF PUBLIC WORKS | DISTRICT ENGINEER - OAHU |
|----------------------------------------|--------------------------|
| 1                                      | 1                        |
| 3                                      | 4                        |



| FED. ROAD DIST. NO. | STATE | FED. AID PROJ. NO. | FISCAL YEAR | SHEET NO. | TOTAL SHEETS |
|---------------------|-------|--------------------|-------------|-----------|--------------|
|                     |       |                    | 1954        | 10        | 12           |

TO BE CONSTRUCTED BY OTHERS

STOP

KEEP RIGHT

01-1212 CURB CURVE DATA  
 12.35 12.41 12.47 128.39