

INDEX TO DRAWINGS			
SHEET NO.	DESCRIPTION		
1	Title Sheet	9	Kam Hwy. and Waimalu
2	Location Plan		Tract Road "B"
3	Adjustment of Drainage	10	Kam Hwy. and Waimalu
	Kam Highway- Kawaiiloa		Tract Road "A"
4	Waimano Home Road	11	Culvert- Honolulu-Pearl
5	Kam Hwy. and Puu Momi St.		Harbor Road
6	Kam Hwy. and Puu Poni St.	12	Adjustment of Drains at
7	Kam Hwy. and Kaluamoi St.		Wilder and Dole St.
8	Kam Hwy. and Waimalu Drum Storage		


CONVENTIONAL SIGNS	
Centerline	125
Boundary Lines	, or
Fences (Named)	
Existing Roadways	
Circular Culvert	
Box Culvert	
Bridge	
Telephone Pole	
Electric Power Pole	
Water Main	W ₂ W ₂ (W ₄ , 8, 12, Etc.)
Storm Drain	SD ₁₂ SD ₁₂ (SD ₁₈ , 24, Etc.)
Concrete Drop Intake	C.D.I.
Standard Catch Basin	S.C.B.
Standard Manhole	M.H.S.
Sewer Manhole	S.S. S.S. S ₁₂
Telephone Manhole	T.M.H.
Fire Hydrant	F.H.
Tree (Large, named)	Mango, Coco
Railroad	
Water Telephone Underground Cable	W.T.C.
Water Meter	W.M.

TERRITORY OF HAWAII
TERRITORIAL HIGHWAY DEPARTMENT
HONOLULU, OAHU, T. H.

PLANS OF
MISCELLANEOUS
IMPROVEMENTS

WAIALUA
DISTRICTS OF EWA
HONOLULU
ISLAND OF OAHU

SCALE
PLAN.....1"= 20'

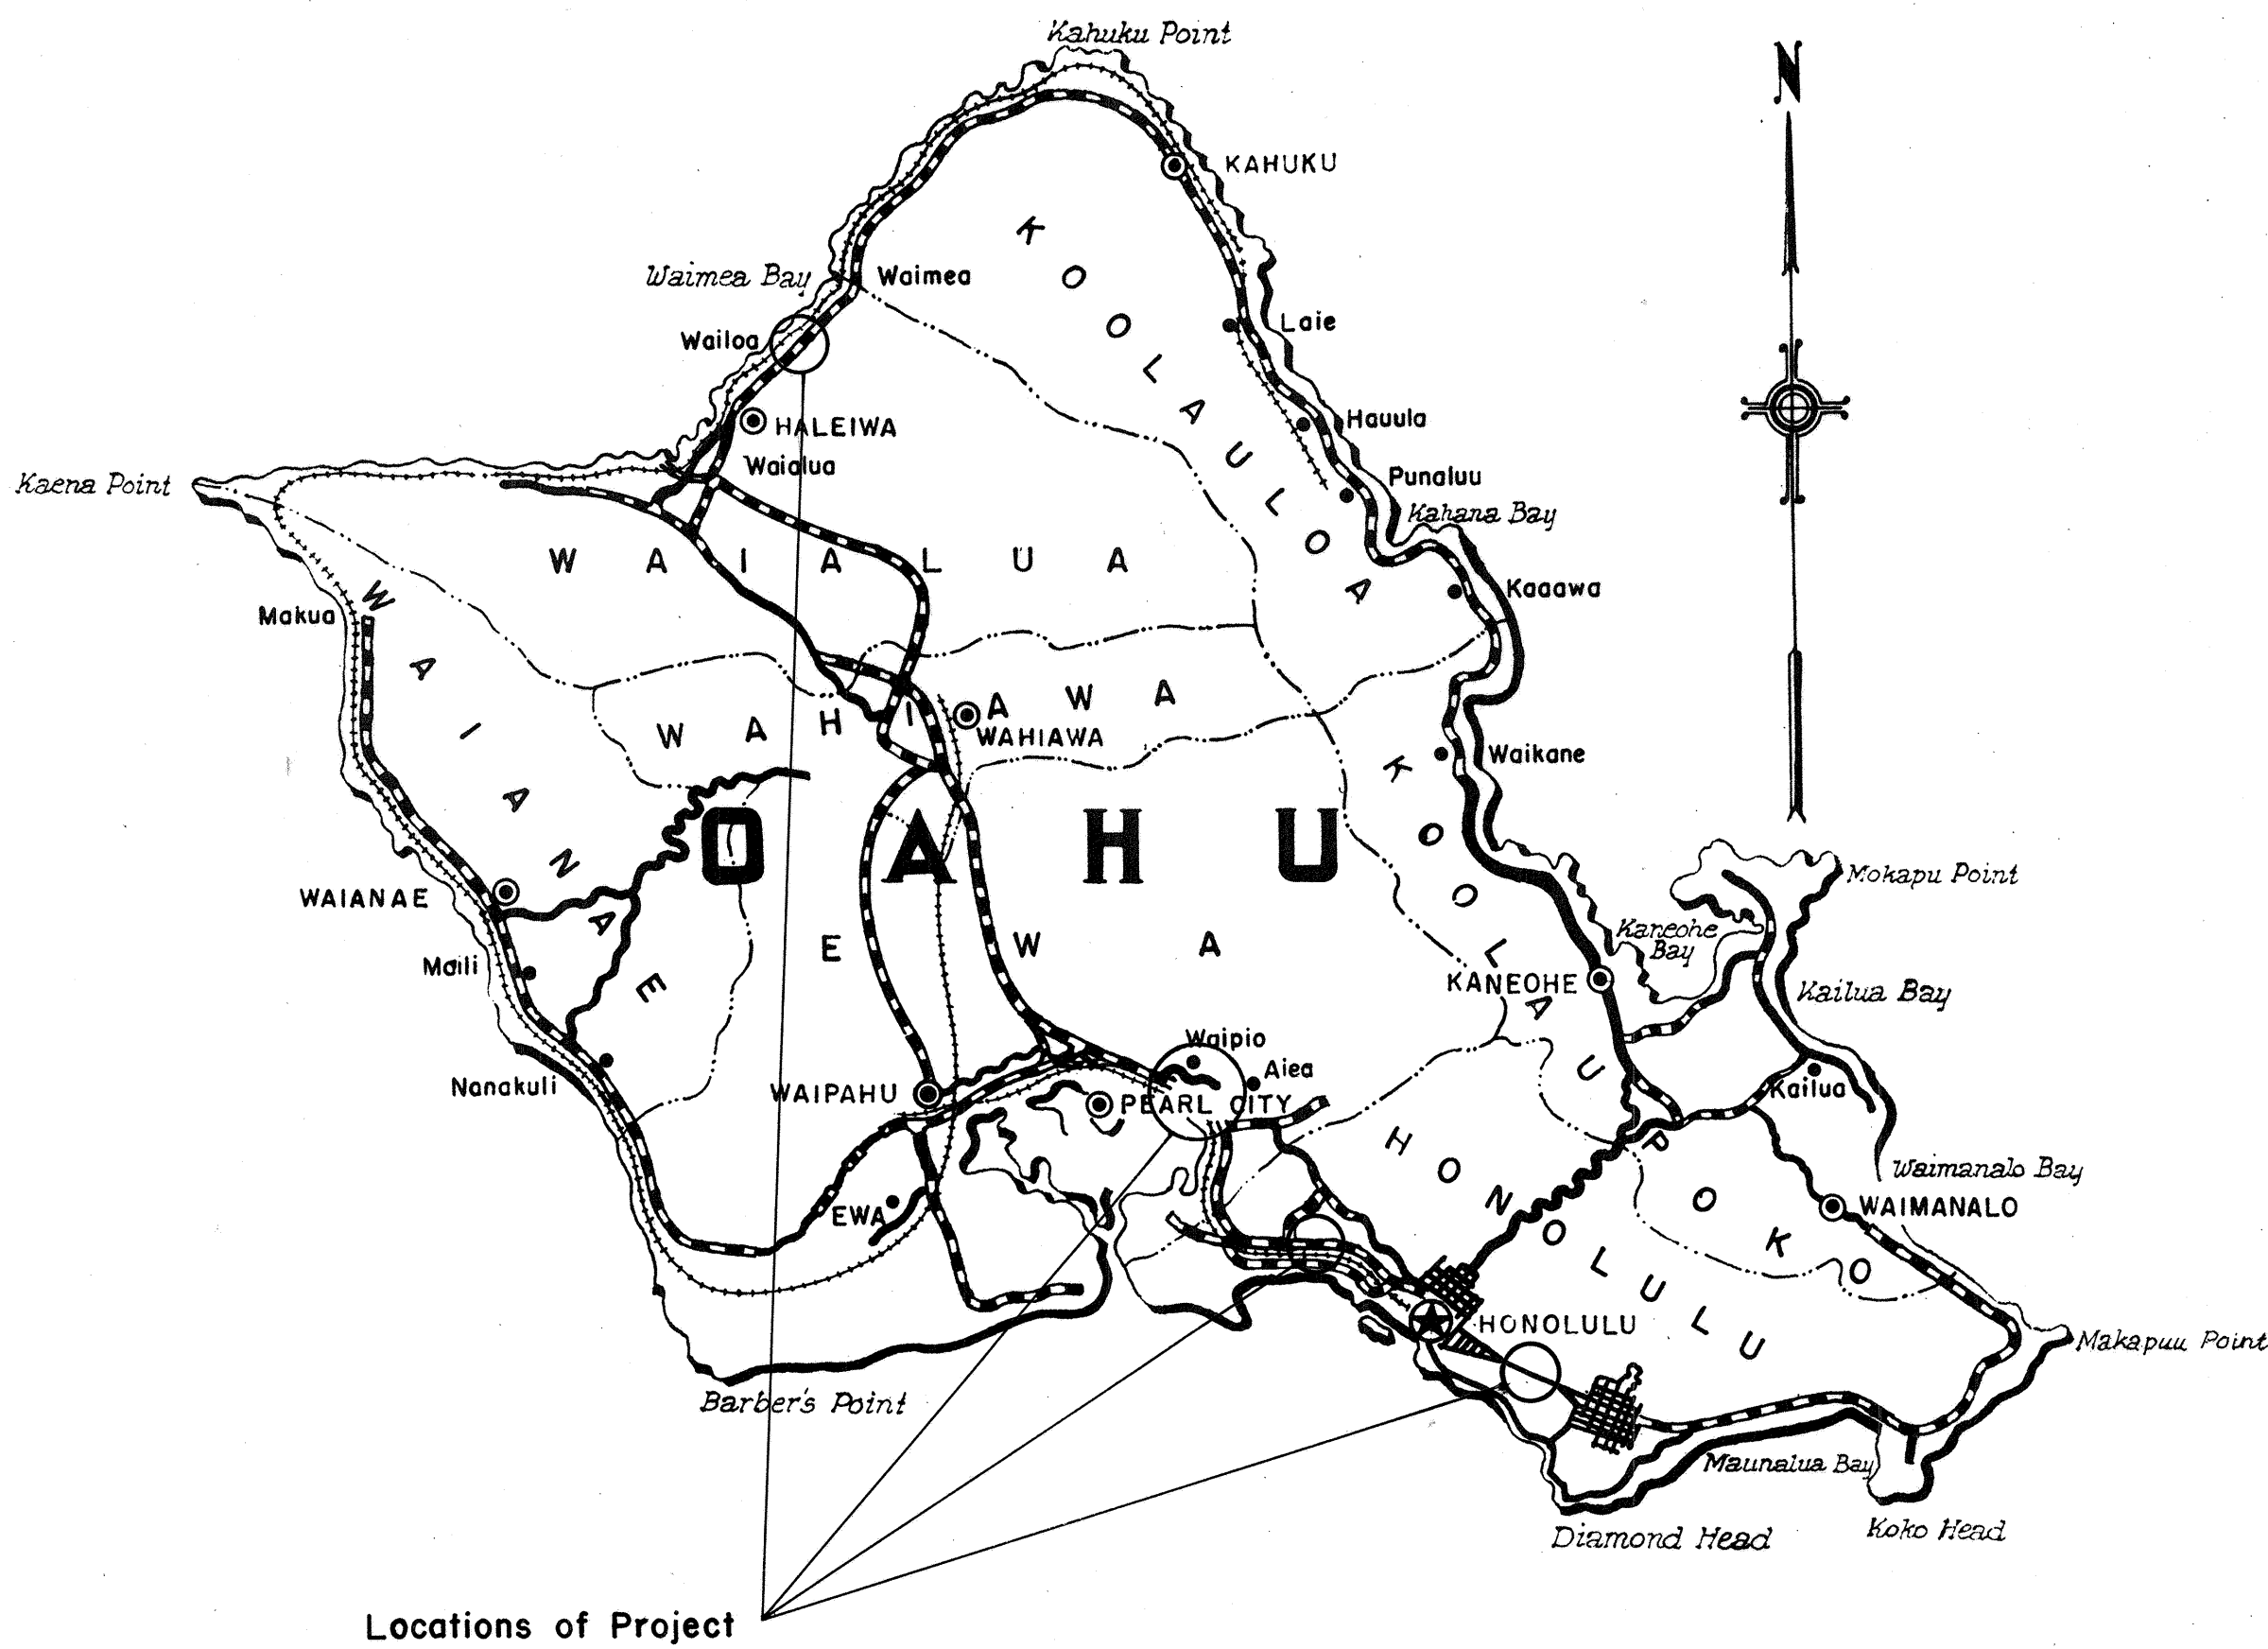

Federal Aid Projects Previously Constructed Or Under Construction

NOTE:


ALL CHANGES MADE DURING CONSTRUCTION HAVE
BEEN NOTED IN RED ON THESE TRACINGS
AND CHECKED BY:

William H. J. J.
PROJECT ENGINEER
June 28, 1957
DATE

APPROVED
Ray E. Muth
TERRITORIAL HIGHWAY ENGINEER

5867.01

FED. ROAD DIST. NO.	STATE	FED. AID PROJ. NO.	FISCAL YEAR	SHEET NO.	TOTAL SHEETS
			1956	2	12

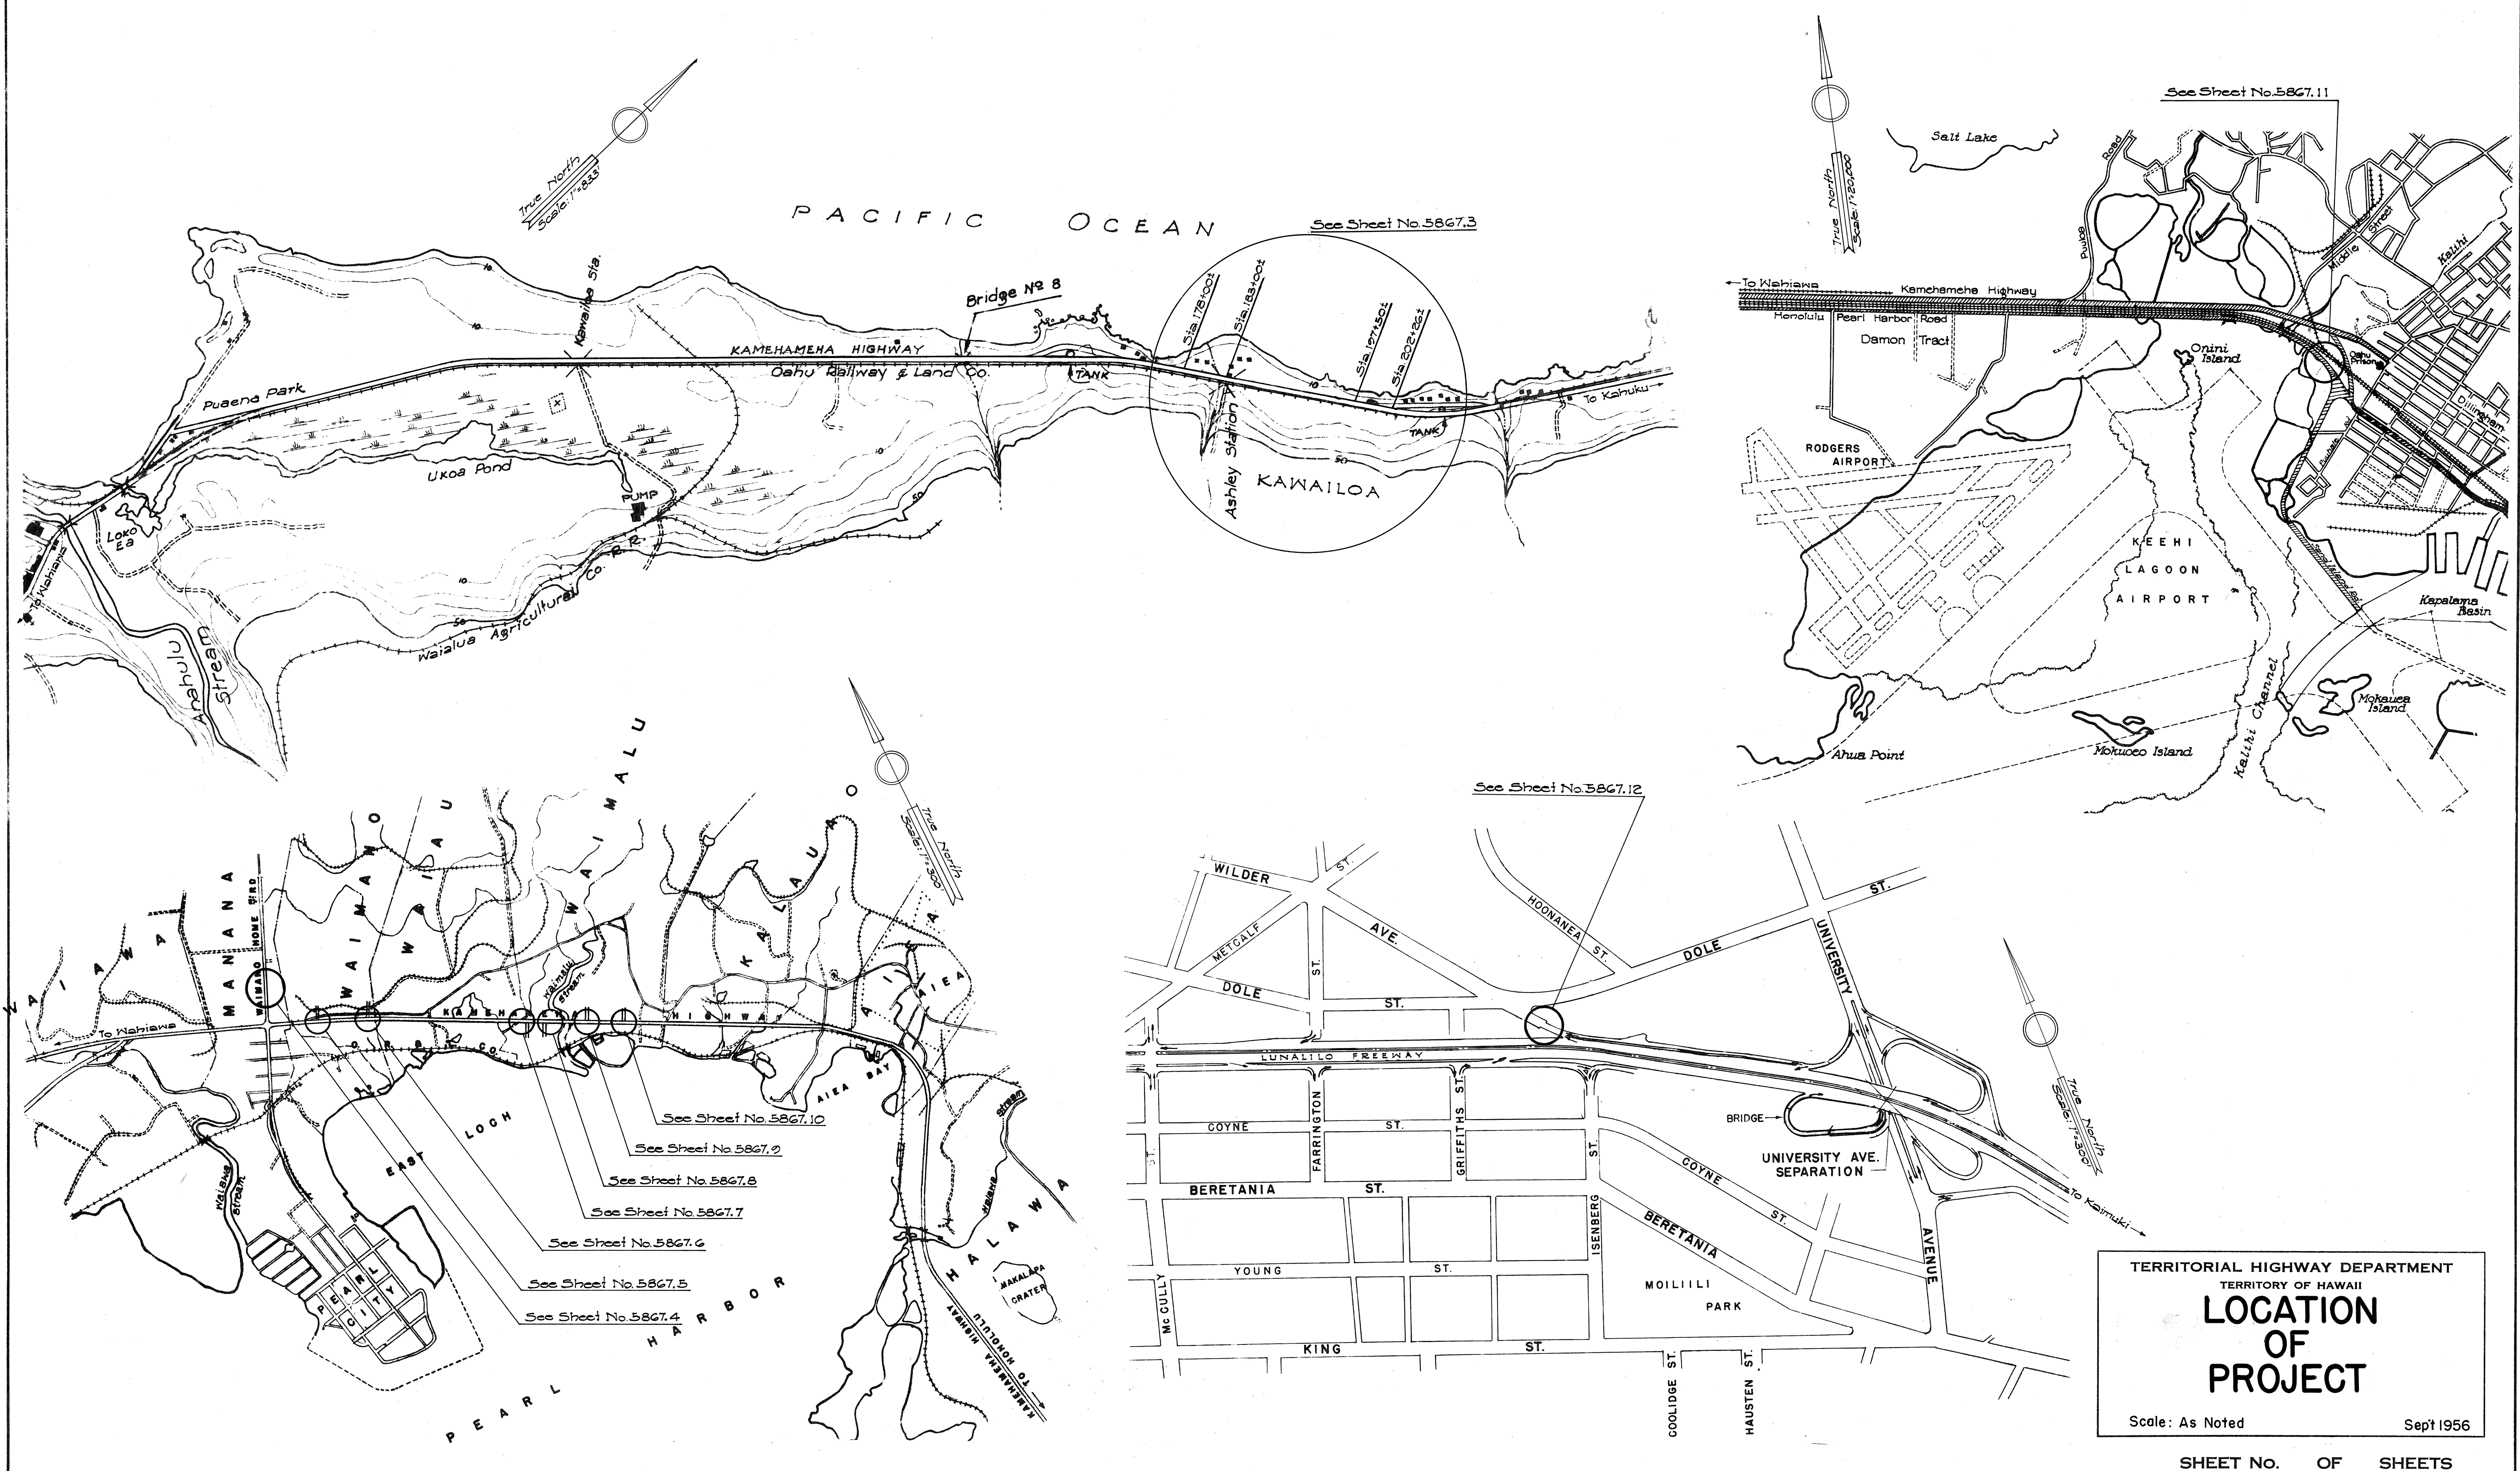

SURVEY PLOTTED BY	DATE
ORIGINAL PLAN	
NOTE BOOK	
CHECKED BY	