
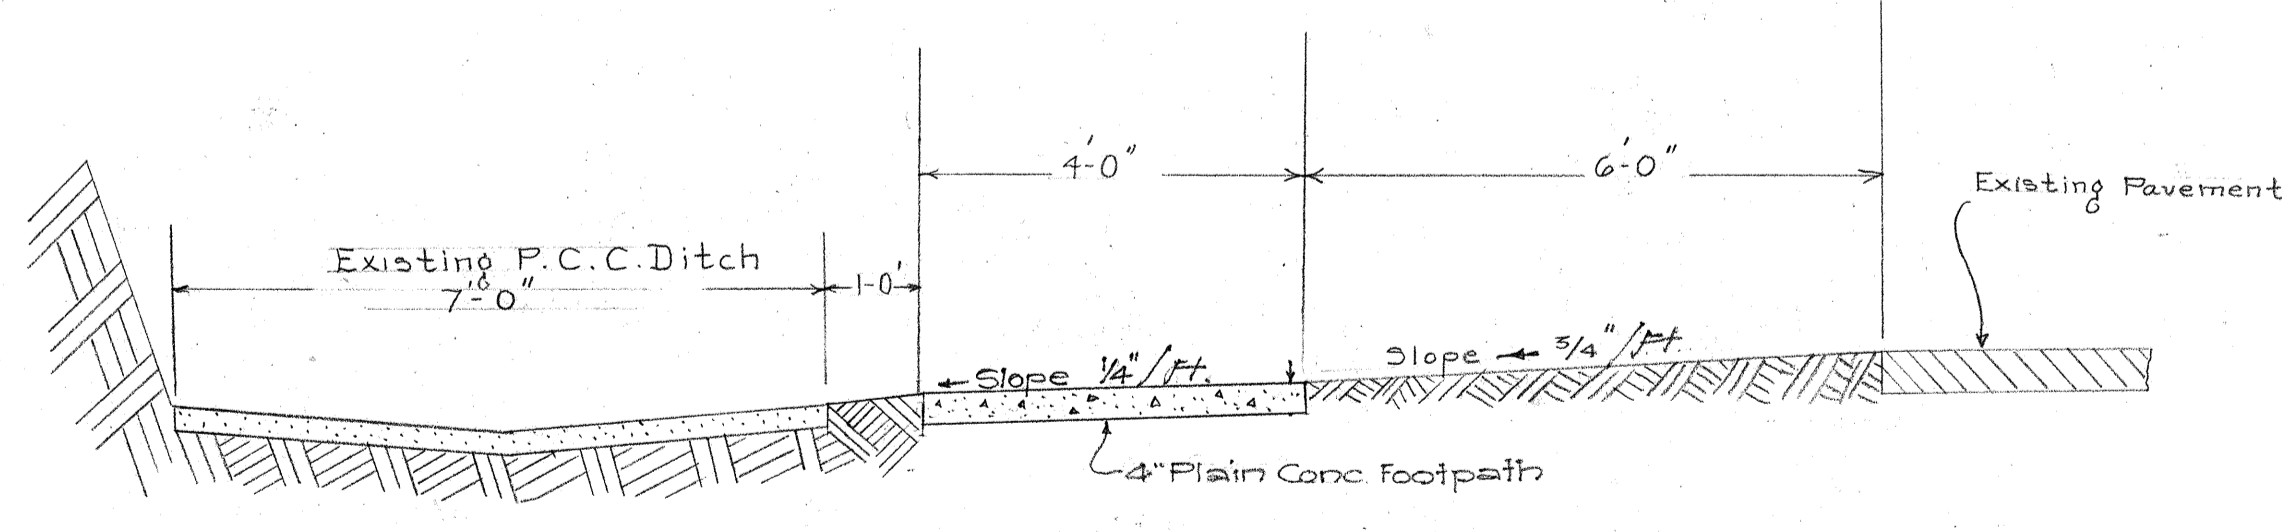
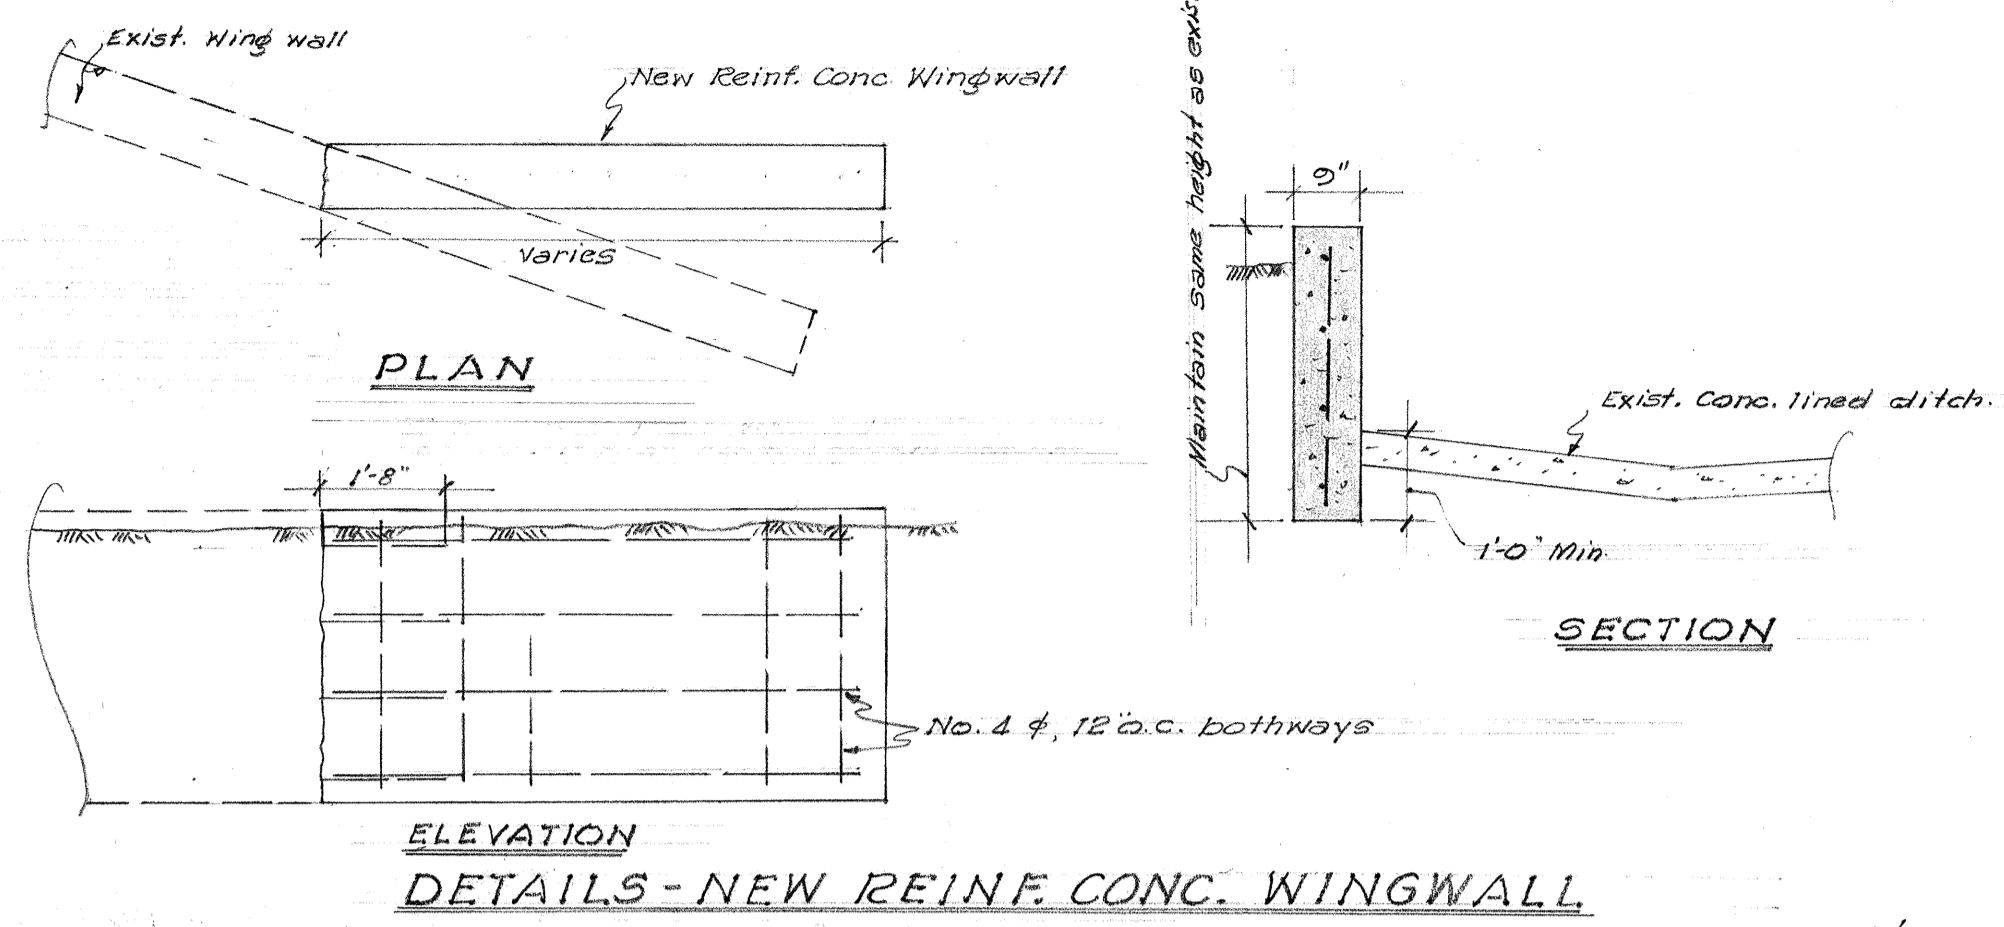


FED. ROAD DIST. NO.	STATE	FED. AID PROJ. NO.	FISCAL YEAR	SHEET NO.	TOTAL SHEETS
			1956	4	12

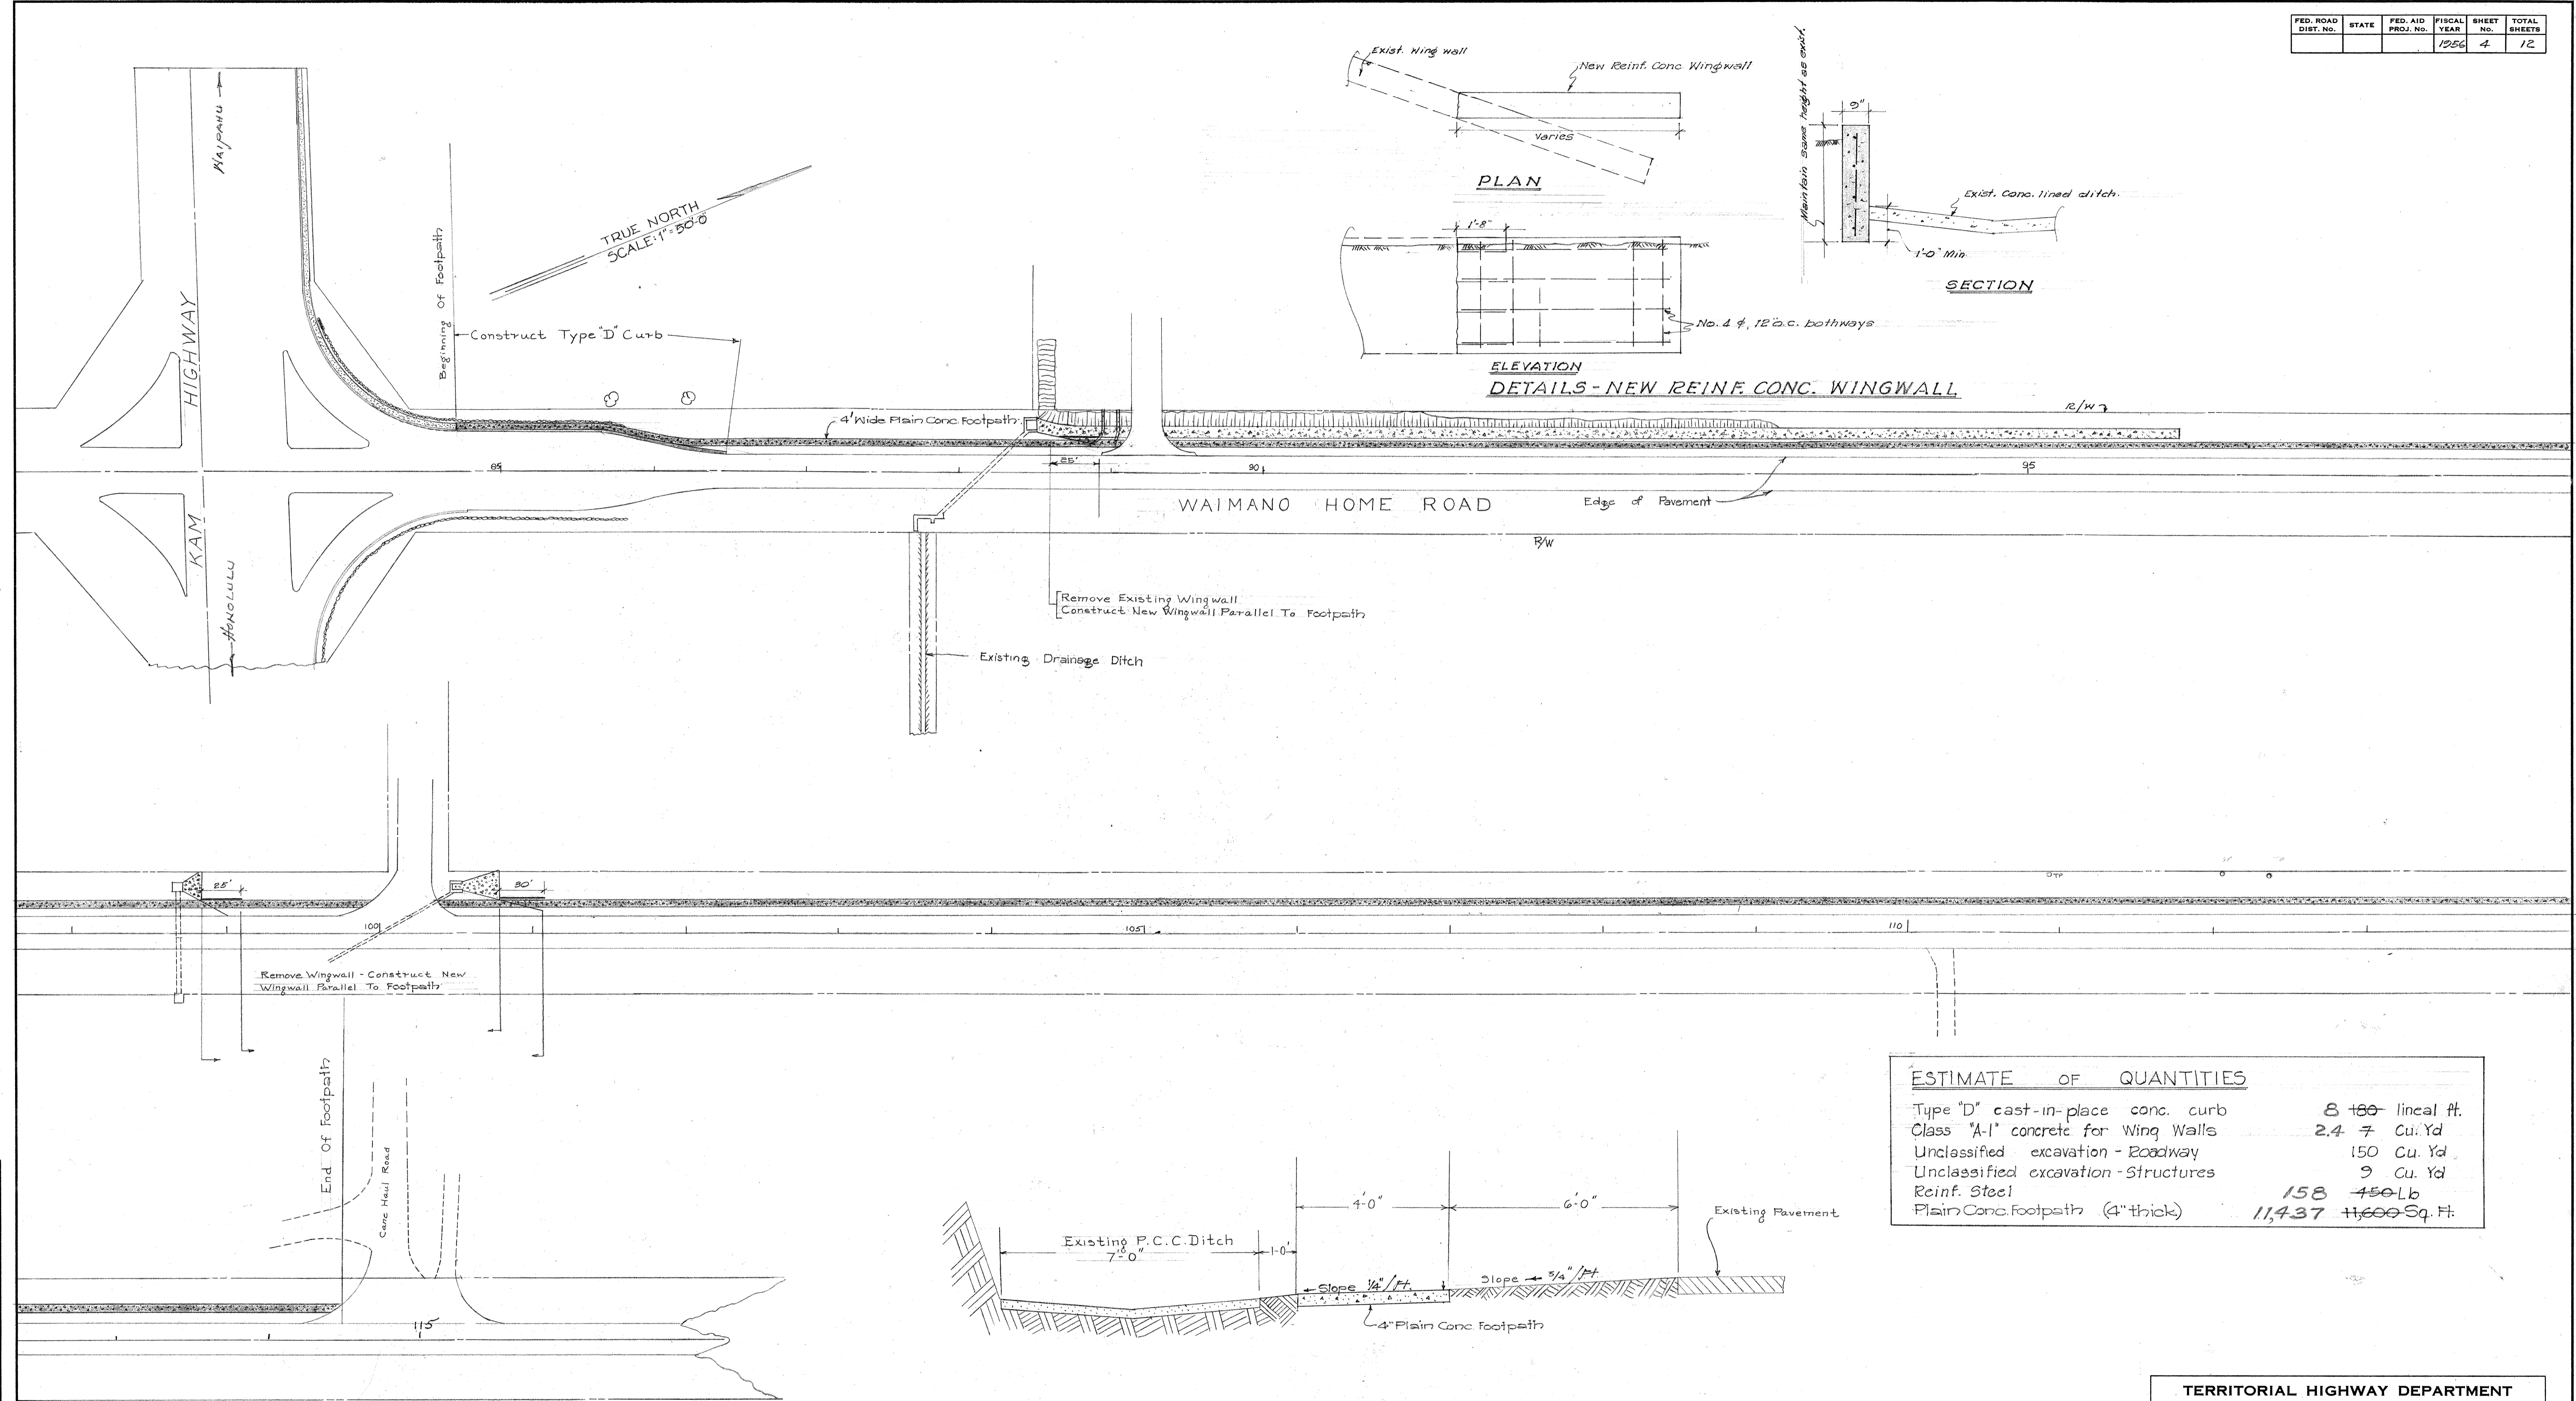

ESTIMATE OF QUANTITIES	
Type "D" cast-in-place conc. curb	8 +80- lineal ft.
Class "A-1" concrete for Wing Walls	2.4 7 Cu. Yd
Unclassified excavation - Roadway	150 Cu. Yd
Unclassified excavation - Structures	9 Cu. Yd
Reinf. Steel	158 450Lb
Plain Conc. Footpath (4" thick)	11,437 11,600 Sq. Ft.

TYPICAL SECTION
Scale 1/2" = 1'-00"

DESIGNED BY: DATE: 4-22-56
 DRAWN BY: J. K. King
 TRACED BY:
 QUANTITIES CHECKED BY:
 CHECKED BY:

TERRITORIAL HIGHWAY DEPARTMENT
 TERRITORY OF HAWAII
 CONSTRUCTION OF FOOT-STEP ON THE EWA SIDE OF WAIMANO HOME ROAD FROM KAM HIGHWAY TO CANE HAUL ROAD.
 Scale: as noted April 26, 1956

SHEET No. OF SHEETS

5867.4