
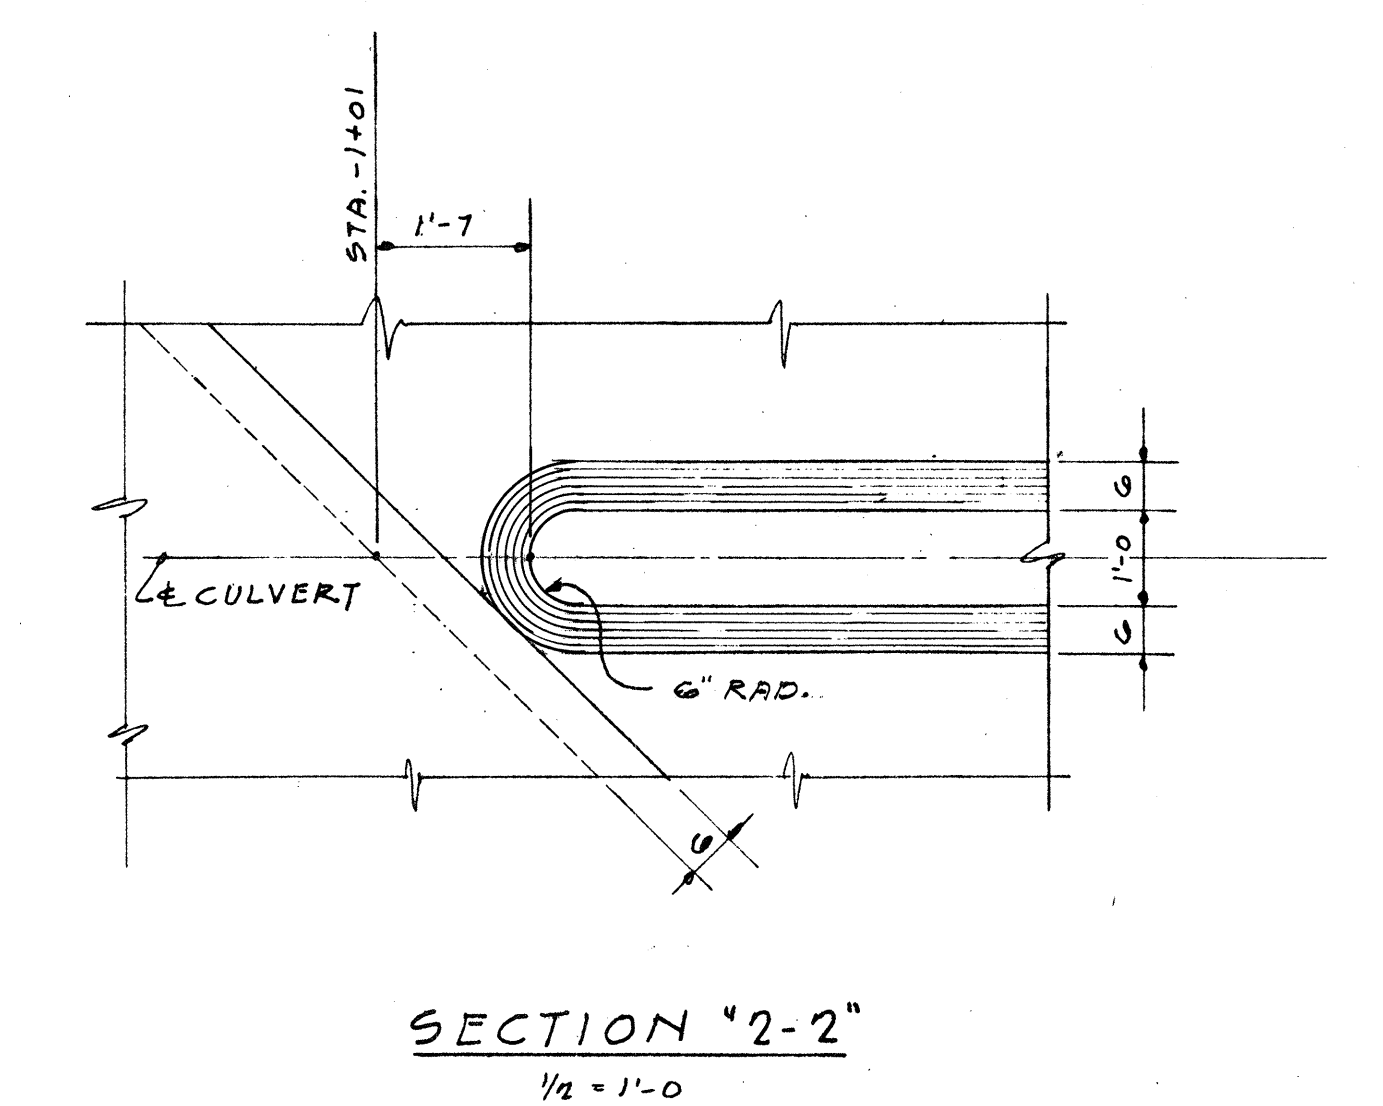
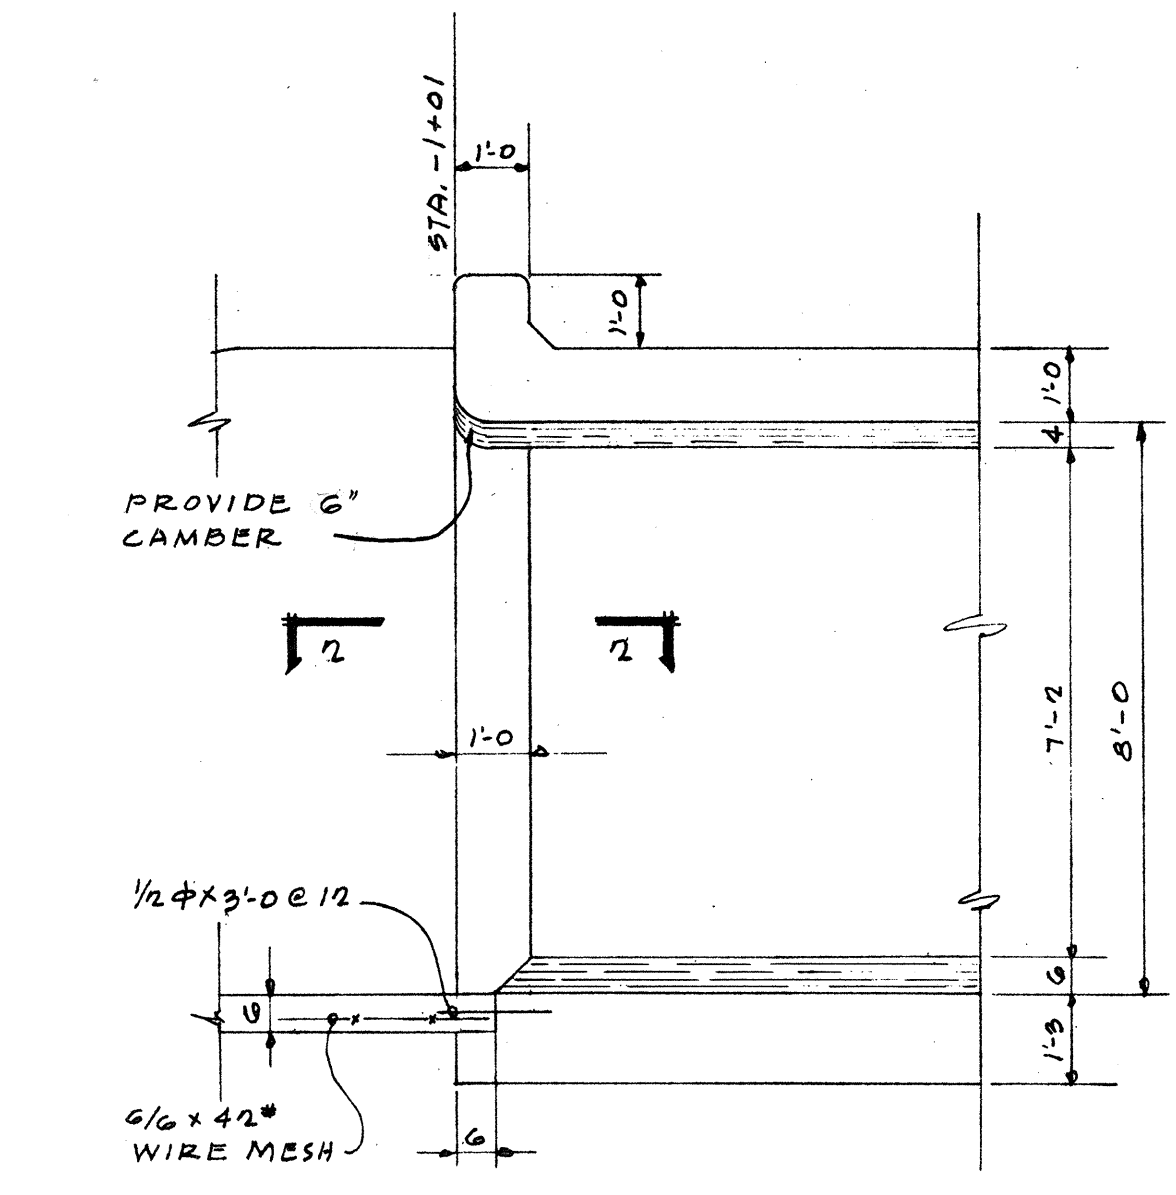
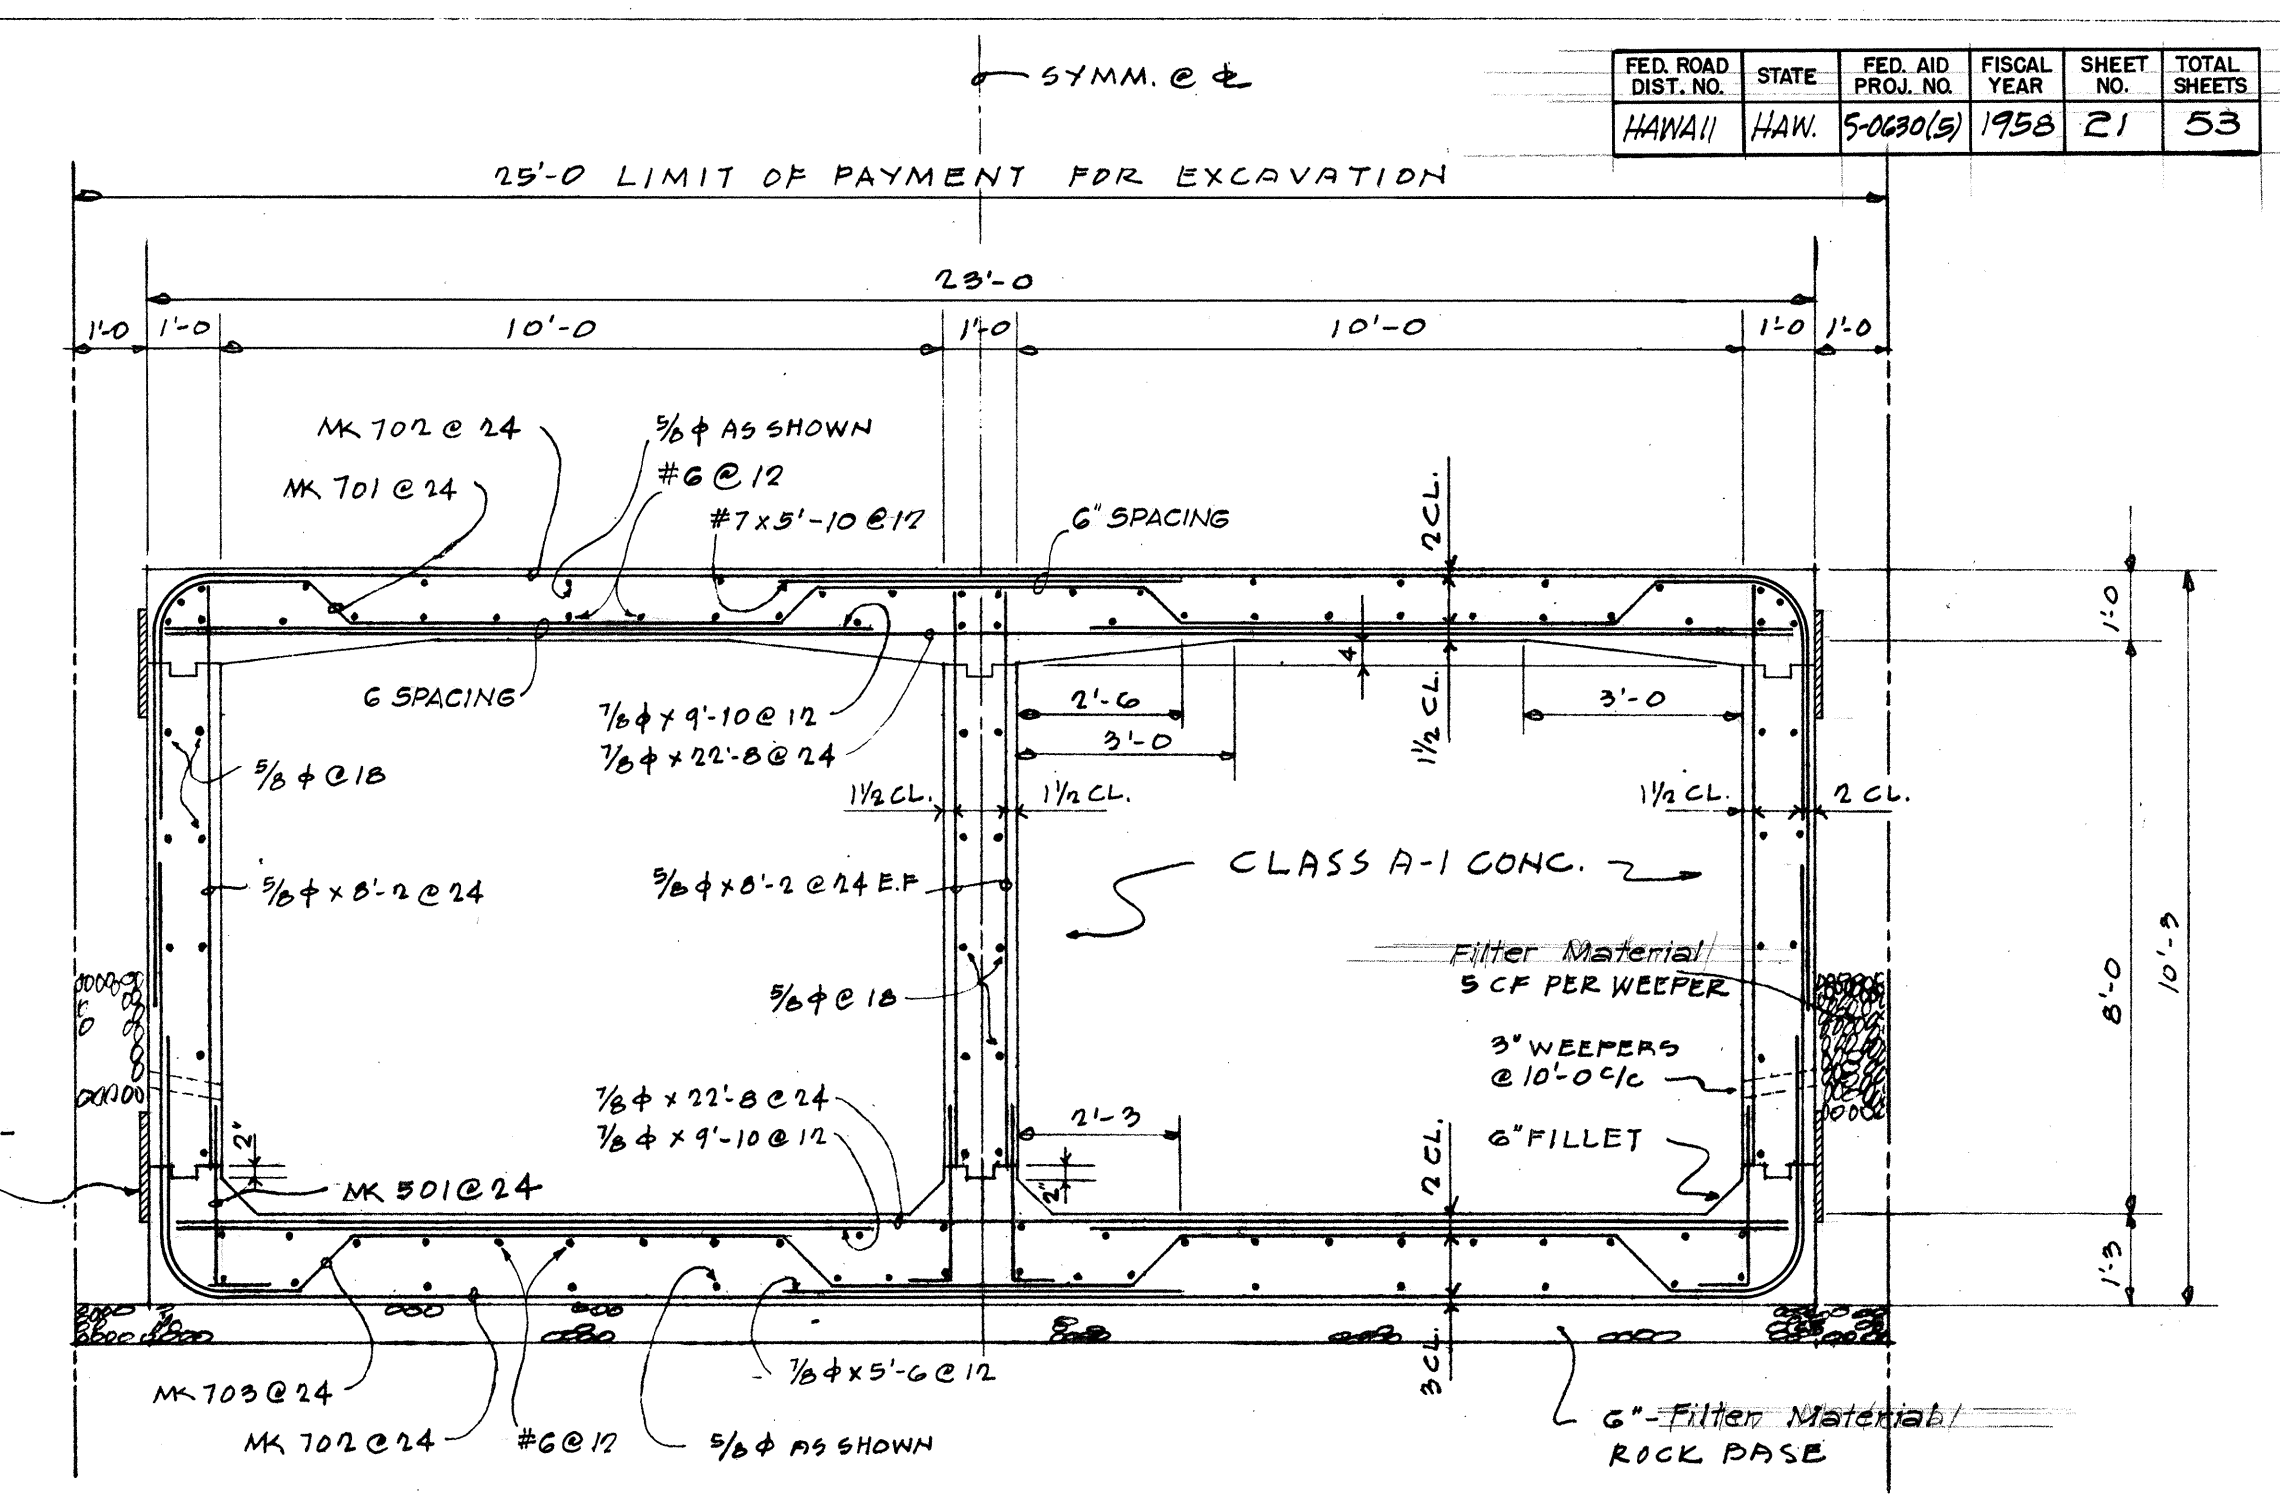


FED. ROAD DIST. NO.	STATE	FED. AID PROJ. NO.	FISCAL YEAR	SHEET NO.	TOTAL SHEETS
HAWAII	HAW.	5-0630(5)	1958	21	53

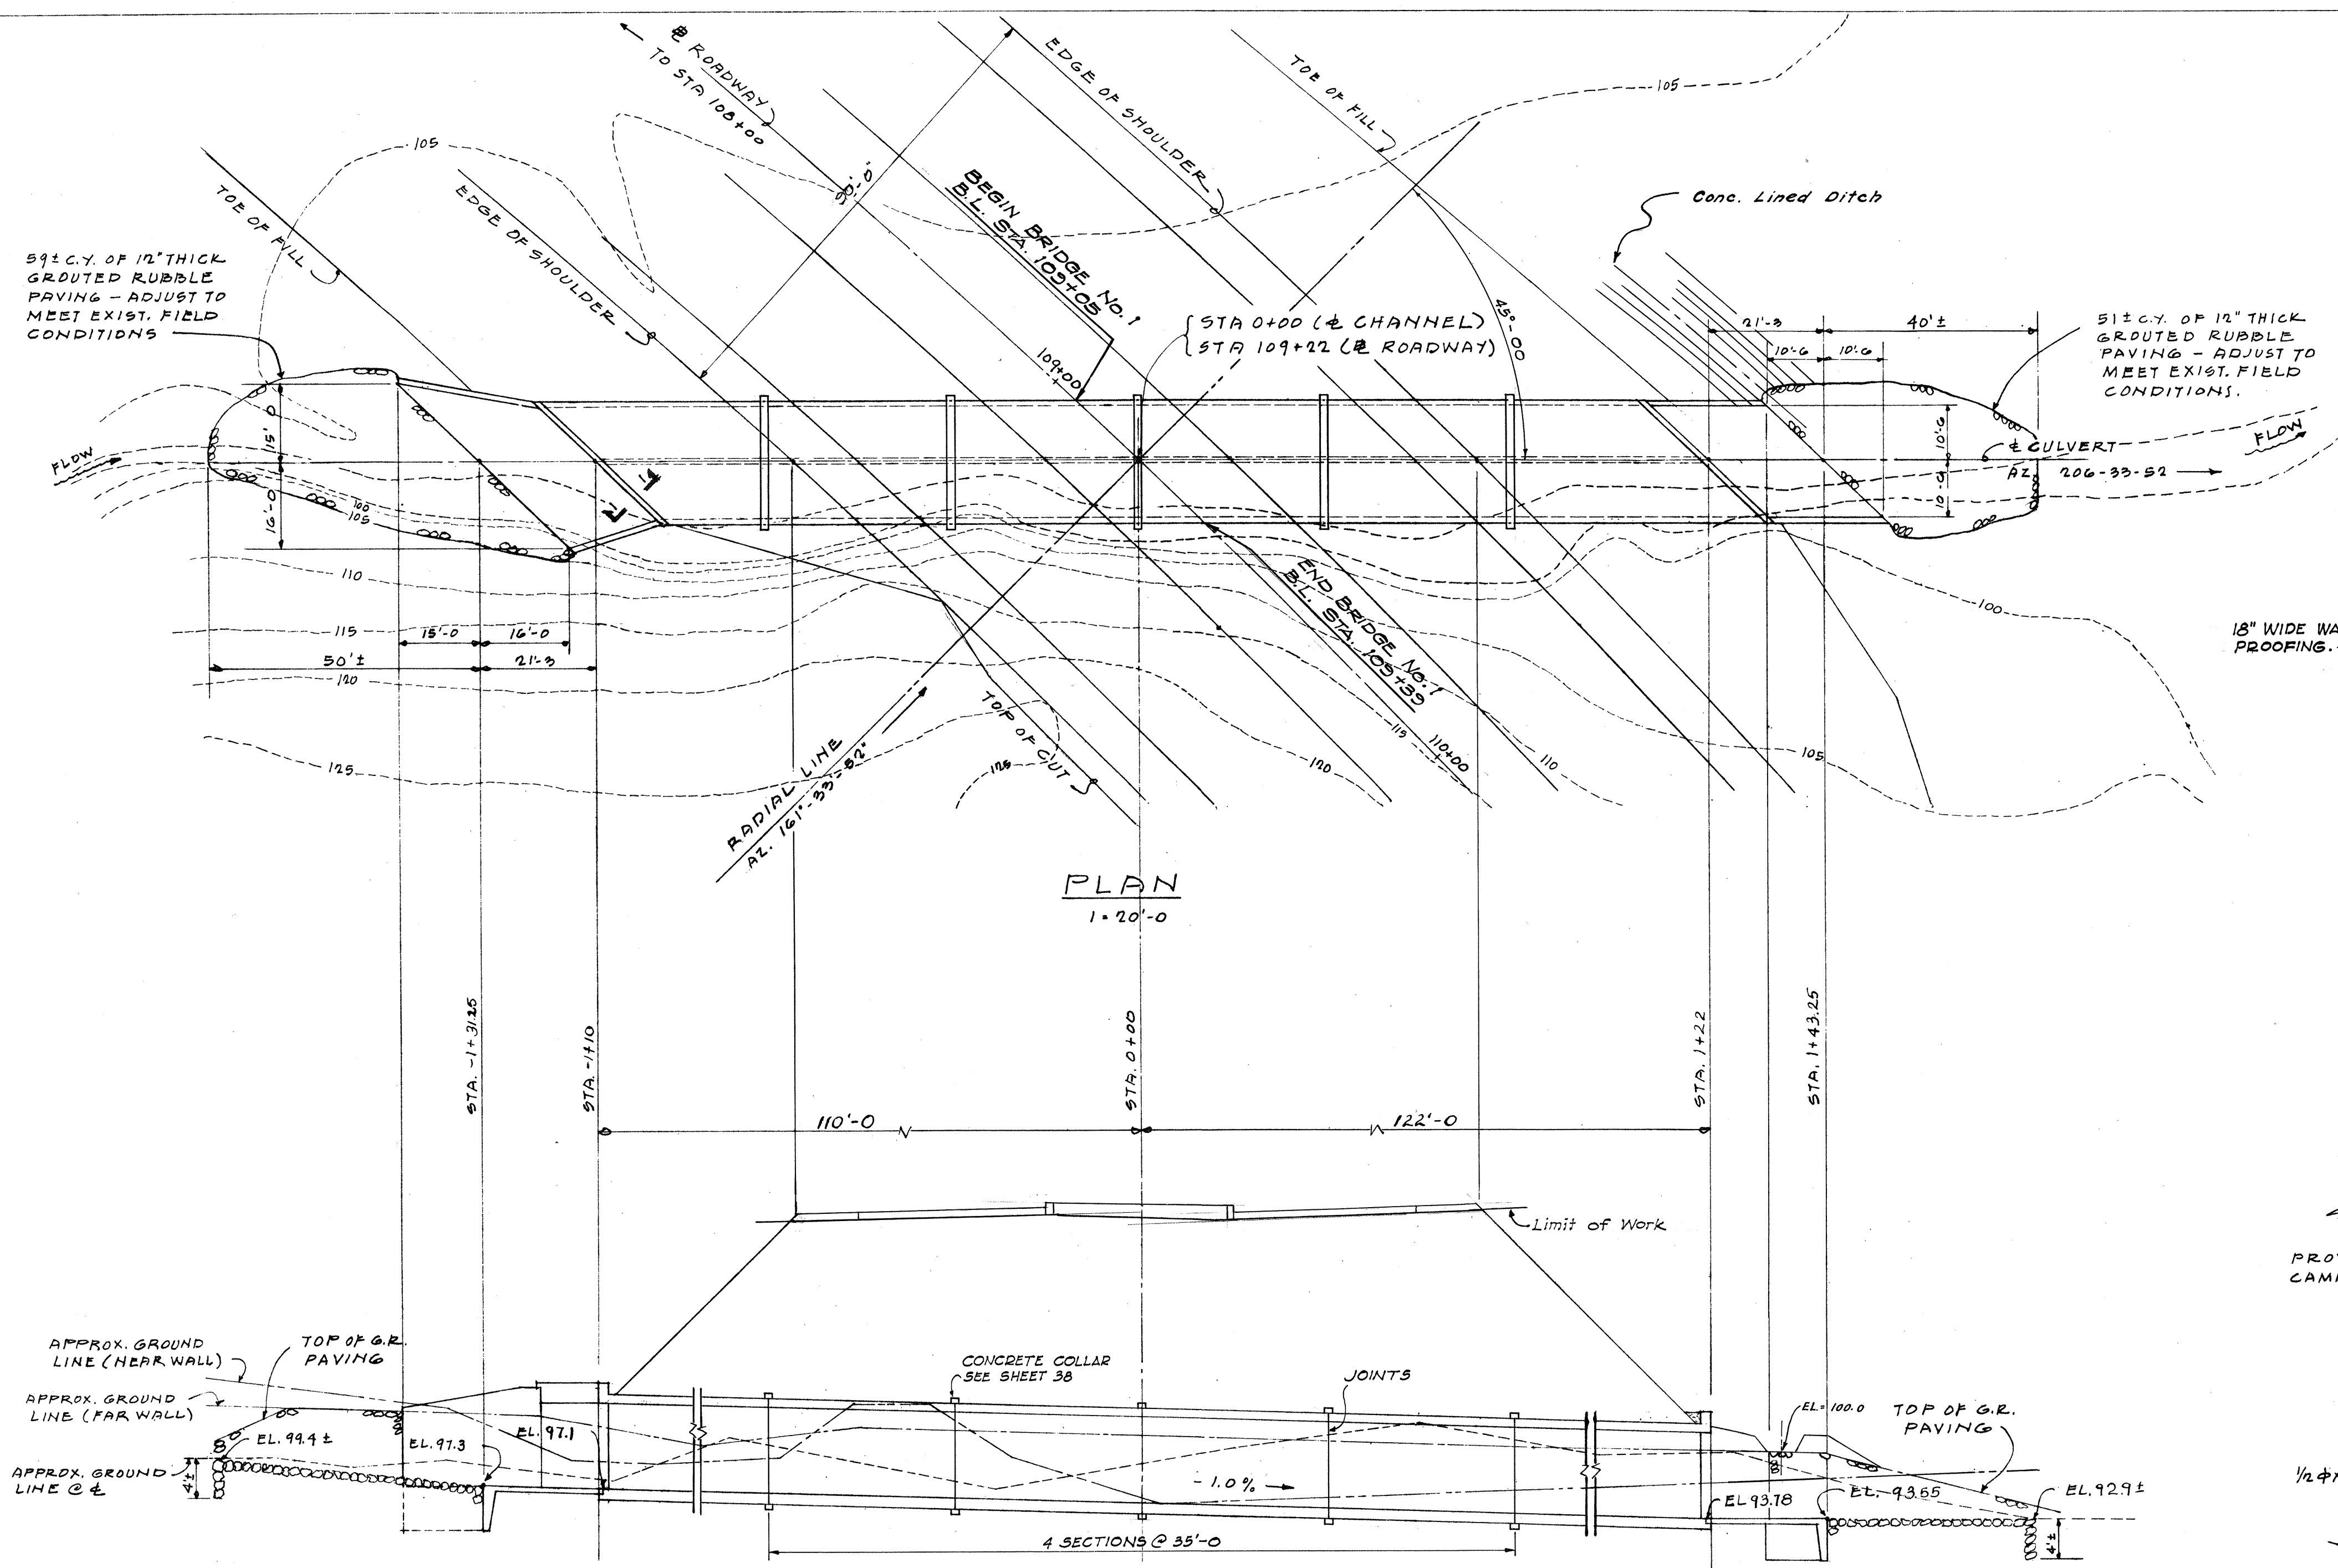

TERRITORIAL HIGHWAY DEPARTMENT
TERRITORY OF HAWAII

BRIDGE No. 1
STA. 109+05 TO STA. 109+22

LIKELIKE HIGHWAY
FED. AID SECONDARY PROJ. NO. 5-0630 (5)

SCALE: AS NOTED MAY 1957

