


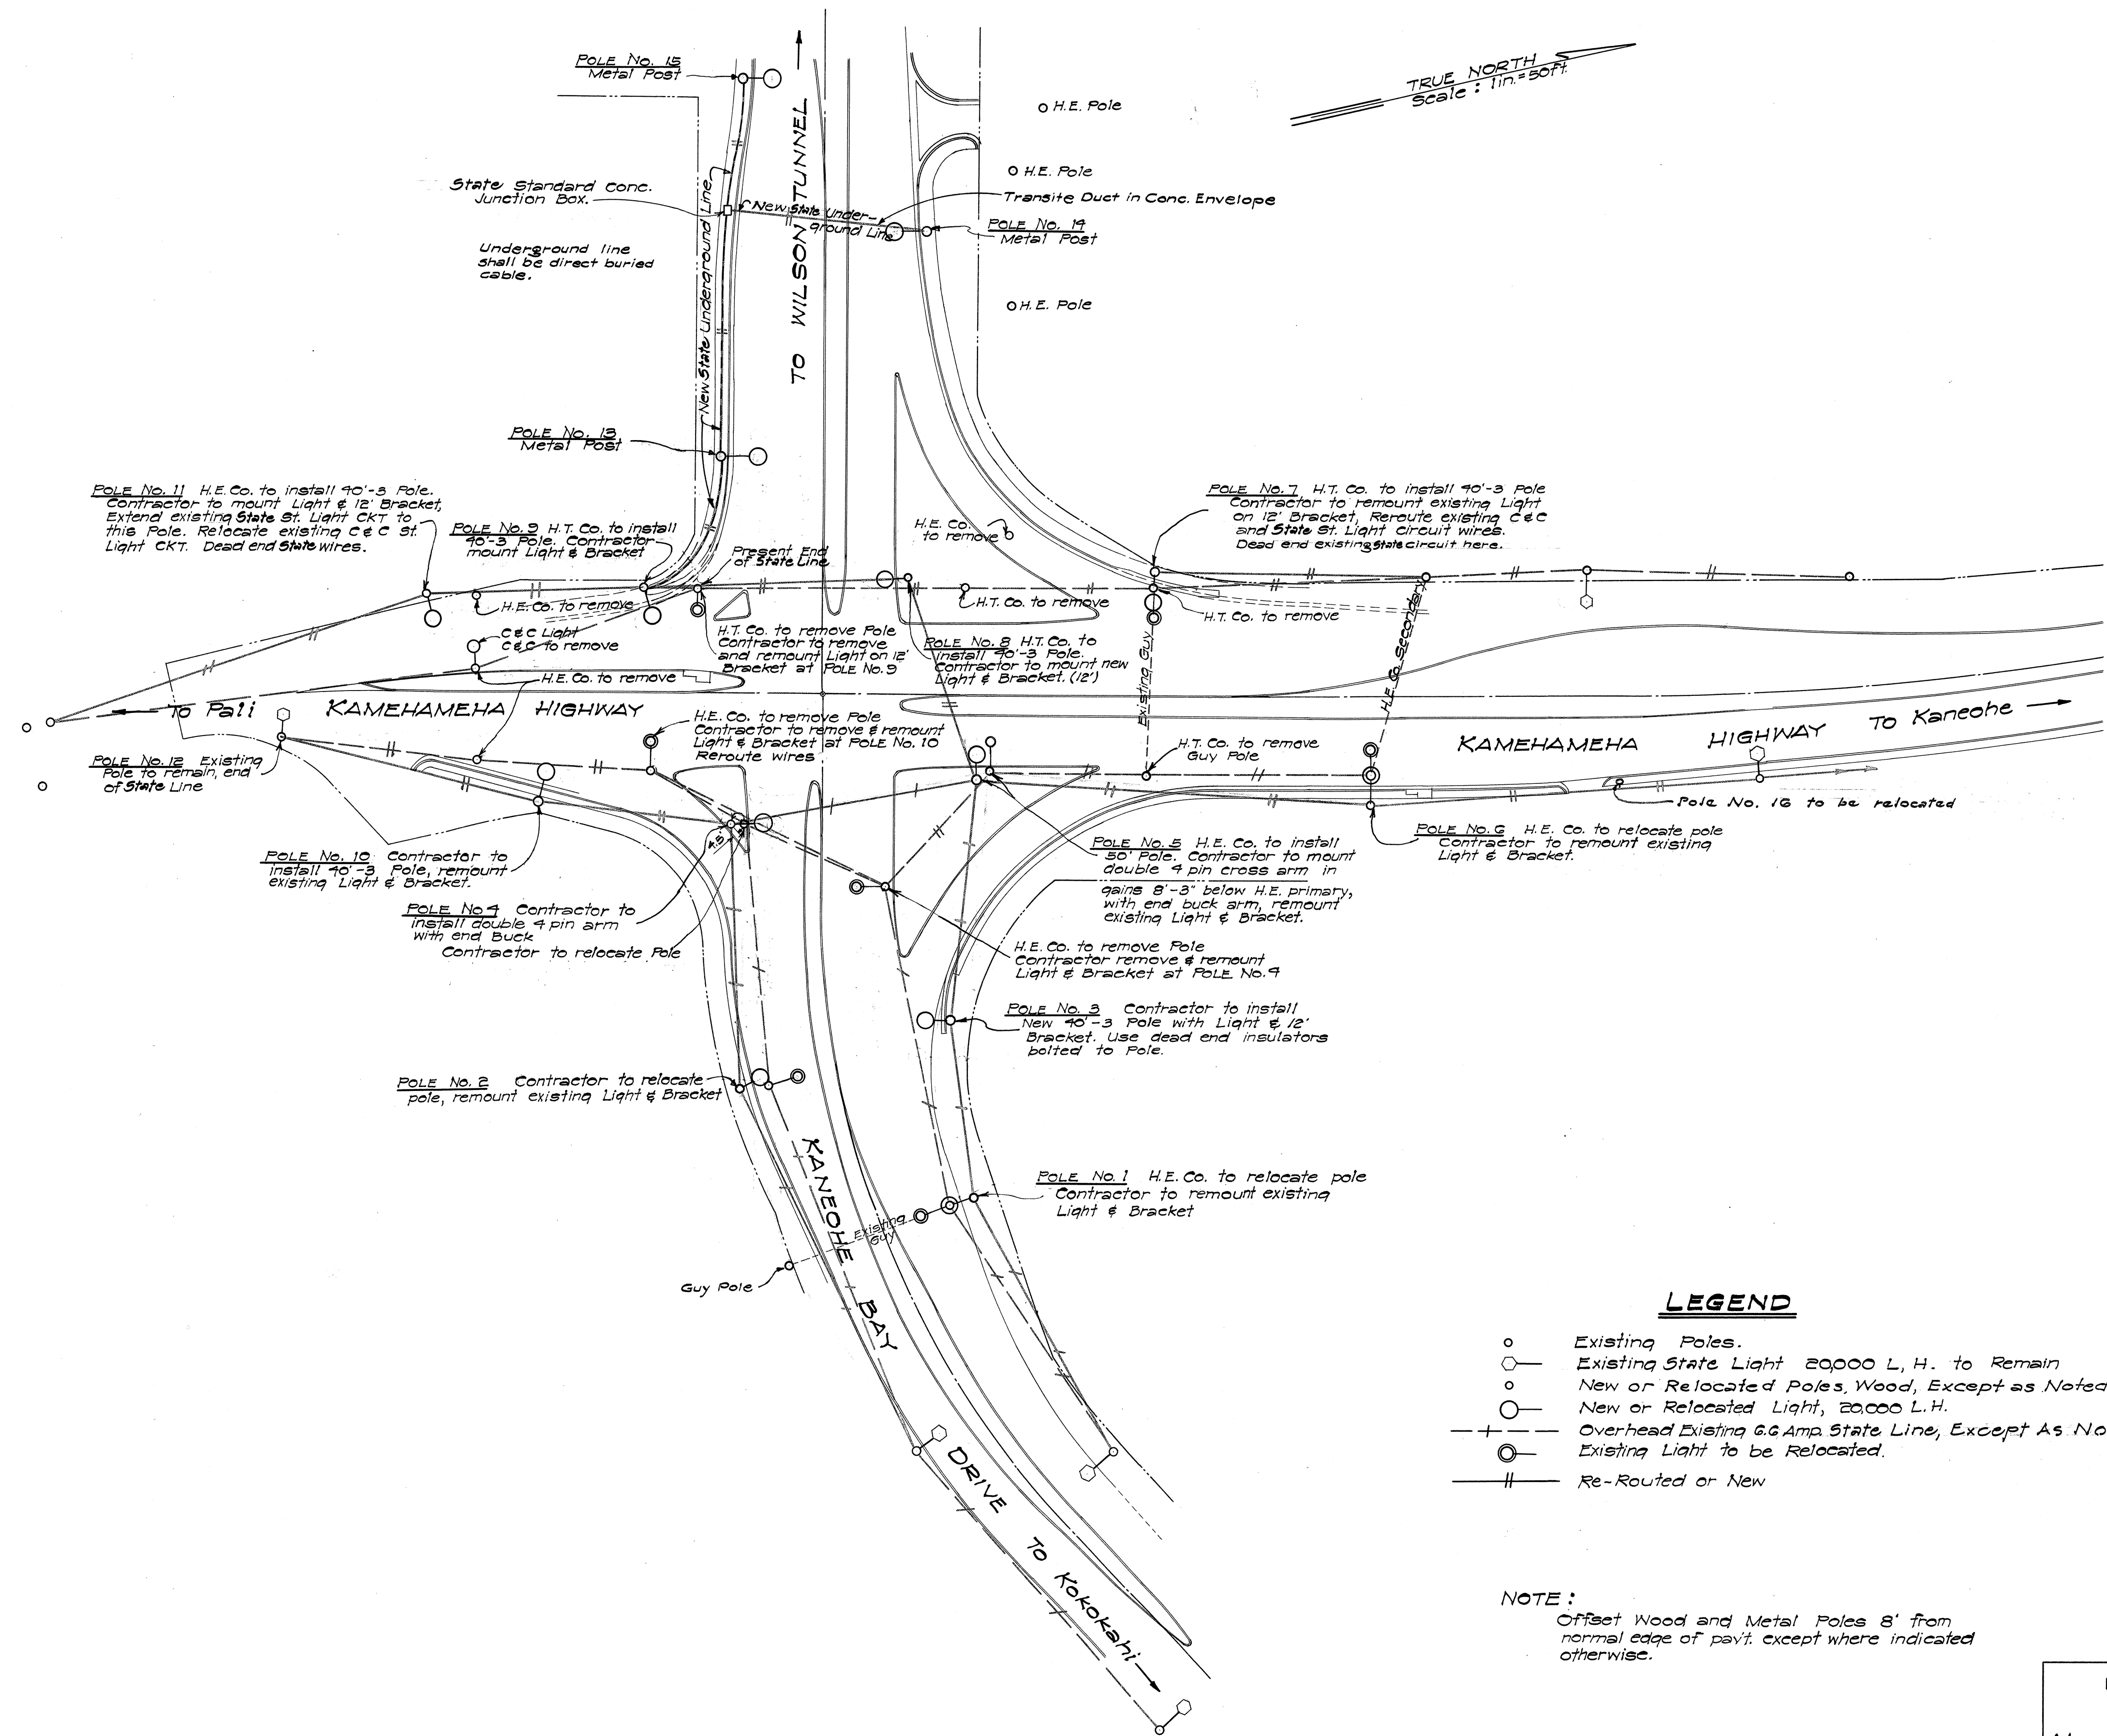

HAWAII STATE HIGHWAY DEPARTMENT
STATE OF HAWAII
HIGHWAY LIGHTING SYSTEM
KAM. HWY. AND KANEOHE BAY DRIVE
LIKELIKE HIGHWAY
FED. AID. SECONDARY PROJ. No. 5-0630(4)
SCALE: 1 in. = 50 ft.

ORIGINAL PLAN	DATE
SURVEY PLOTTED BY	
DESIGNED BY	
DRAWN BY	
TRACED BY	
CHECKED BY	
NO.	

