

STATE OF HAWAII

HAWAII STATE HIGHWAY DEPARTMENT
HONOLULU, OAHU HAWAII
AS-BUIL
PLANS OF

LIKELIKE HIGHWAY

(PAVING)


FEDERAL AID SECONDARY PROJECT NO. S-0630 (4)


DISTRICT OF KOOLAUPOKO

ISLAND OF OAHU

SCALE

PLAN		•	l	INCH	=	50 FEET
PROFILE		HOR.	1	INCH	=	50 FEET
		VÉR.	l	INCH	=	10 FEET
CROSS	SECTION	HOR.	1	INCH	=	5 FEET
		VER.	1	INCH	=	5 FEET

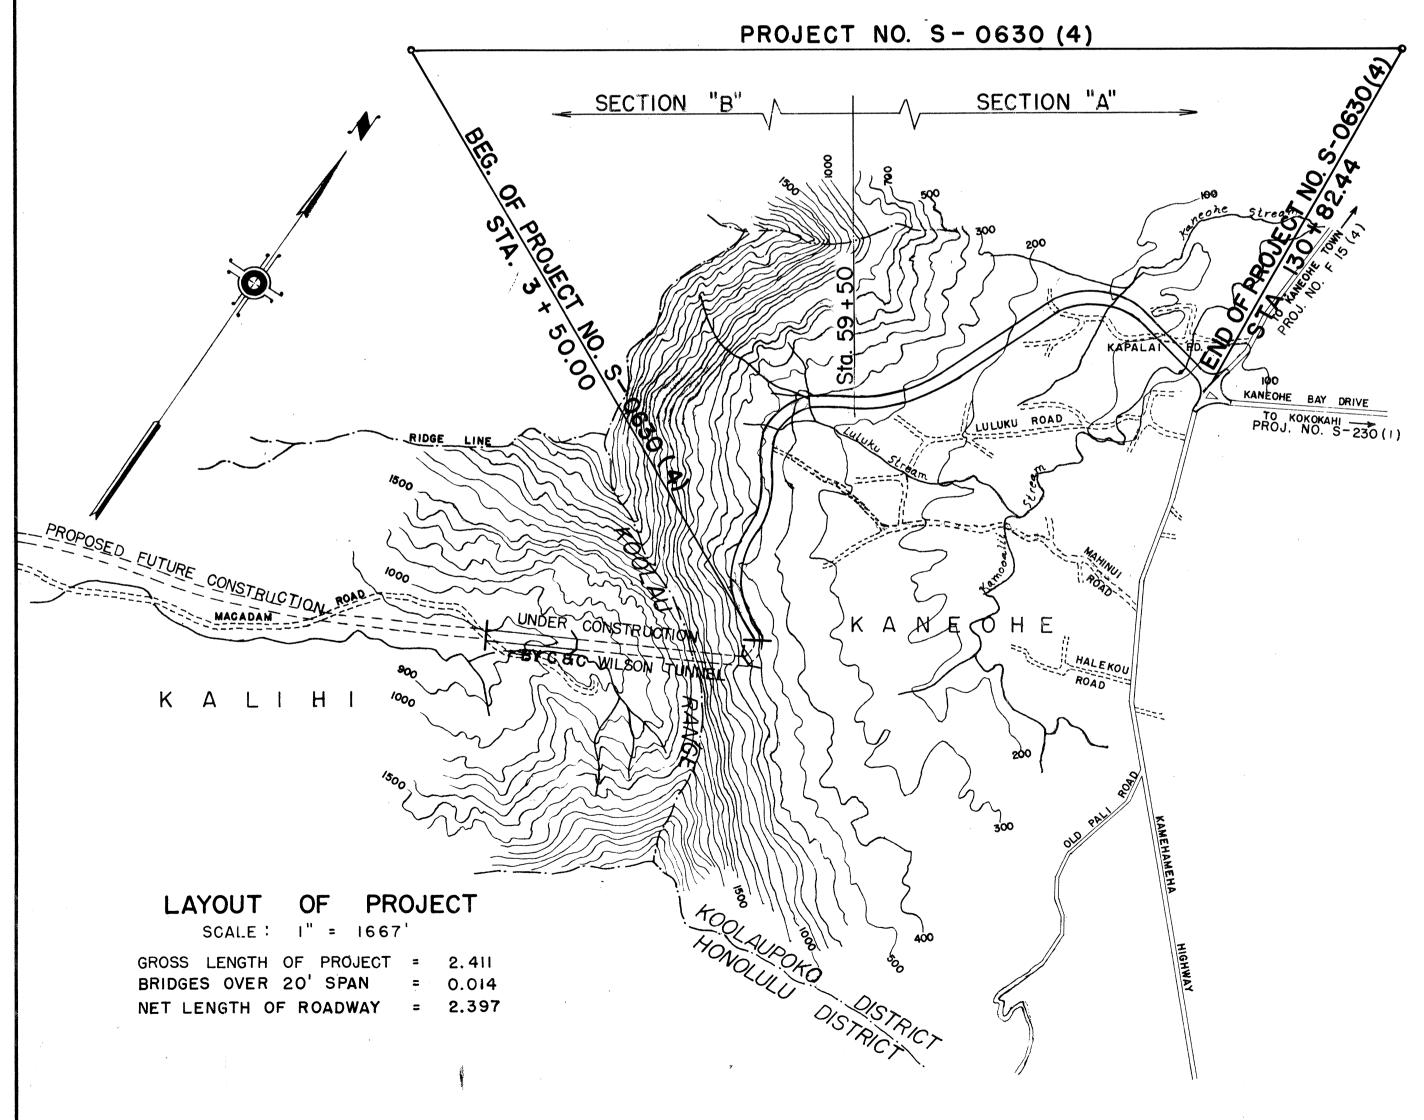

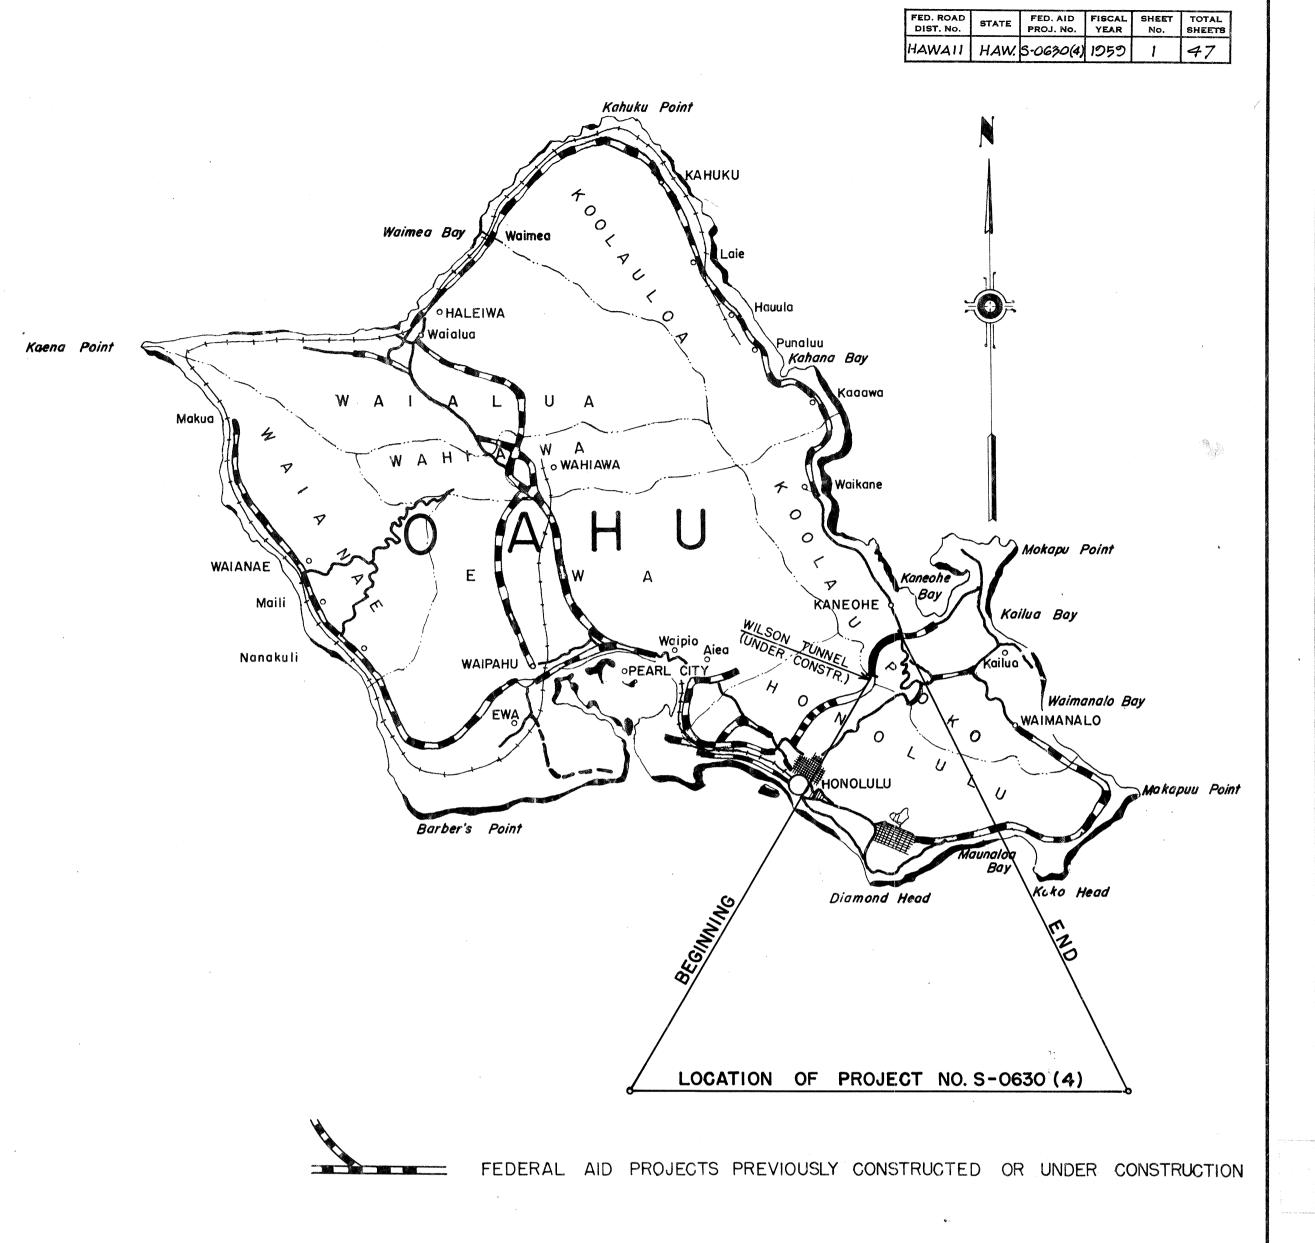

NOTE:

ALL CHANGES MADE DURING CONSTRUCTION HAVE BEEN NOTED IN RED ON THESE TRACINGS AND CHECKED BY

PROJECT ENGINEER

DATE

APPROVED DATE FEB. 17, 1959

VIEW ON STATE RIGHWAY ENGINEER

DEPARTMENT OF COMMERCE
BUREAU OF PUBLIC ROADS

APPROVED

DIVISION ENGINEER DATE

8132 (1).

PRINTED ON DIEPO 1000H CLEARPRINT