




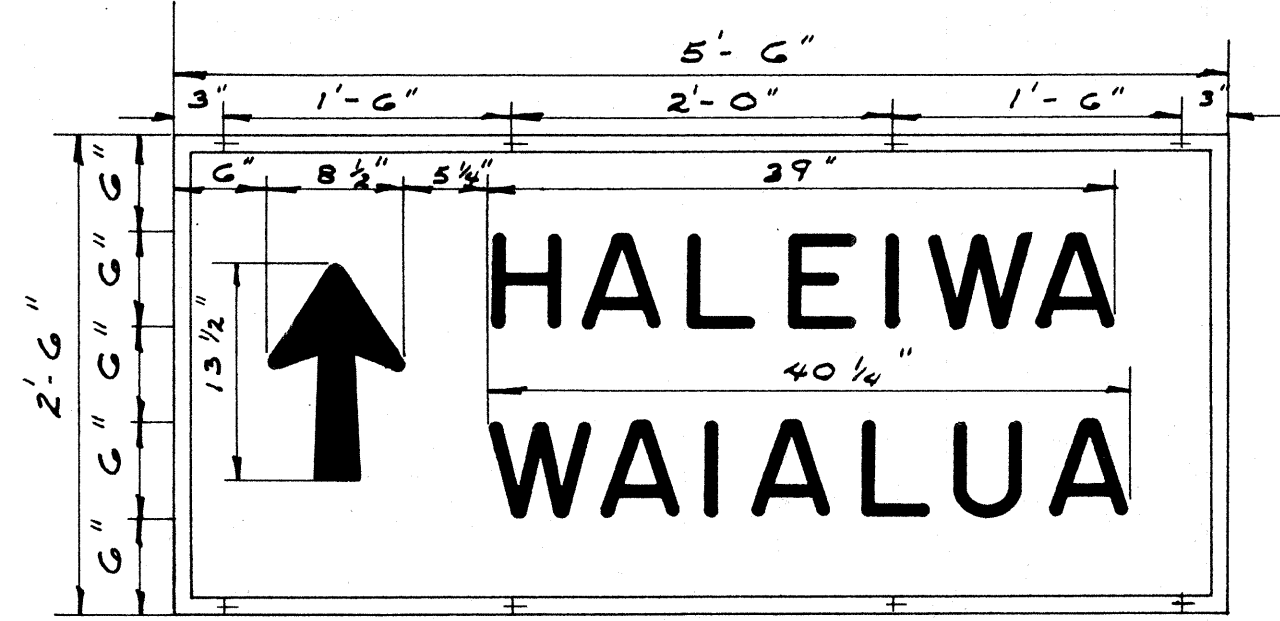


D-1

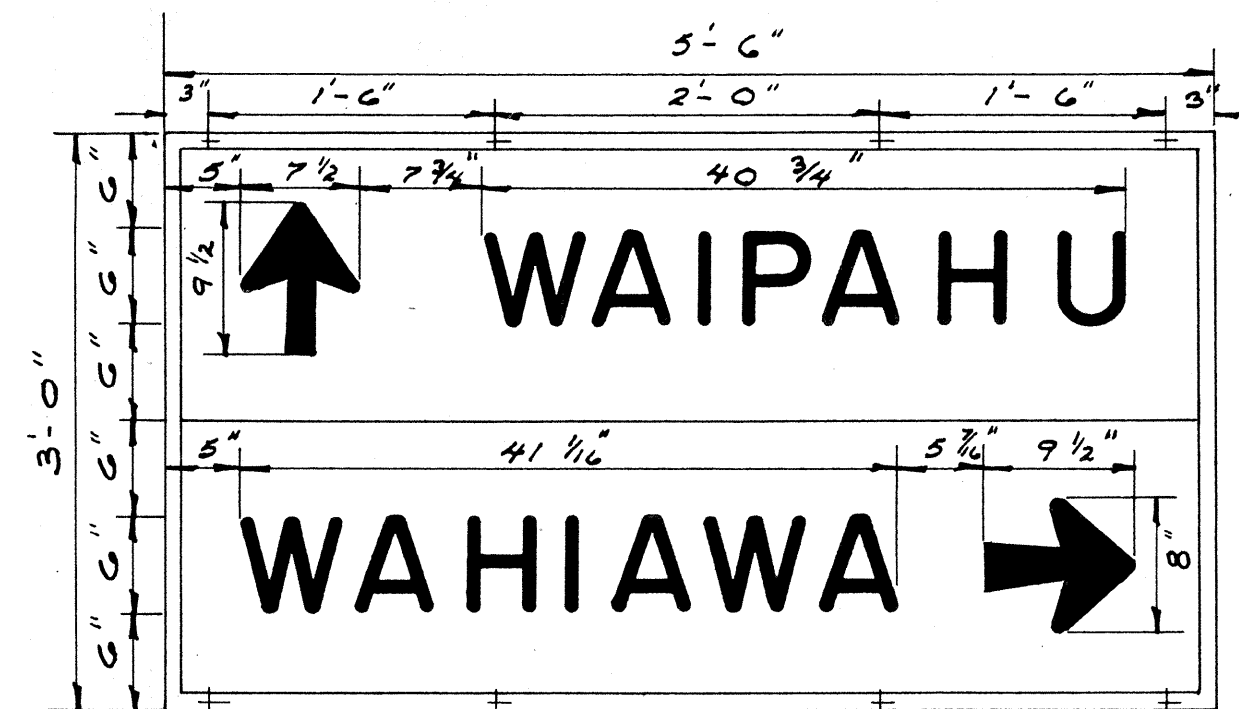


D-2

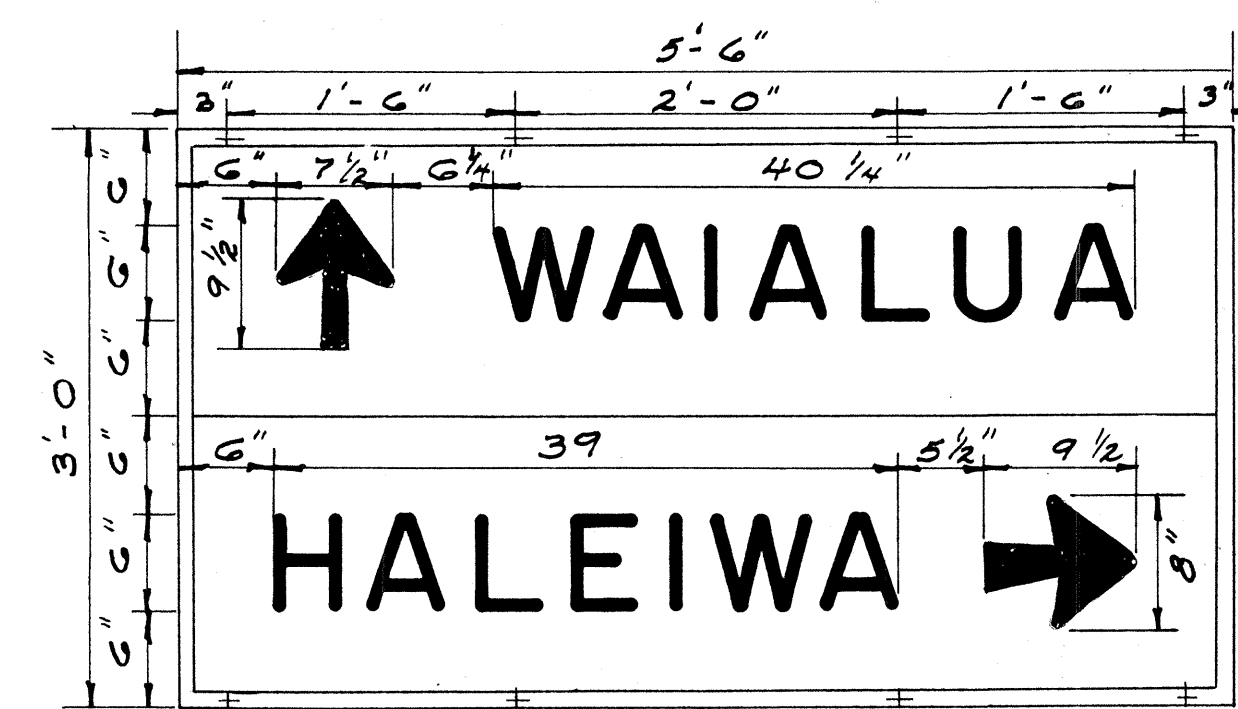


D-3

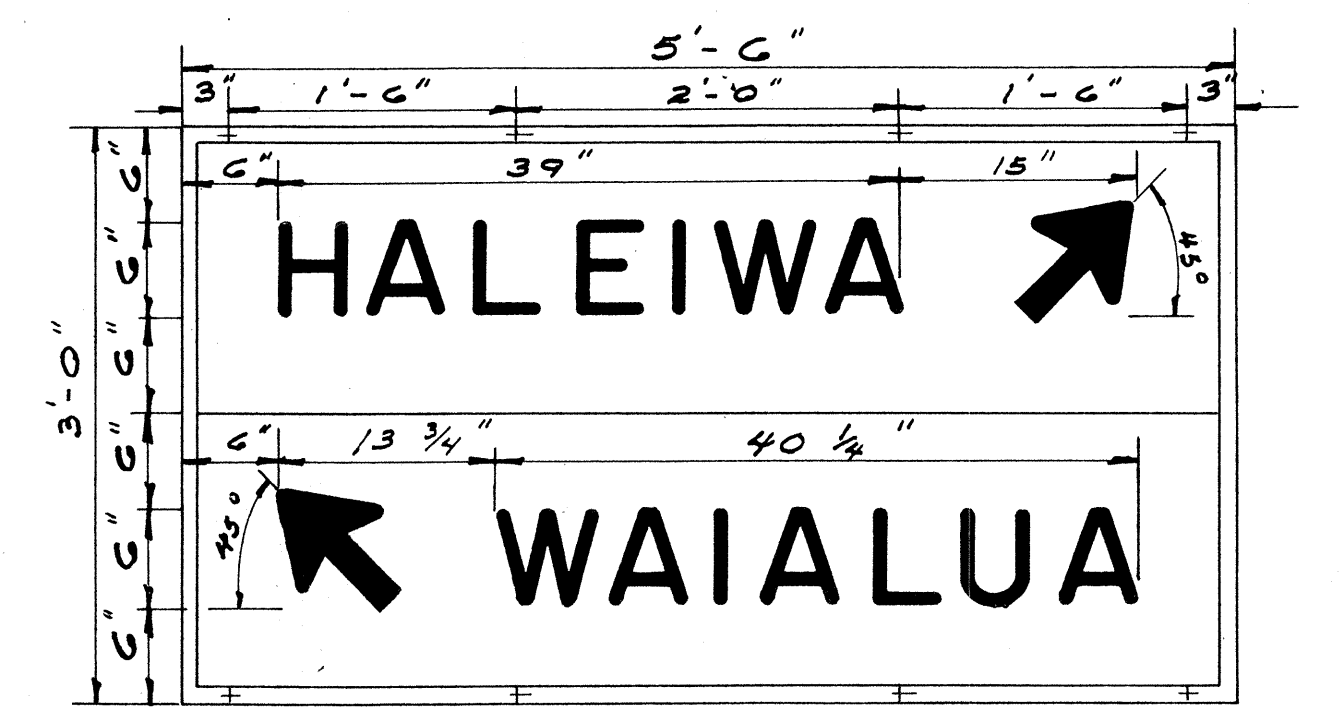


D-4

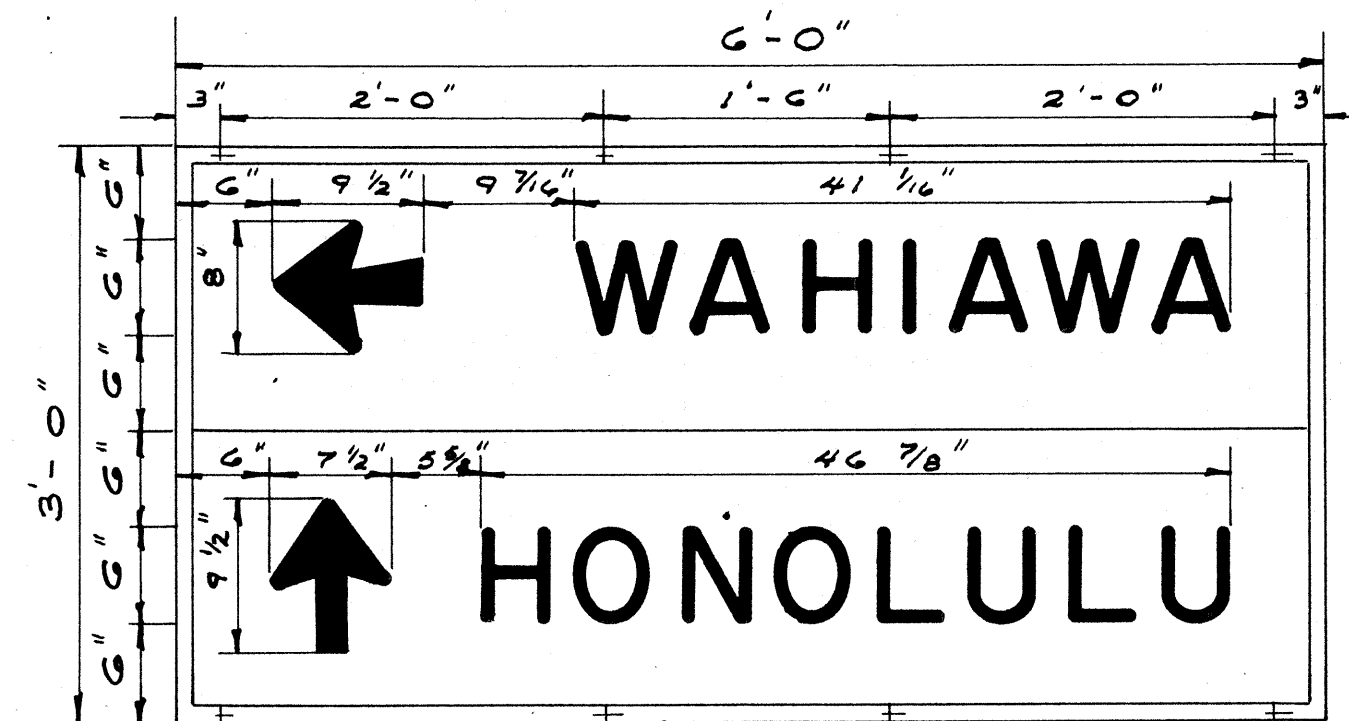


D-5

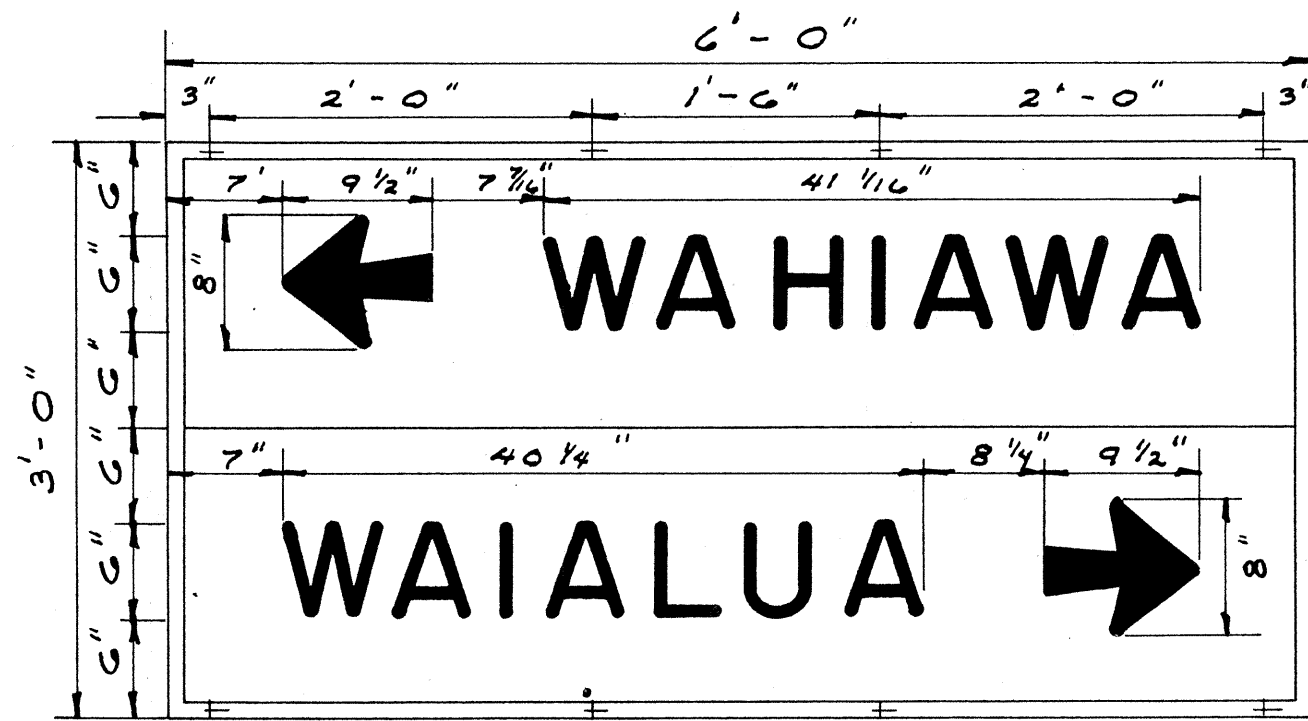


D-6

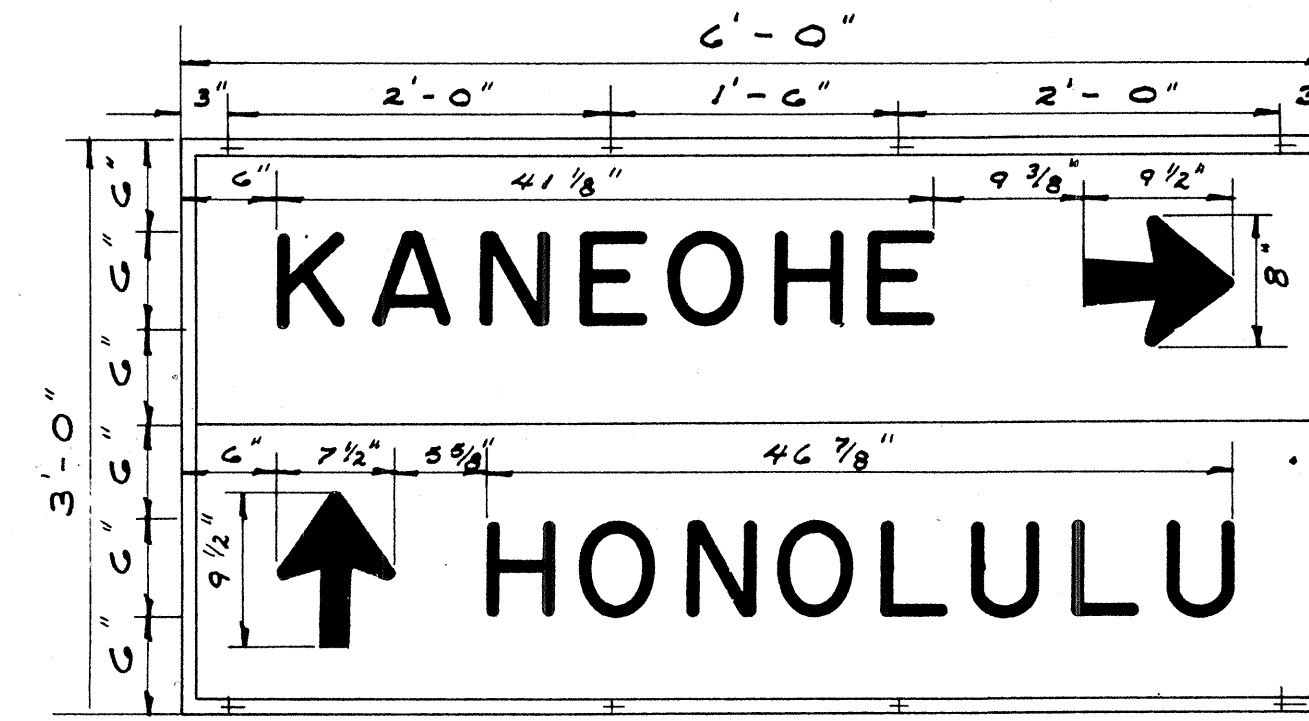


D-7

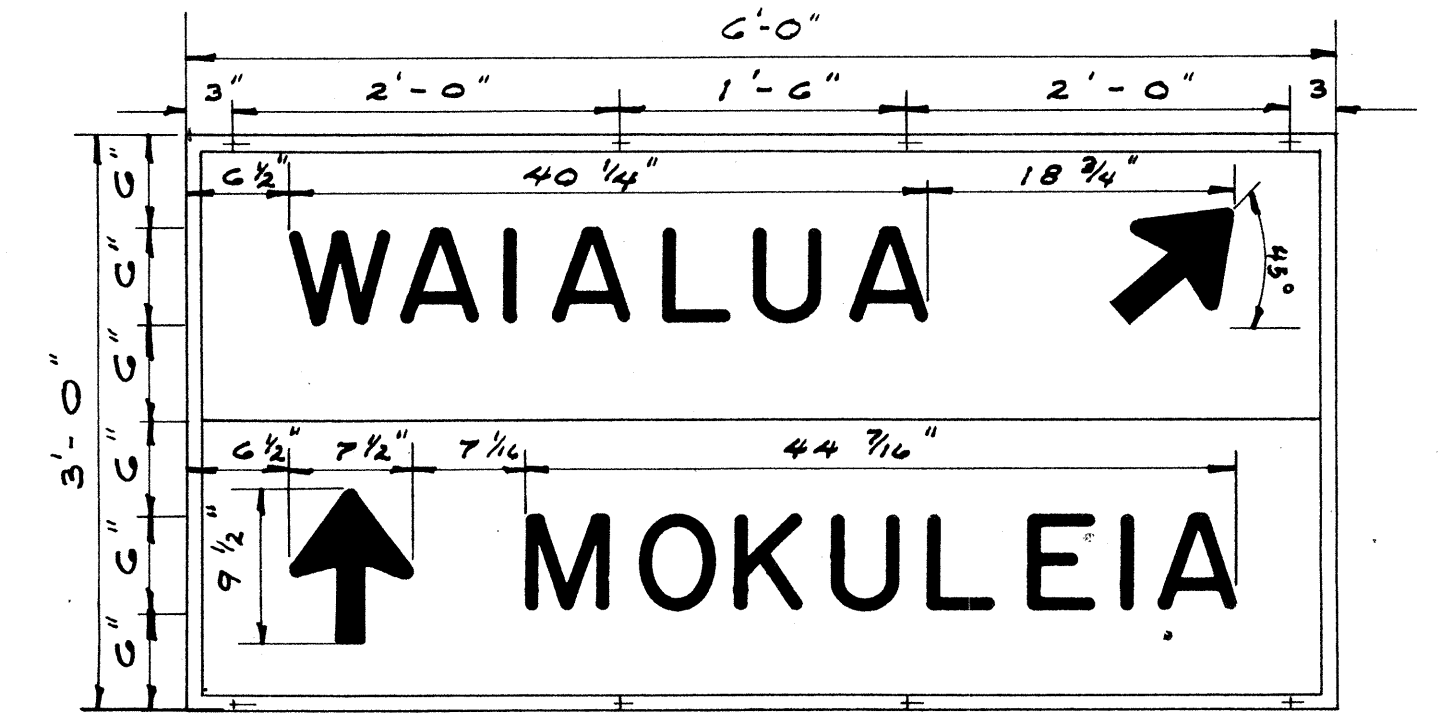


D-8

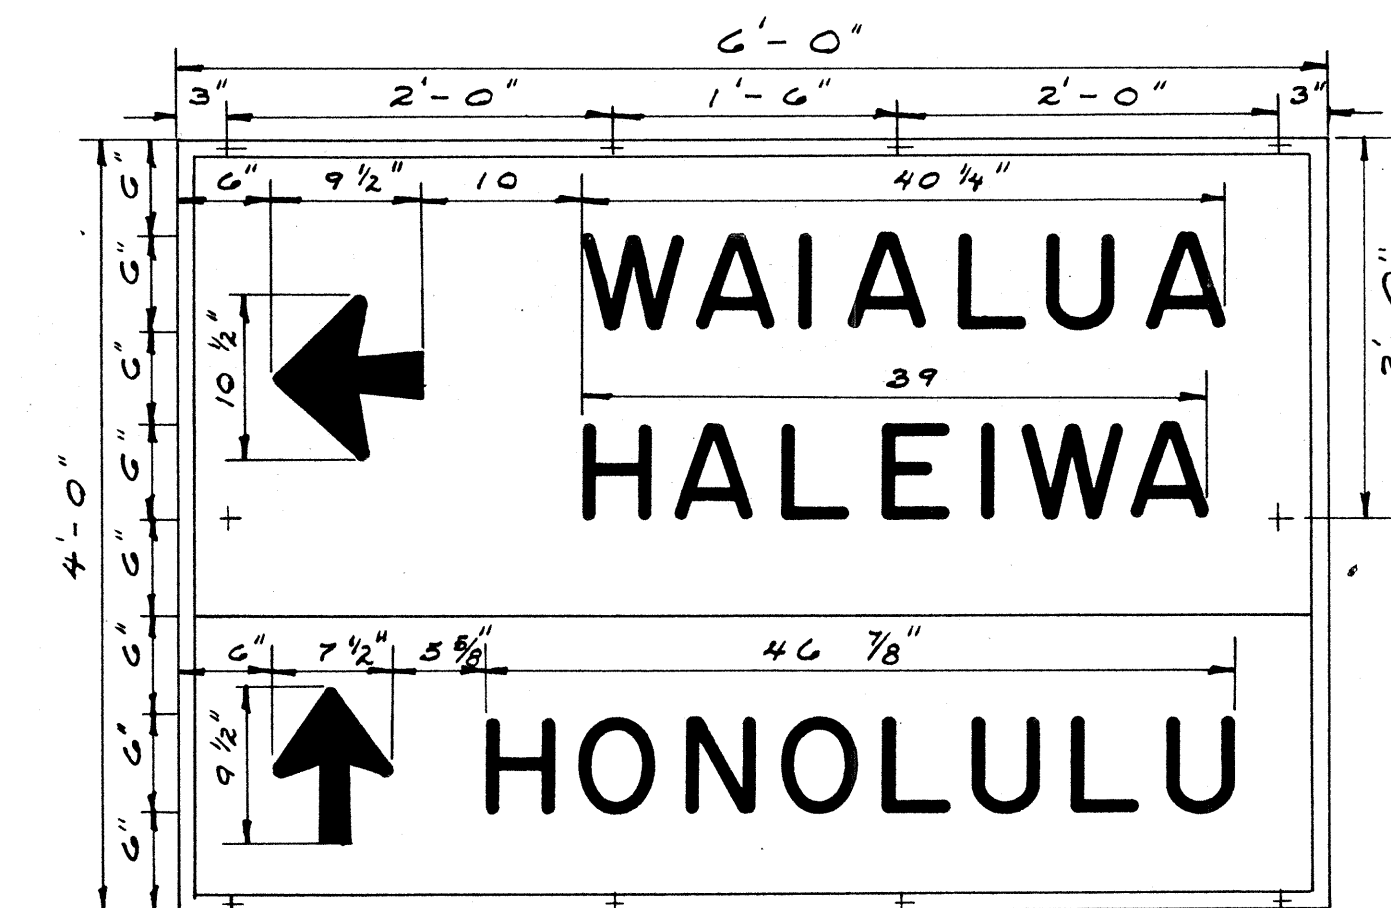


D-9

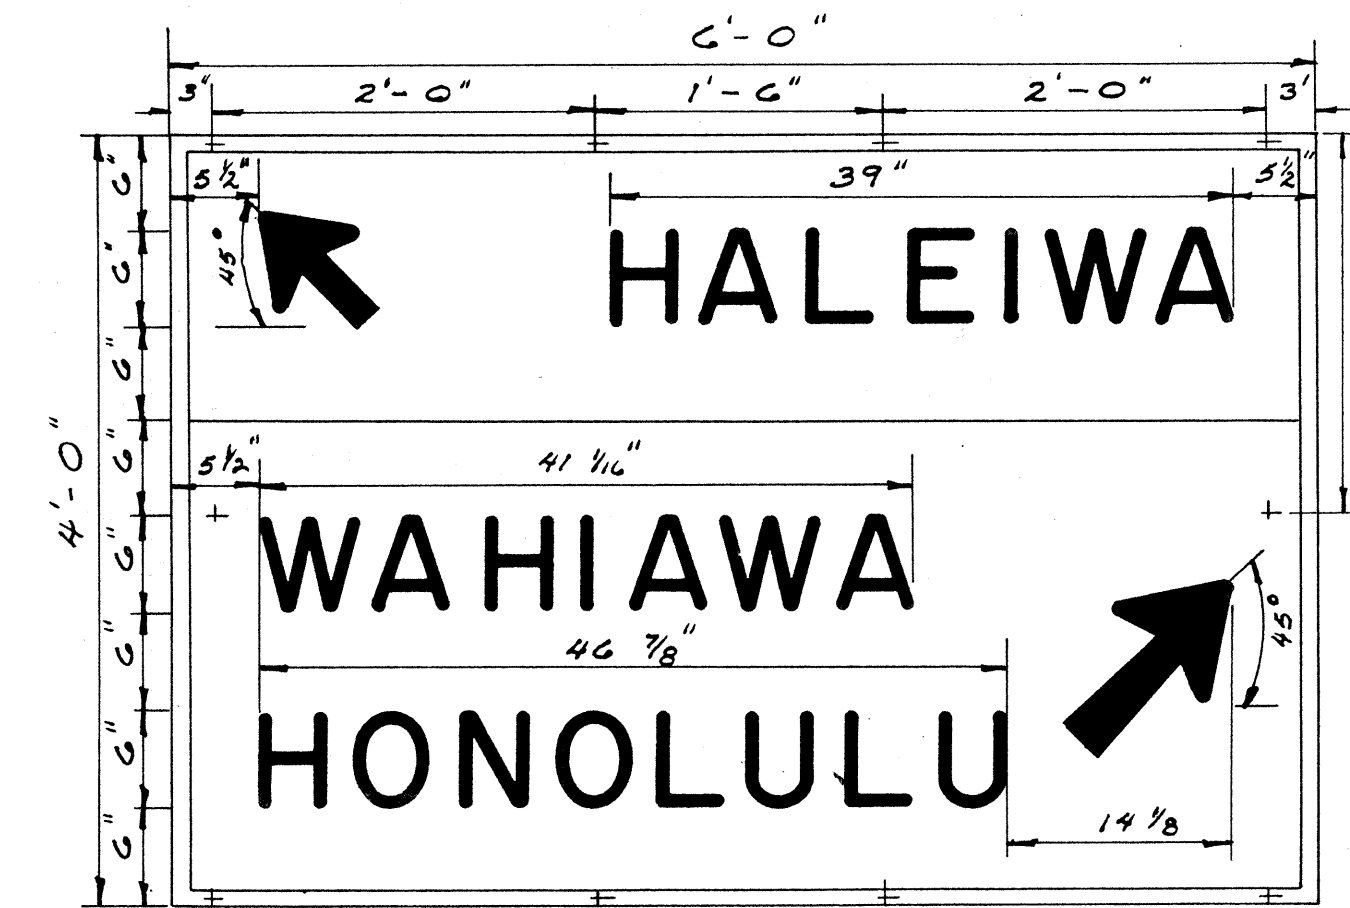


D-10

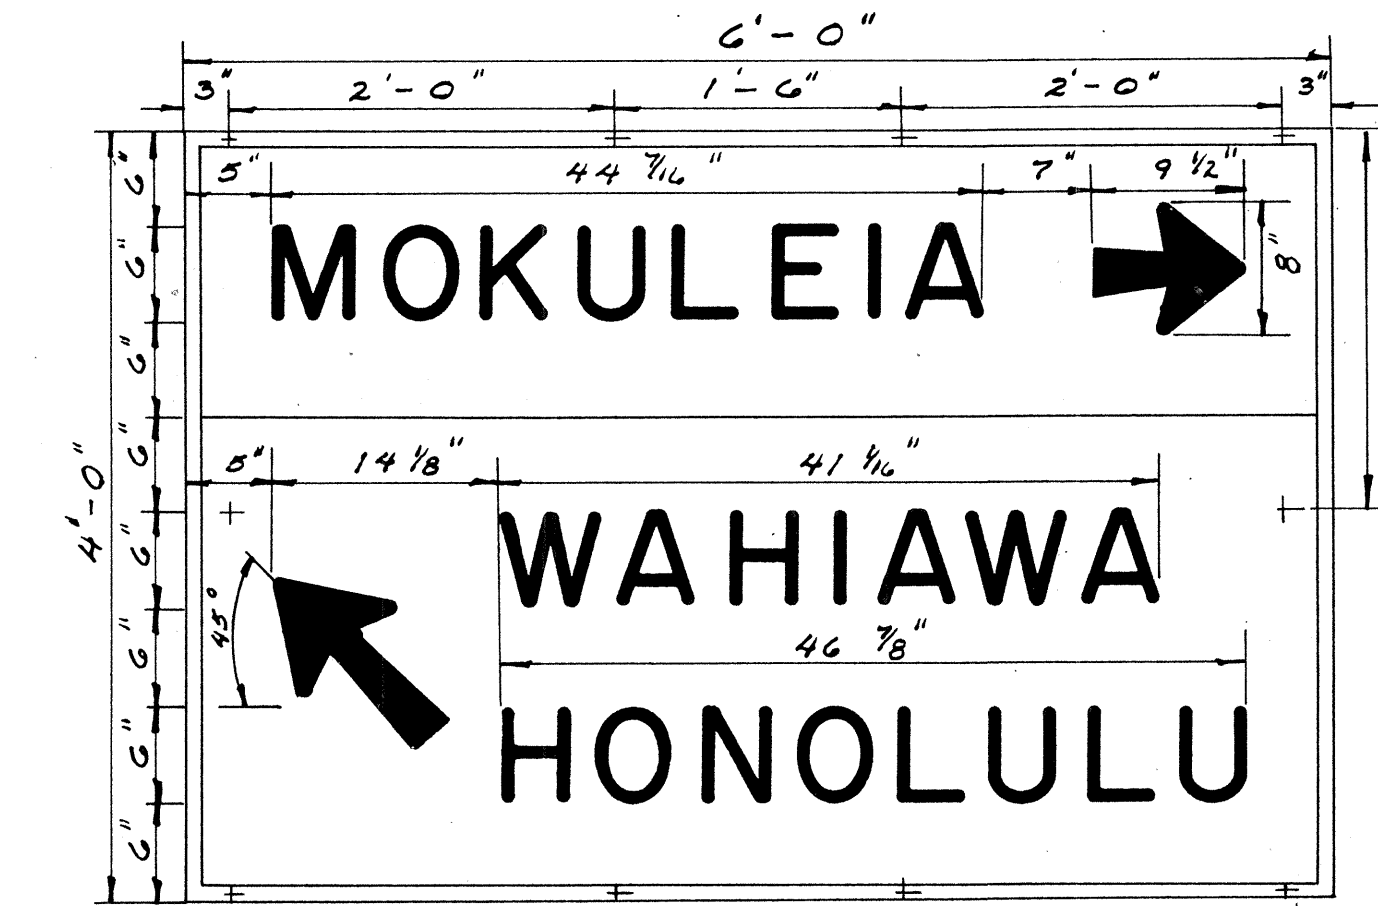


D-11

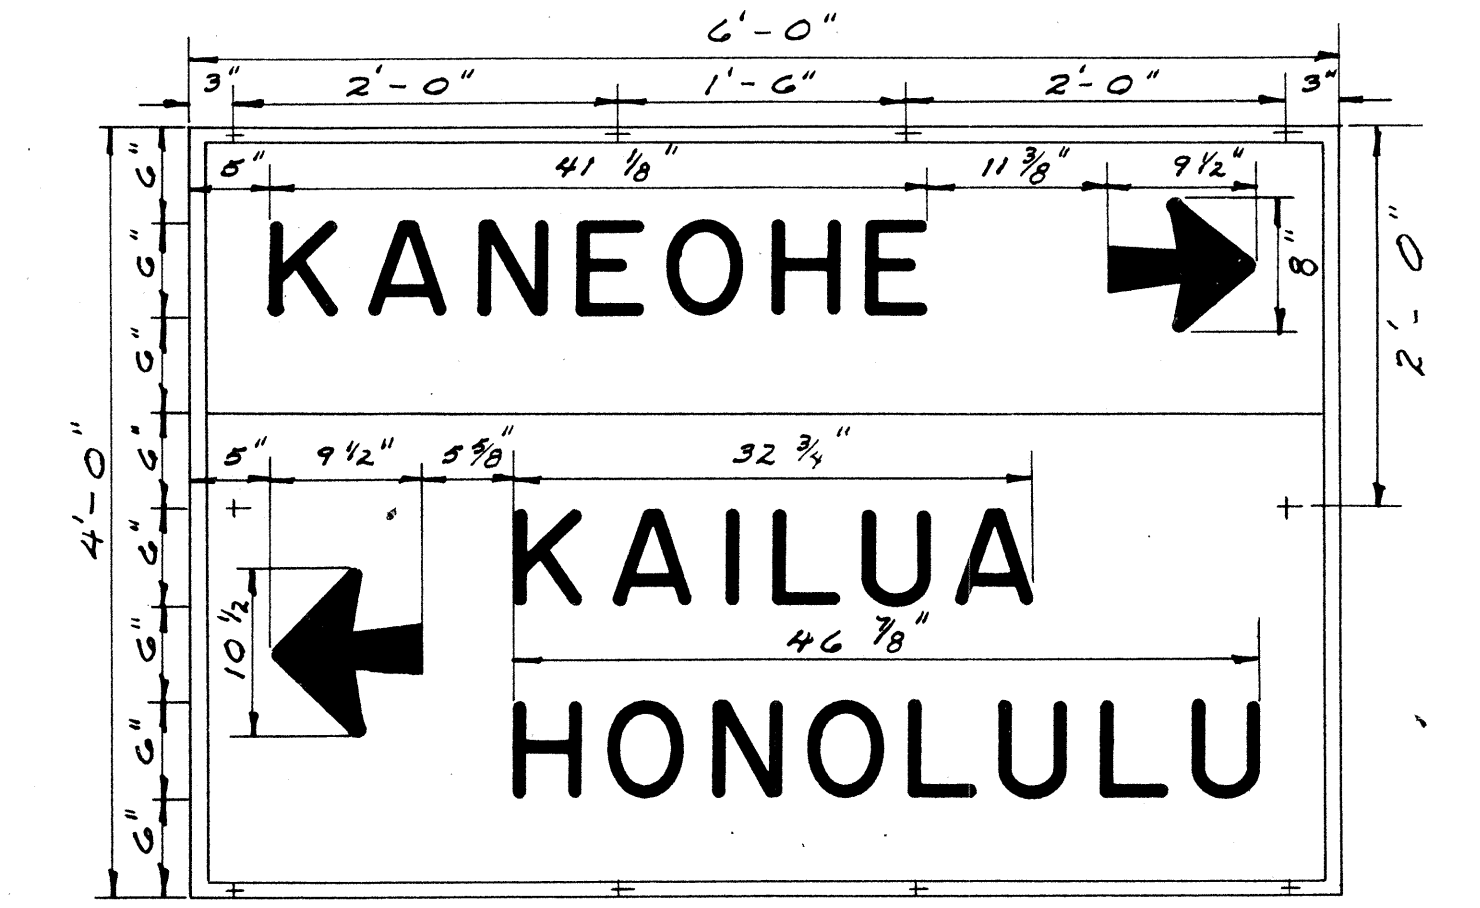


D-12

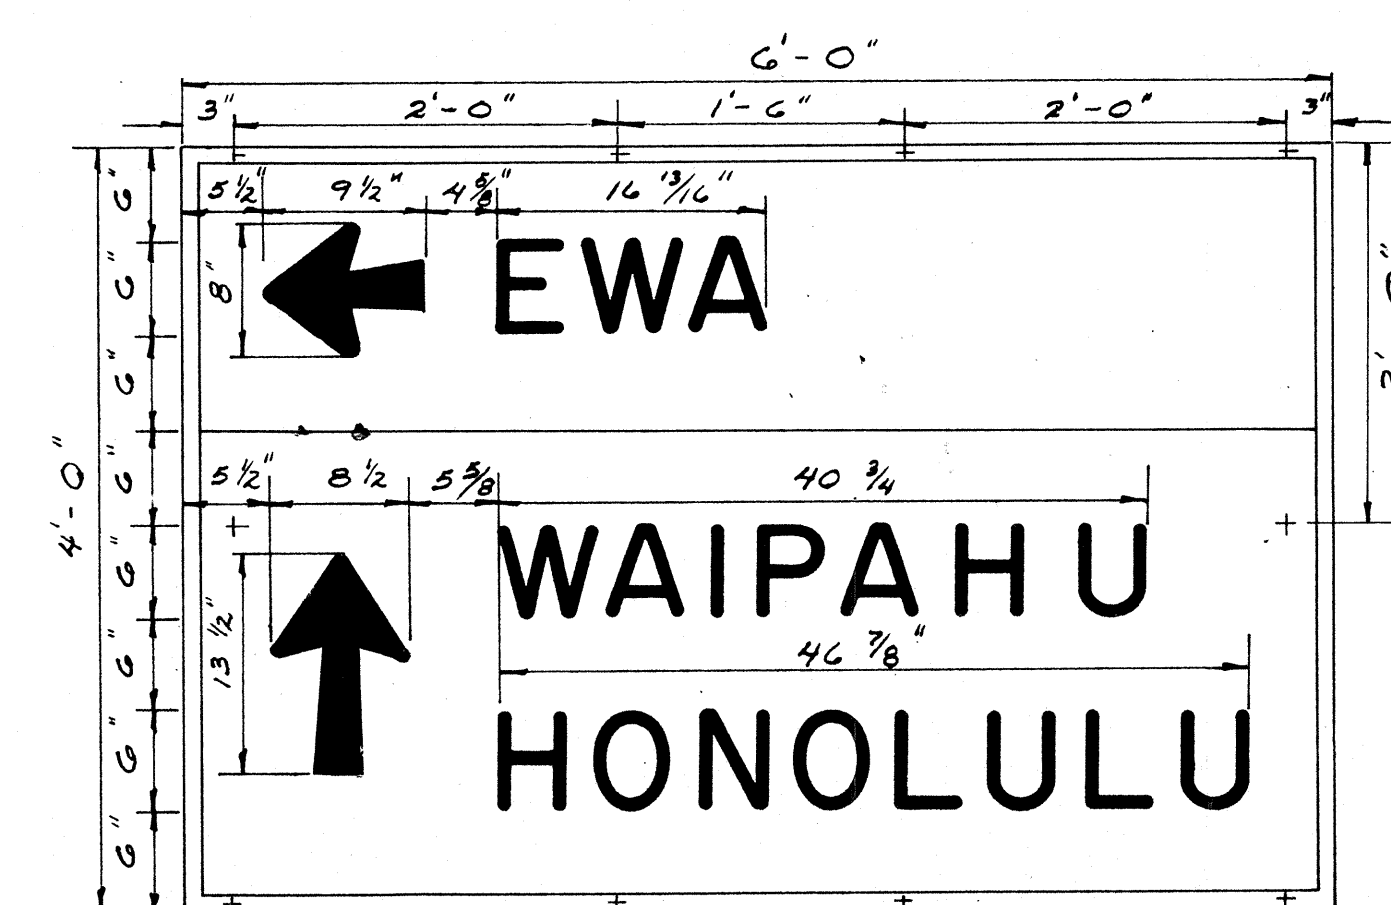

D-13

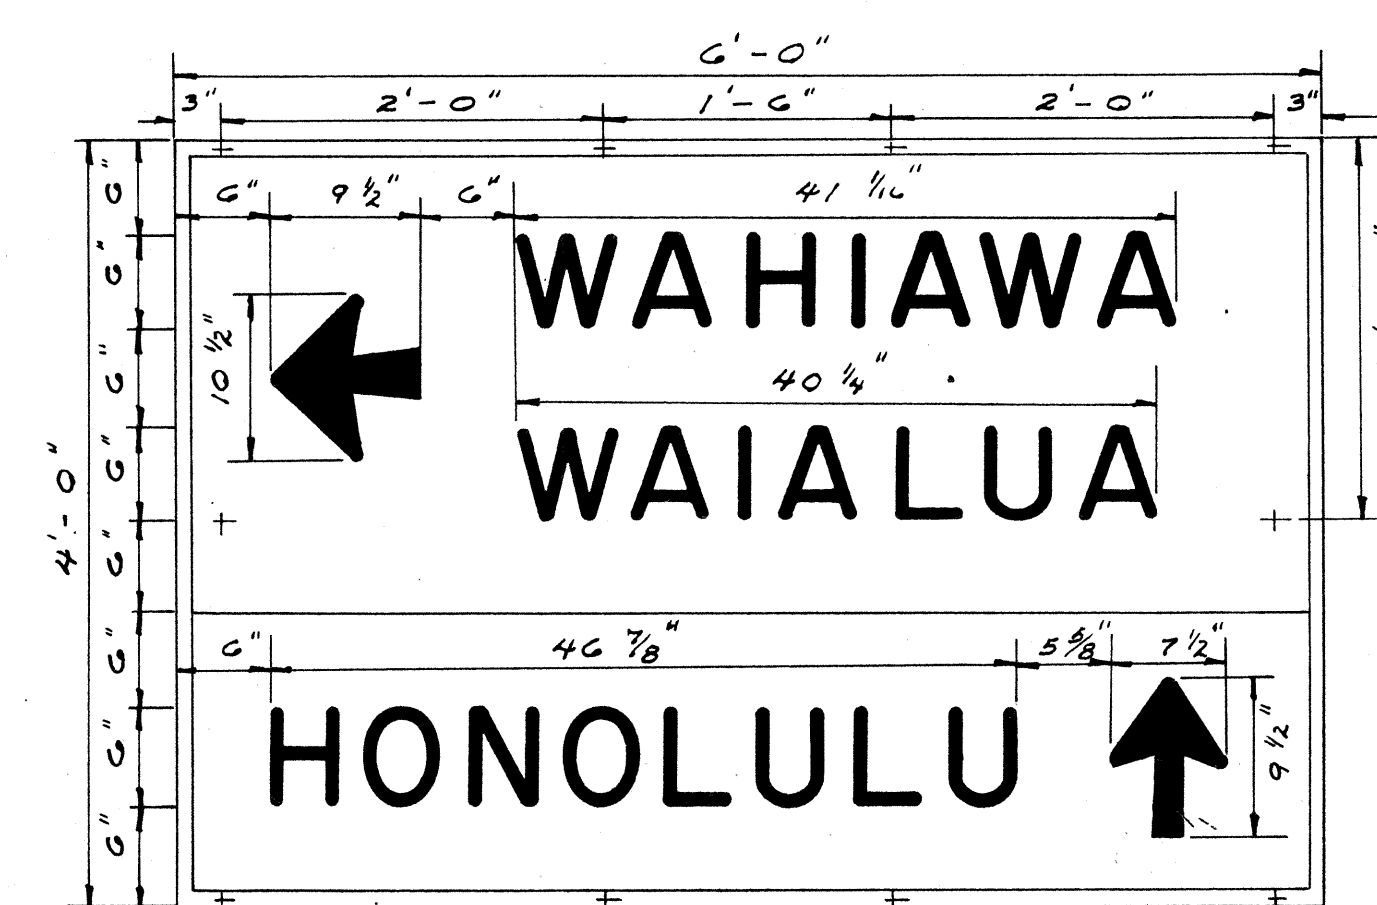

D-14

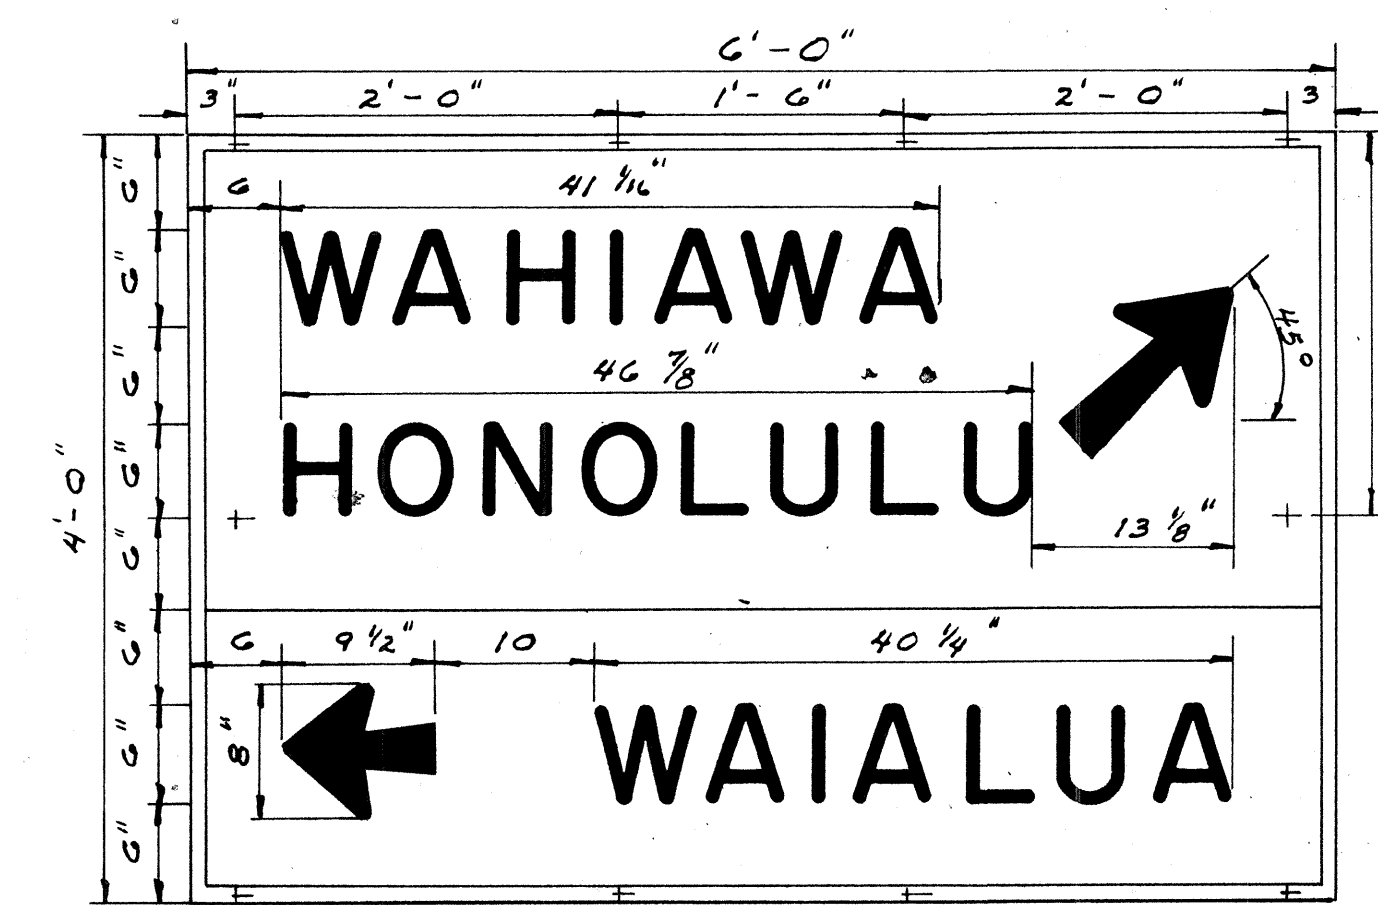

D-15

Note:

Signs D-1 to D-35 &
D-58 to D-60
6" Series "D" Letters.

Signs D-36 to D-57
4" Series "D" Letters.

Note:


134 SS Neoprene
Washers Required.

TERRITORIAL HIGHWAY DEPARTMENT
TERRITORY OF HAWAII
**DESTINATION SIGNS
ISLAND OF OAHU**
SCALE: 1" = 1'-0"


SHEET NO. 1 OF 5 SHEETS

A-0001-04-60 (4)


ORIGINAL	SURVEY PLOTTED BY	DATE
PLAN	DESIGNED BY	
NOTE BOOK	DRAWN BY	
NO.	QUANTITIES CHECKED BY	
	CHECKED BY	

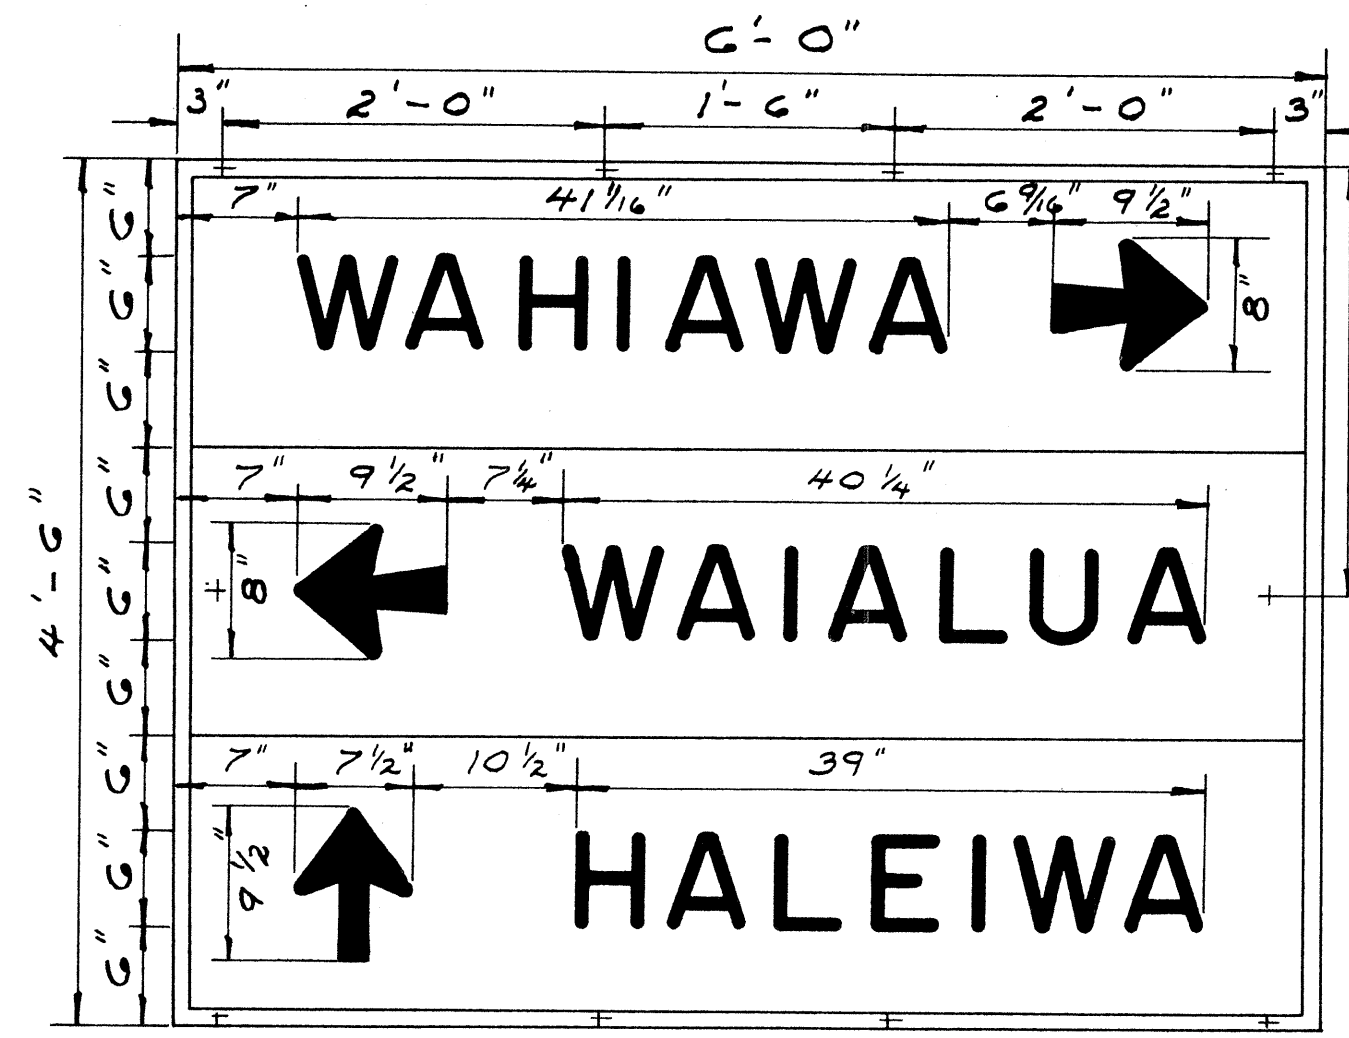


D-16

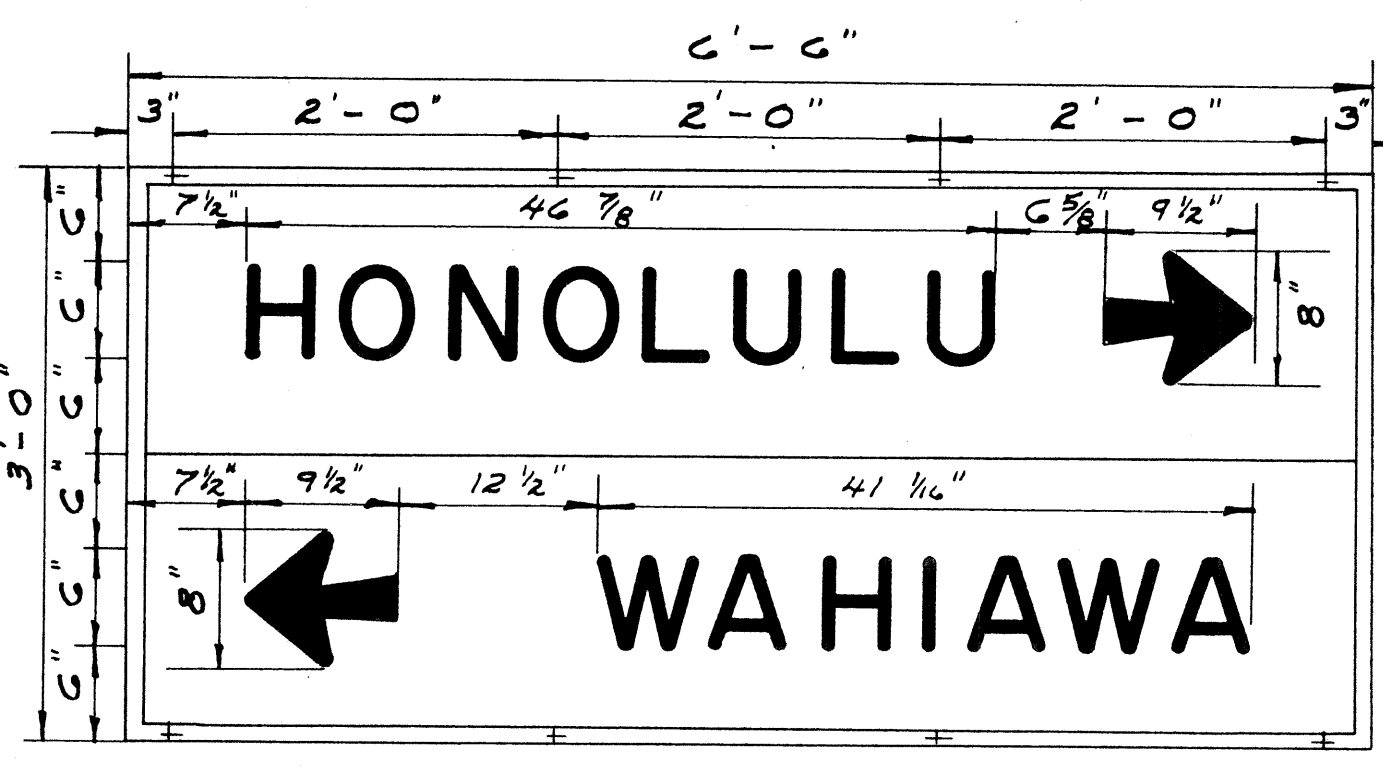

D-17

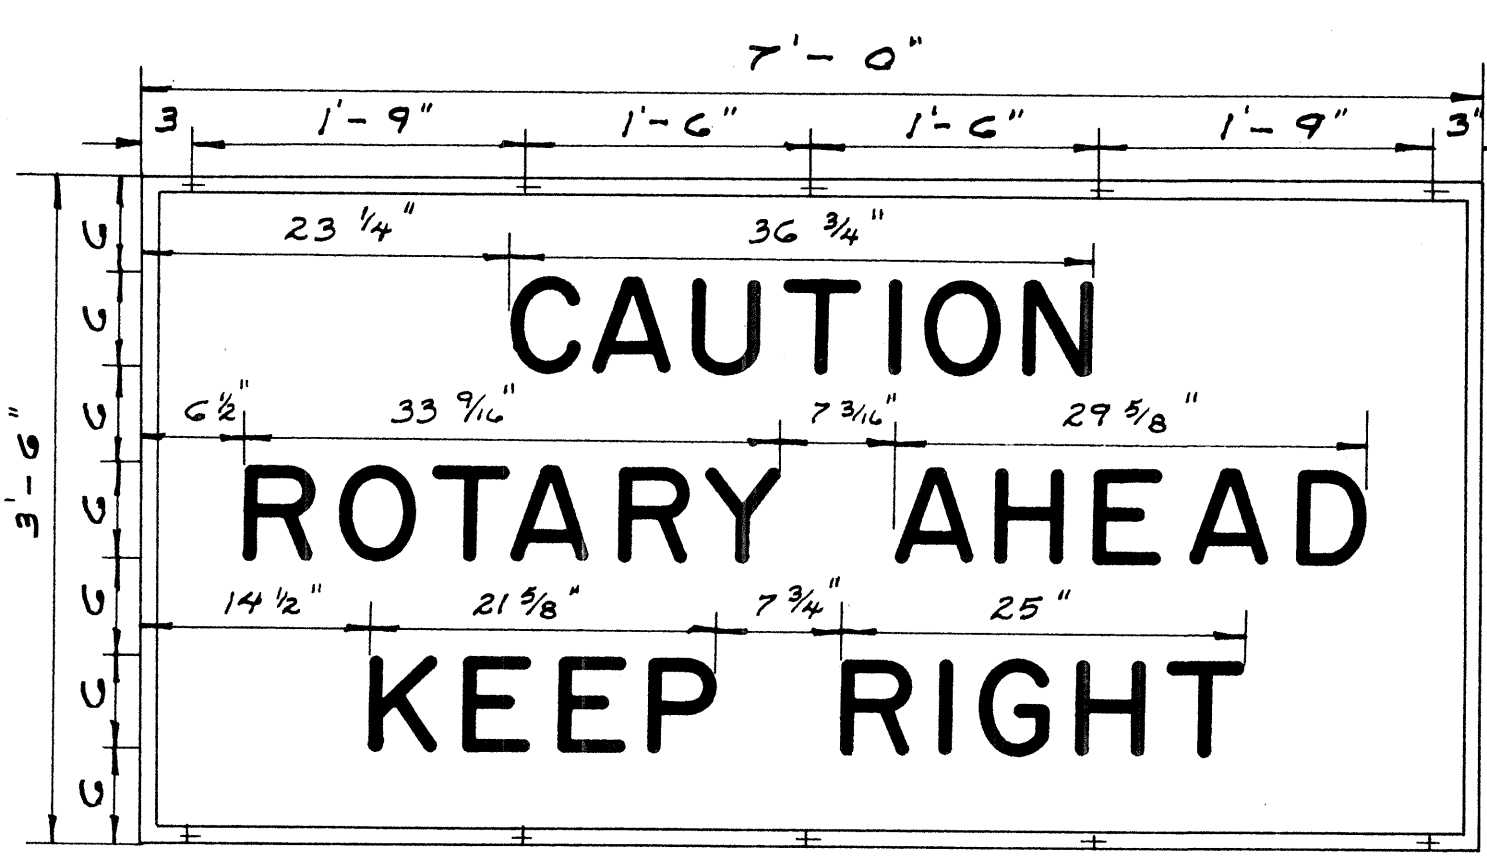


D-18

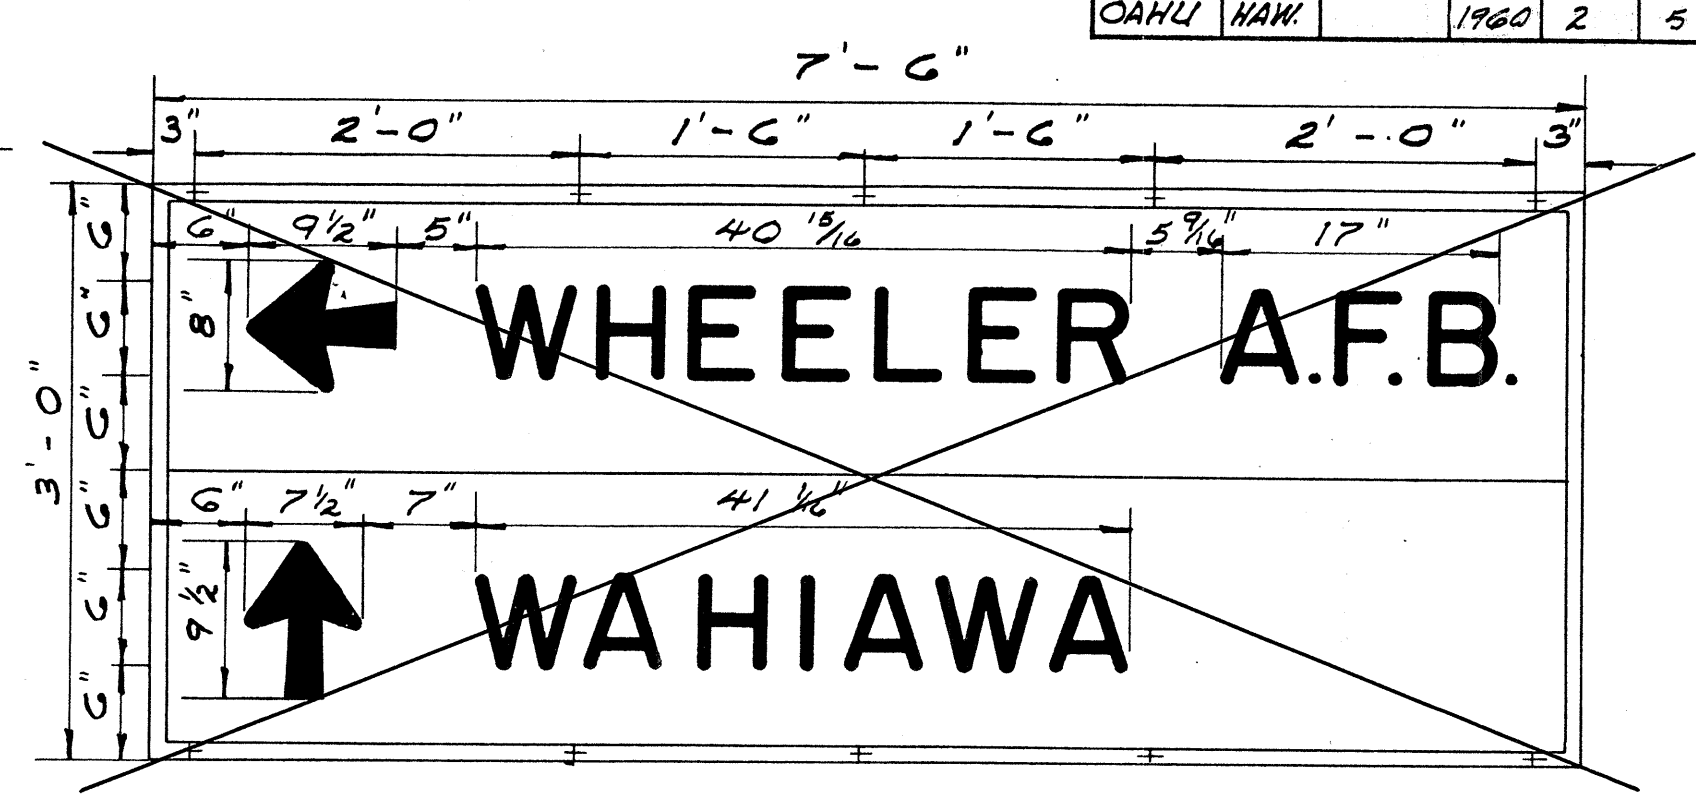


D-19


Note: Signs "D-19" and "D-20" not in contract.

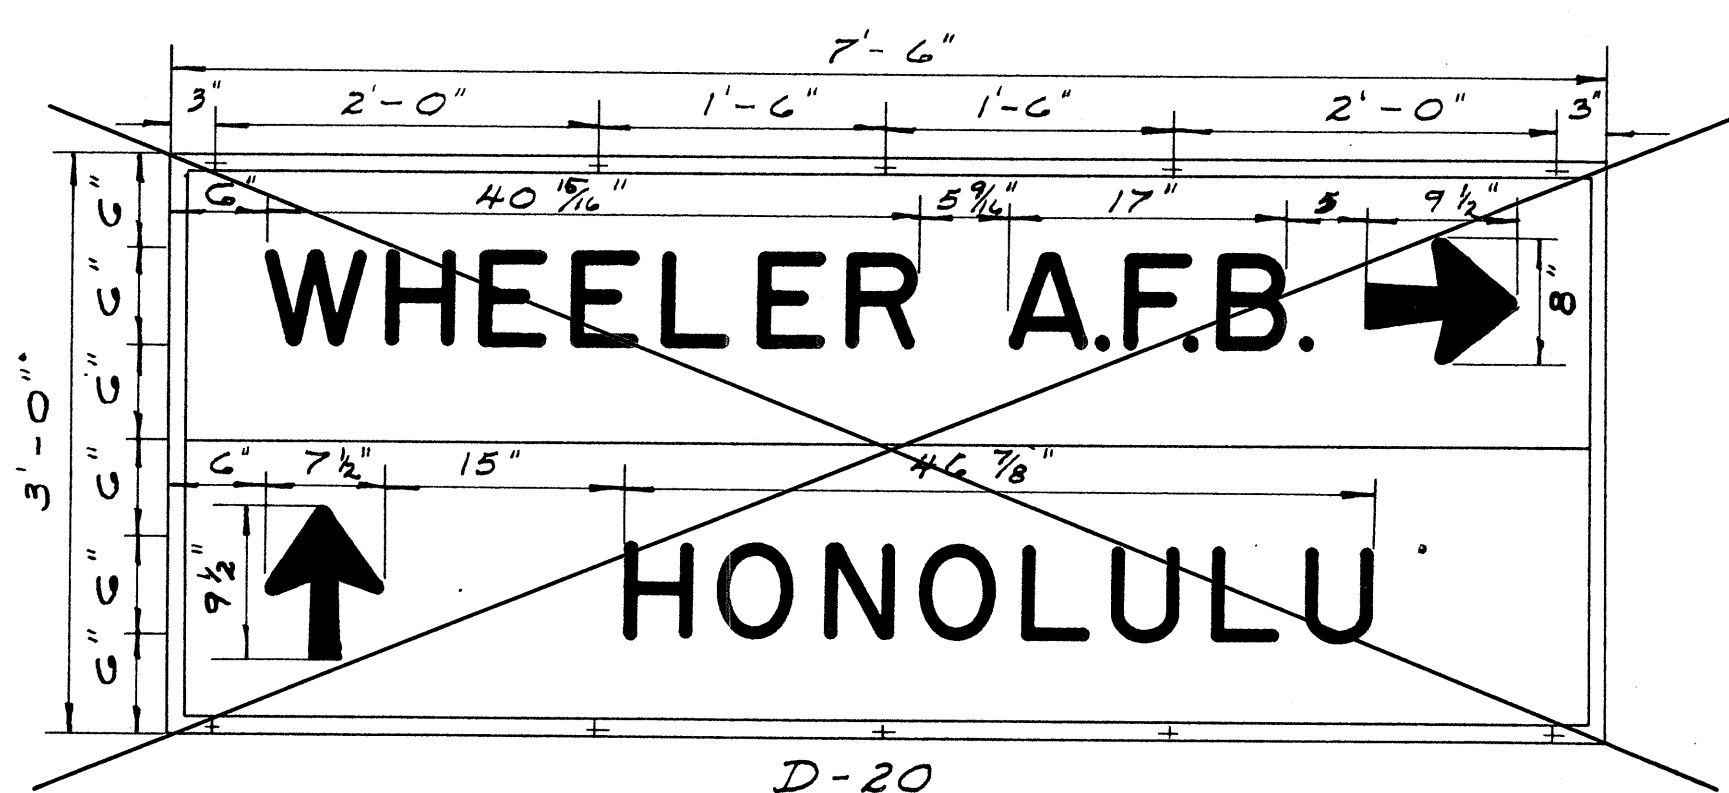


D-20

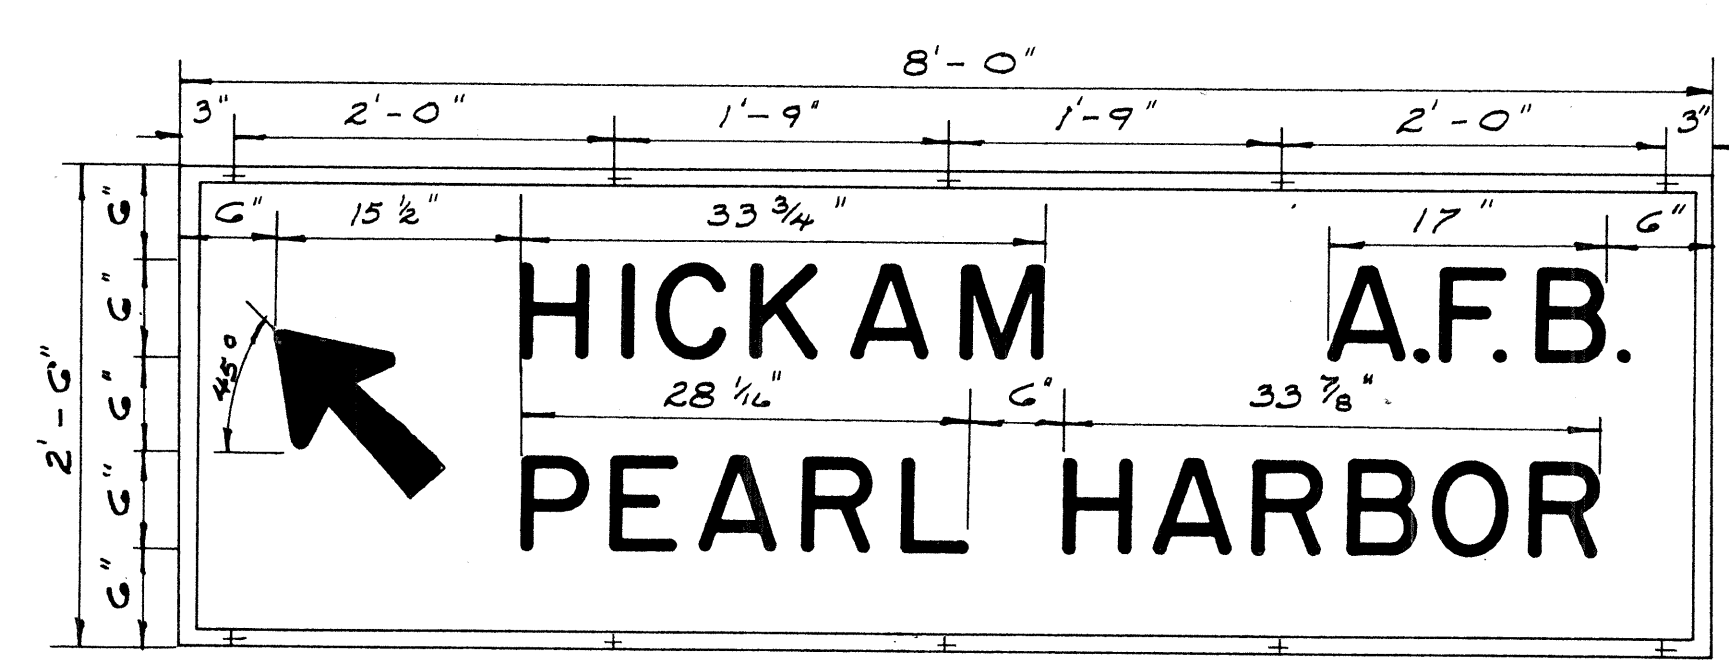


D-21

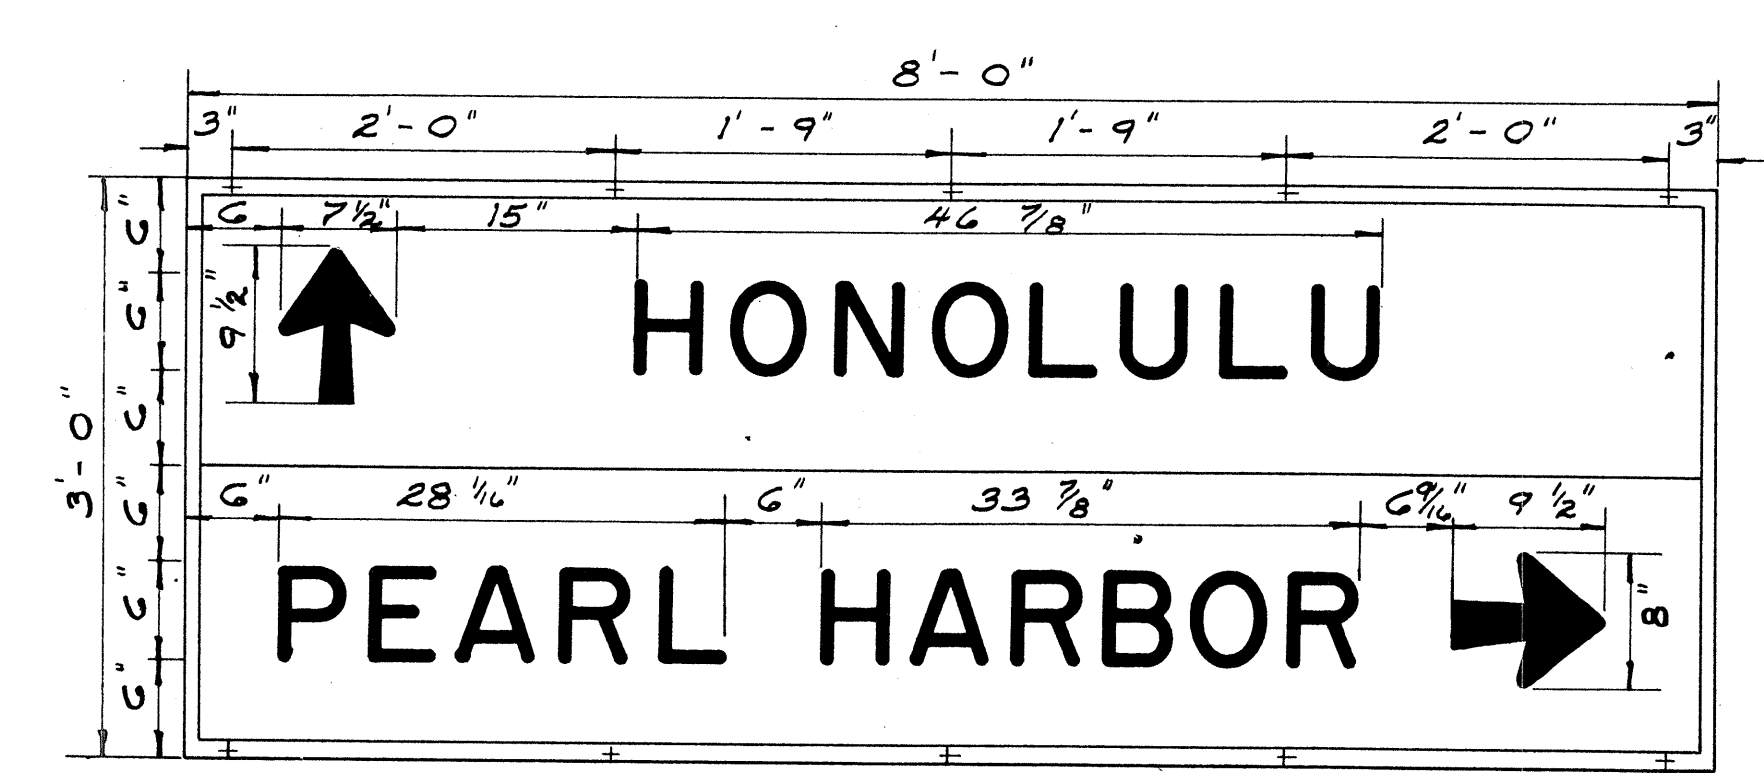


D-22

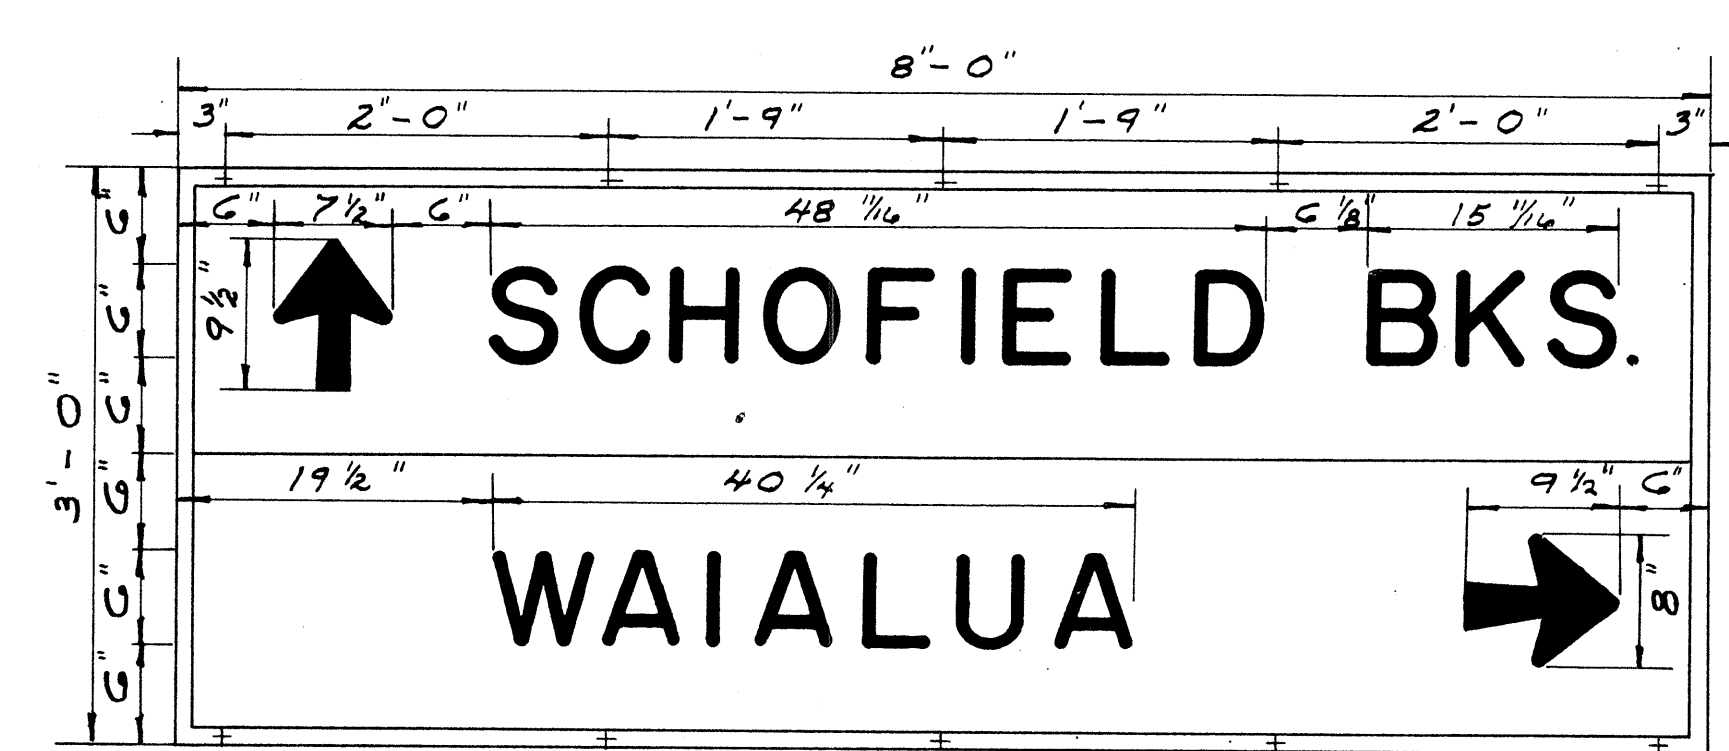


D-23

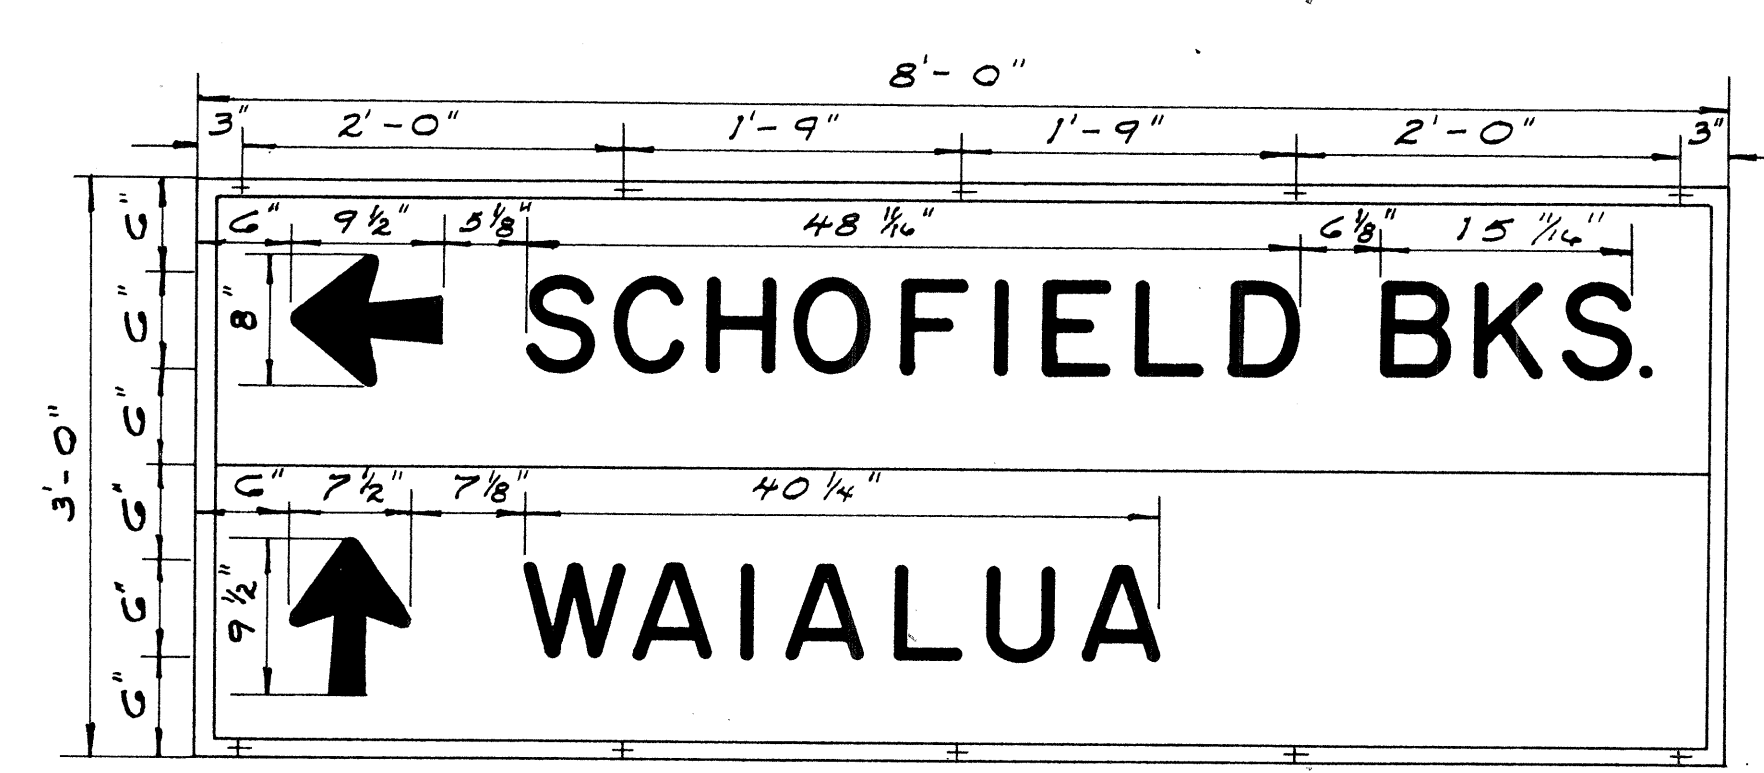


D-24

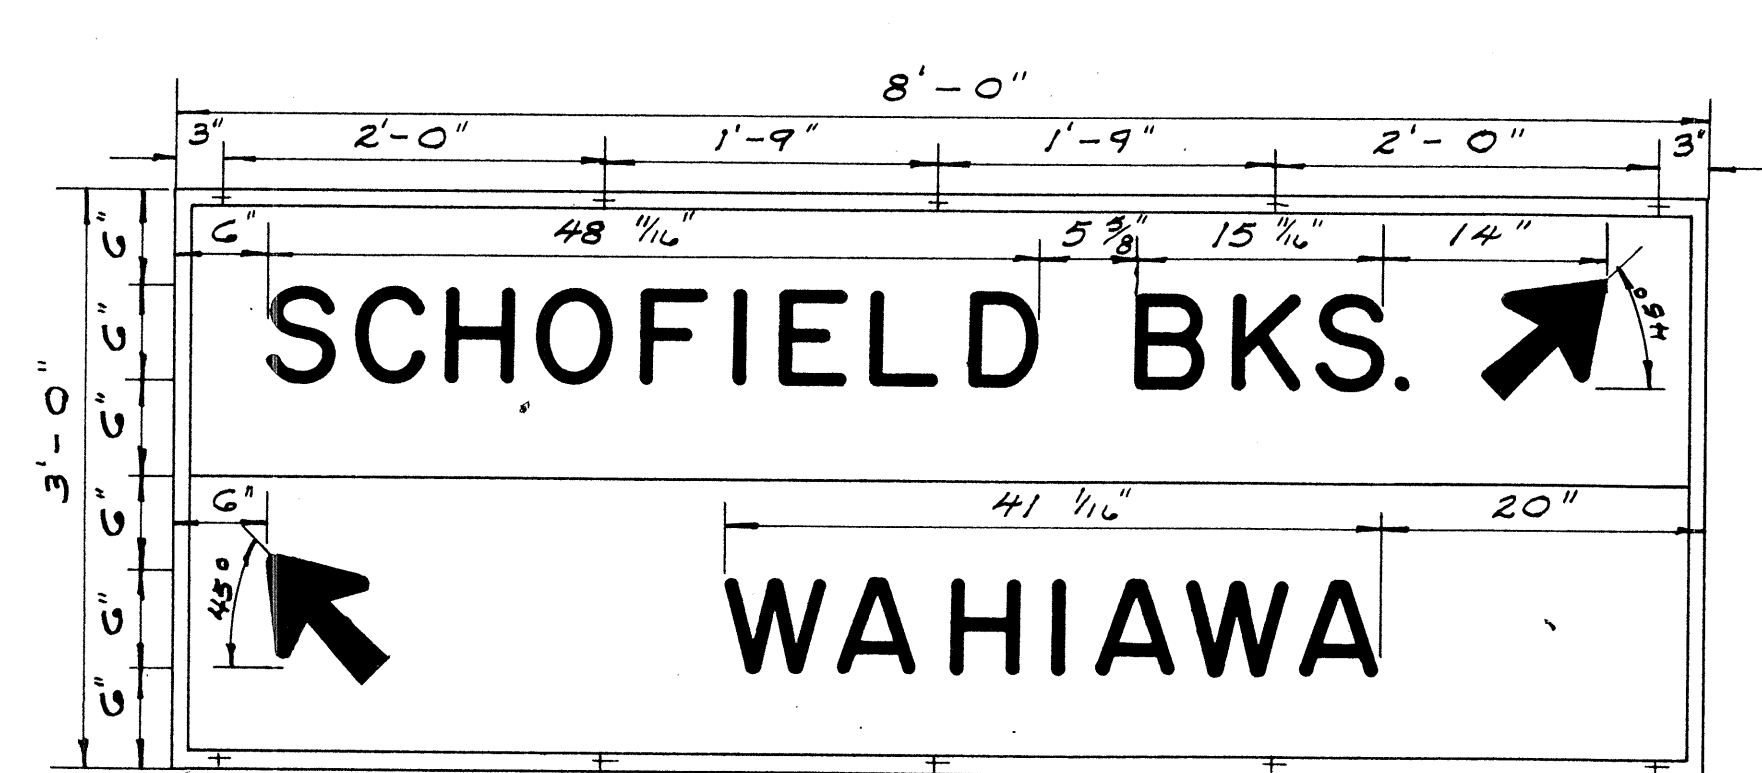

D-25

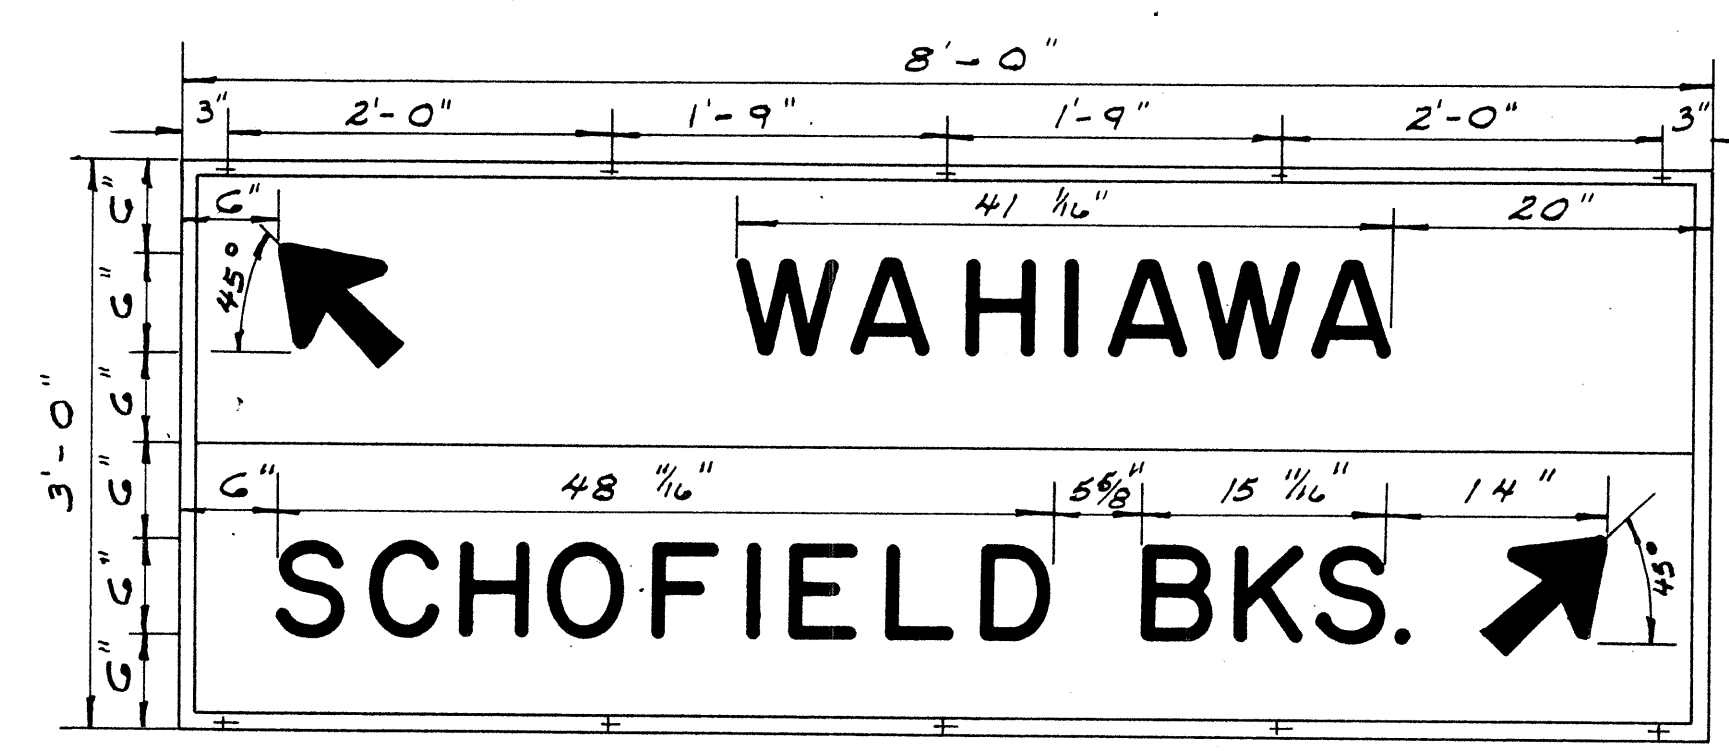

D-26

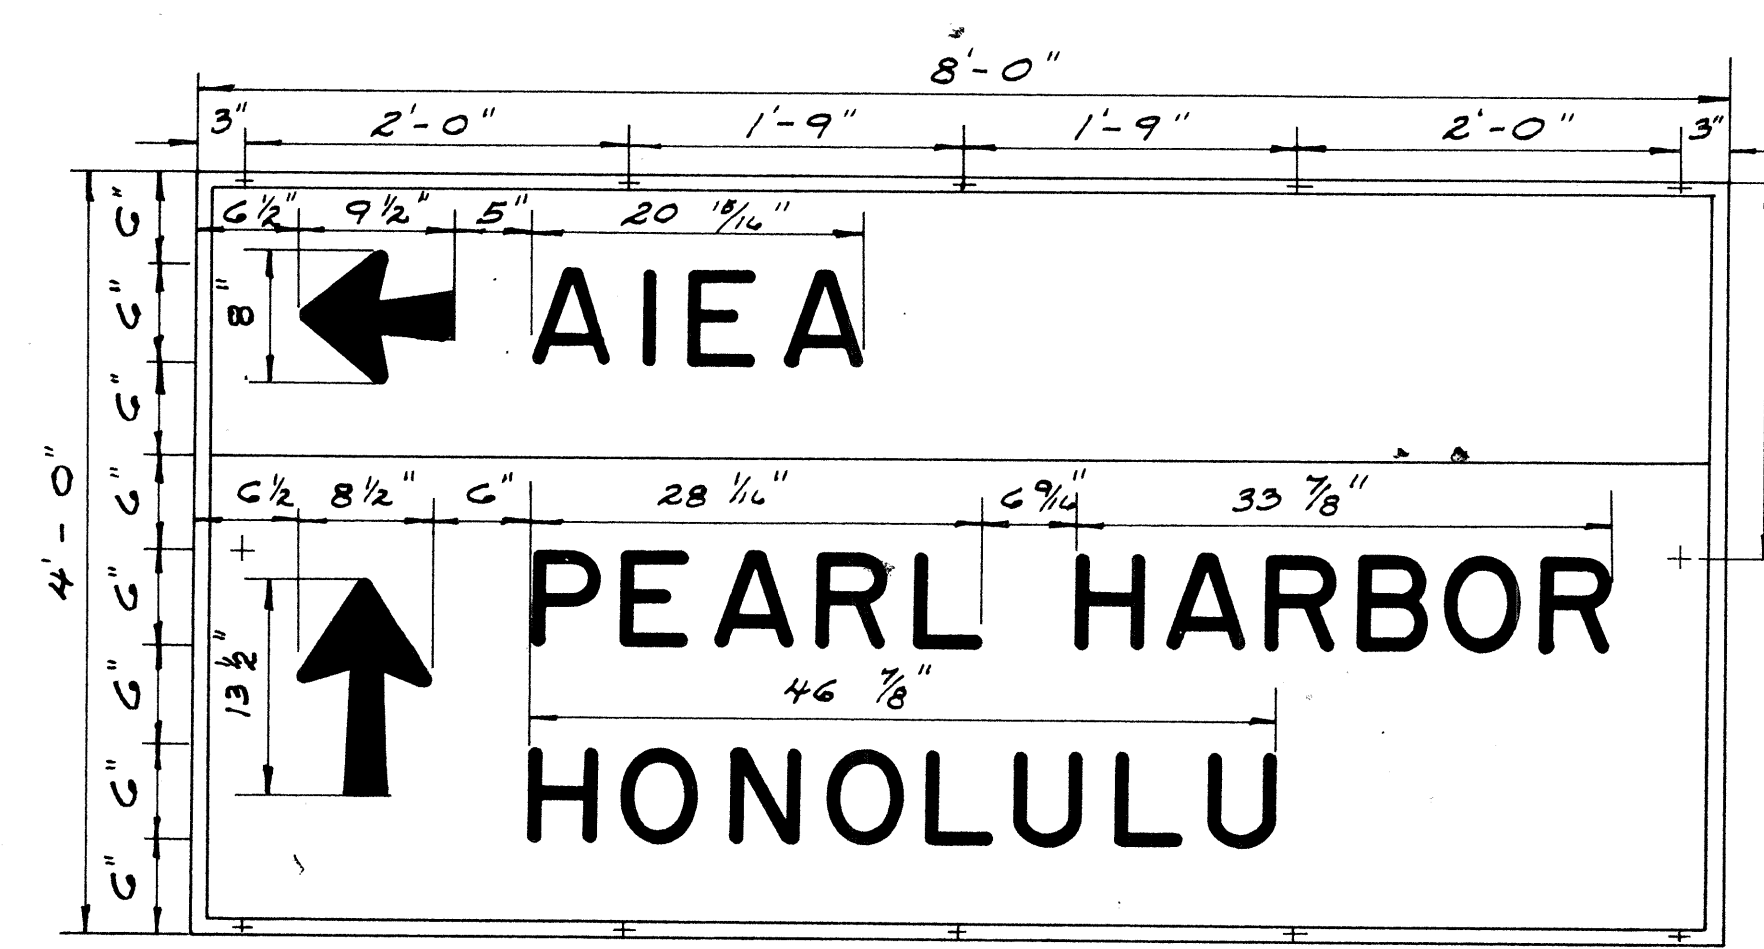

D-27


Note: 120 SS Neoprene Washers Required.

TERRITORIAL HIGHWAY DEPARTMENT
TERRITORY OF HAWAII


DESTINATION SIGNS
ISLAND OF OAHU

SCALE: 1" = 1'-0"


SURVEY PLOTTED BY	DATE
DESIGNED BY	
TRACED BY	
QUANTITIES BY	
CHECKED BY	
NOTE BOOK No.	

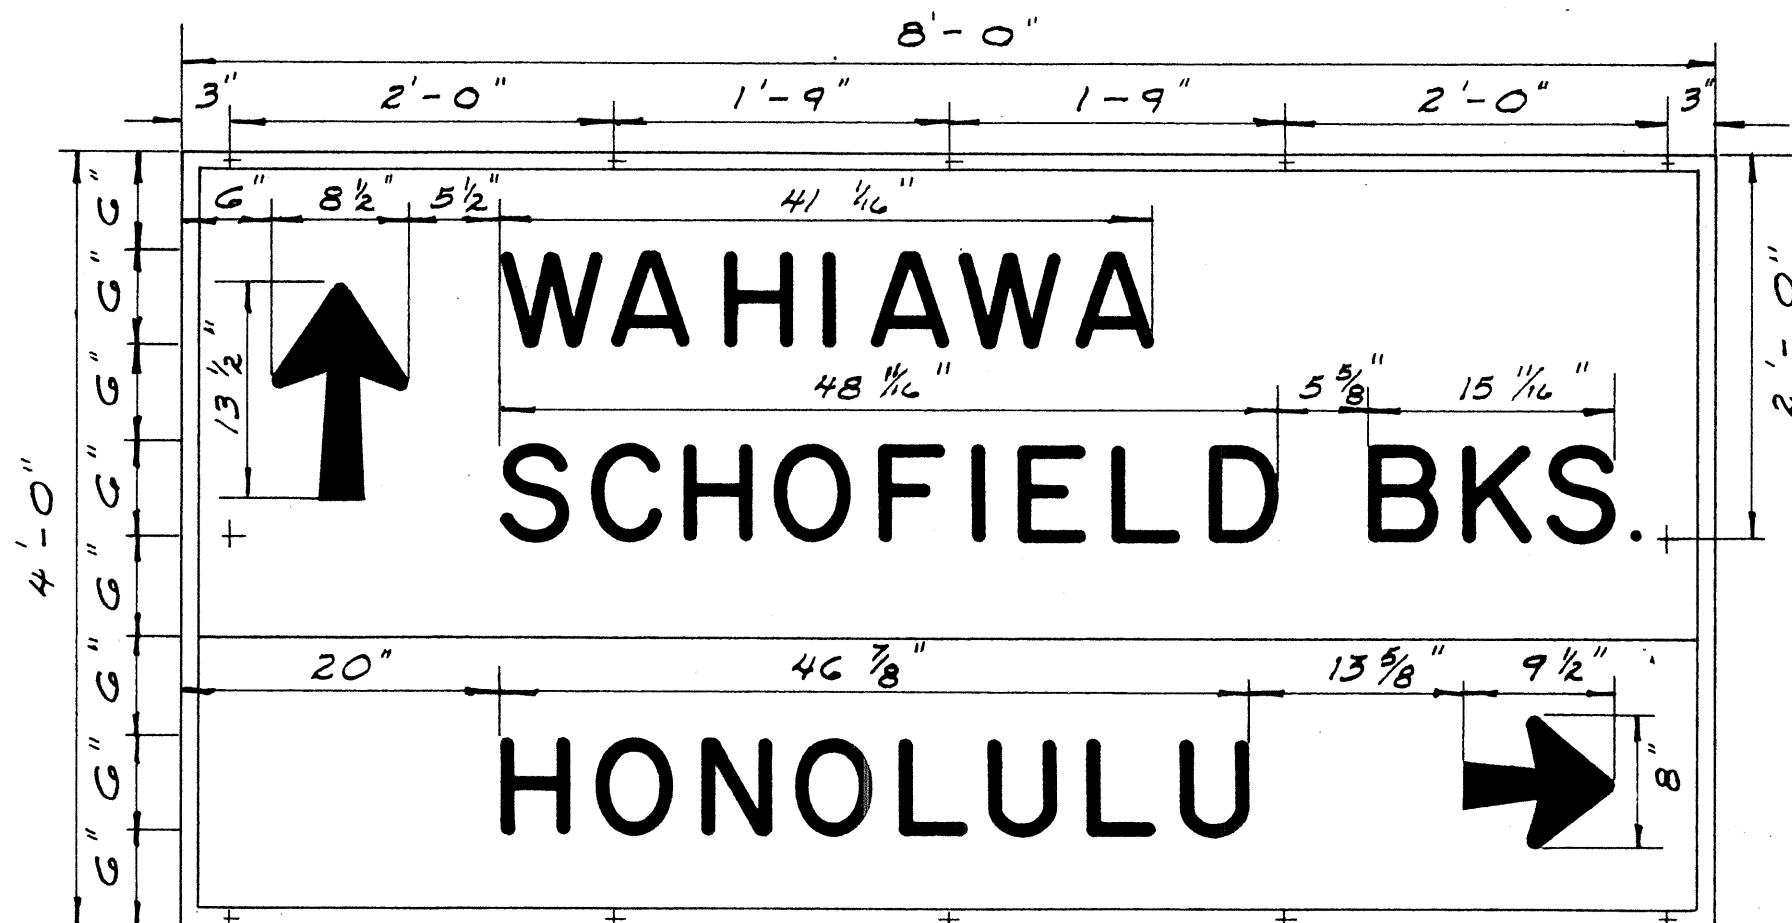


D-28

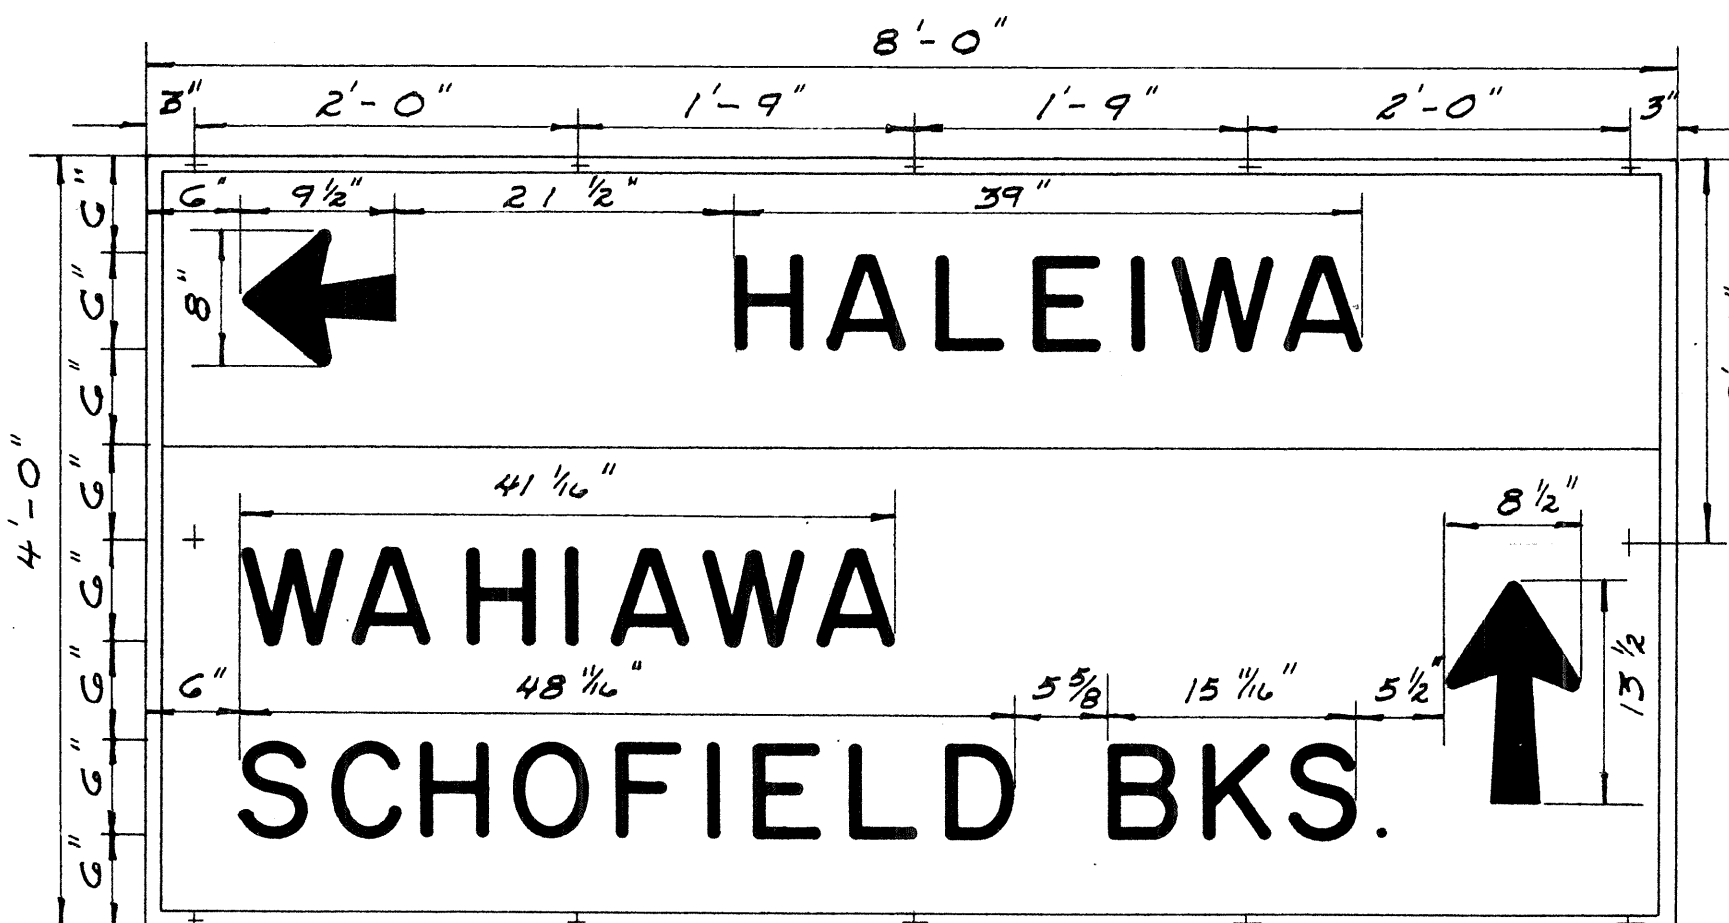


D-29

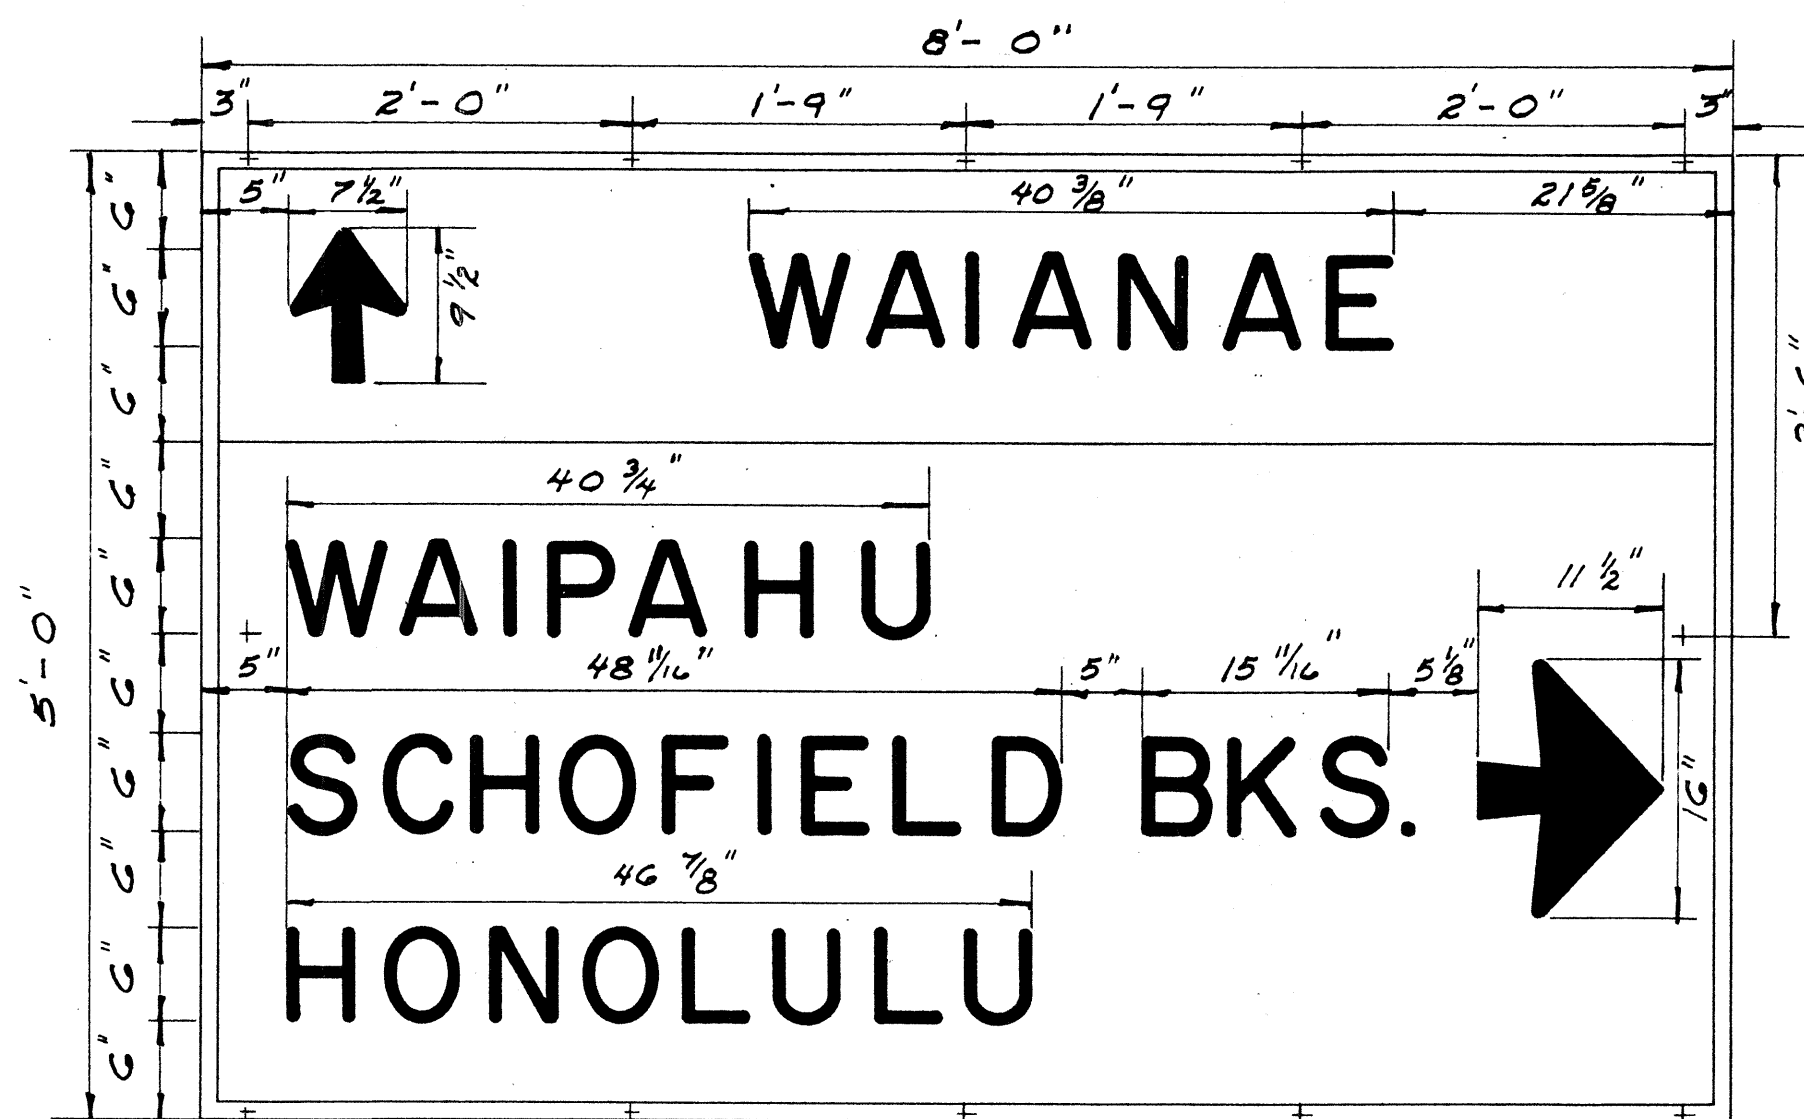


D-30

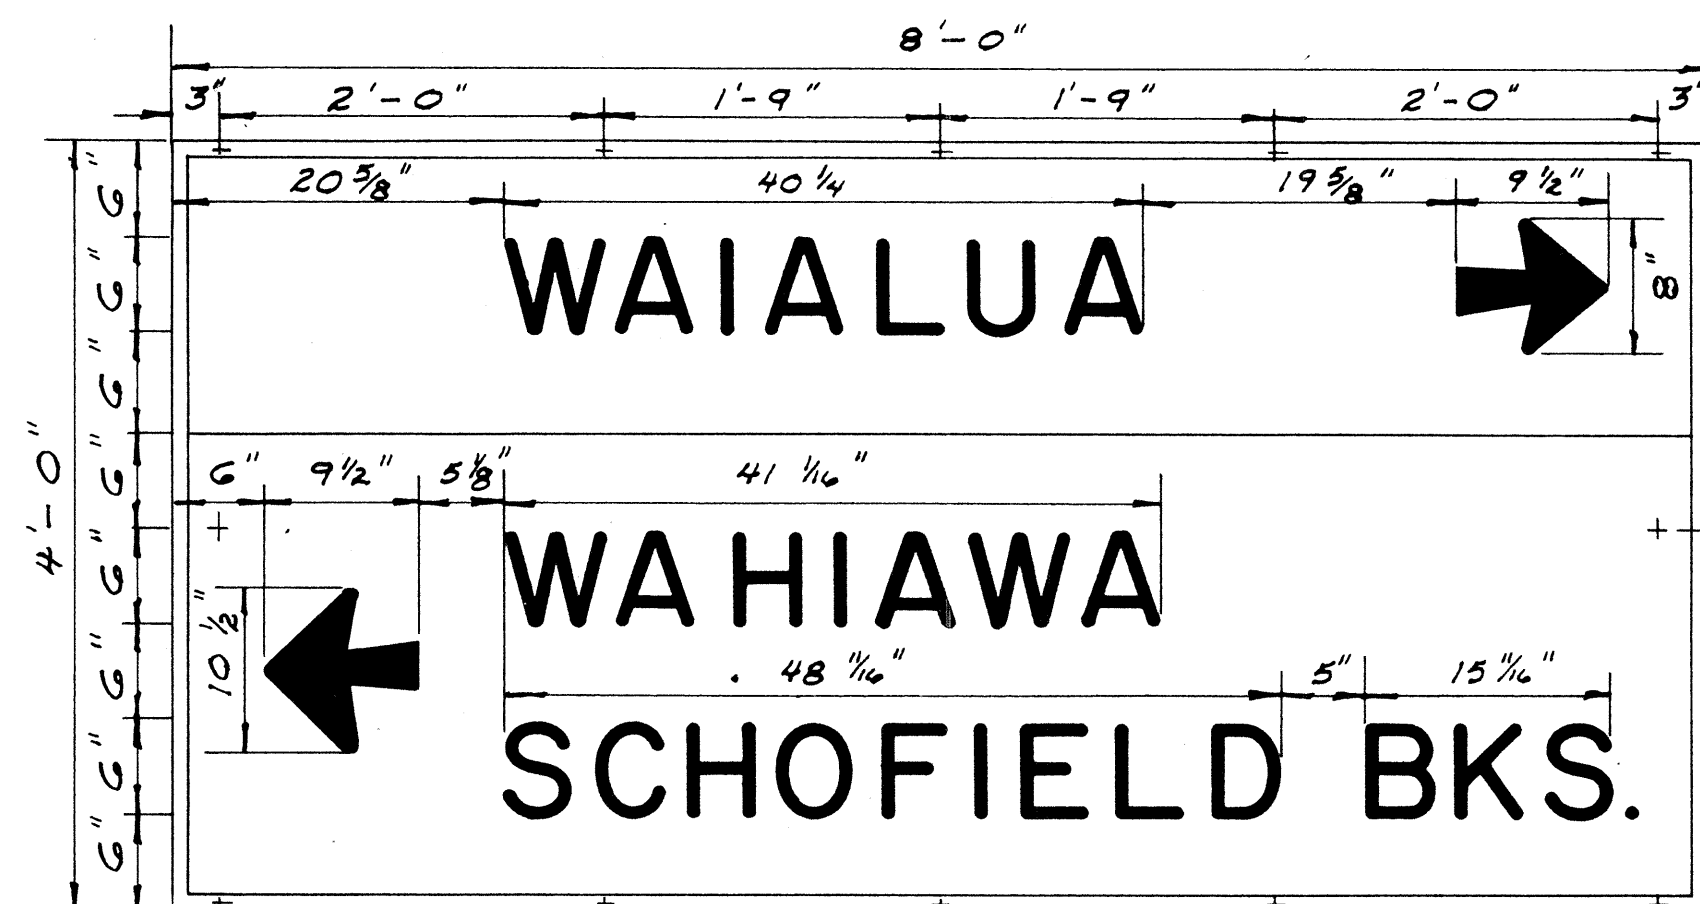


D-31

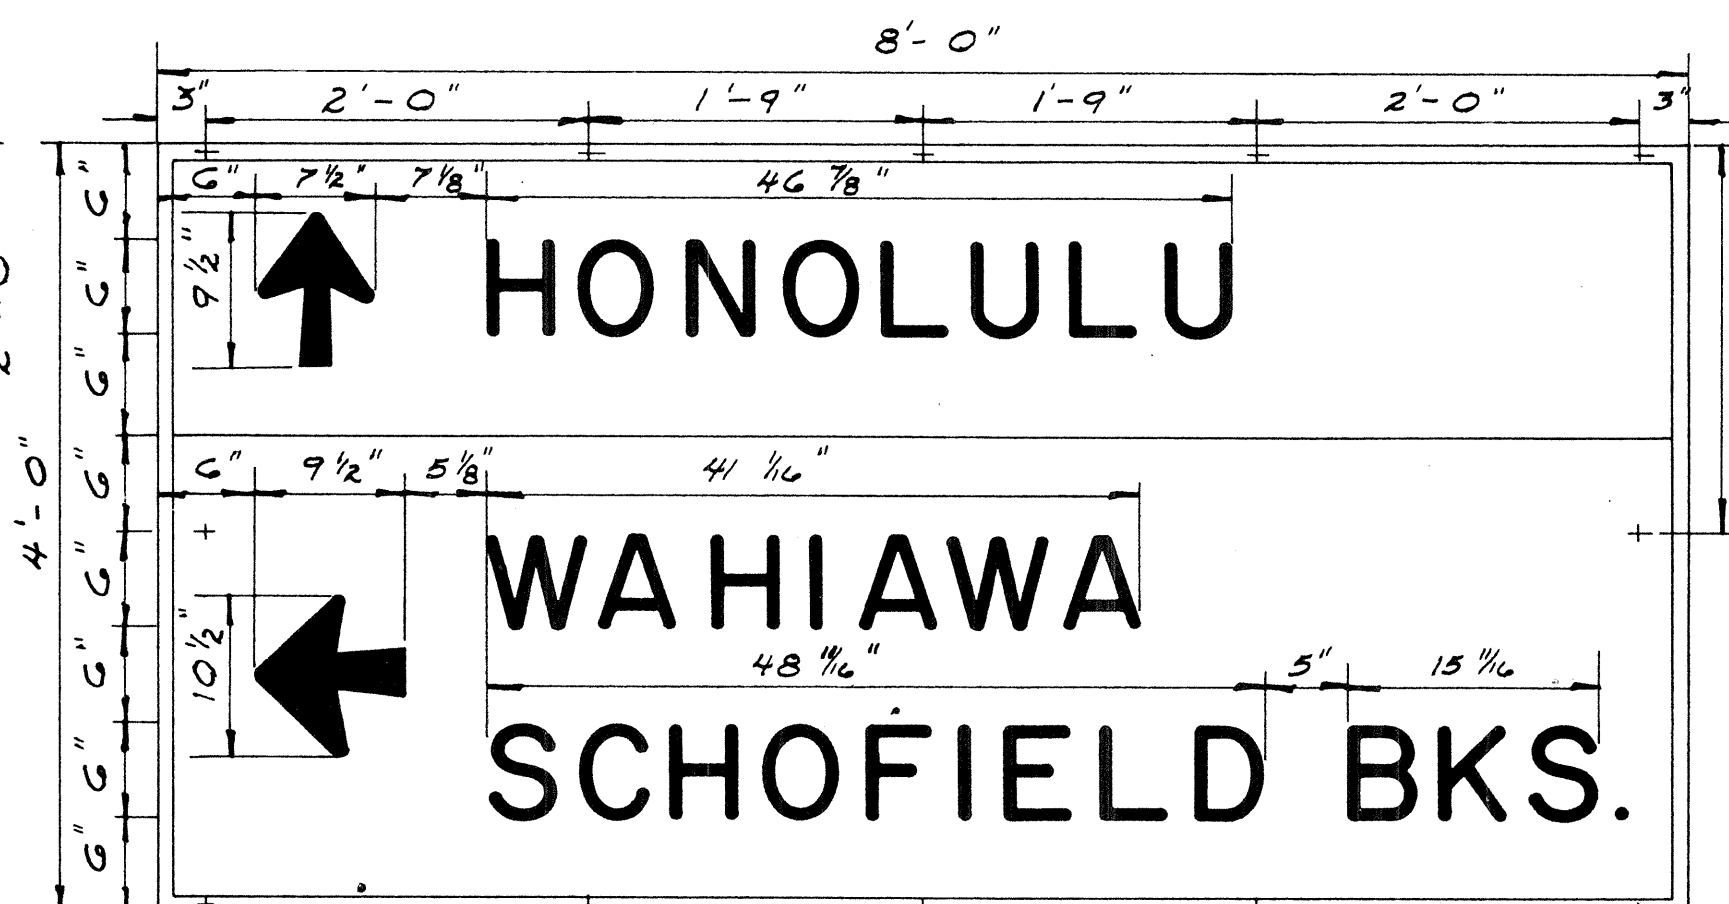


D-32

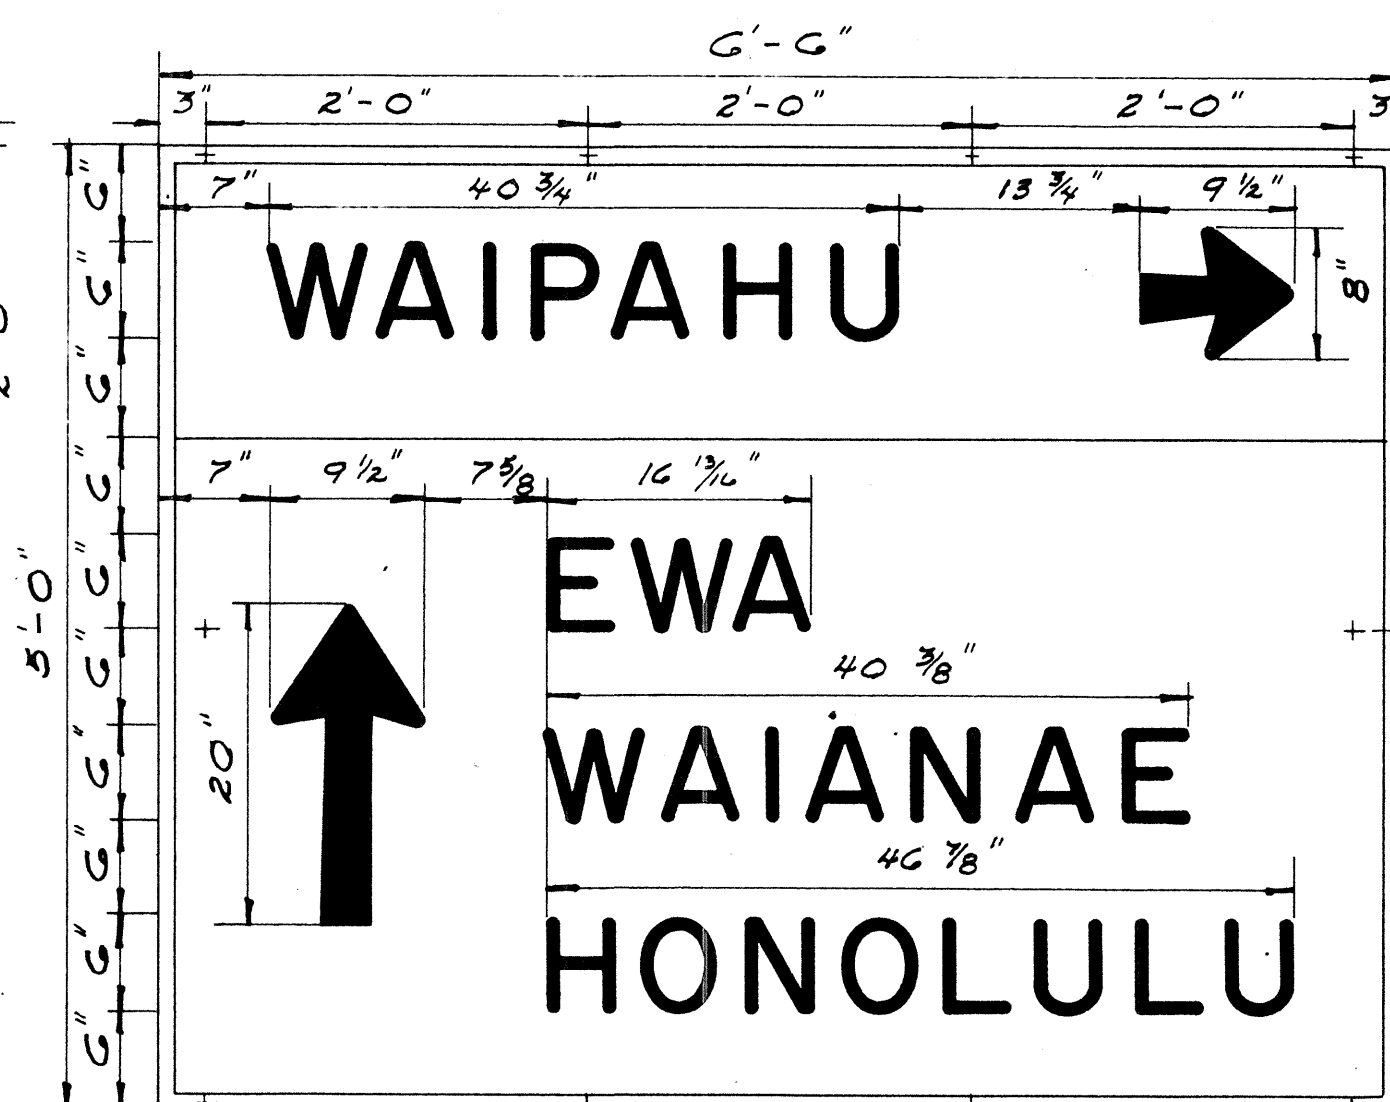


D-33

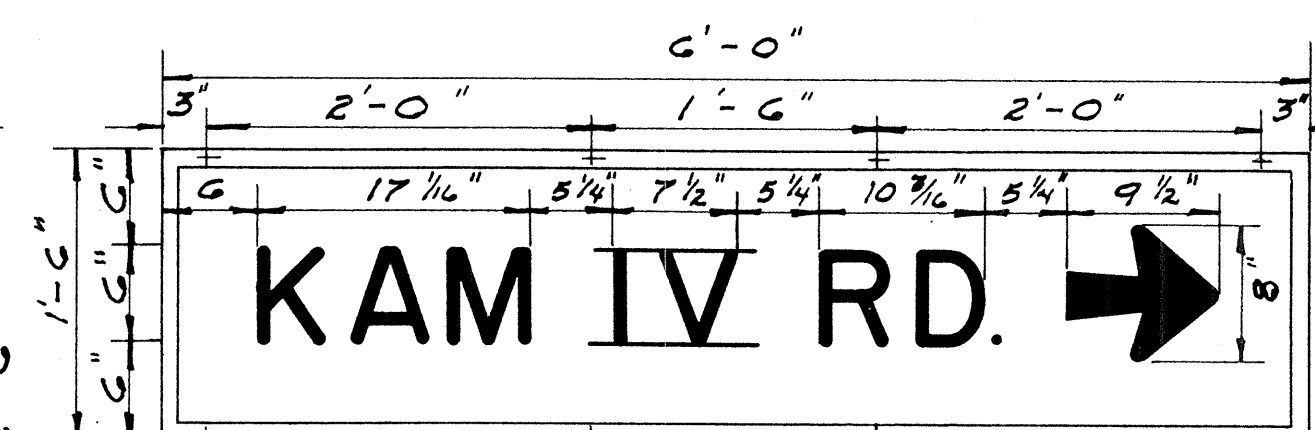


D-34

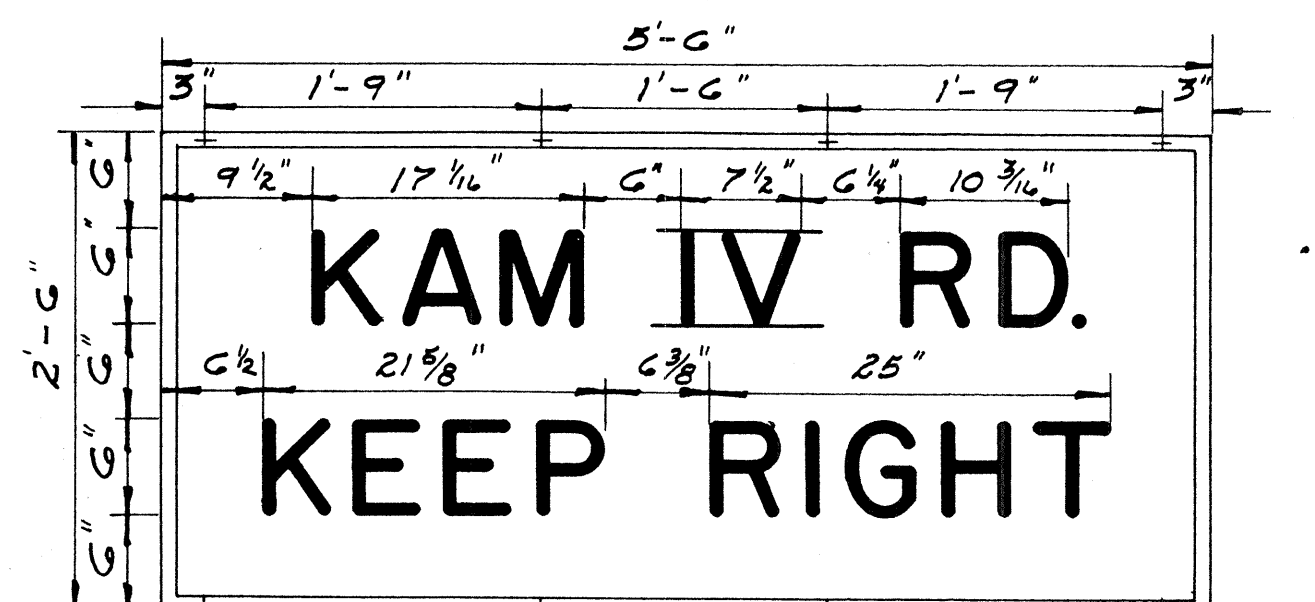


D-35

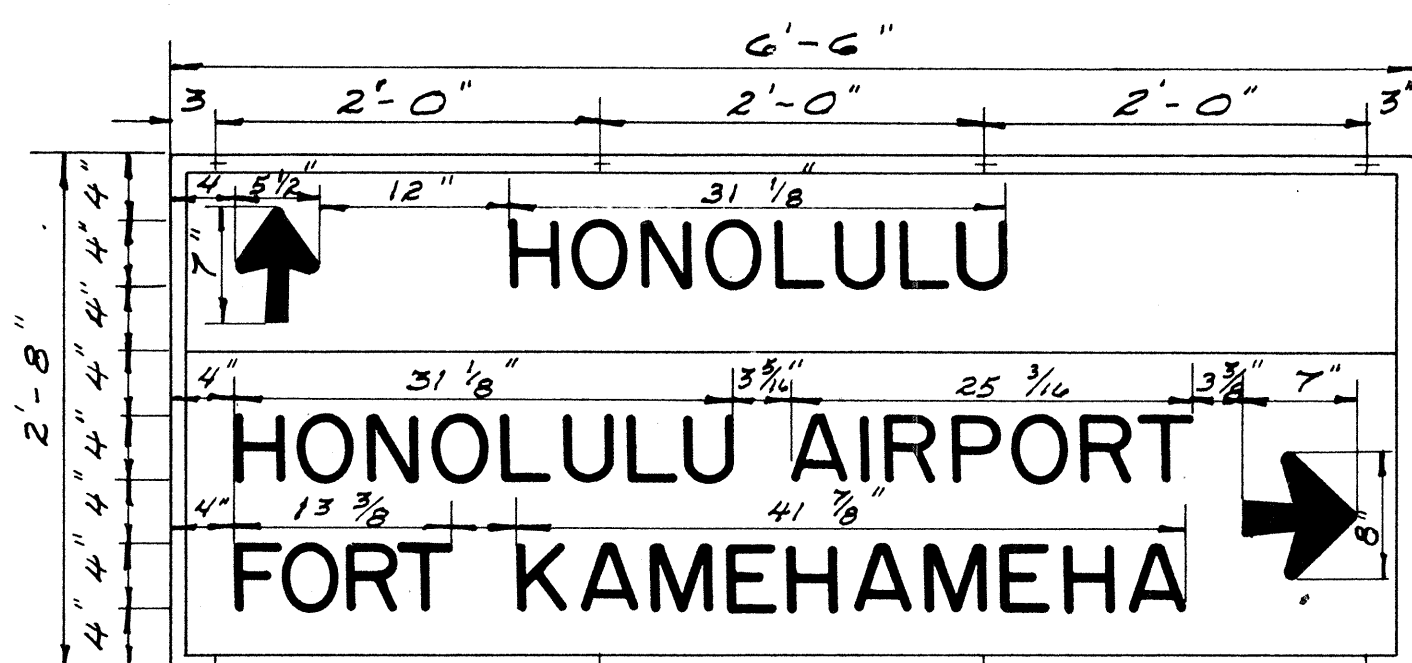


D-36

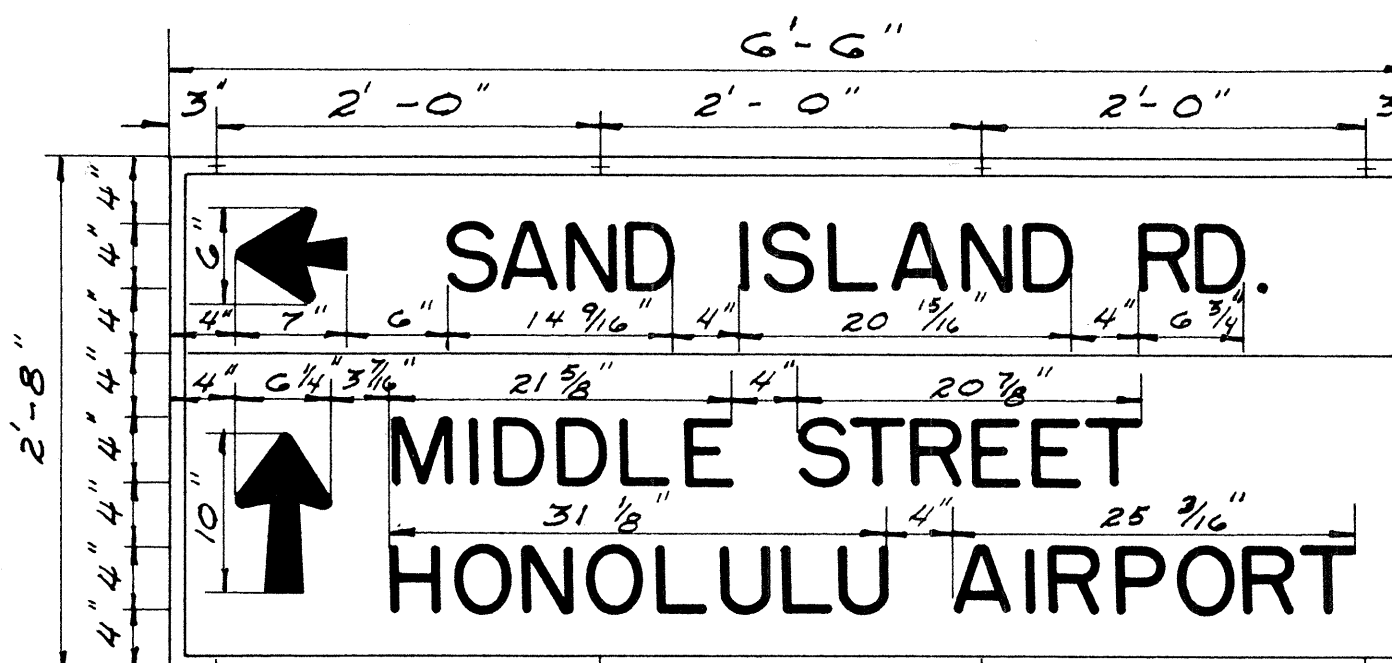


D-37

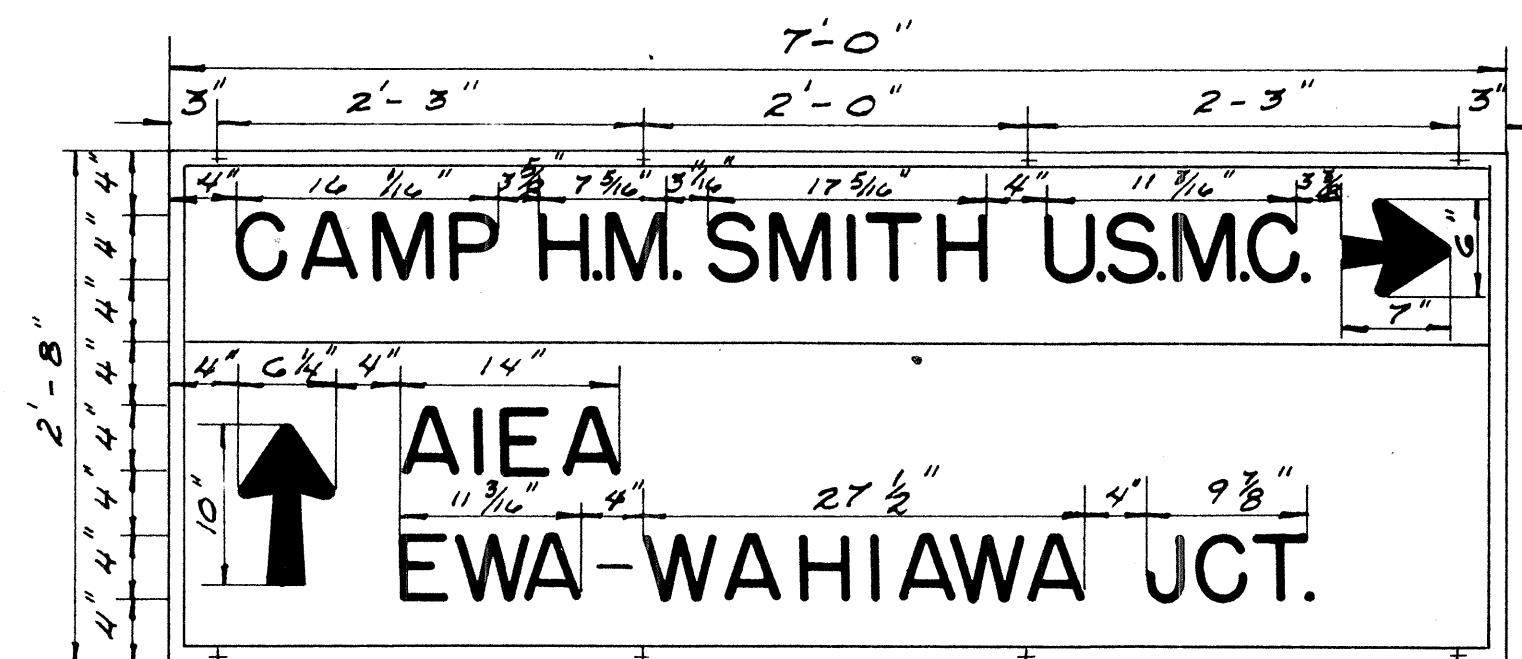


D-38

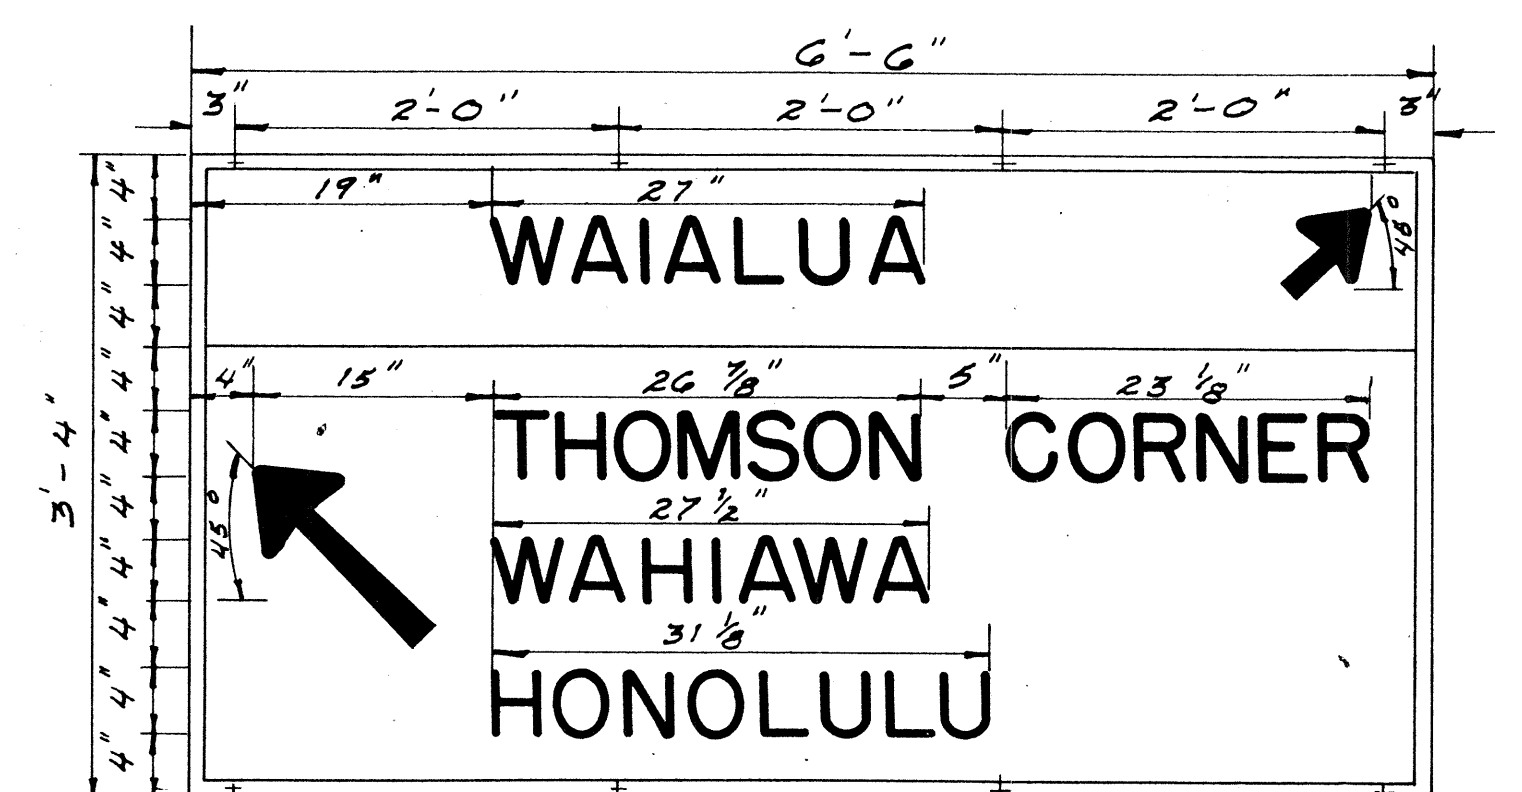


D-39

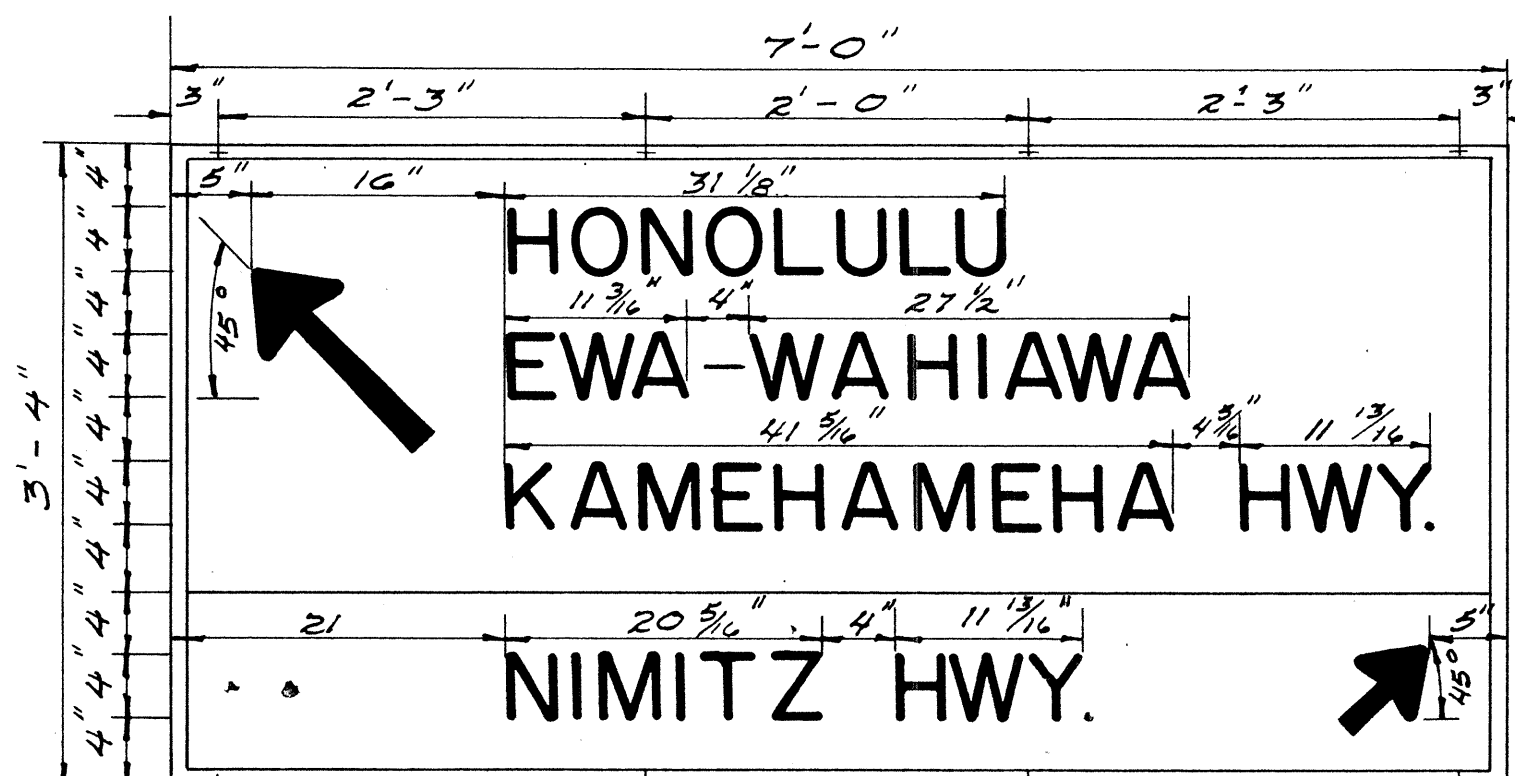

D-40

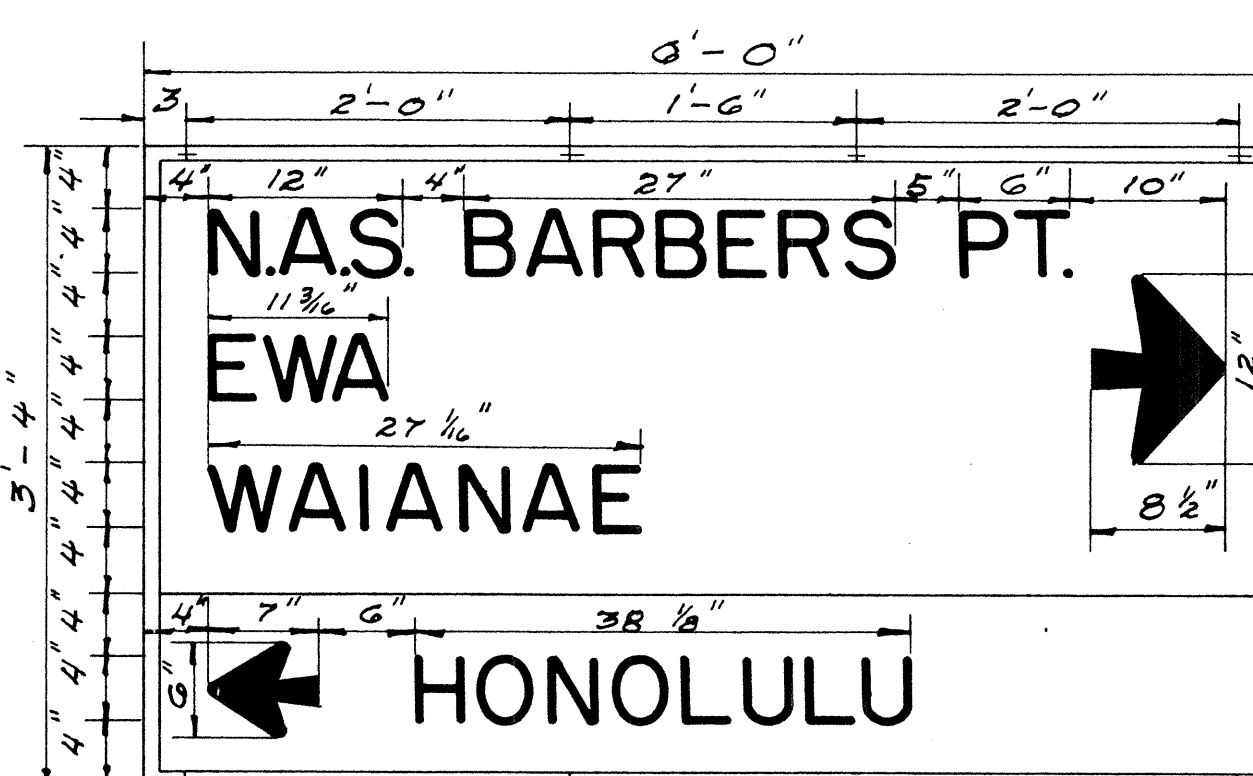

D-41

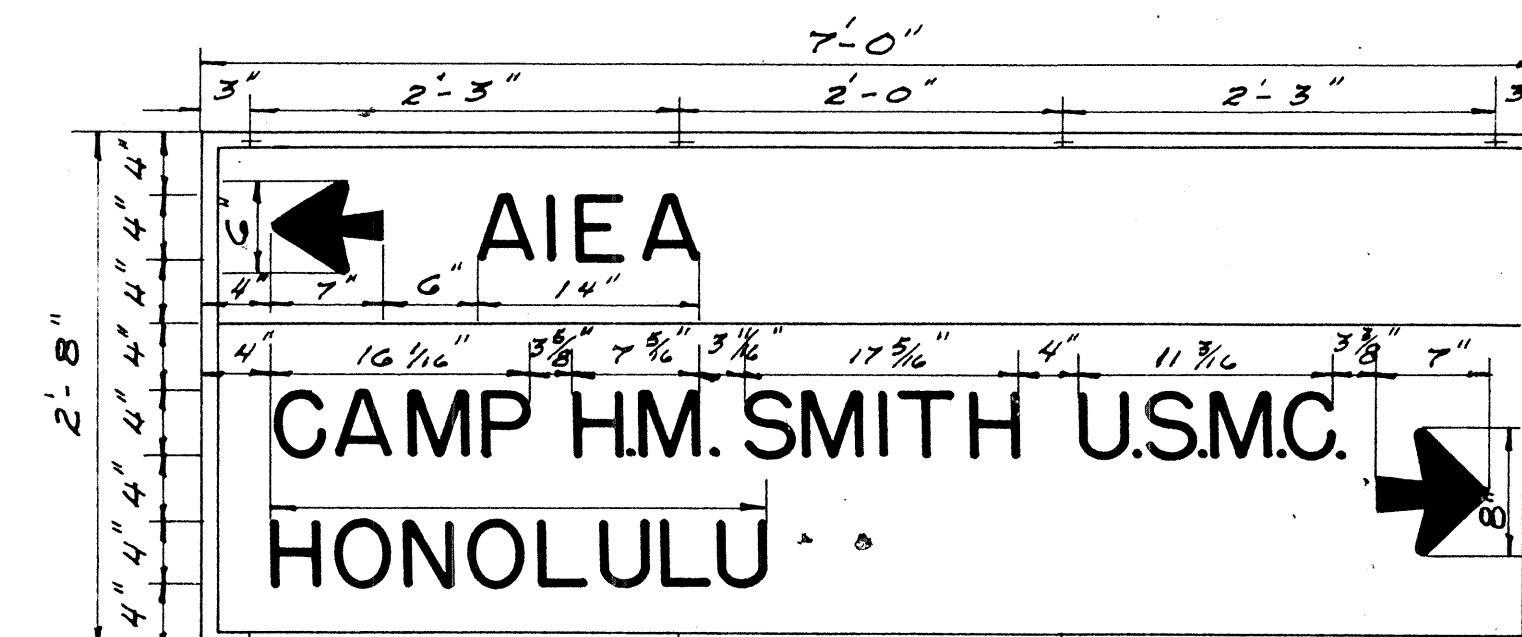


D-42

Note:
142 SS Neoprene Washers Required.


TERRITORIAL HIGHWAY DEPARTMENT
TERRITORY OF HAWAII
**DESTINATION SIGNS
ISLAND OF OAHU**
SCALE: 1" = 1'-0"

SHEET NO. 3 OF 5 SHEETS


DATE: _____
SURVEY PLOTTED BY: _____
ORIGINAL PLAN: _____
DRAWN BY: _____
TRACED BY: _____
NOTE BOOK: _____
QUANTITIES CHECKED BY: _____
No. _____

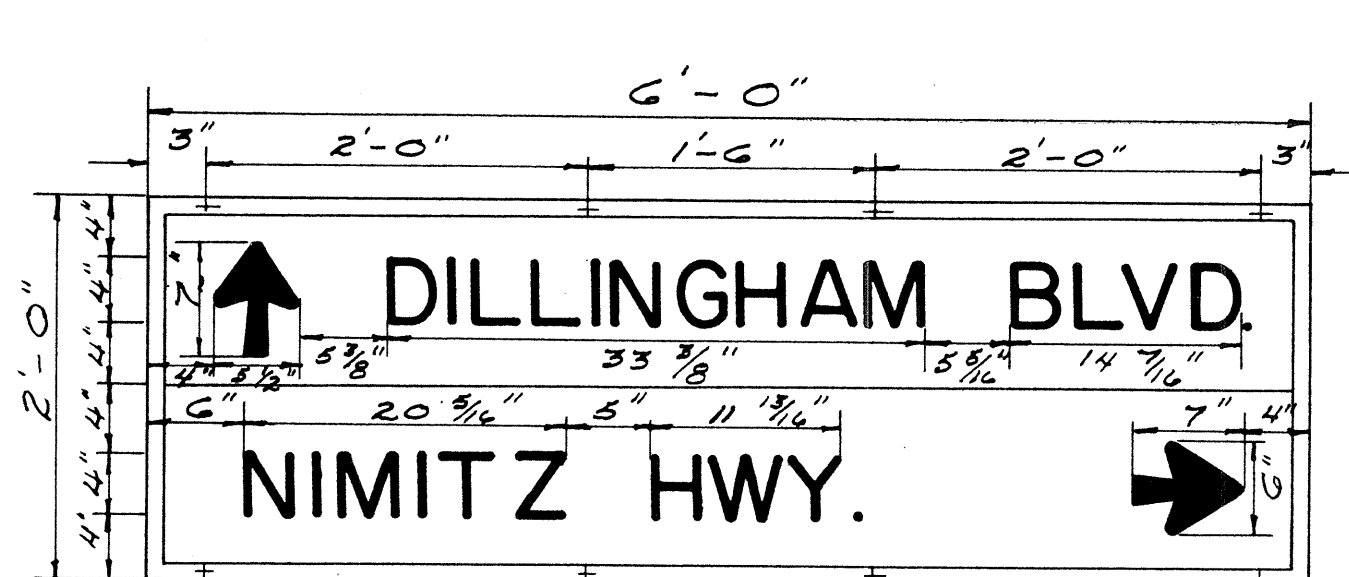


D-43

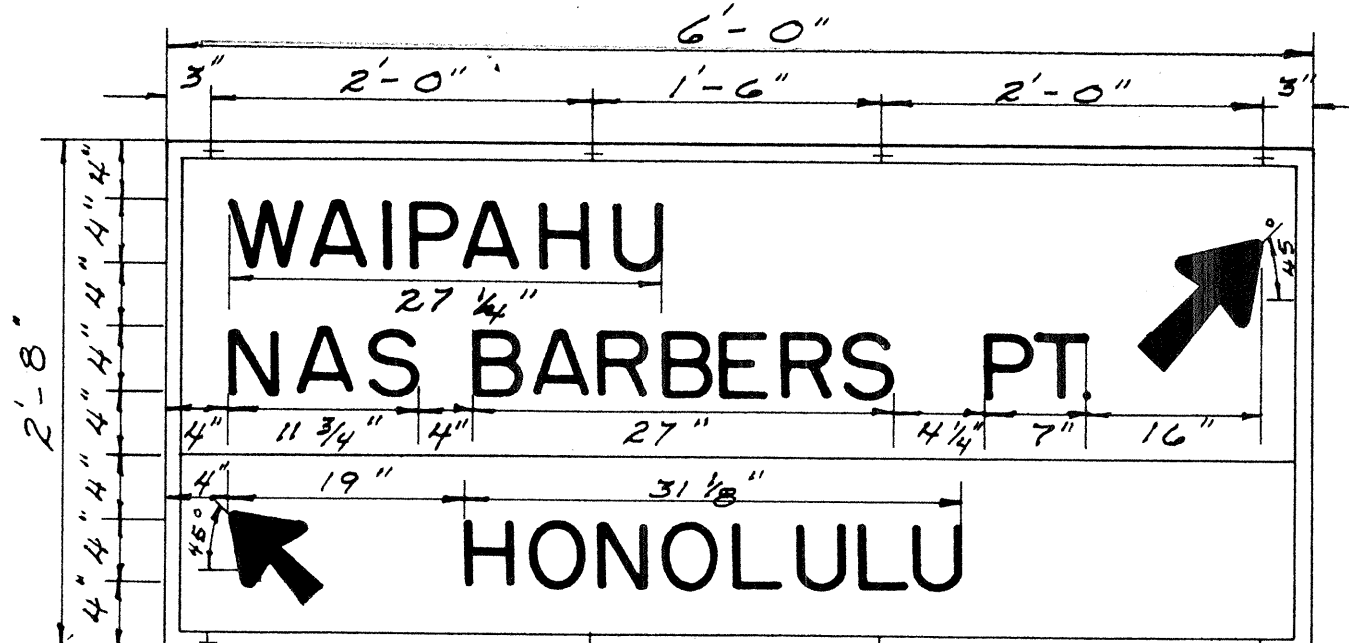


D-44

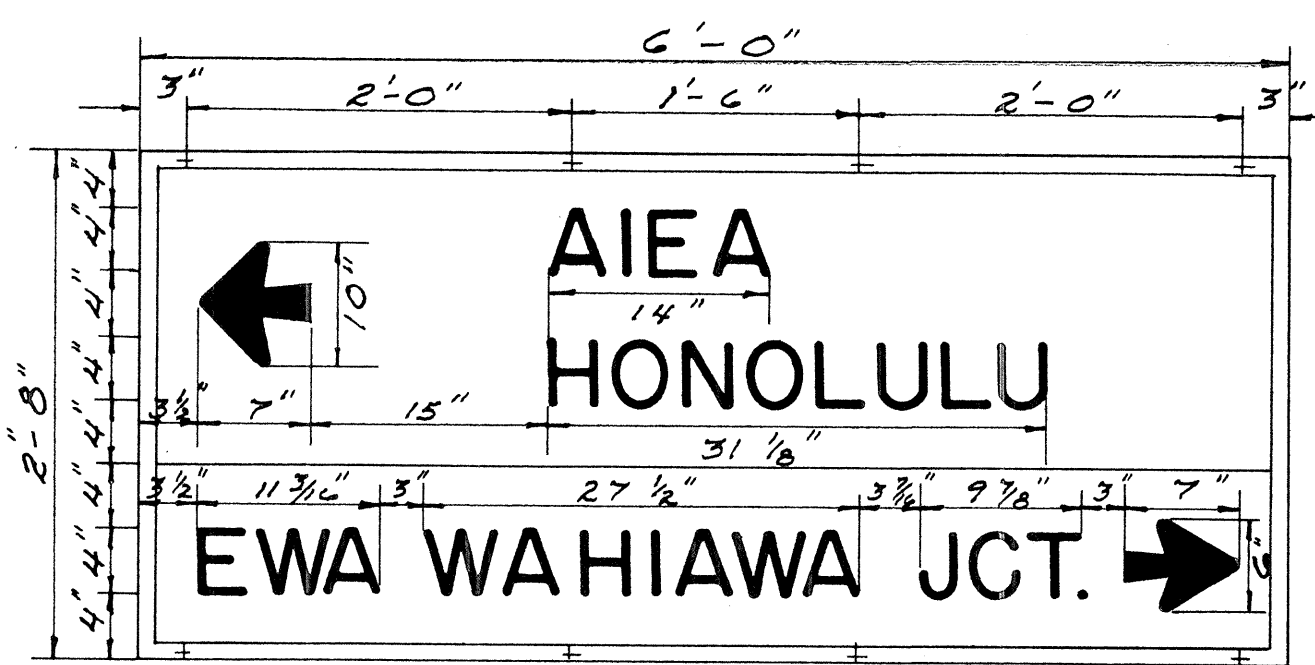


D-45

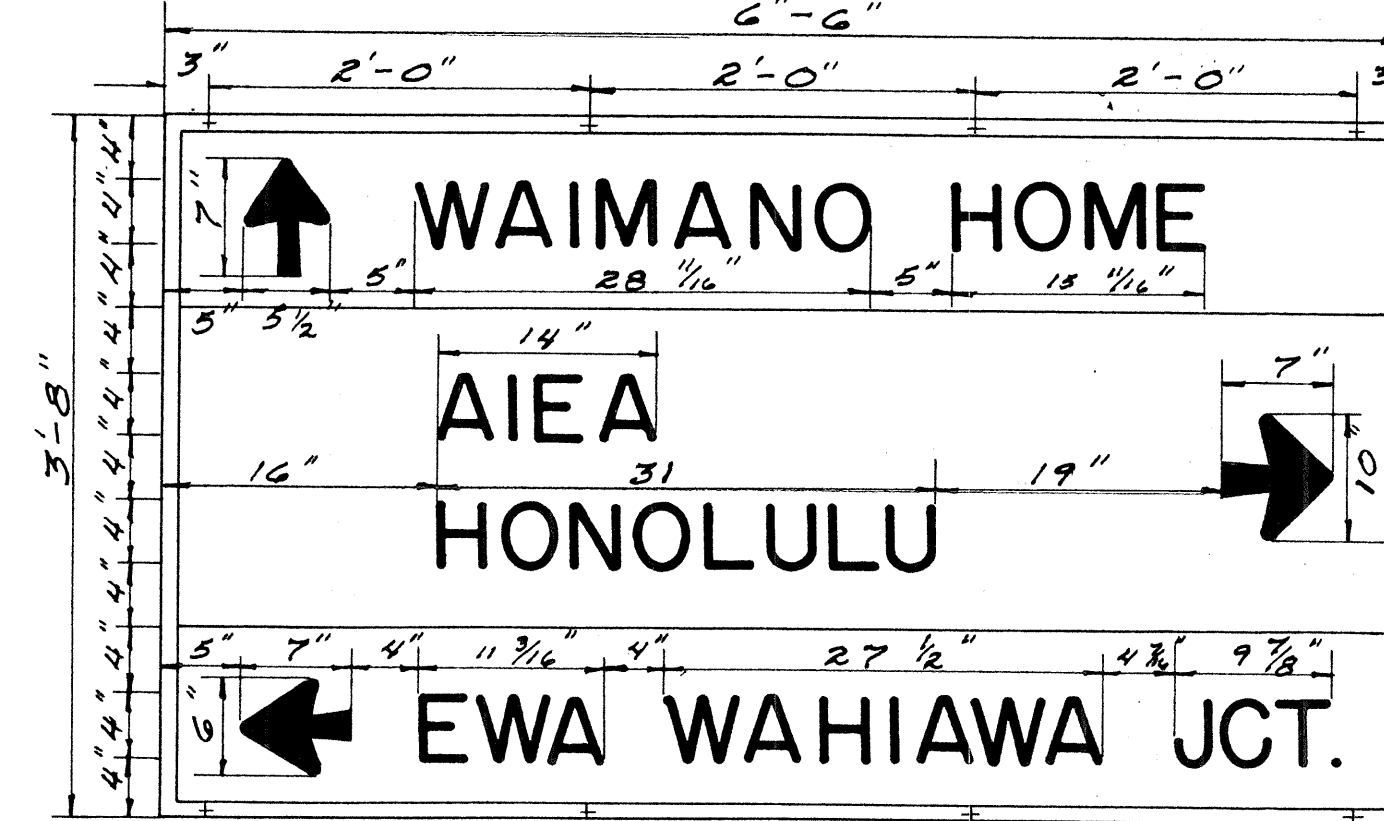


D-46

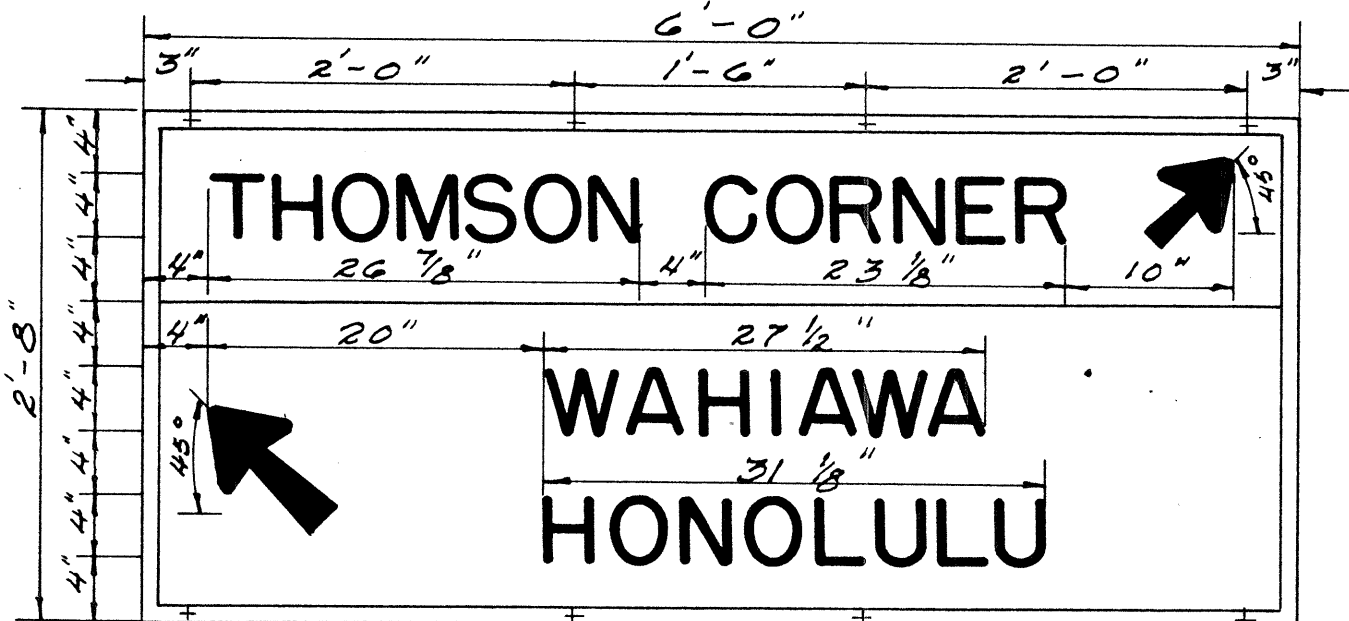


D-47

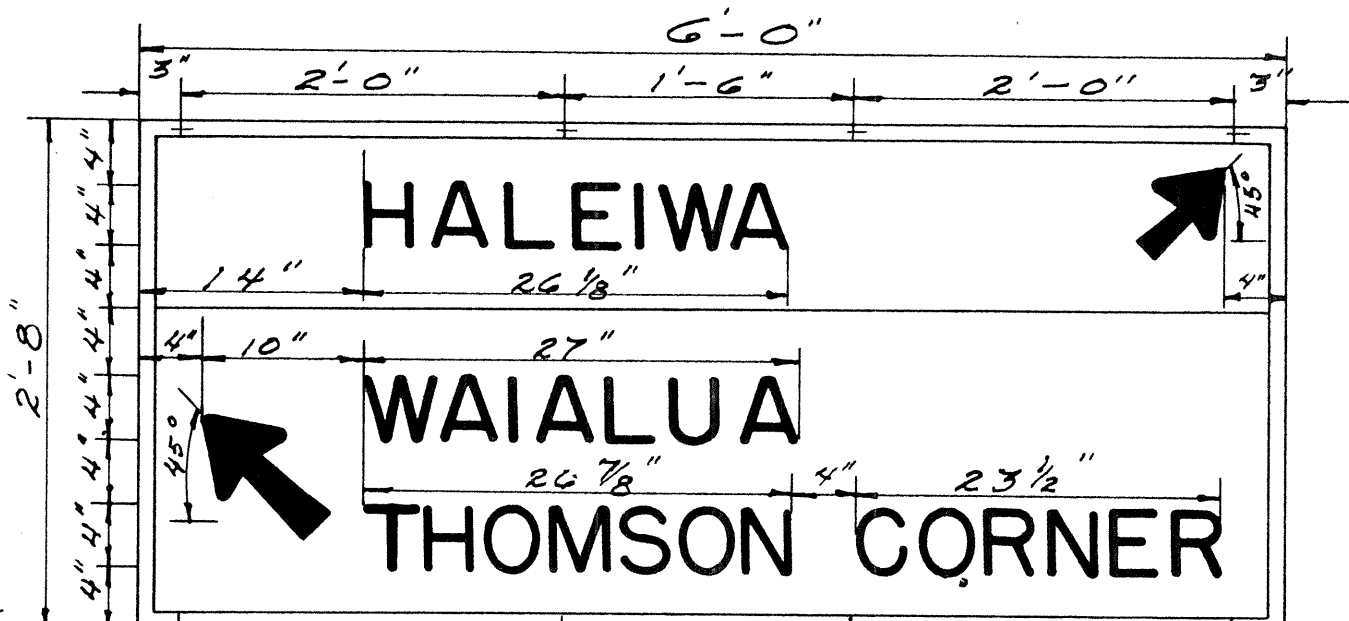


D-48

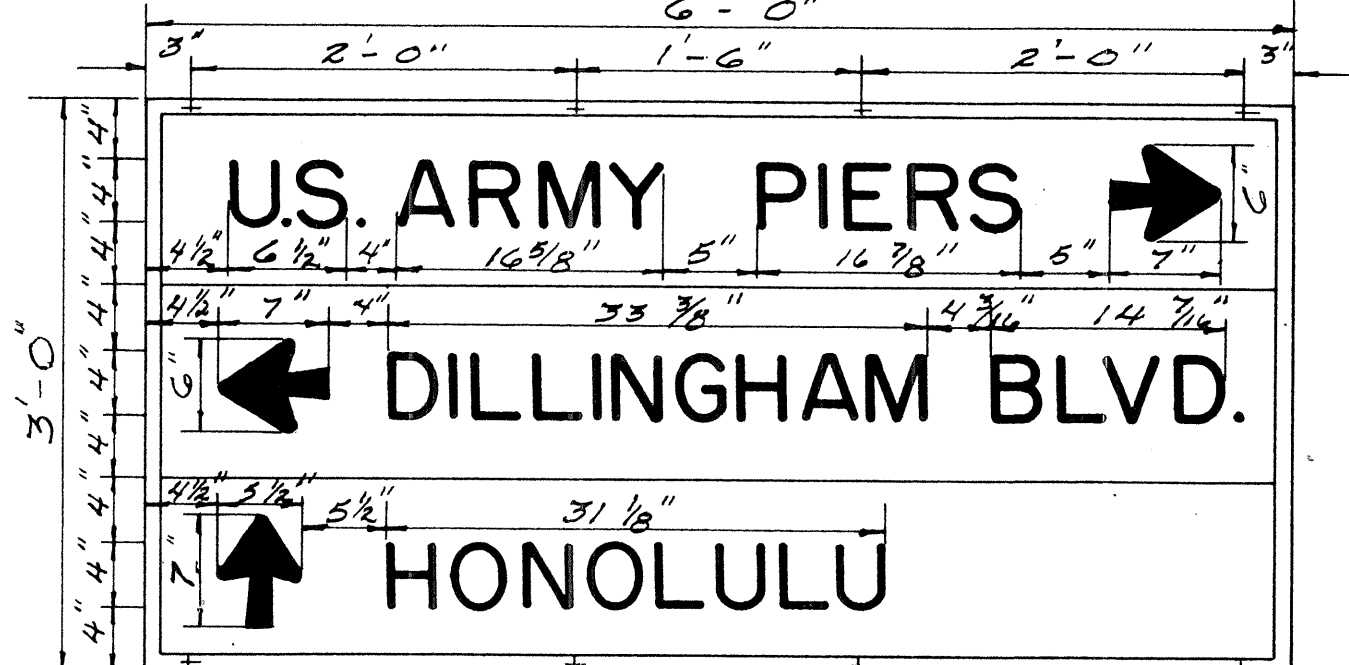


D-49

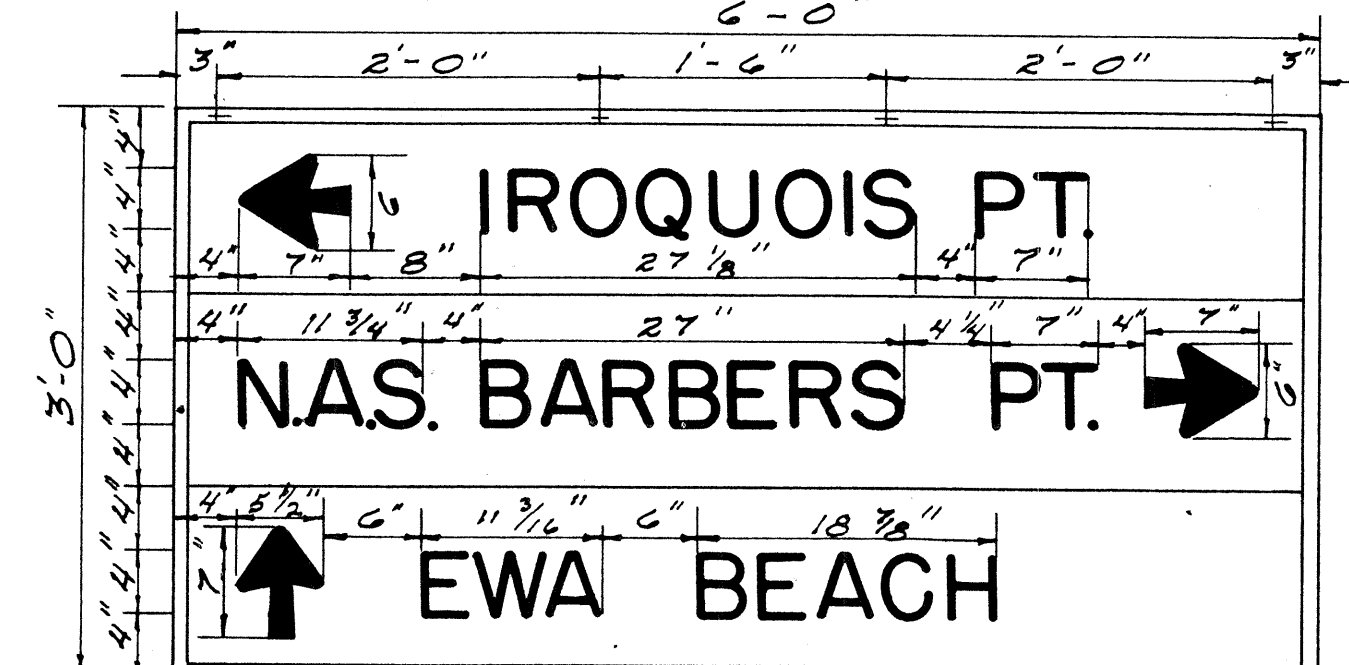


D-50

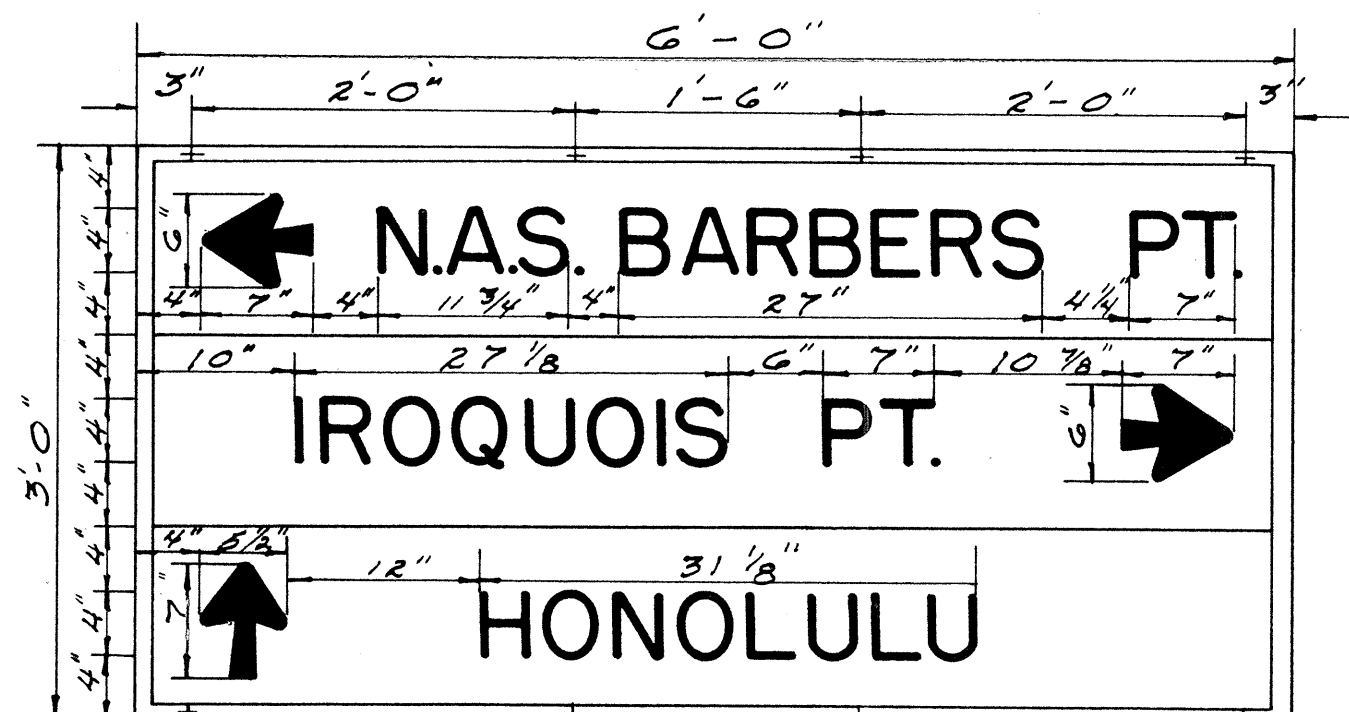


D-51

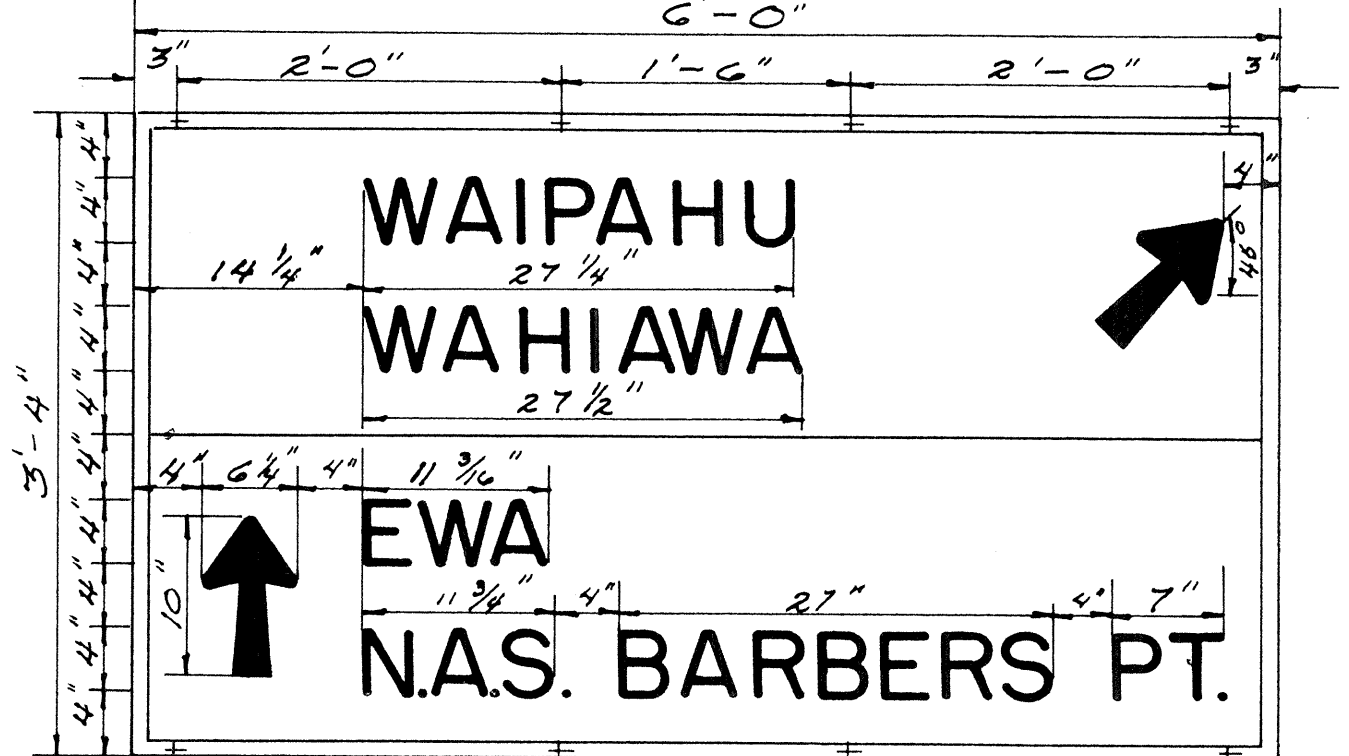


D-52

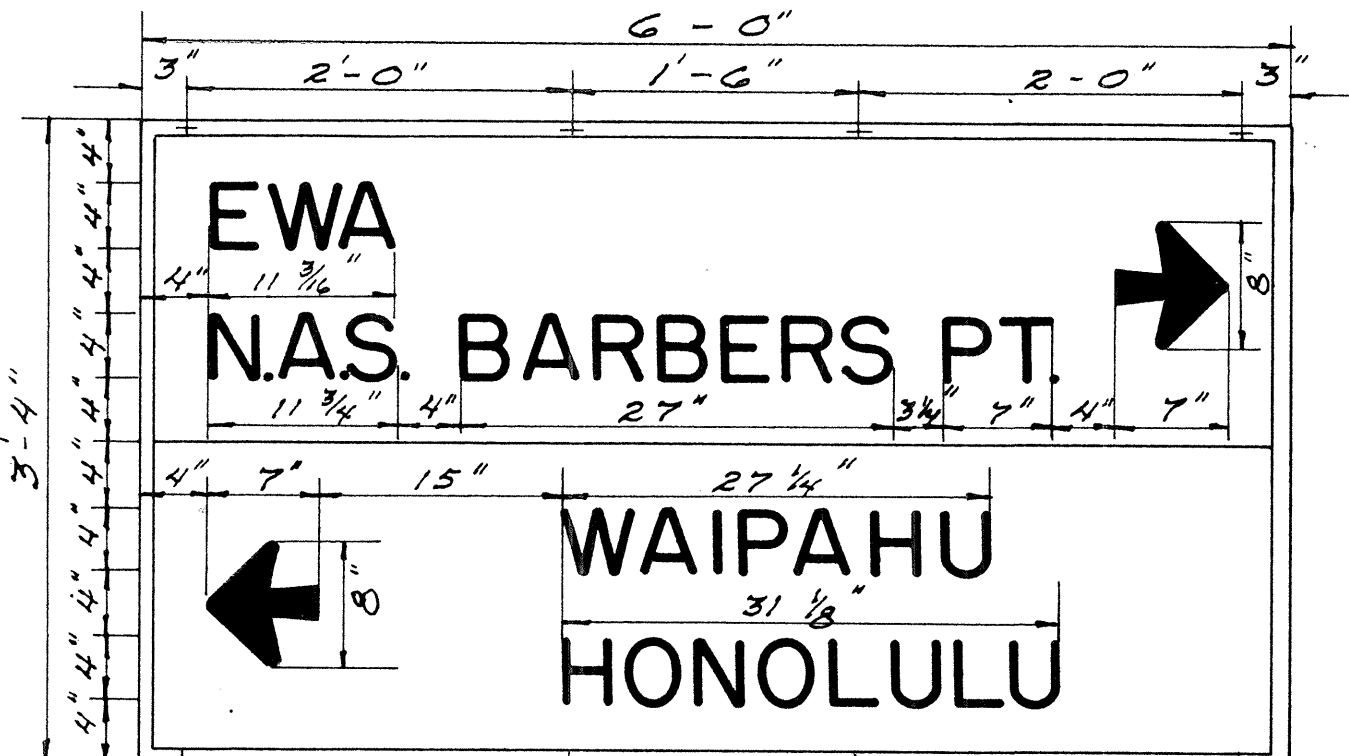


D-53

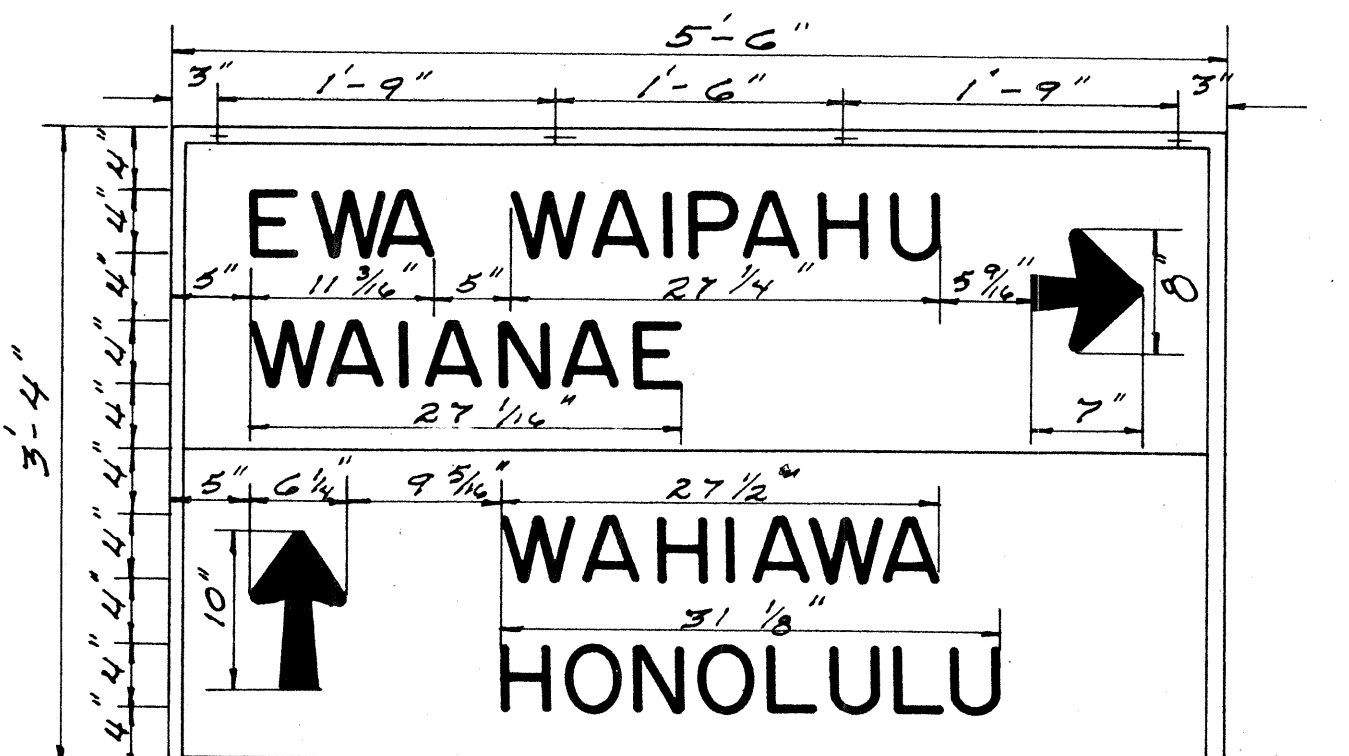


D-54

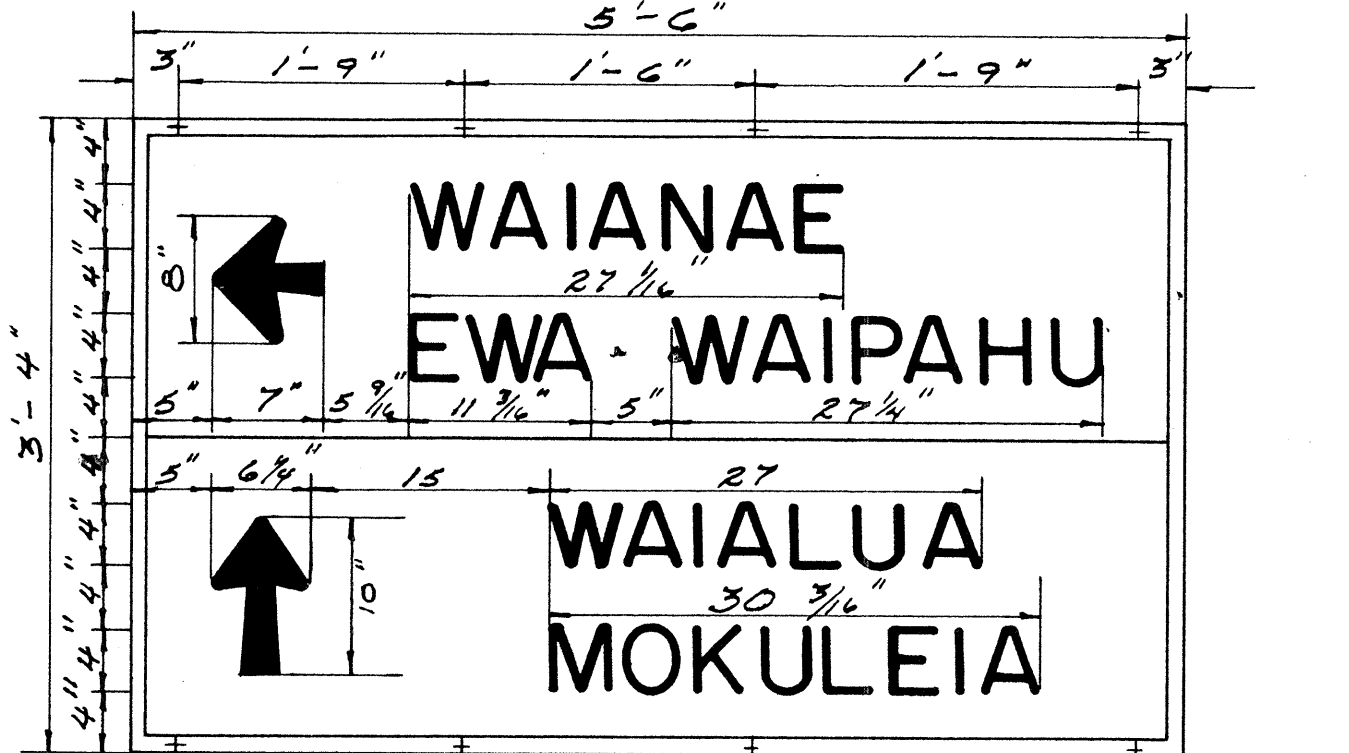

D-55

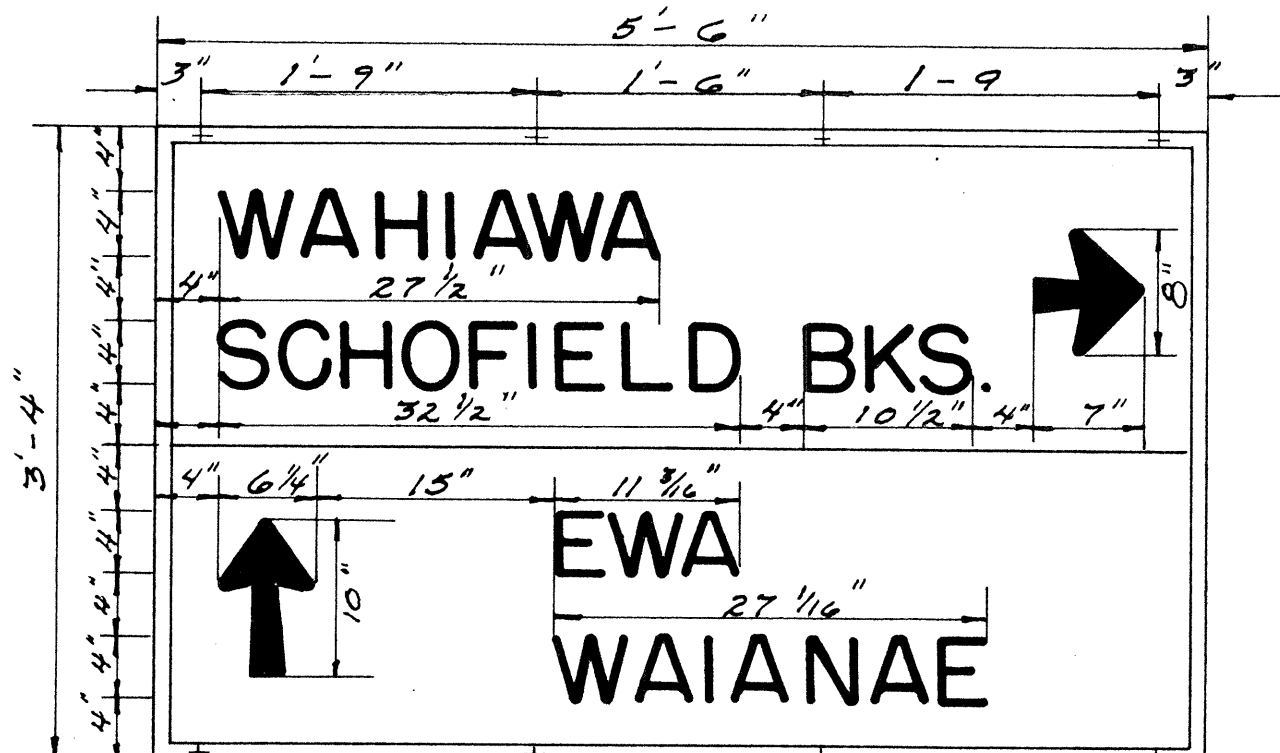

D-56

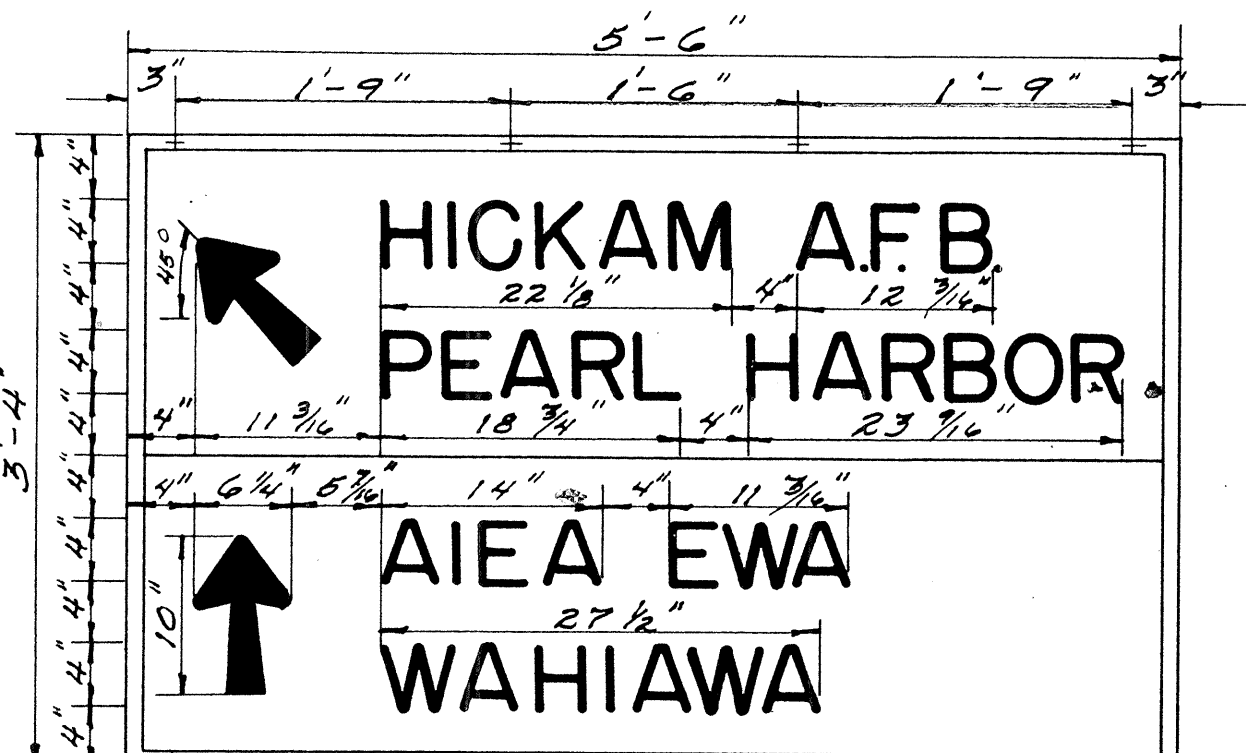

D-57

TERRITORIAL HIGHWAY DEPARTMENT
TERRITORY OF HAWAII



**DESTINATION SIGNS
ISLAND OF OAHU**

SCALE: 1" = 1'-0"

Note:
120 SS Neoprene
Washers Required.

ORIGINAL PLAN	SURVEY PLOTTED BY	DATE
	DESIGNED BY	
	DRAWN BY	
	QUANTITIES BY	
NOTE BOOK	QUANTITIES CHECKED BY	
	CHECKED BY	
No.		

FED. ROAD DIST. NO.	STATE	FED. AID PROJ. NO.	FISCAL YEAR	SHEET NO.	TOTAL SHEETS
04H1	HAW.		1960	5	5

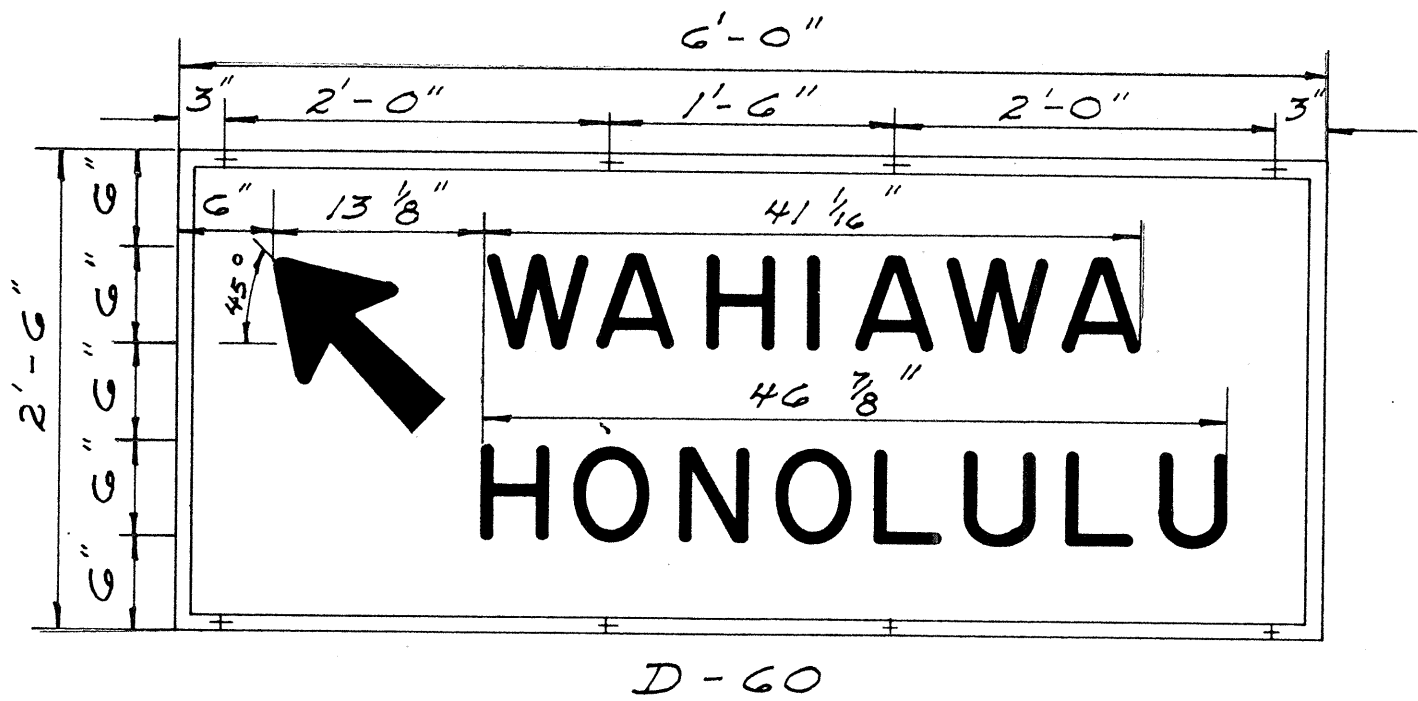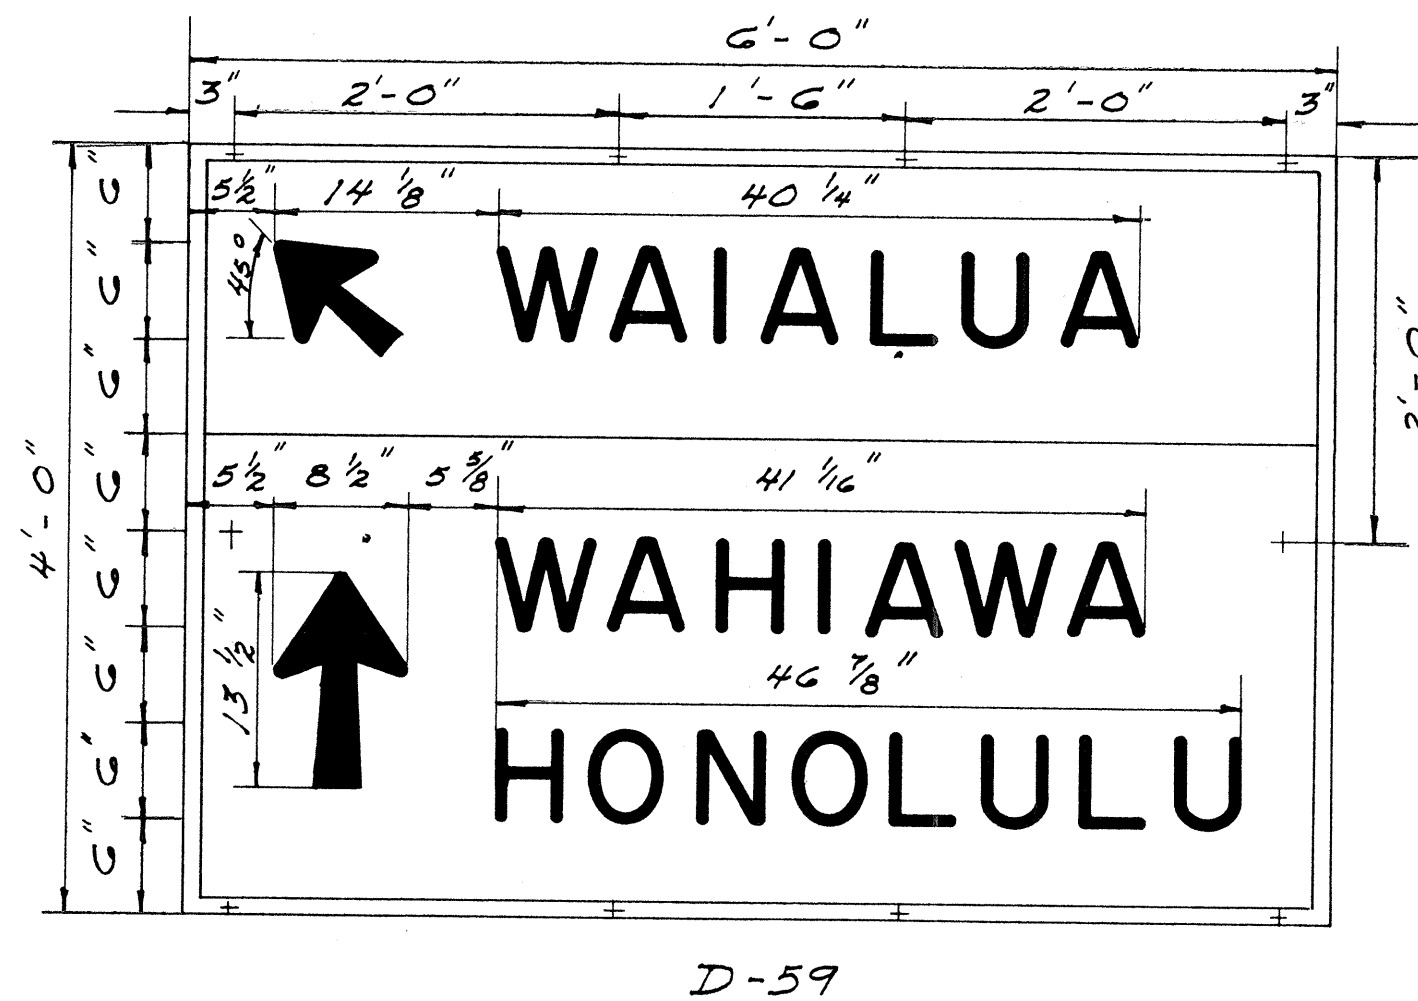

DESIGNED BY	DATE
DRAWN BY	
CHECKED BY	
QUANTITIES CHECKED BY	
NO.	

Note:
30 SS Neoprene
Washers Required.

TERRITORIAL HIGHWAY DEPARTMENT
TERRITORY OF HAWAII

DESTINATION SIGNS
ISLAND OF OAHU
SCALE: 1"= 1'- 0"