
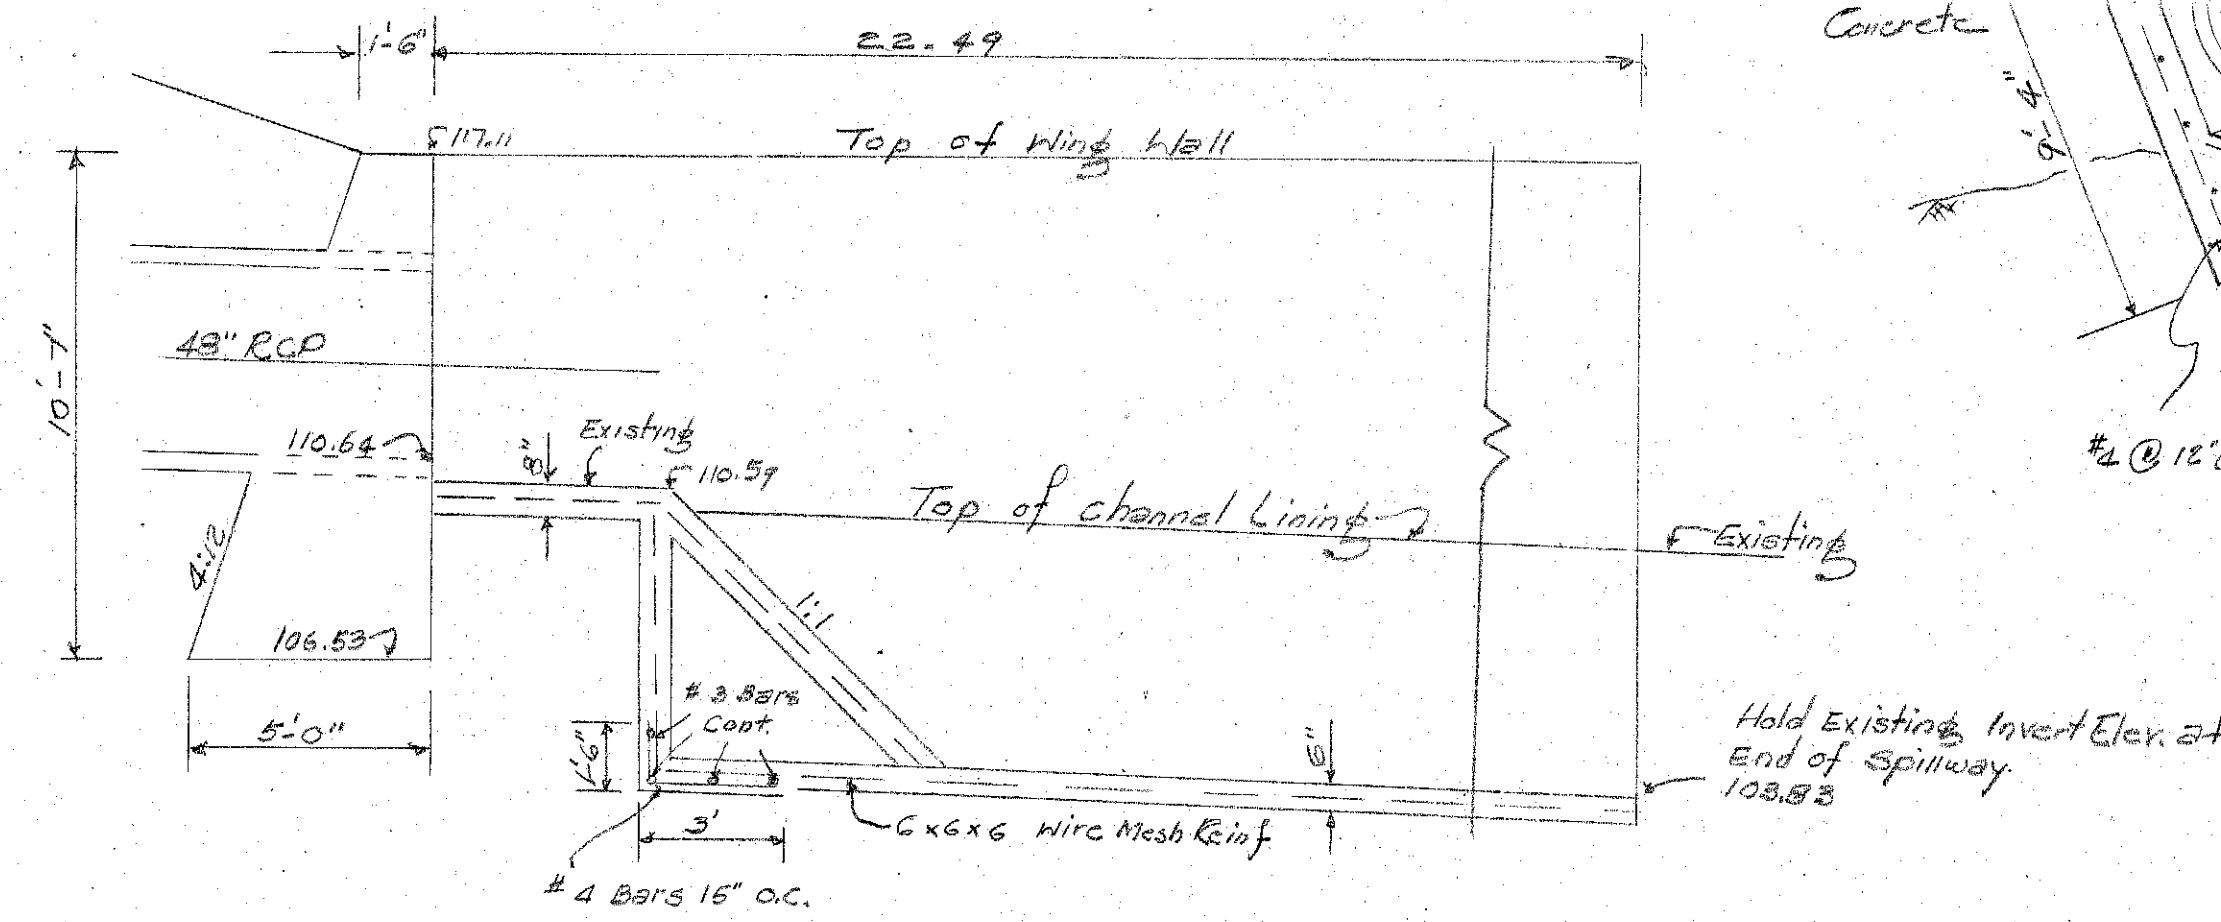
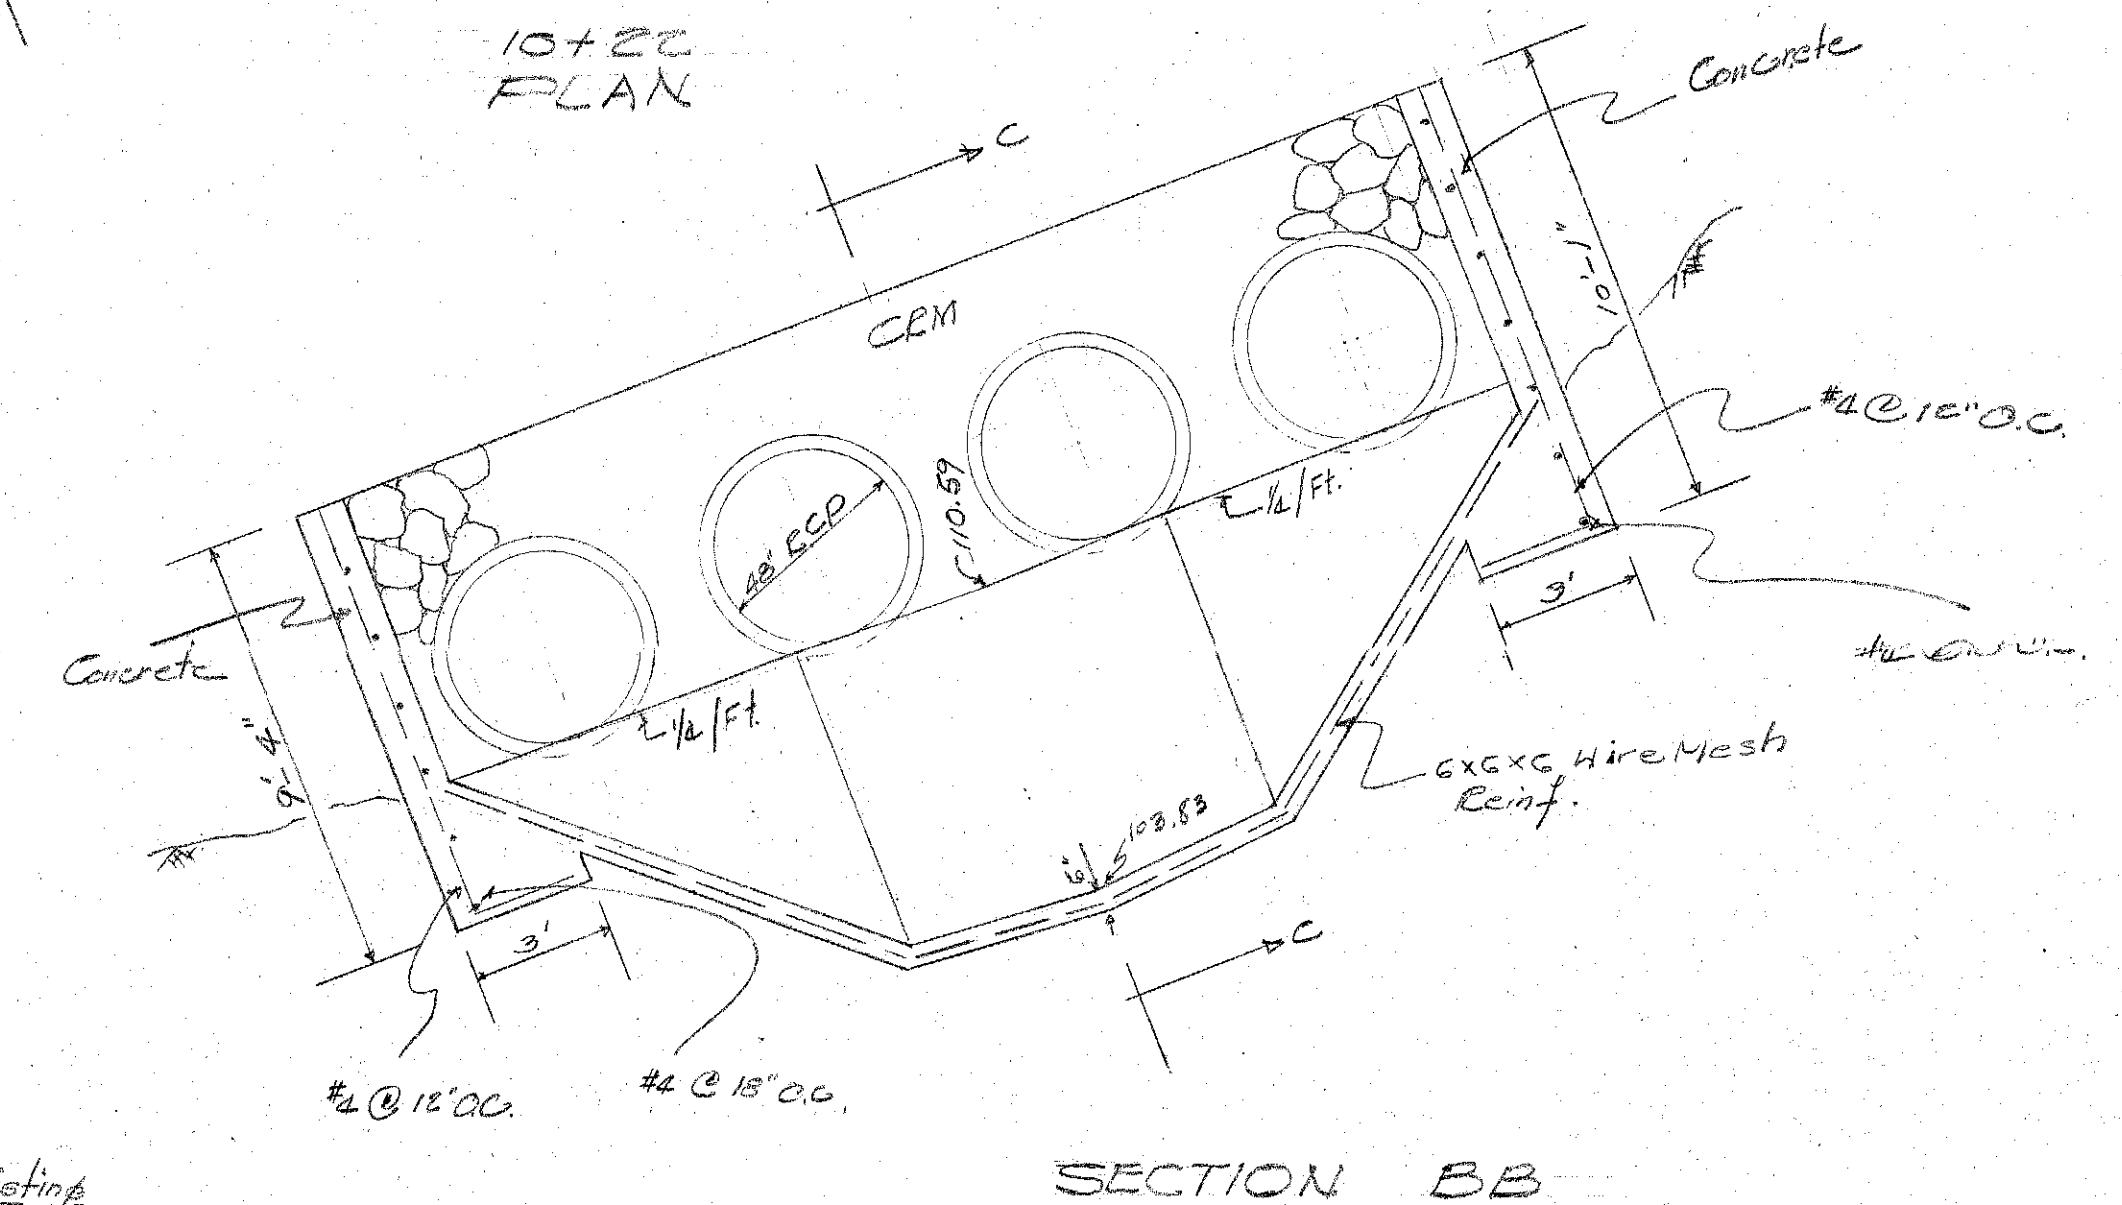
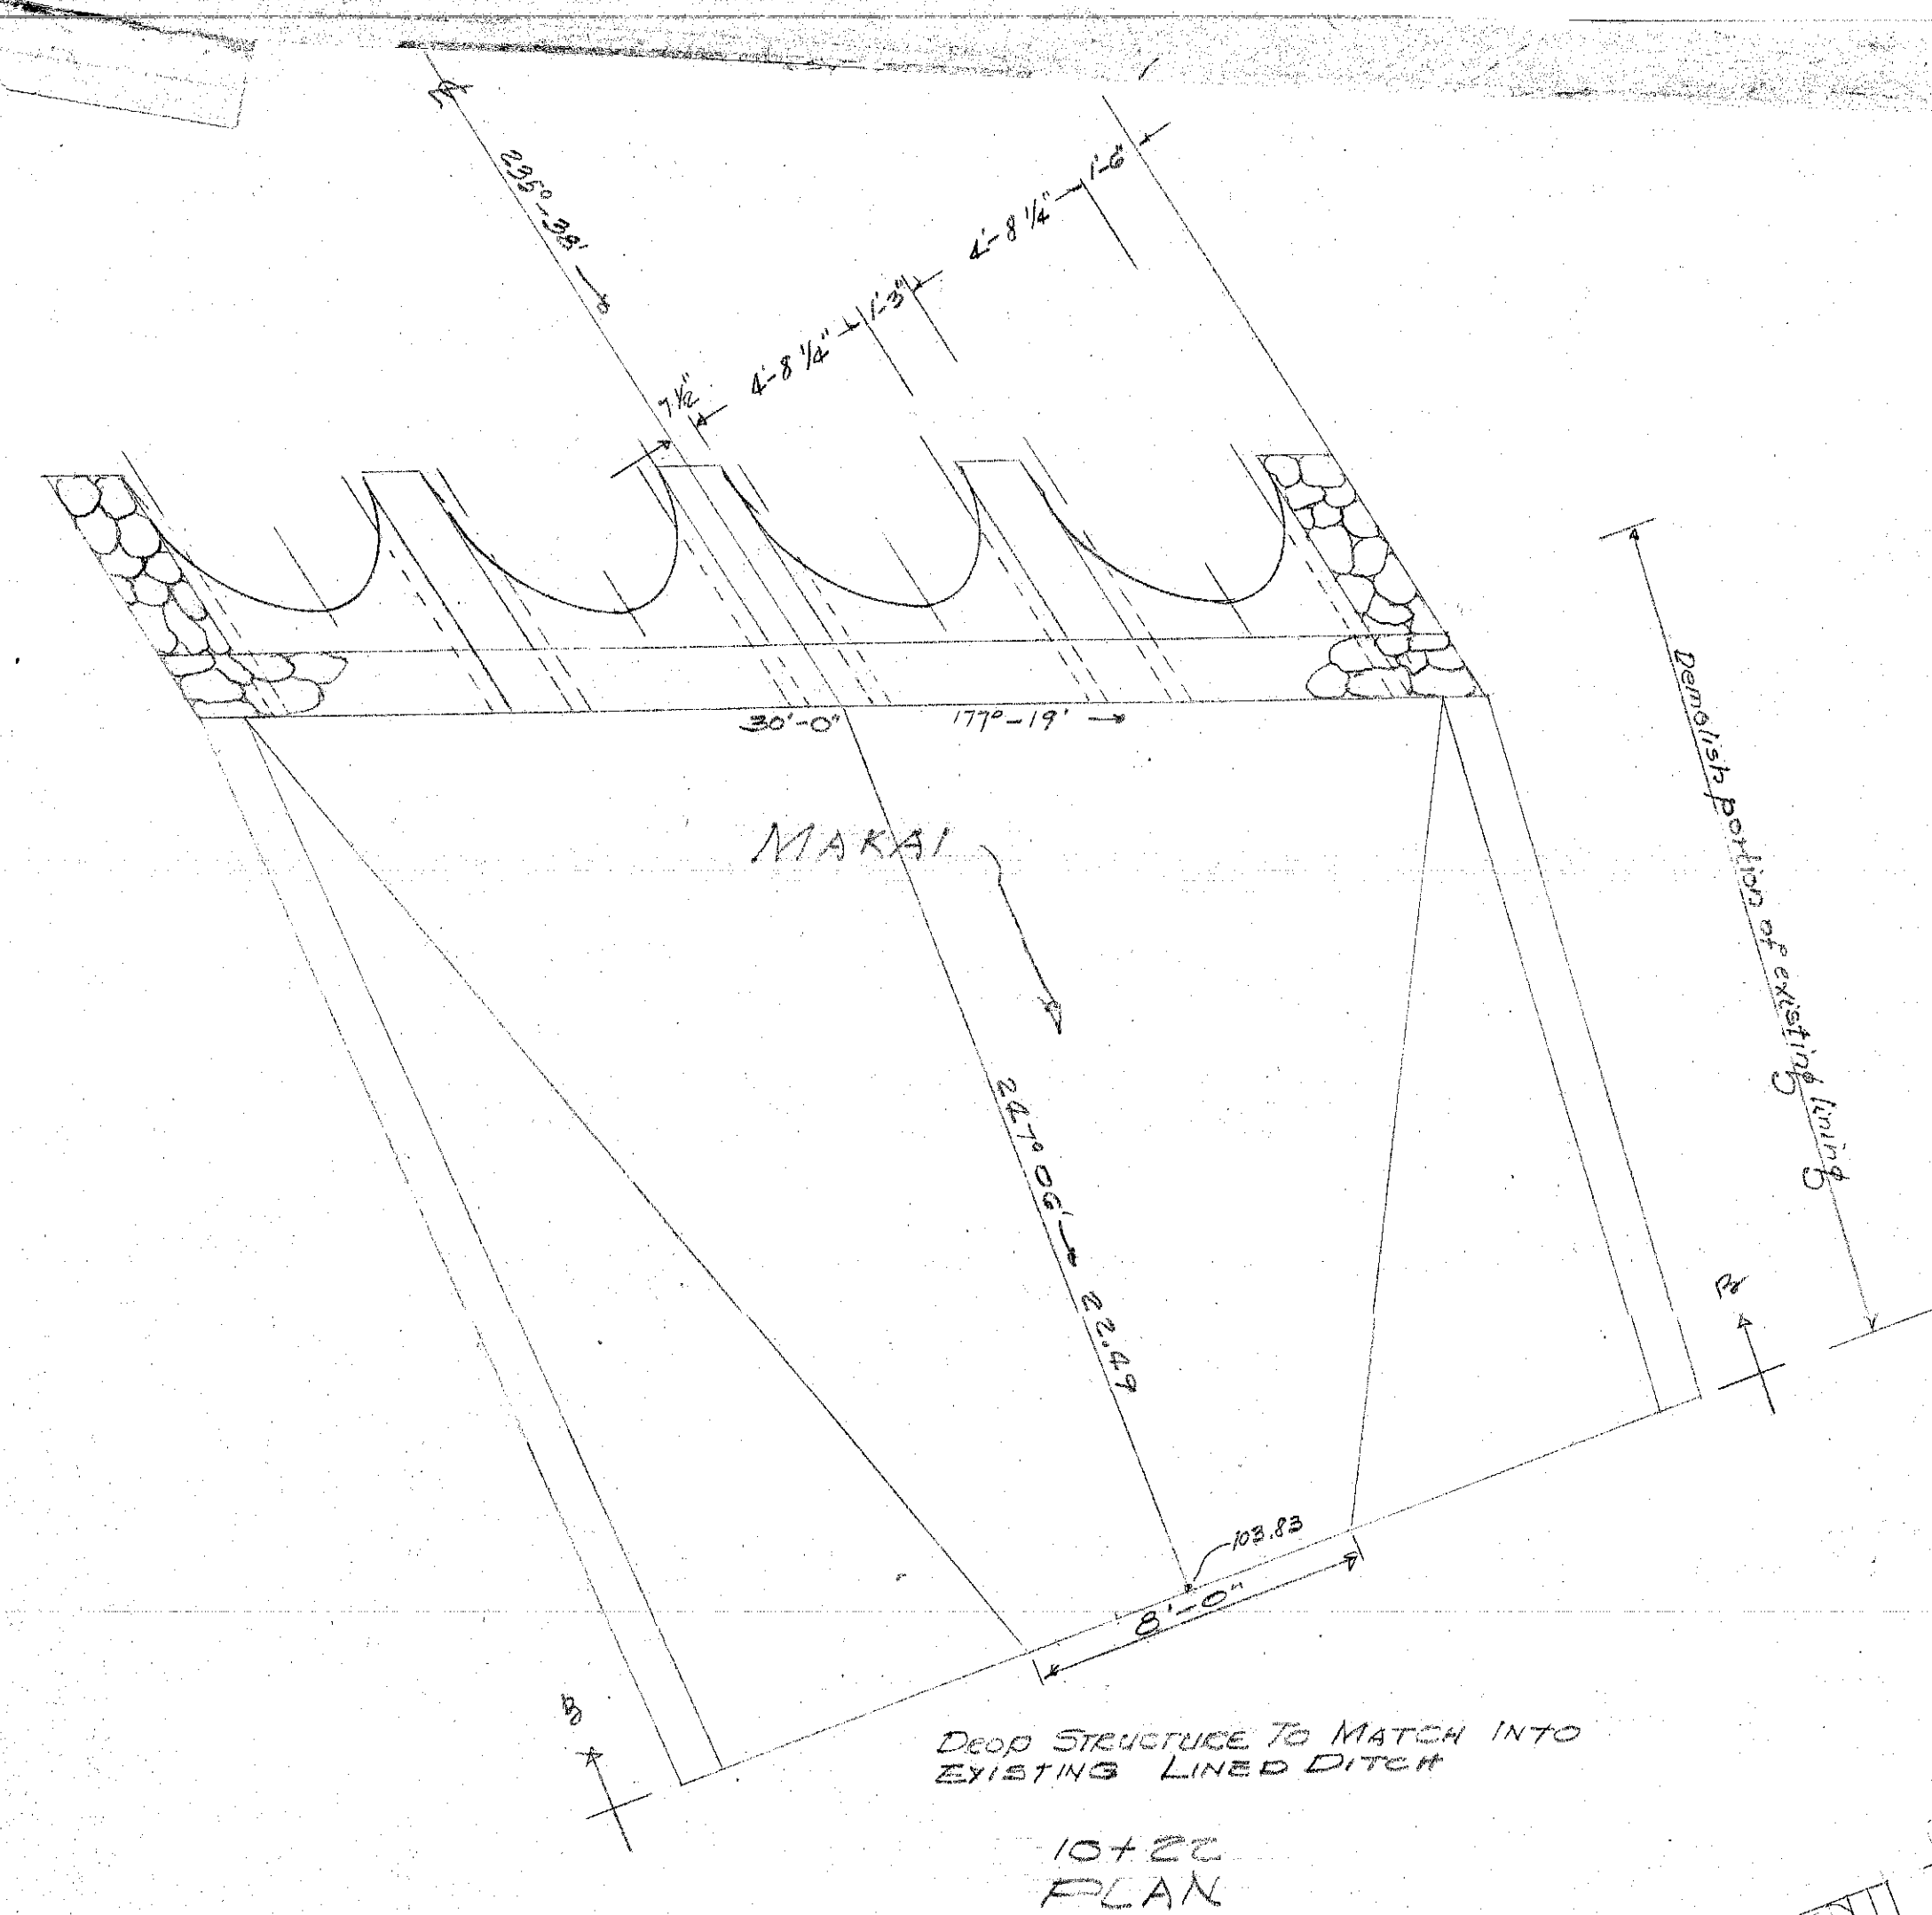
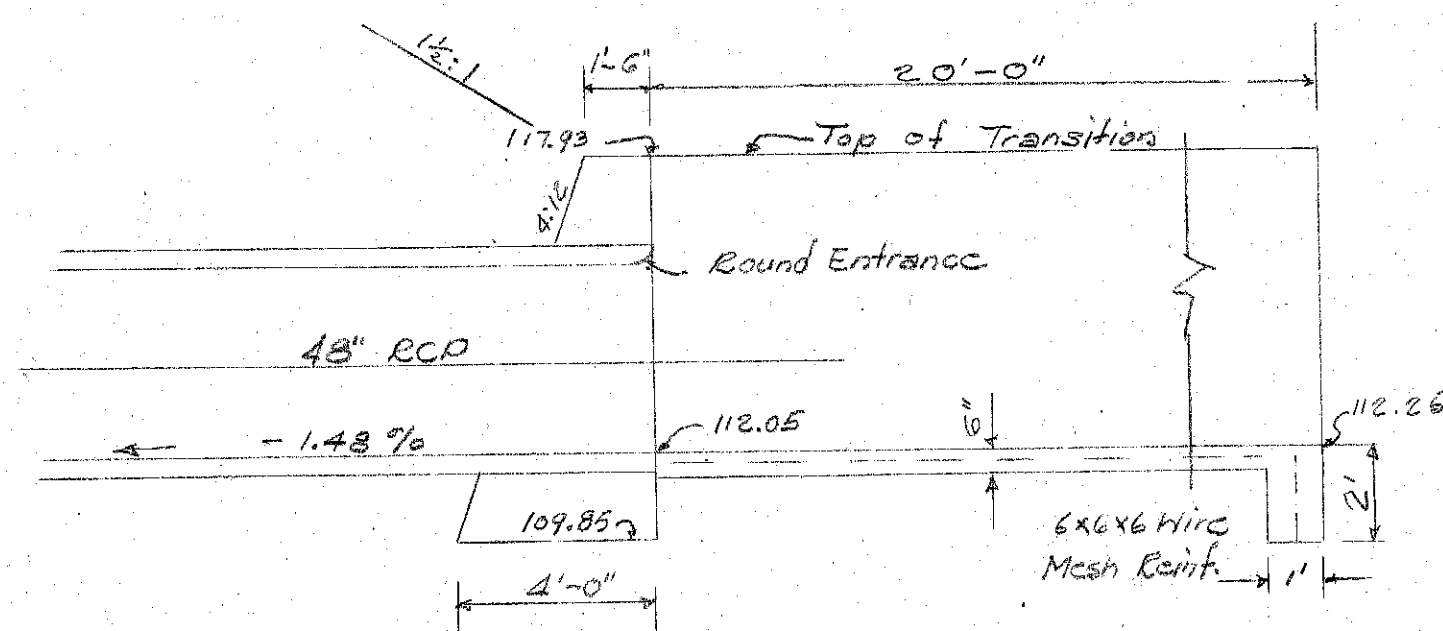
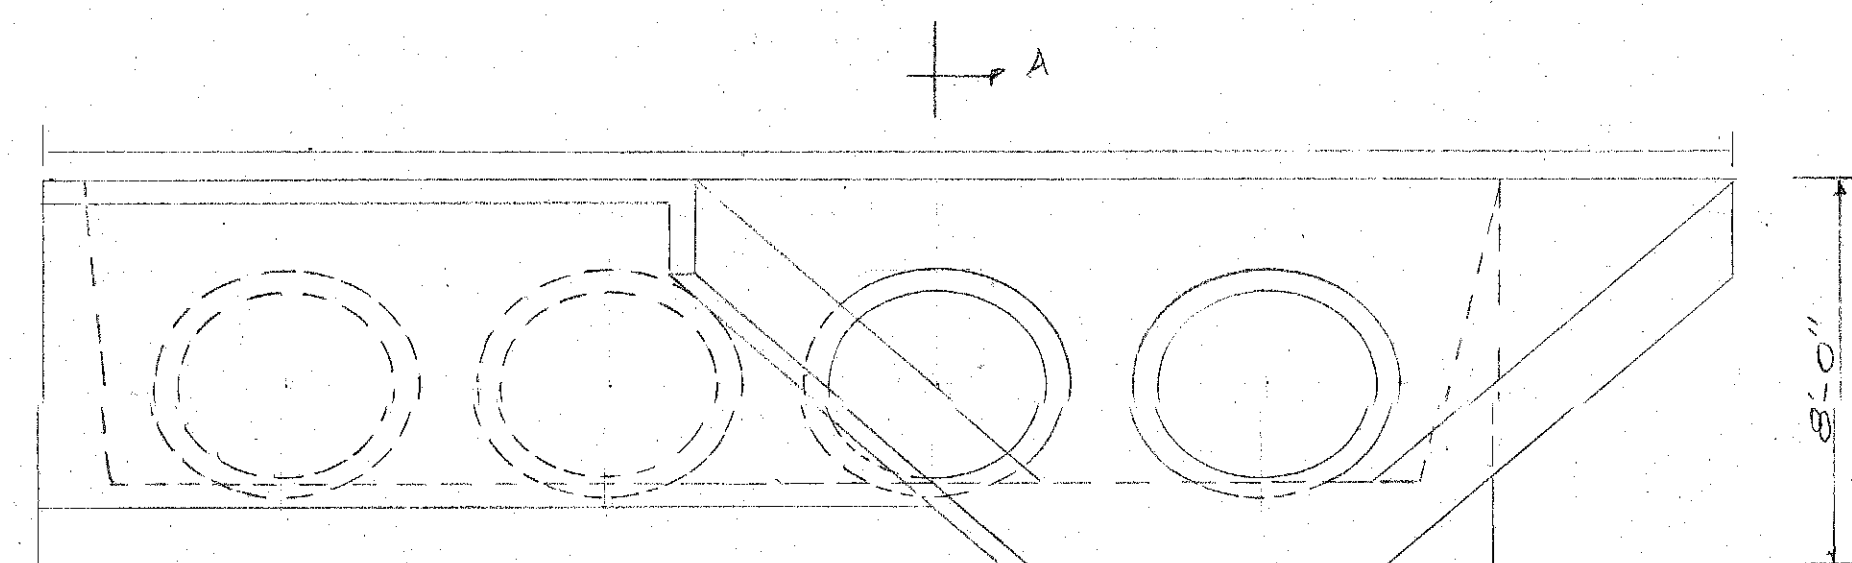


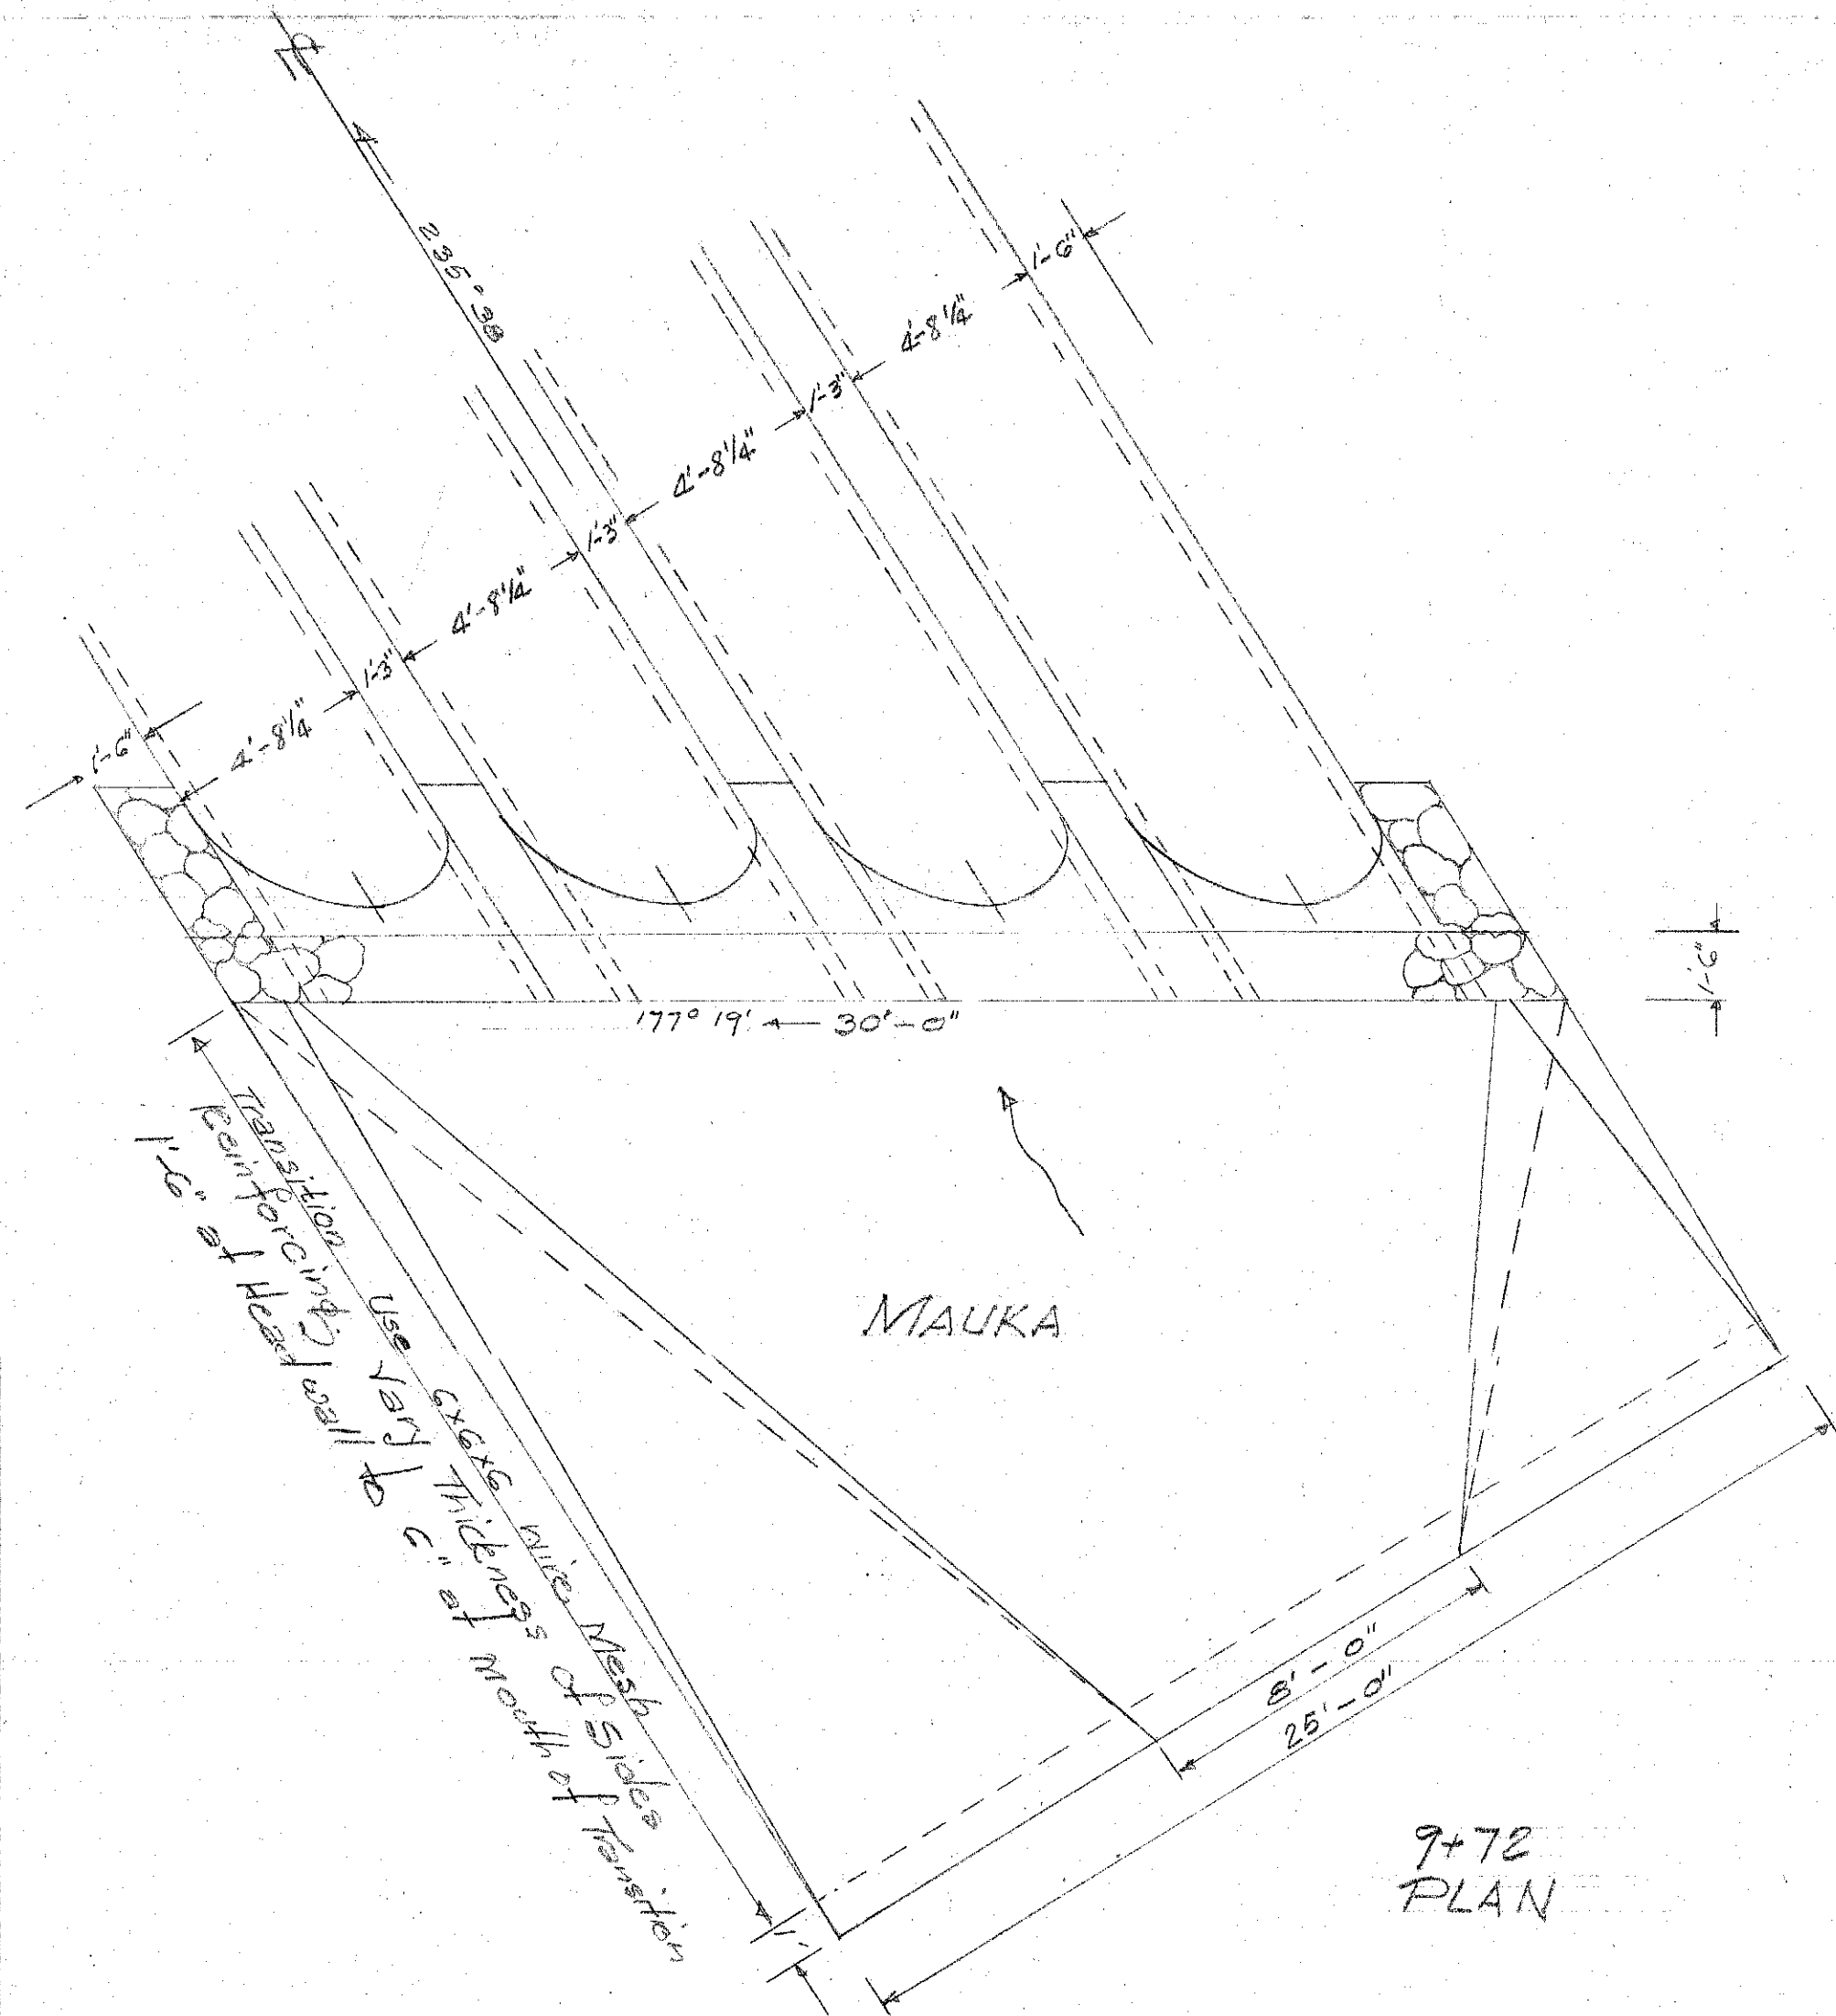

DEPARTMENT OF PUBLIC WORKS
DIVISION OF ENGINEERING
IMPROVEMENT DISTRICT NO. 162

KAHALU CUTOFF ROAD
CULVERT CROSSING AT
Base line Sta. 771.87
Scale: 1/4" = 1'-0"
August 28, 1964

EYE
DEPARTMENT
ENGINEER