
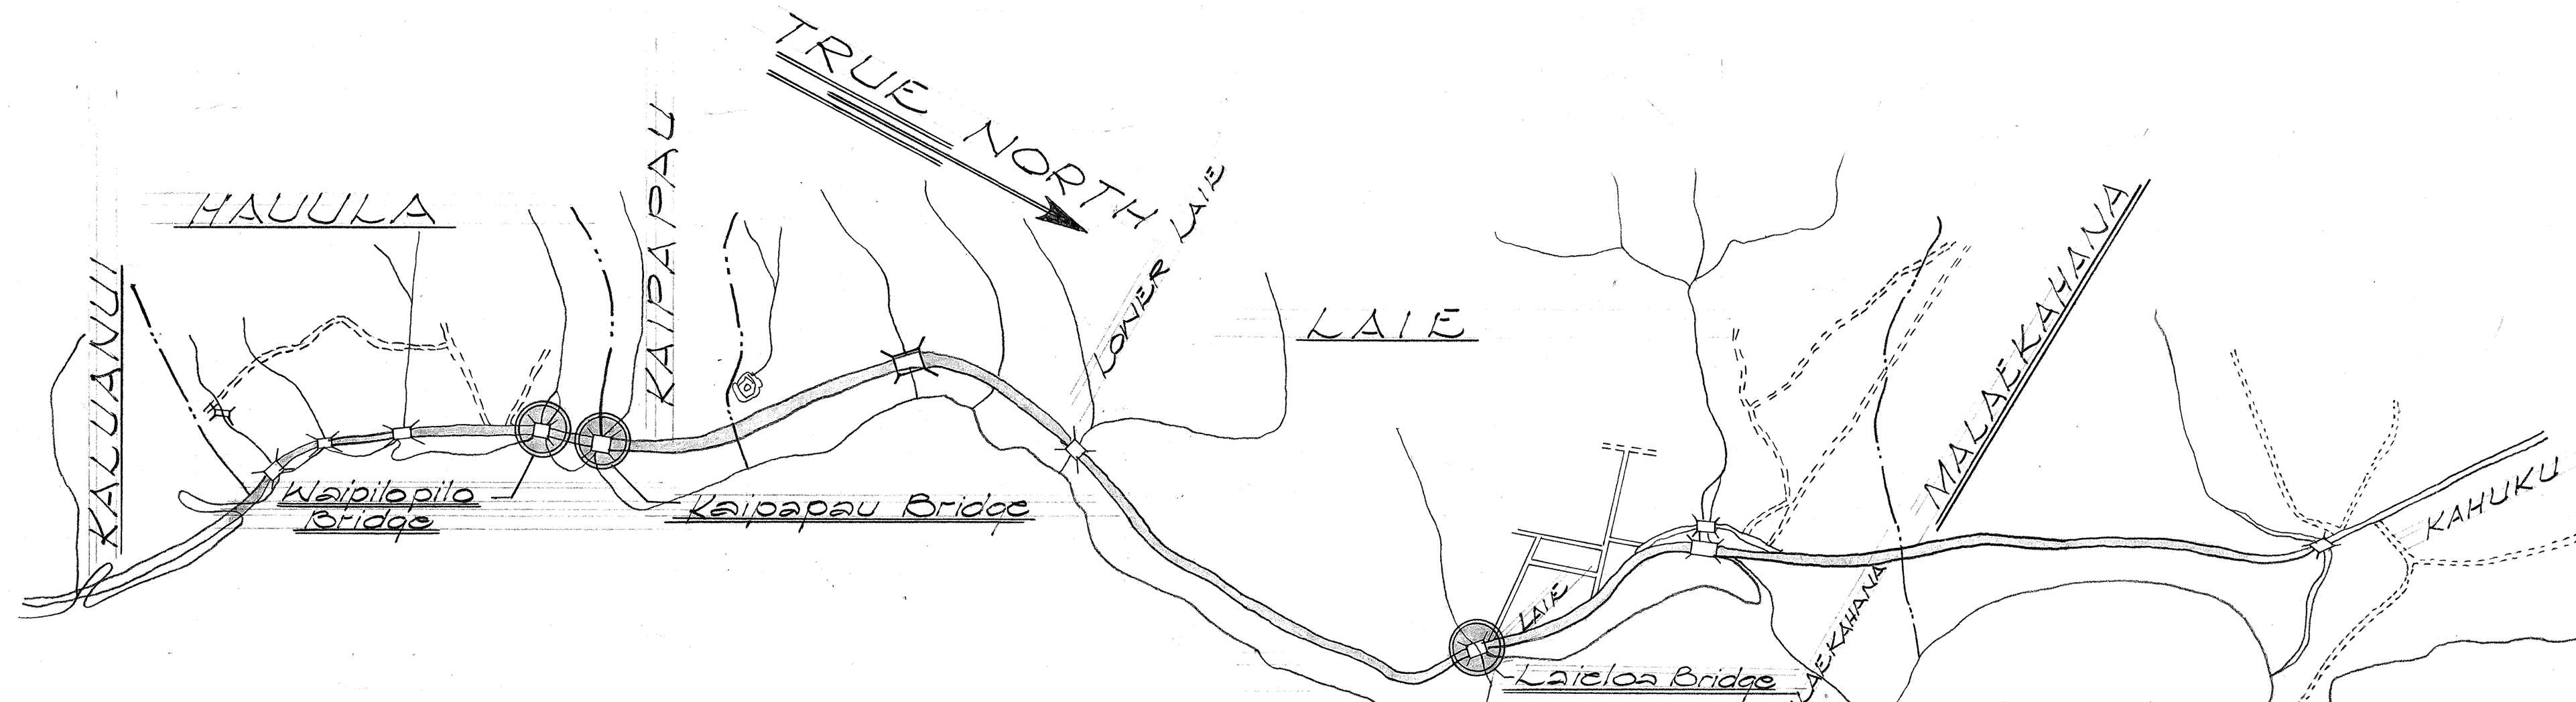


INDEX TO DRAWINGS	
SHT. NO.	DESCRIPTION


STATE OF HAWAII
DEPARTMENT OF TRANSPORTATION
HIGHWAYS DIVISION
HONOLULU, HAWAII

"AS BUILT"
PLANS OF

BRIDGE WALKS FOR WAIPLOPILO, KAIPAPAU AND LAIELOA BRIDGES Proj. No. D-83-01-G4
AND
BRIDGE WALKS FOR KAAWA, MAKAAU, PUNALUU AND MAHEIWI BRIDGES Proj. No. E-83-02-G4

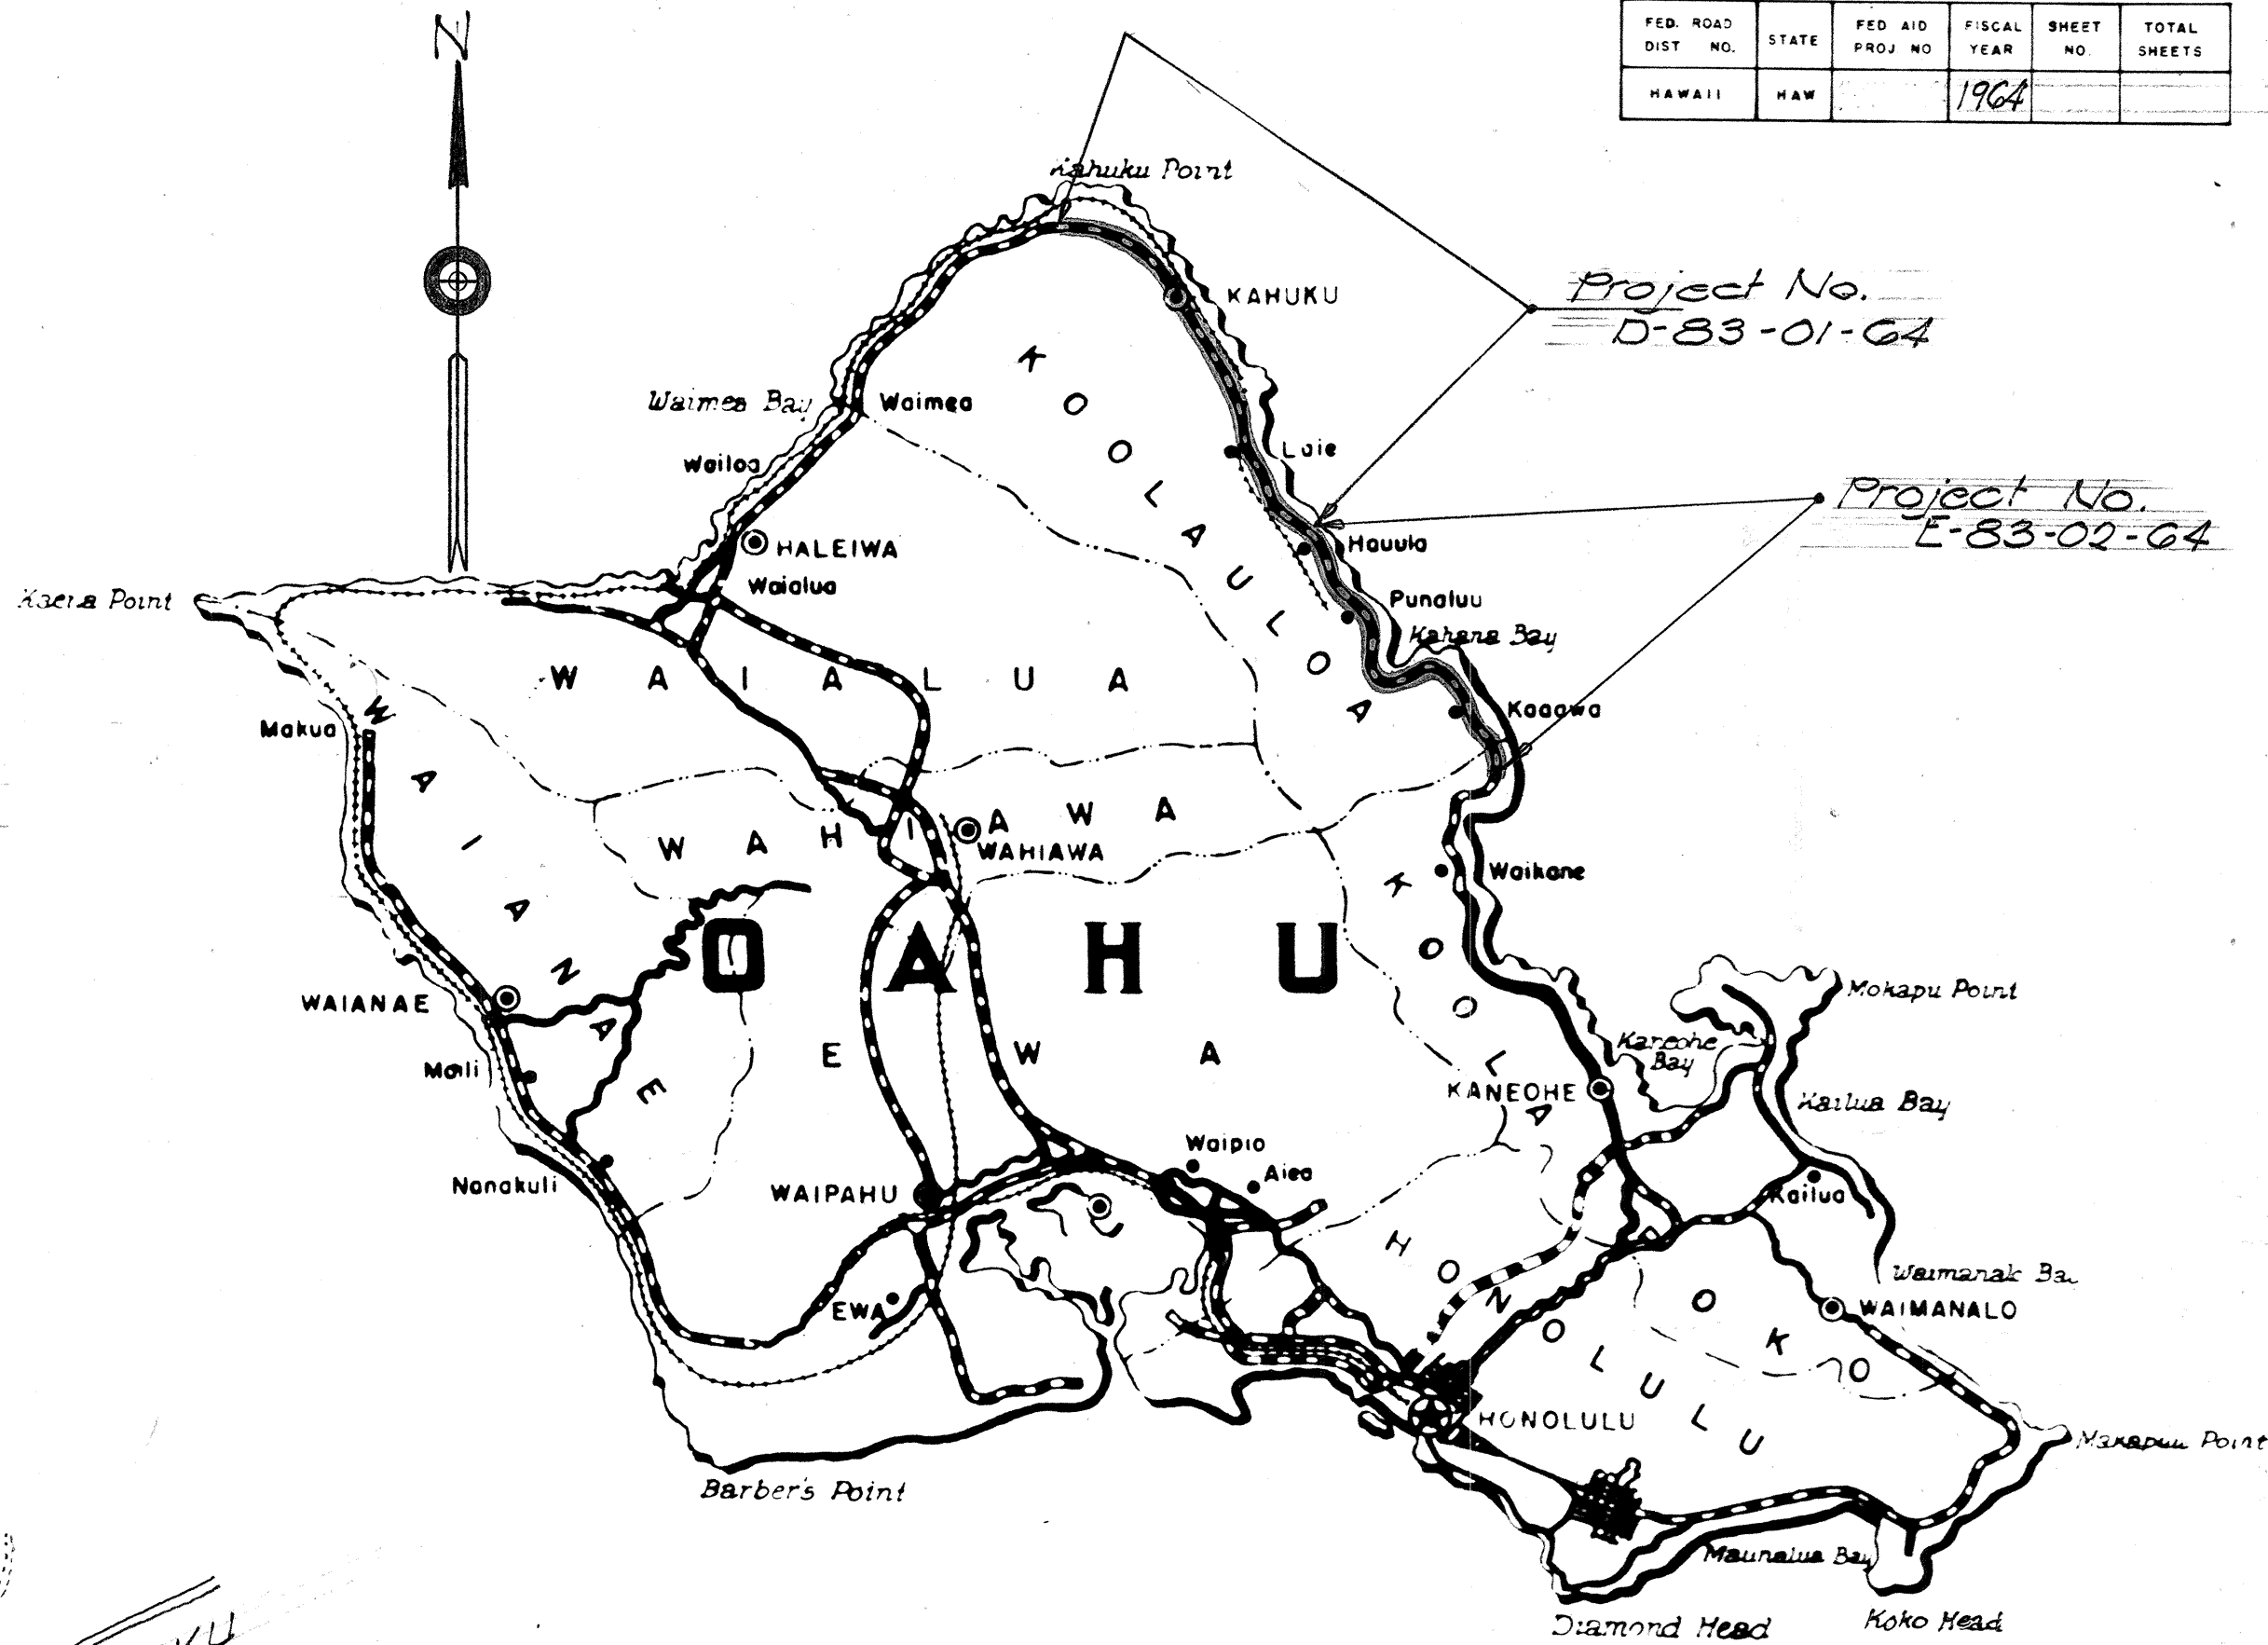

LAYOUT for PROJECT N° D-83-01-G4
Scale: 1" = 20,000'

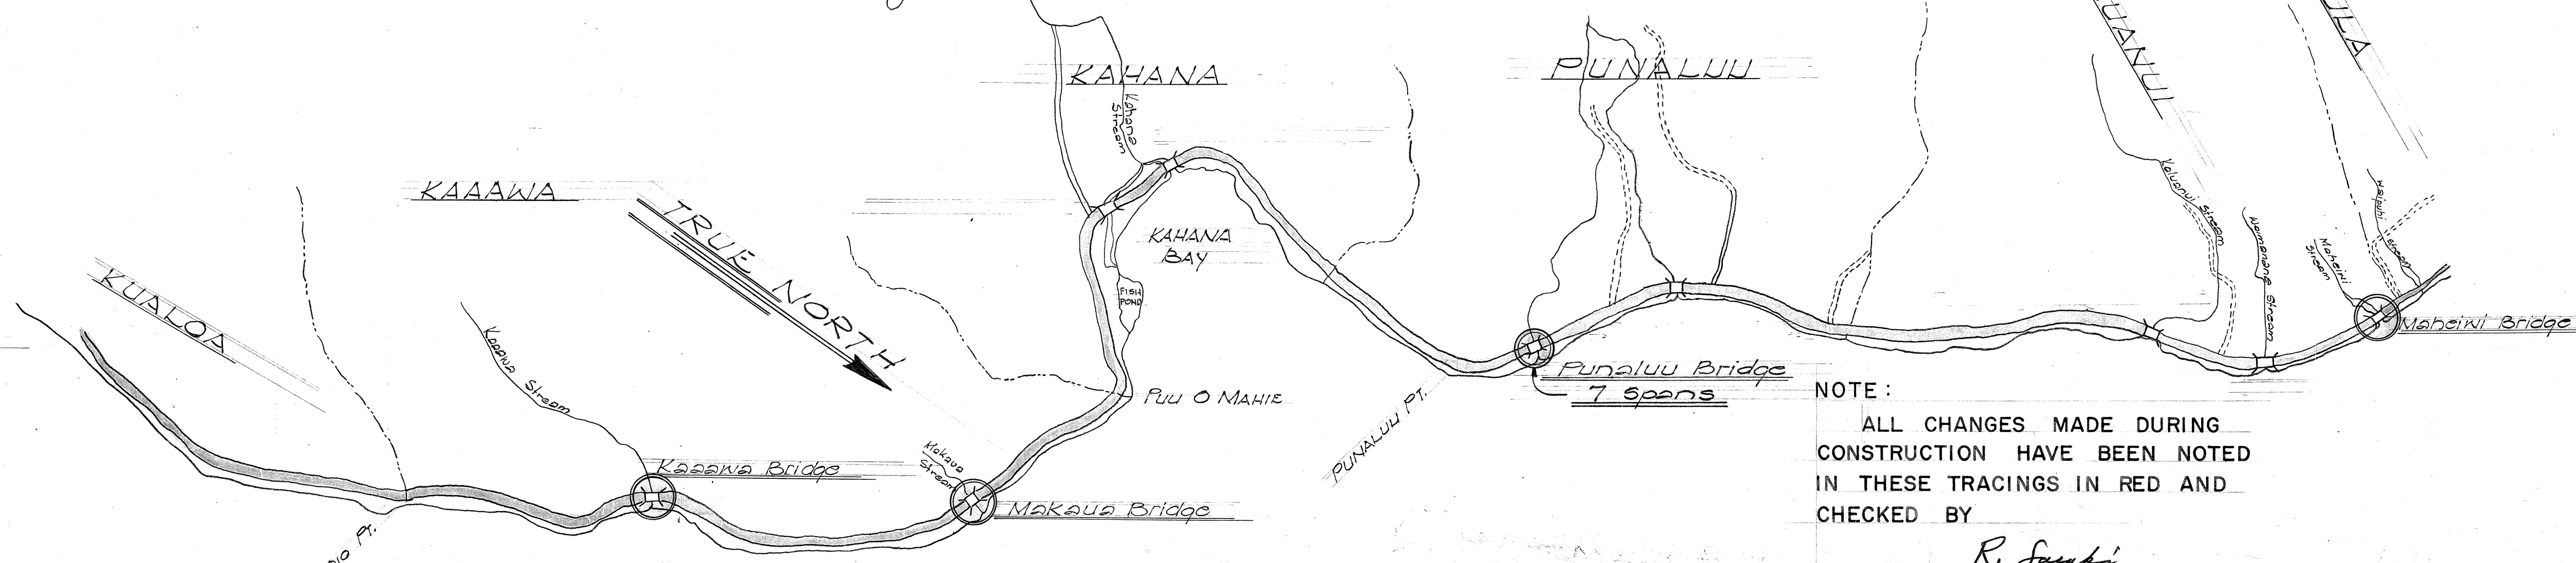

LAYOUT for PROJECT N° E-83-02-G4
Scale: 1" = 1500'

Federal Aid Projects Previously Constructed Or Under Construction

NOTE:
ALL CHANGES MADE DURING
CONSTRUCTION HAVE BEEN NOTED
IN THESE TRACINGS IN RED AND
CHECKED BY

R. Sasaki
RESIDENT ENGINEER

Approved: DATE: 22 May 64

Lewis H. H. H.
DIRECTOR OF TRANSPORTATION

DATE	
SURVEY PLATTED BY	
DESIGNED BY	
DRAWN BY	
CHECKED BY	
NOTE BOOK	
NO.	