

INDEX TO DRAWINGS	
SHT. NO.	DESCRIPTION
1.	Location Drawing
REPAIRS TO KALUANUI BRIDGE	
2.	Repair Details
3.	Existing Concrete Bridge Drawing
REPAIRS TO MOANALUA BRIDGE	
4.	Repair Details

STATE OF HAWAII

DEPARTMENT OF TRANSPORTATION

HIGHWAYS DIVISION

HONOLULU, HAWAII

AS BUILT

PLANS OF REPAIRS TO KALUANUI BRIDGE, KAMEHAMEHA HIGHWAY



DISTRICT OF KOOLAULOA, AND

PLANS OF REPAIRS TO MOANALUA BRIDGE, NIMITZ HIGHWAY

DISTRICT OF HONOLULU

PROJ. NO. SD64-021 UNIT 1

ISLAND OF OAHU

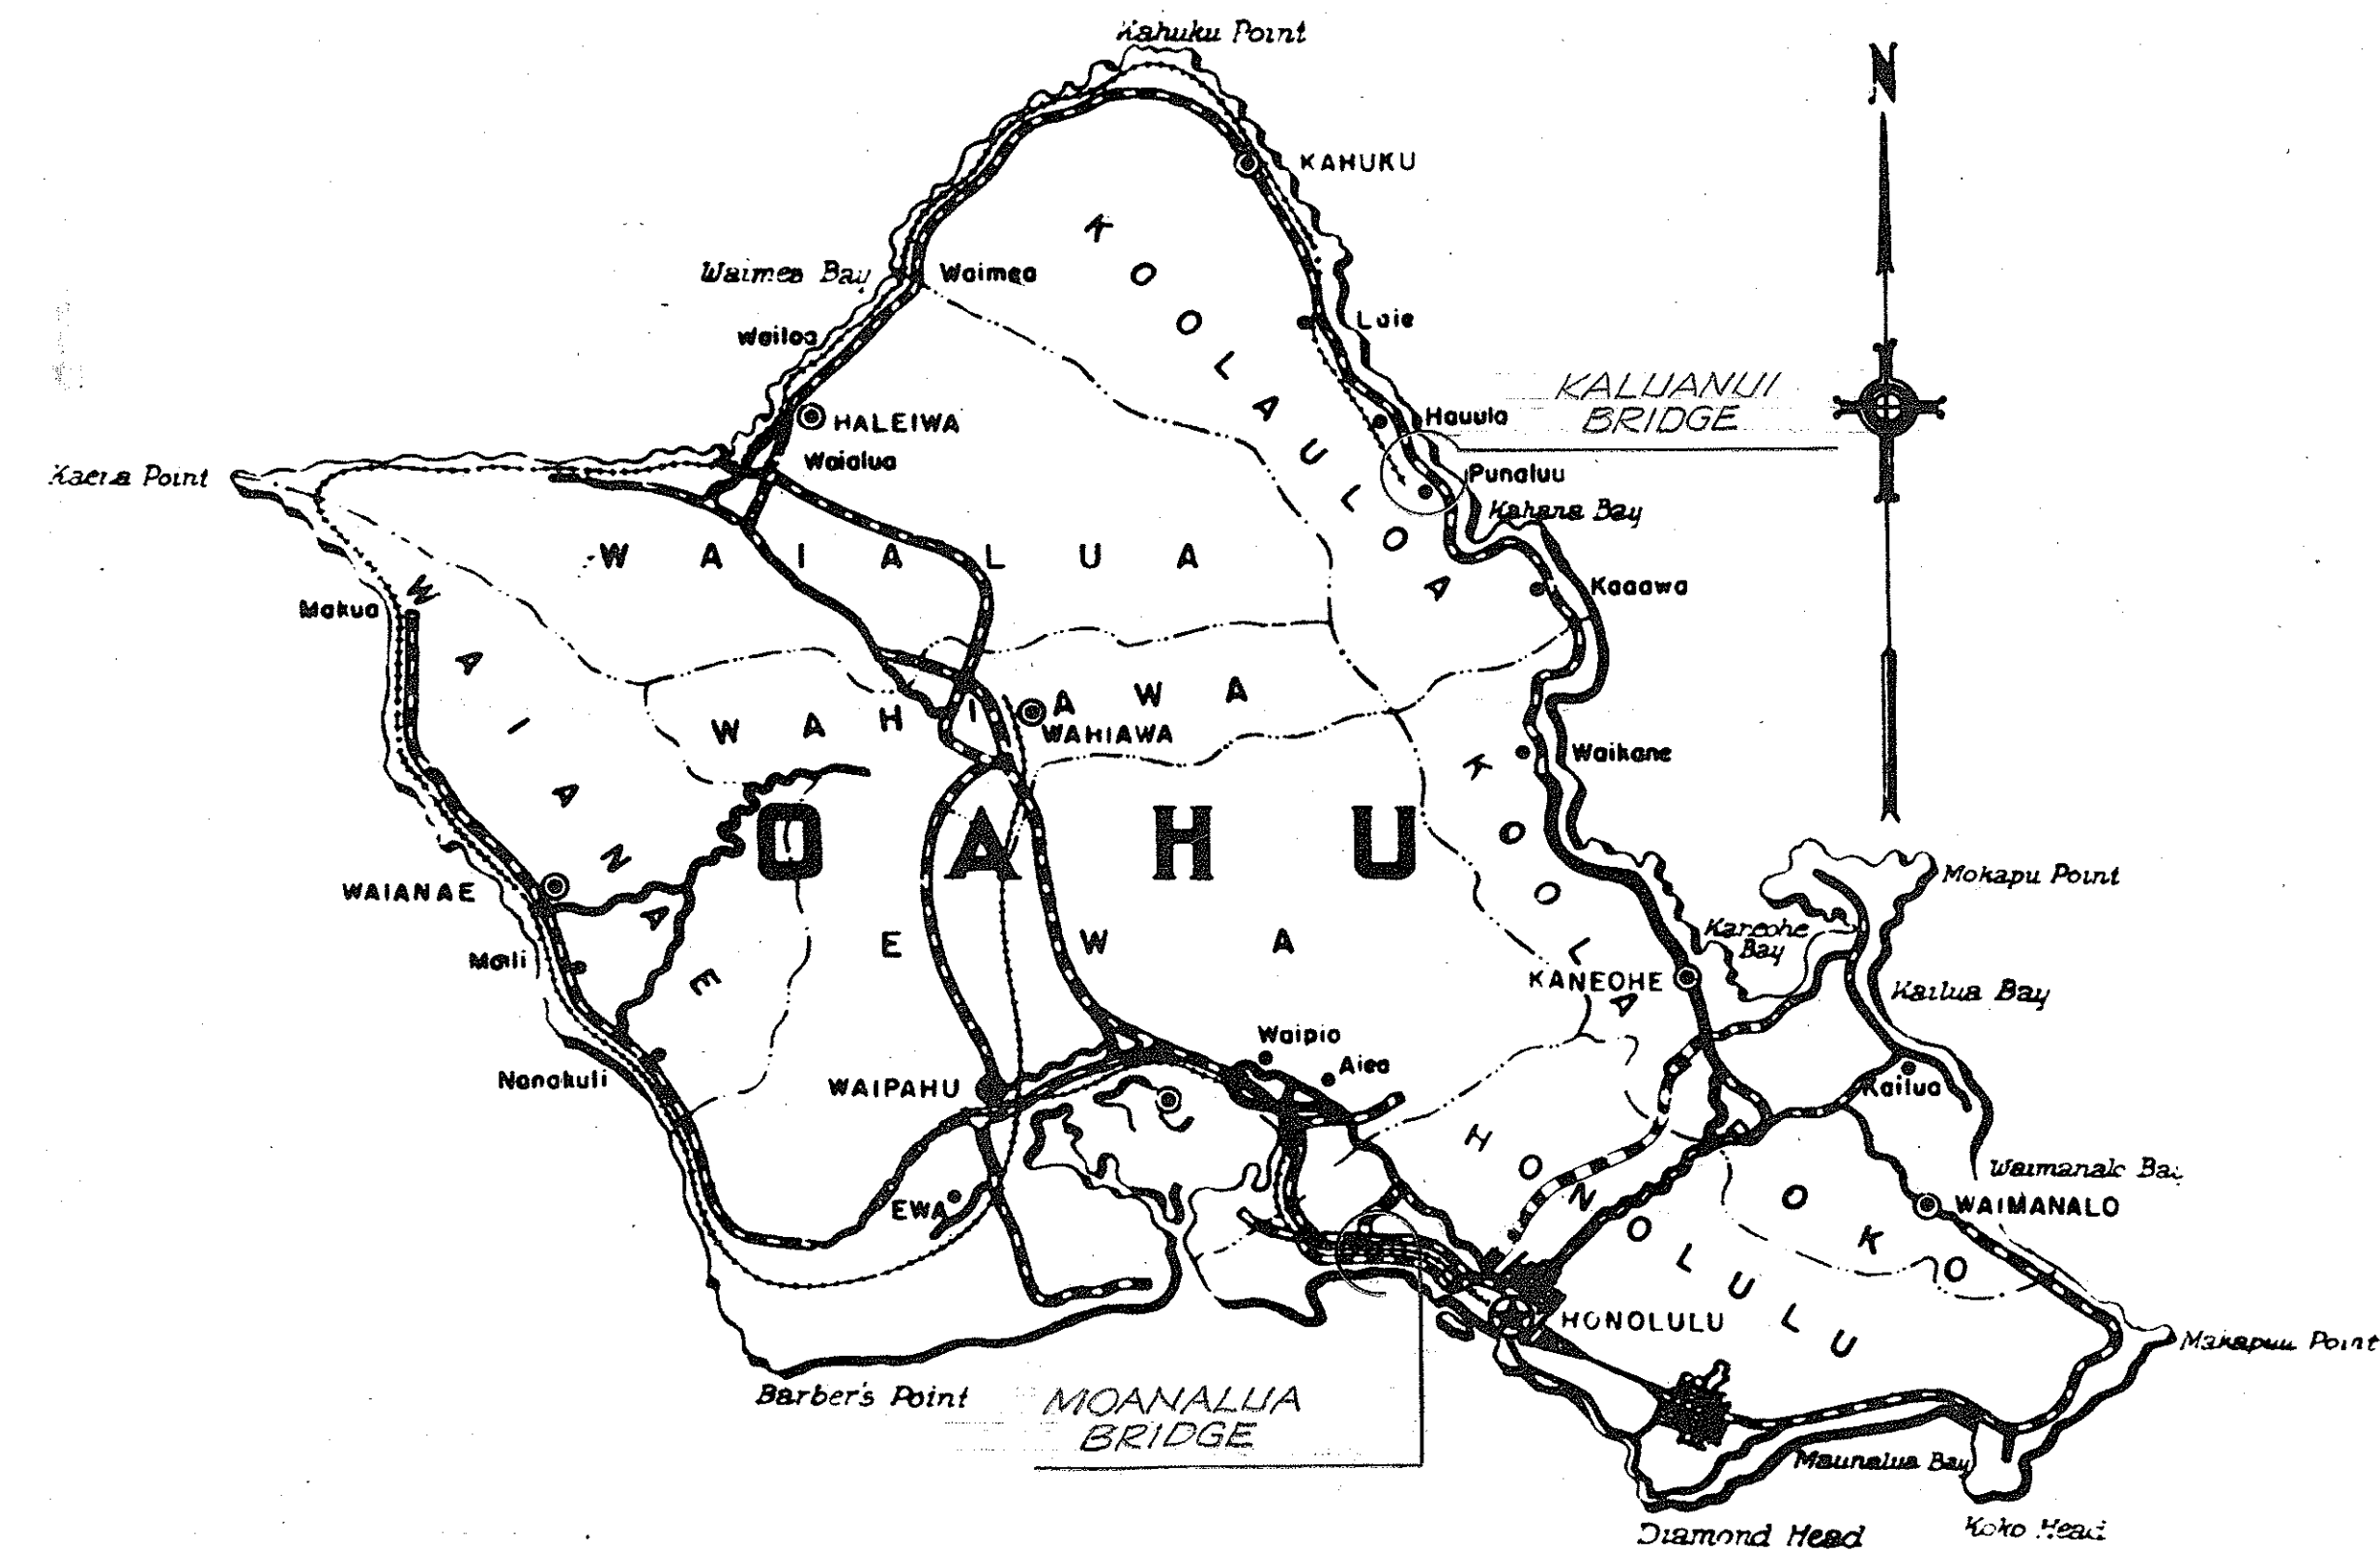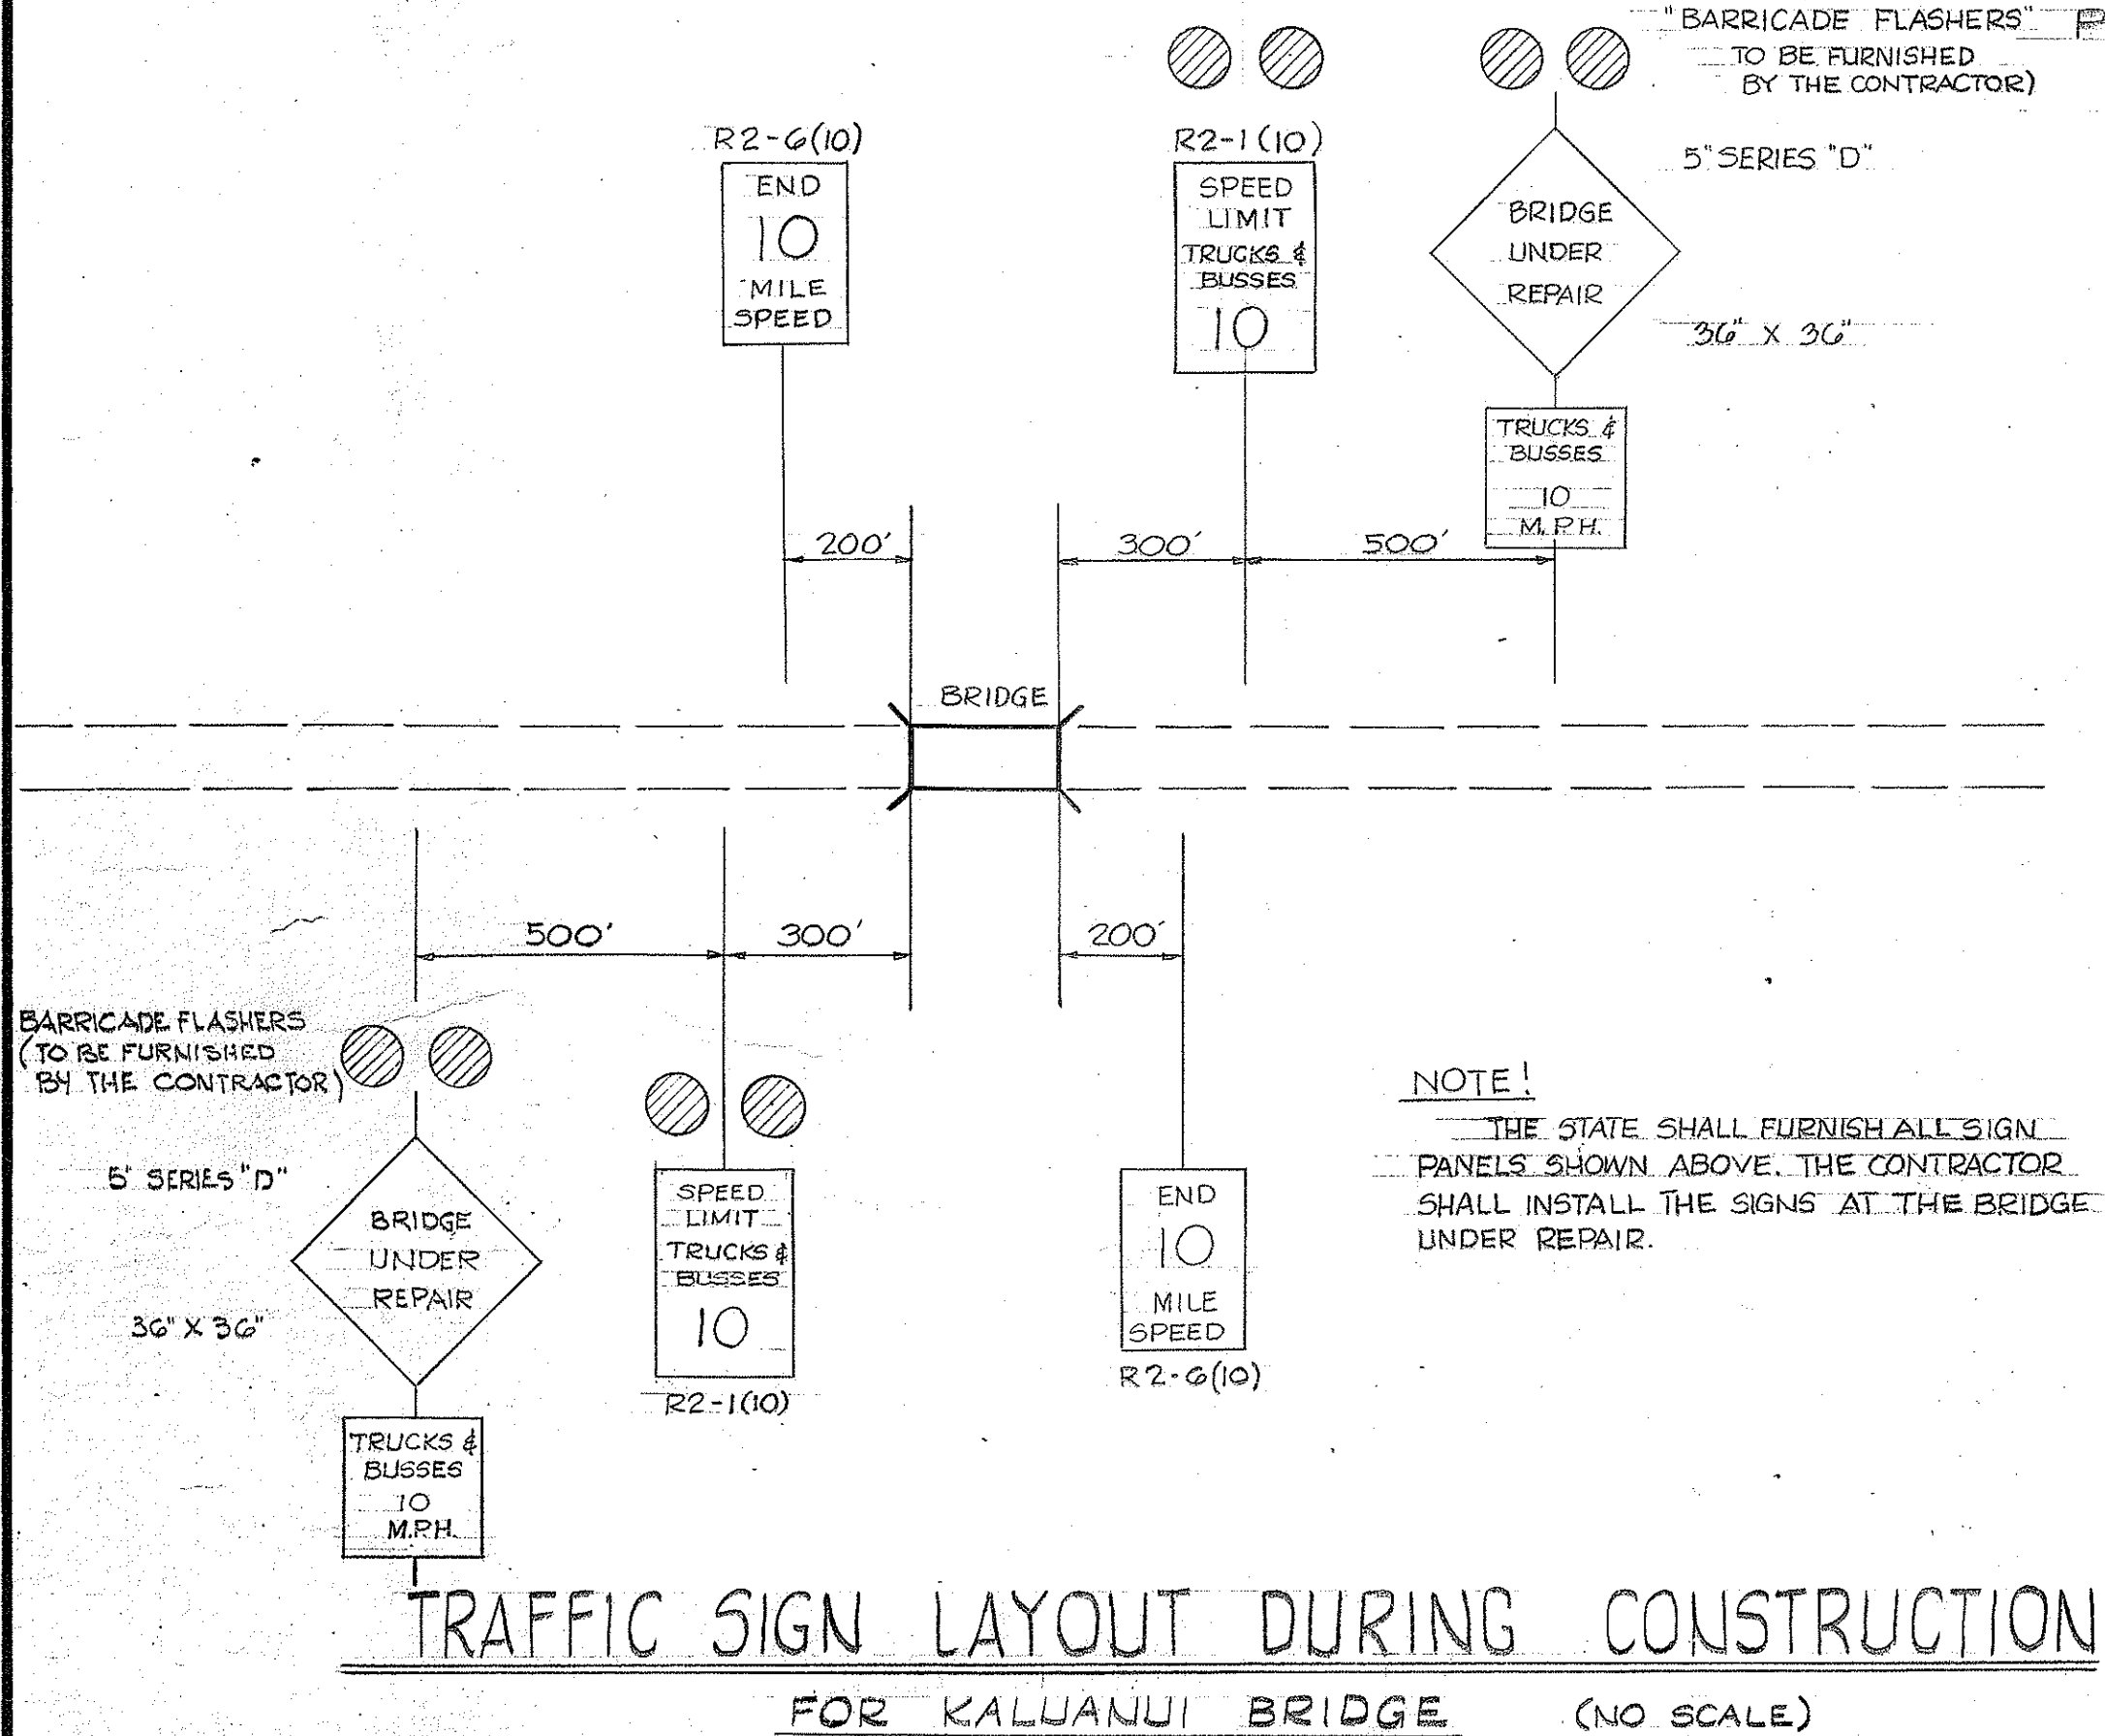

Federal Aid Projects Previously Constructed Or Under Construction

NOTE: ALL CHANGES MADE DURING CONSTRUCTION ARE SHOWN IN RED ON THESE TRACINGS AND CHECKED BY:

Ray T. Kaula
PROJECT ENGINEER

2/28/67
DATE

APPROVED: *Luigi Urdaneta*
DATE: 11 Dec 67
DIRECTOR OF TRANSPORTATION

SHEET No. 1 OF 4 SHEETS