


STATE OF HAWAII
DEPARTMENT OF TRANSPORTATION
HIGHWAYS DIVISION
HONOLULU HAWAII

"AS BUILT" PLANS FOR
RESURFACING OF A PORTION OF
KAMEHAMEHA HIGHWAY
(KUILIMA BRIDGE TOWARD KAHUKU)
PROJECT NO. C-83-02-66

DISTRICT OF KOOLAULOA
ISLAND OF OAHU



LAYOUT PLAN
Scale 1"=25,000 Ft.
LENGTH OF PROJECT = 3.272 Miles

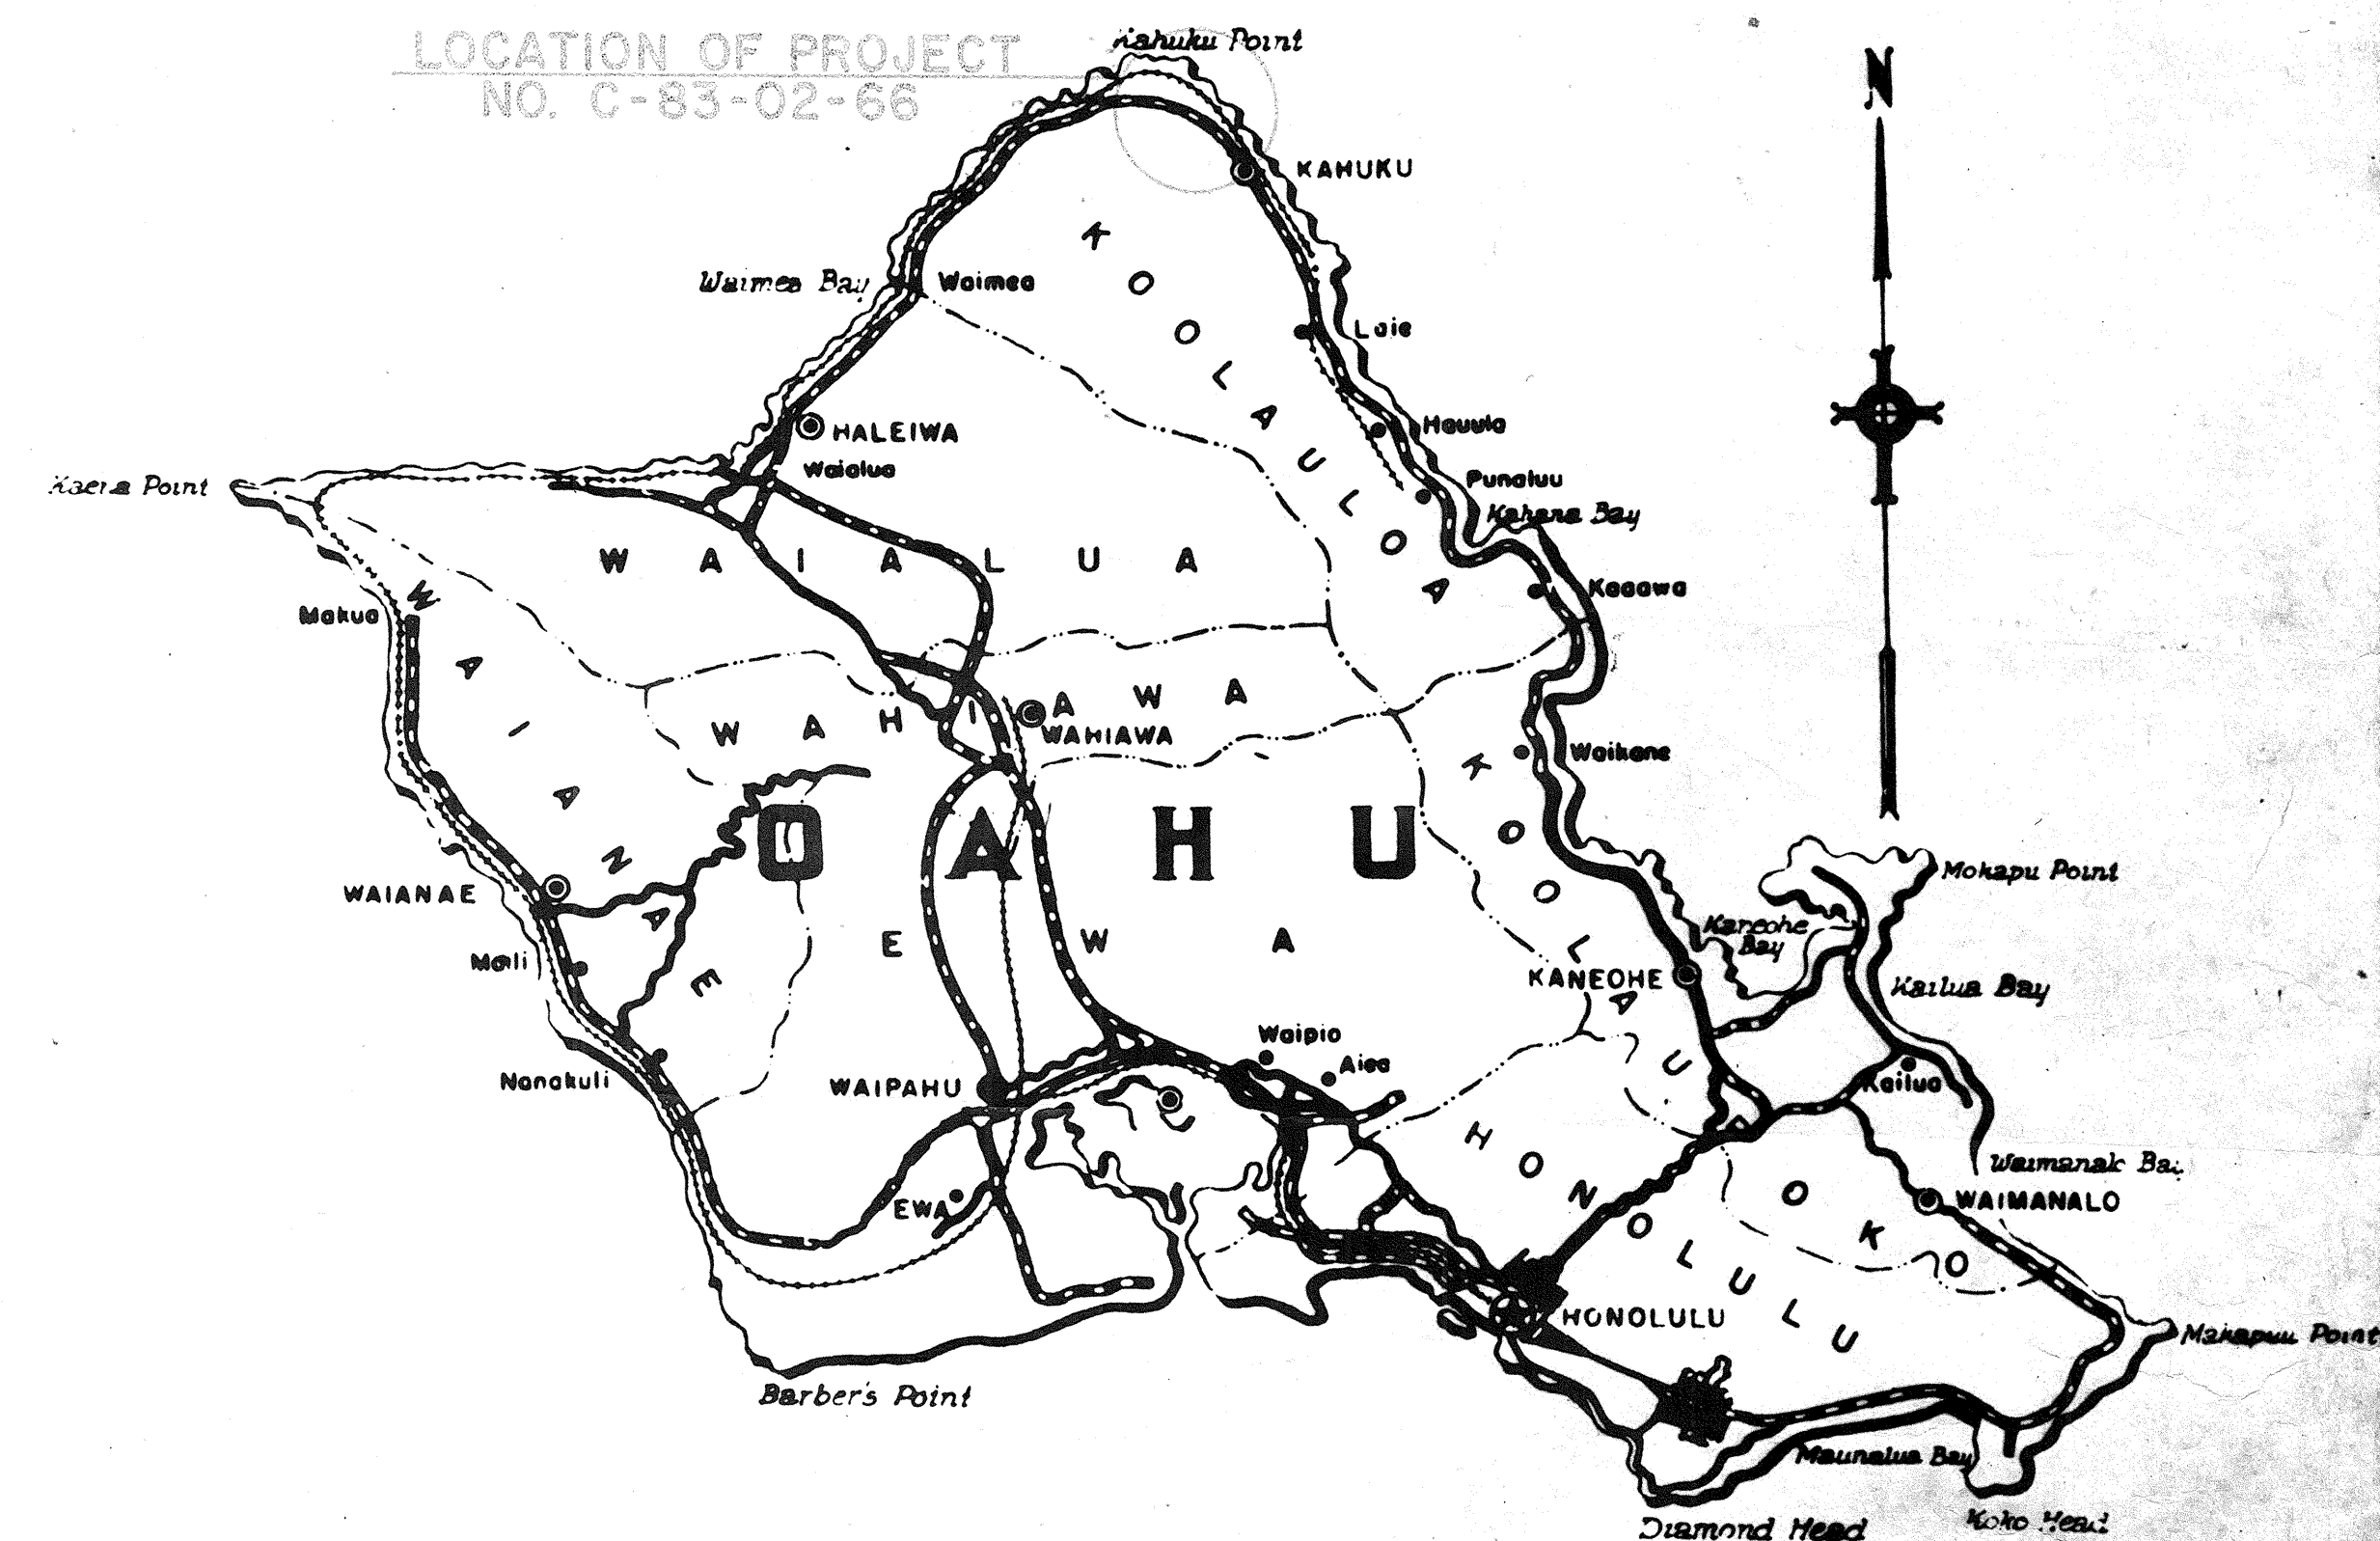

Federal Aid Projects Previously Constructed Or Under Construction

GENERAL NOTES	STATION	WIDTH	THICKNESS
1. Resurfaced	00+00 to 01+00	20'	12"
2. Resurfaced	01+00 to 02+00	20'	12"
3. Resurfaced	02+00 to 03+00	20'	12"
4. Resurfaced	03+00 to 04+00	20'	12"
5. Resurfaced	04+00 to 05+00	20'	12"
6. Resurfaced	05+00 to 06+00	20'	12"
7. Resurfaced	06+00 to 07+00	20'	12"
8. Resurfaced	07+00 to 08+00	20'	12"
9. Resurfaced	08+00 to 09+00	20'	12"

NO CHANGE WAS MADE DURING
CONSTRUCTION OF THIS PROJECT.

R. T. Smith
RESIDENT ENGINEER
DATE 11-10-81

APPROVED: _____ DATE _____
[Signature]

SURVEY PLOTTED BY	DATE
ORIGINAL PLAN	
TRACED BY	
NOTE BOOK	
QUANTITIES CHECKED BY	
NO.	