

INDEX TO DRAWINGS	
SHEET NO.	DESCRIPTION
1	TITLE SHEET
2-3	TYPICAL RDWY. SECTIONS
4-9	PLAN & PROFILE
10-17	MISC. ROADWAY DETAILS
18-30	UTILITY PLANS AND DETAILS
31-43	DRAINAGE PLANS AND DETAILS
44-53	TRAFFIC SIGNING PLANS AND DETAILS
54-56	LANDSCAPING PLANS
57-67	KAMOOALII STREAM BRIDGE PLANS & DETAILS
68-83	CROSS SECTIONS
C.O. 8S	DETAIL ROADWAY PLAN
C.O. 42S	DRAINAGE DETAILS
C.O. 60SI	BRIDGE DETAILS

STATE OF HAWAII

DEPARTMENT OF TRANSPORTATION

HIGHWAYS DIVISION

HONOLULU, HAWAII

"AS BUILT"

PLANS FOR

CONSTRUCTION OF

KAMEHAMEHA HIGHWAY

PALI GOLF COURSE TOWARD KANEOHE

(KANEOHE ELEMENTARY SCHOOL TO PALI GOLF COURSE)

FEDERAL AID PROJECT NO. F-083-I(2), UNIT 1

DISTRICT OF KOOLAUPOKO

ISLAND OF OAHU



SCALES :

PLAN & PROFILE . . . . . HOR. 1" = 50'

VER. 1" = 10'

CROSS SECTION . . . . . HOR. 1" = 10'

VER. 1" = 10'

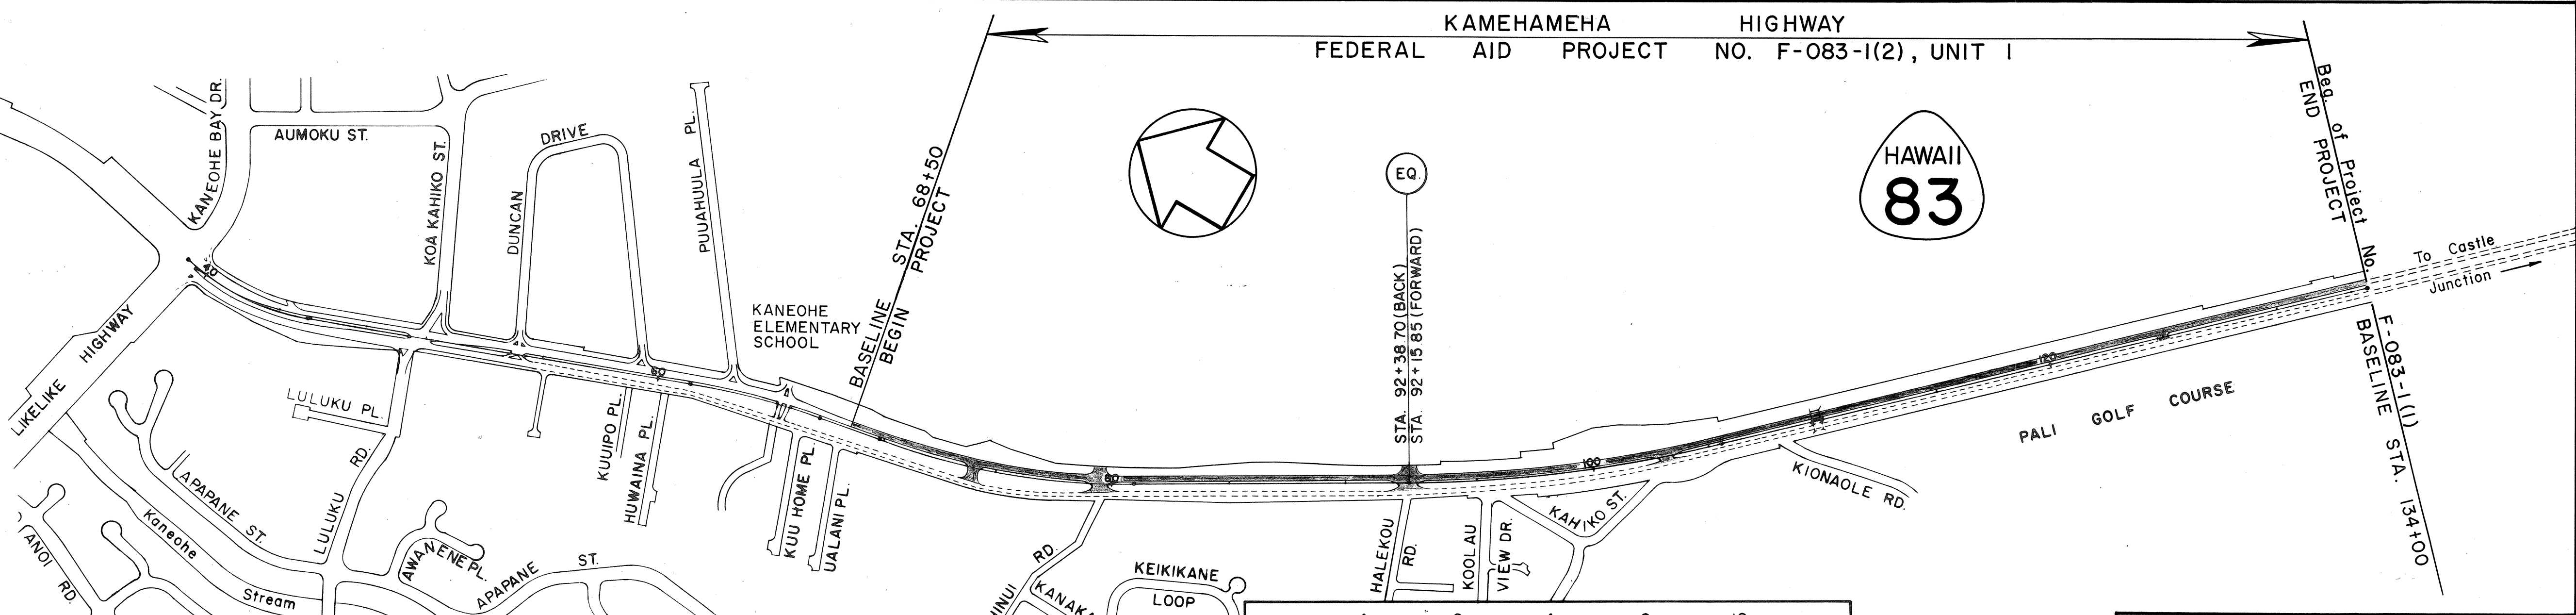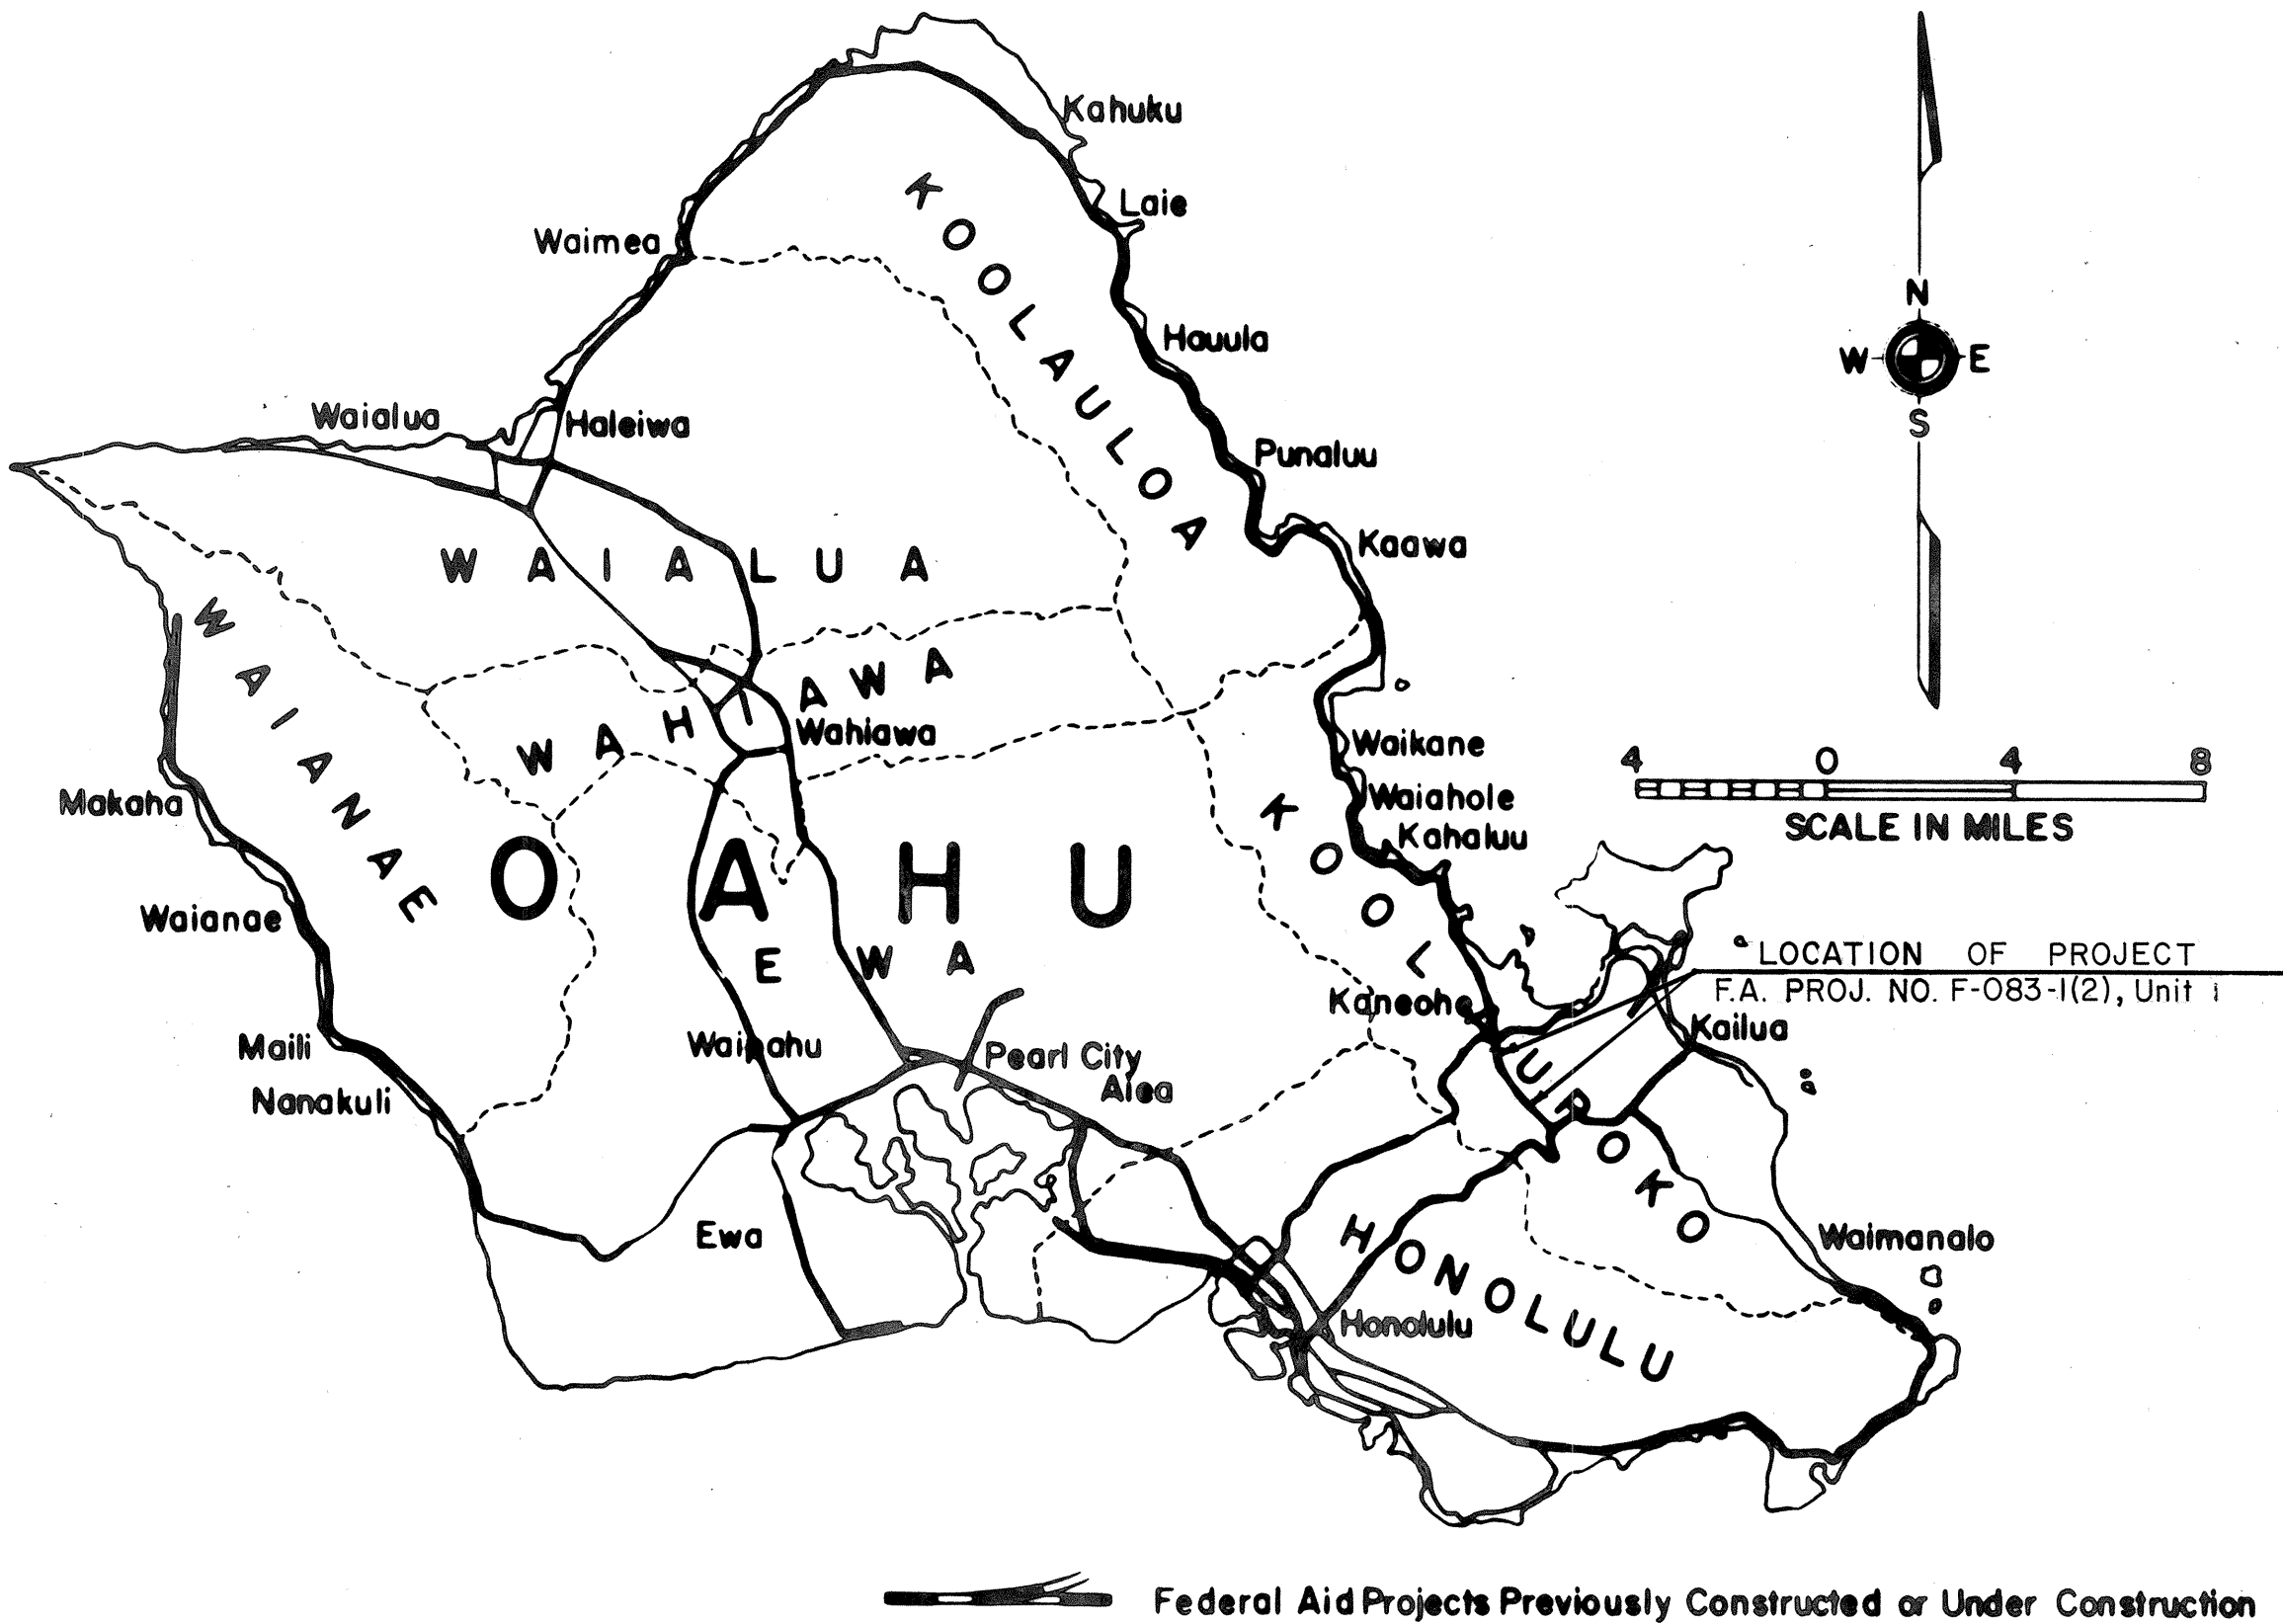

NOTE:

ALL CHANGES MADE DURING CONSTRUCTION HAVE BEEN NOTED IN RED ON THESE TRACINGS AND CHECKED BY

H. Harris

PROJECT ENGINEER

3/22/71

DATE

DESIGN CLASSIFICATION			
ADT (1965) . . . . .	17,300	D. . . . .	60/40
DESIGN ADT(1988) . . . . .	27,000	T. . . . .	3.5 %
DHV . . . . .	10%	V. . . . .	40 M.P.H.

LAYOUT PLAN	
GROSS LENGTH OF PROJECT . . . . .	1.241 Mi.
BRIDGES OVER 20.00' SPAN . . . . .	0/ 20 Mi.
NET LENGTH OF ROADWAY . . . . .	1.221 Mi.

DEPARTMENT OF COMMERCE BUREAU OF PUBLIC ROADS	
APPROVED:	
Ralph E. [Signature]	10/25/66
Sr. DIVISION ENGINEER	DATE

DEPARTMENT OF TRANSPORTATION STATE OF HAWAII	
APPROVED:	
John [Signature]	10-19-66
Sr. DIR. OF TRANSPORTATION	DATE

50511 Local 301

Oct 1966

DATE

PHONE

DESIGN UNIT

Seung Fa Yuen

DESIGN ENGR.