
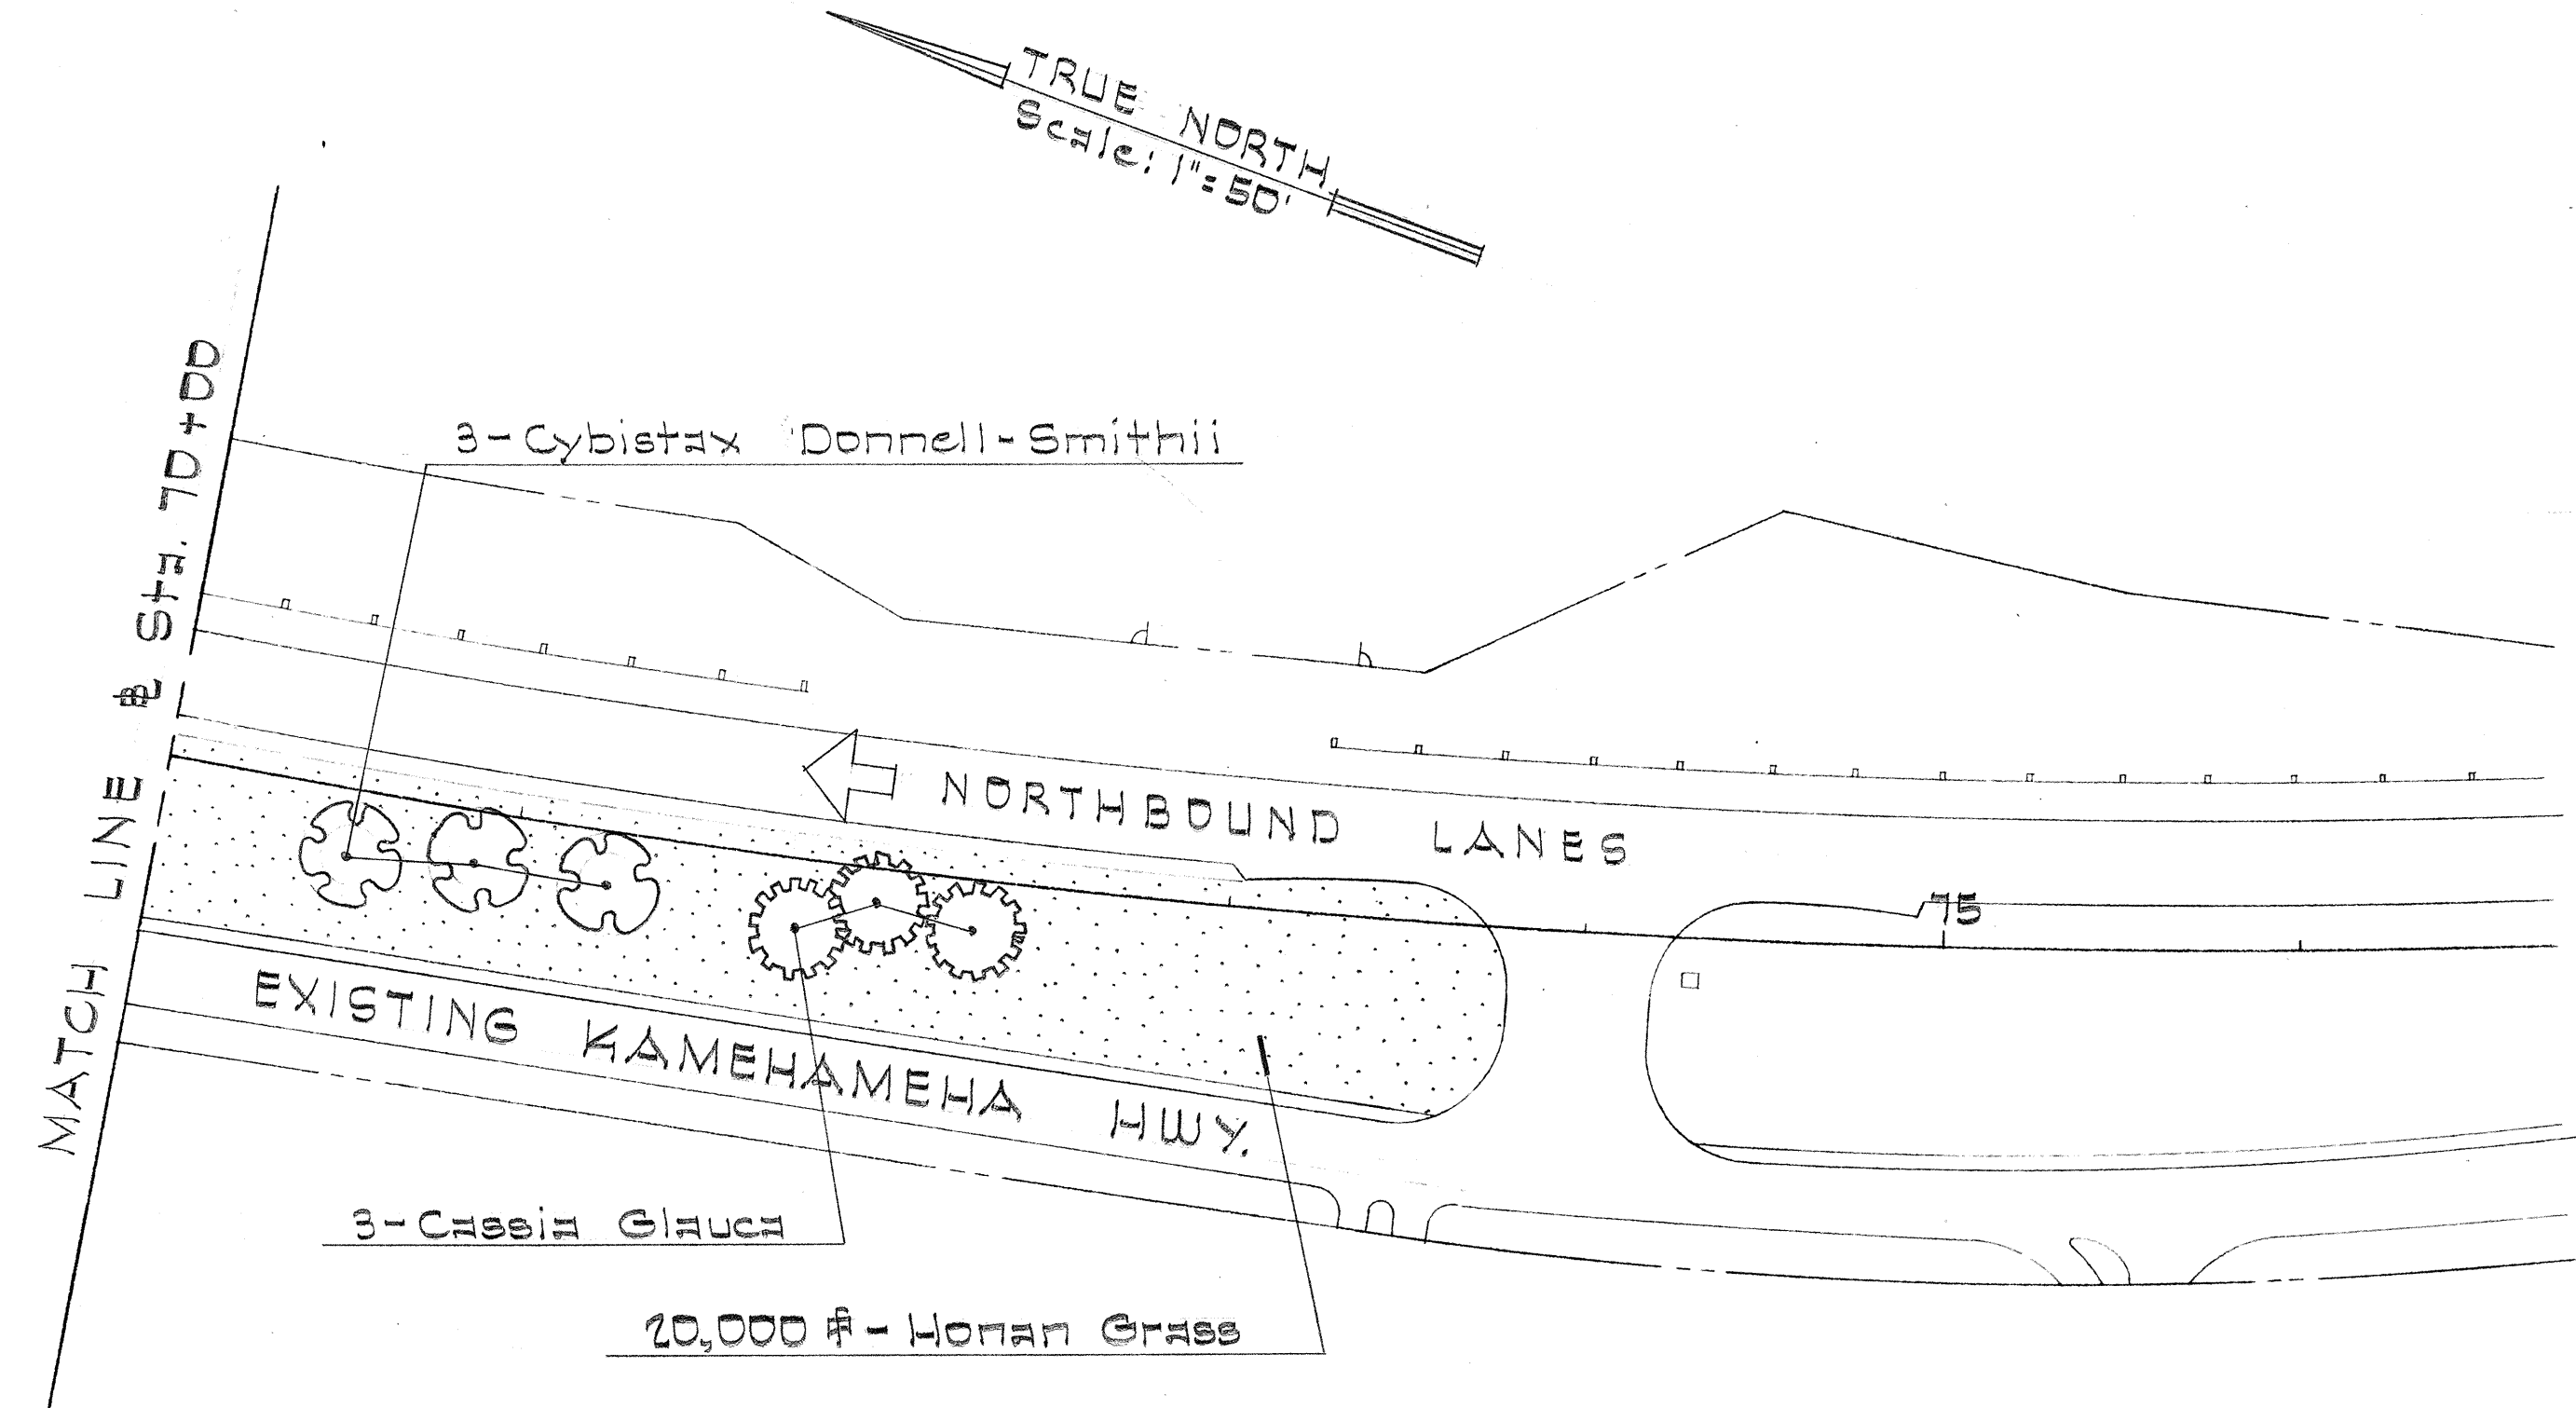


FED. ROAD DIST. NO.	STATE	FED. AID PROJ. NO.	FISCAL YEAR	SHEET NO.	TOTAL SHEETS
HAWAII	HAW.	F-083-1(2) Unit 2	1967	74	83

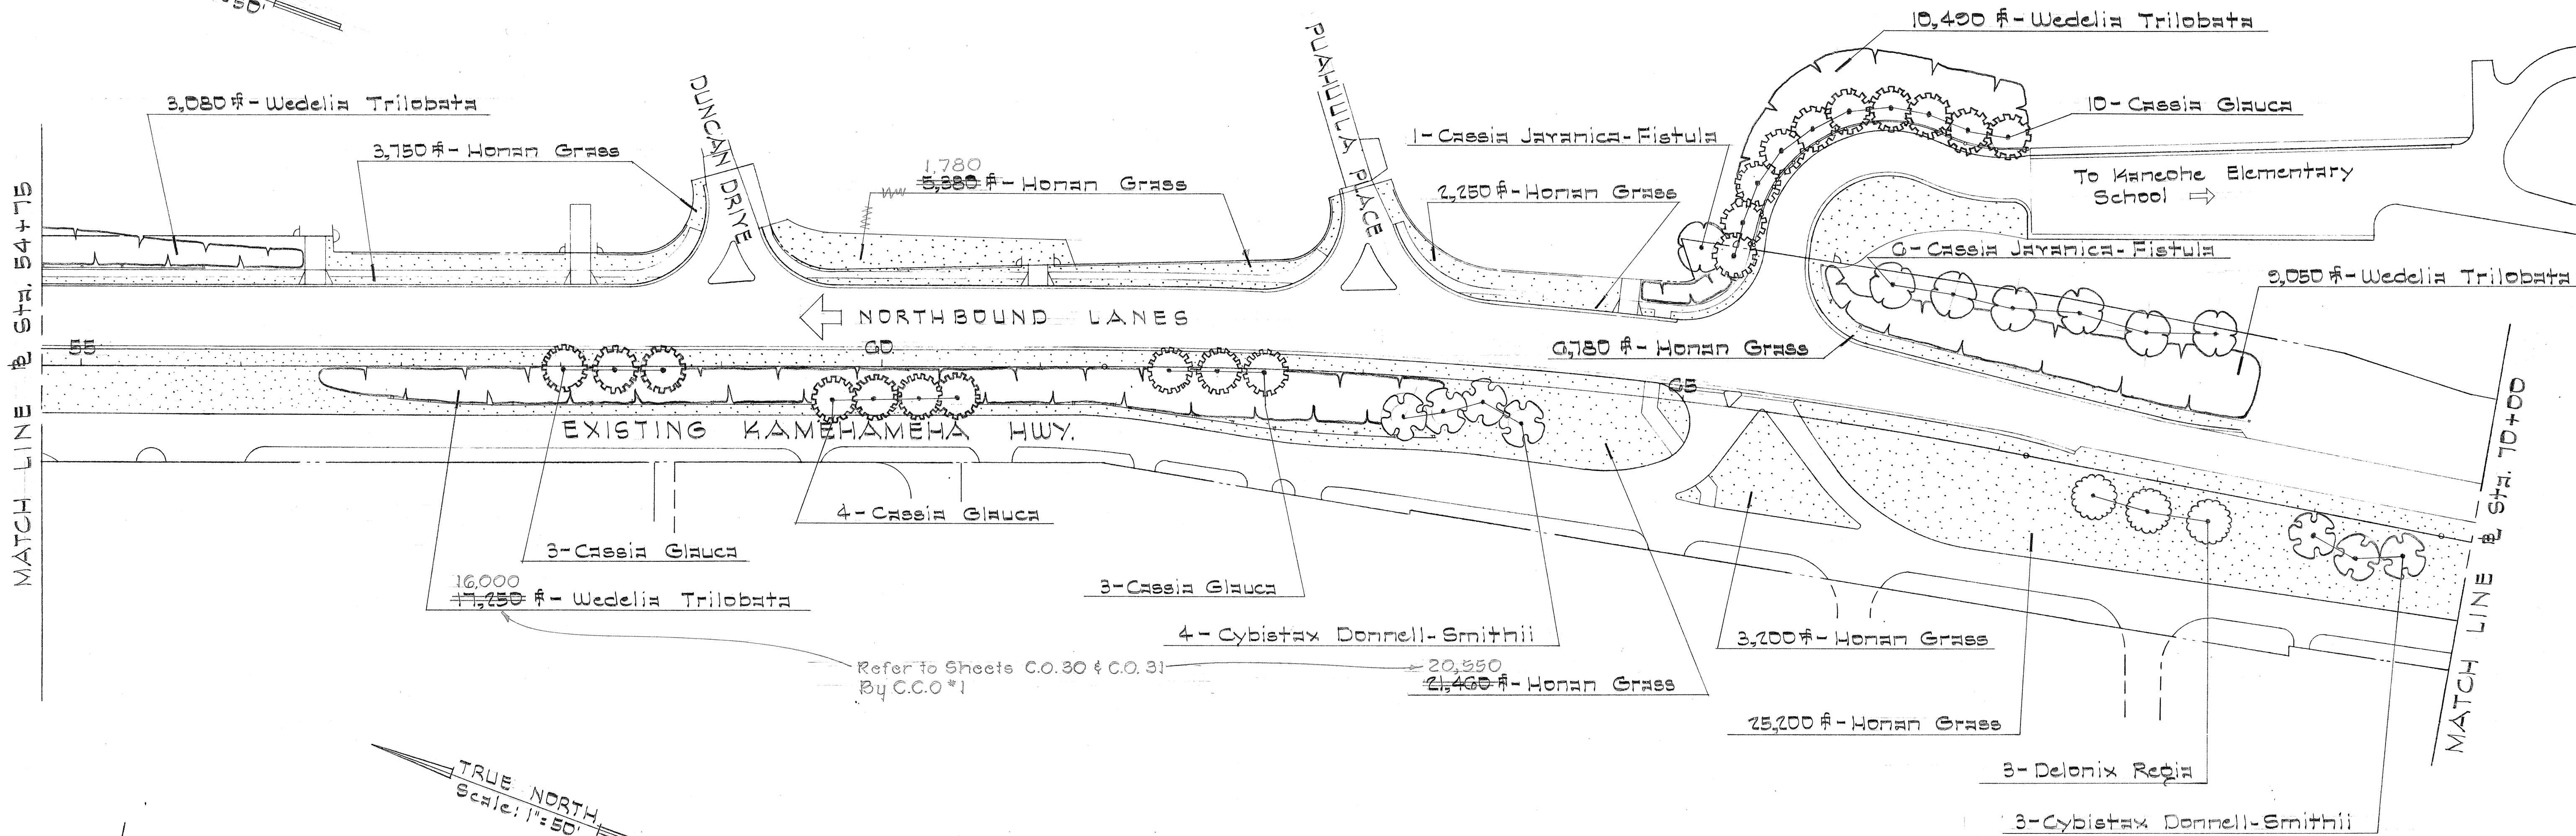

PLANT LIST — THIS SHEET		
BOTANICAL NAME	COMMON NAME	QUANTITY
Cassia glauca	Kalamona	23 ea.
Cassia Jayanica - Fistula	Rainbow Shower	1 ea.
Cybistax Donnell-Smithii	Gold Tree	10 ea.
Delonix Regia	Poinciana	3 ea.
Wedelia Trilobata	Wedelia	39,870 #
Eremochloa Ophiuroides	Honan Grass	88,020 #

STATE OF HAWAII
DEPARTMENT OF TRANSPORTATION
HIGHWAYS DIVISION

LANDSCAPING

KAMEHAMEHA HIGHWAY
F.A. Proj. No. F-083-1(2), Unit 2
Scale: As Shown
May 1967

SHEET No. 2 OF 2 SHEETS

SURVEY PLOTTED BY	DATE
DRAWN BY	
DESIGNED BY	
QUANTITIES BY	
CHECKED BY	
ORIGINAL PLAN	
NOTE BOOK	
No.	