


FED. ROAD DIST. NO.	STATE	FED. AID PROJ. NO.	FISCAL YEAR	SHEET NO.	TOTAL SHEETS
HAWAII	HAW.	F-083-12 Unit 2	1967	4	83

PLAN	SURVEYED	DATE
NO.	NO.	NO.

PROFILE	SURVEYED	DATE
NO.	NO.	NO.

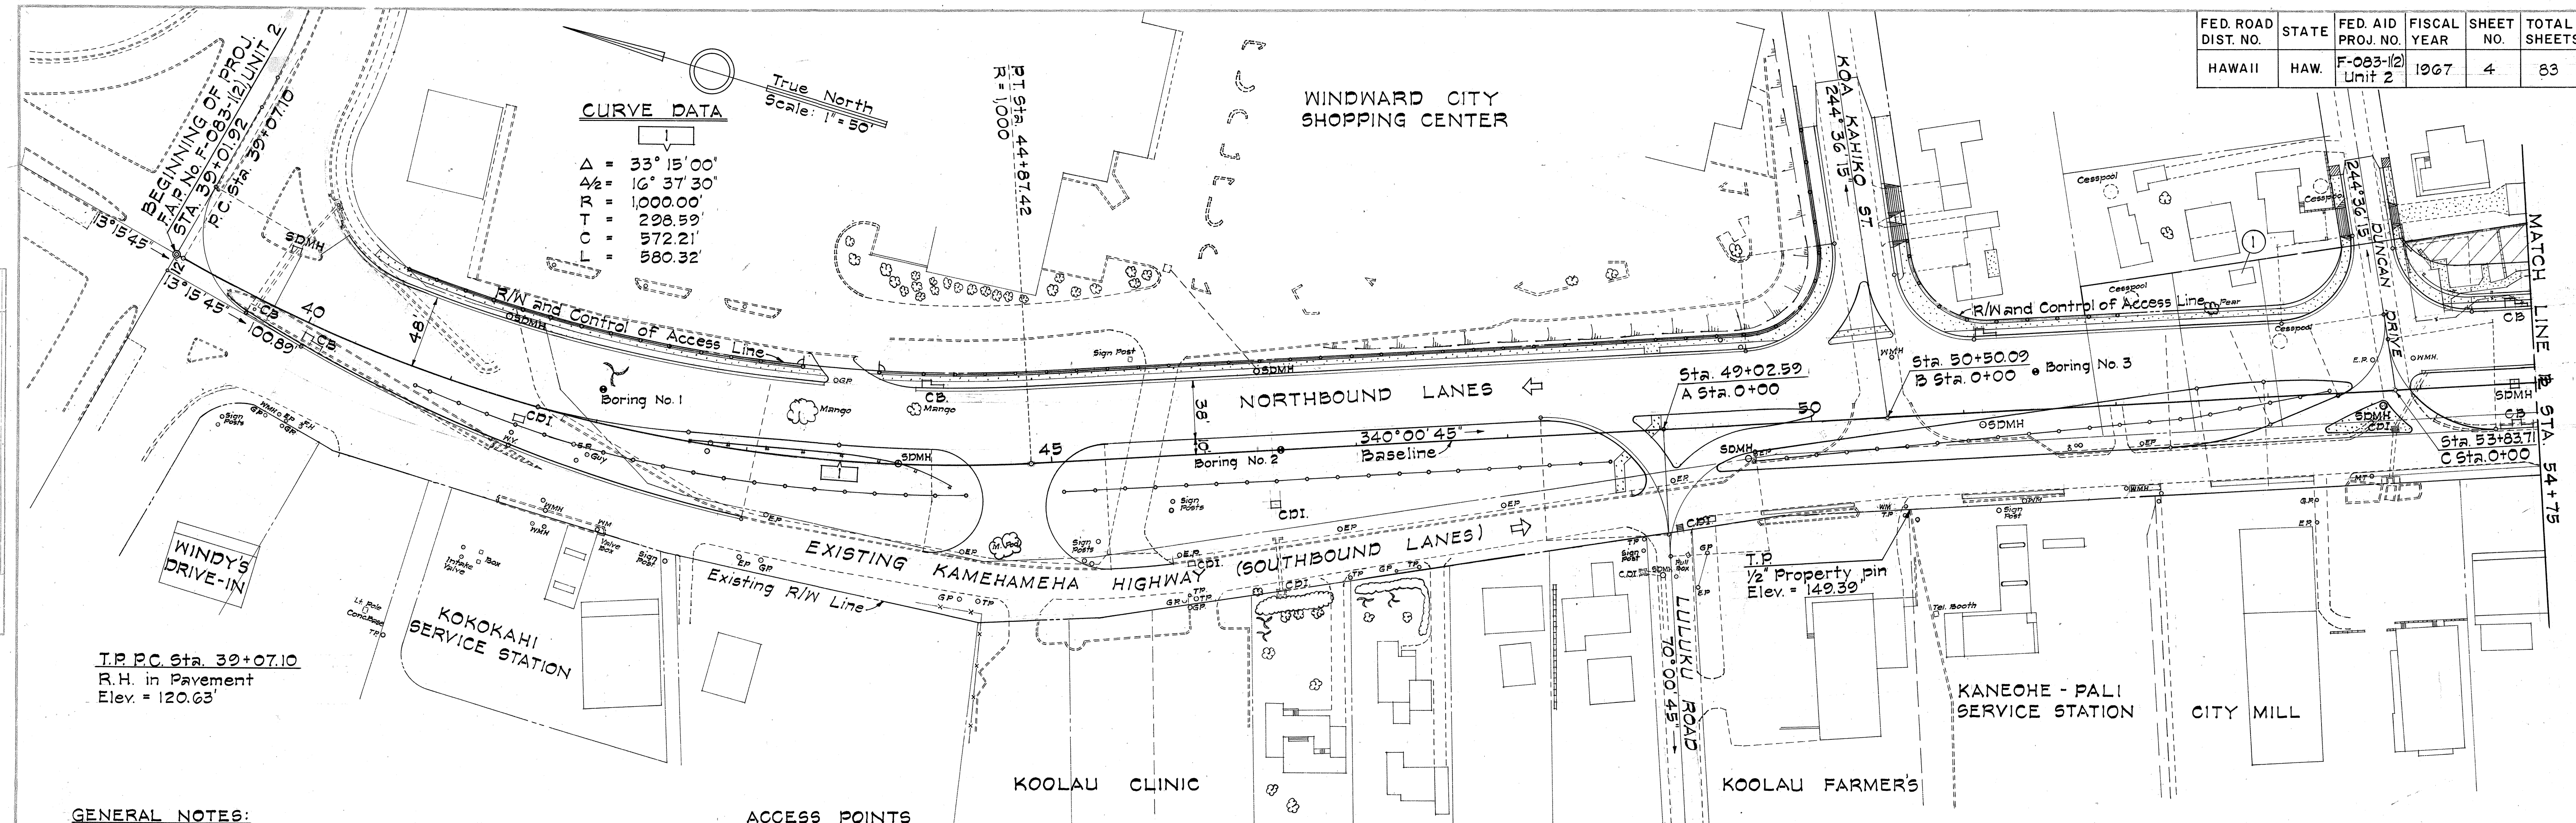


GENERAL NOTES:

1. Origin of Azimuths "Kailua A" and Coordinates referred to "Kailua A".
2. Contractor must contact the utility Companies where the utility facilities are affected by the construction.
3. Where new utility facilities or drainage culverts cross the existing Kamehameha Highway the pavement design for the restoration of the excavated pavement shall be the same as the Northbound lanes and the work involved shall be paid for under each respective item of work listed in the Proposal.
4. See sheets No. 7 to 11 for detailed roadway plans.
5. Curb Transitions between new and existing curb shall be made within a minimum of 20 feet.
6. Where new pavement meets the old pavement make smooth riding connections.
7. Highway Lighting System installation and relocation shall be done by others.

ACCESS POINTS



Station	Left	Right
40+31± to 46+50		2848±
43+58	50.00'	
50+31±	154.84'	
53+74±	40.00'	
56+48±	20.00'	
58+12±	20.00'	
59+01±	77.42'	
60+98±	20.00'	
62+93±	43.39'	
64+60±	20.00'	
65+50±	60.00'	

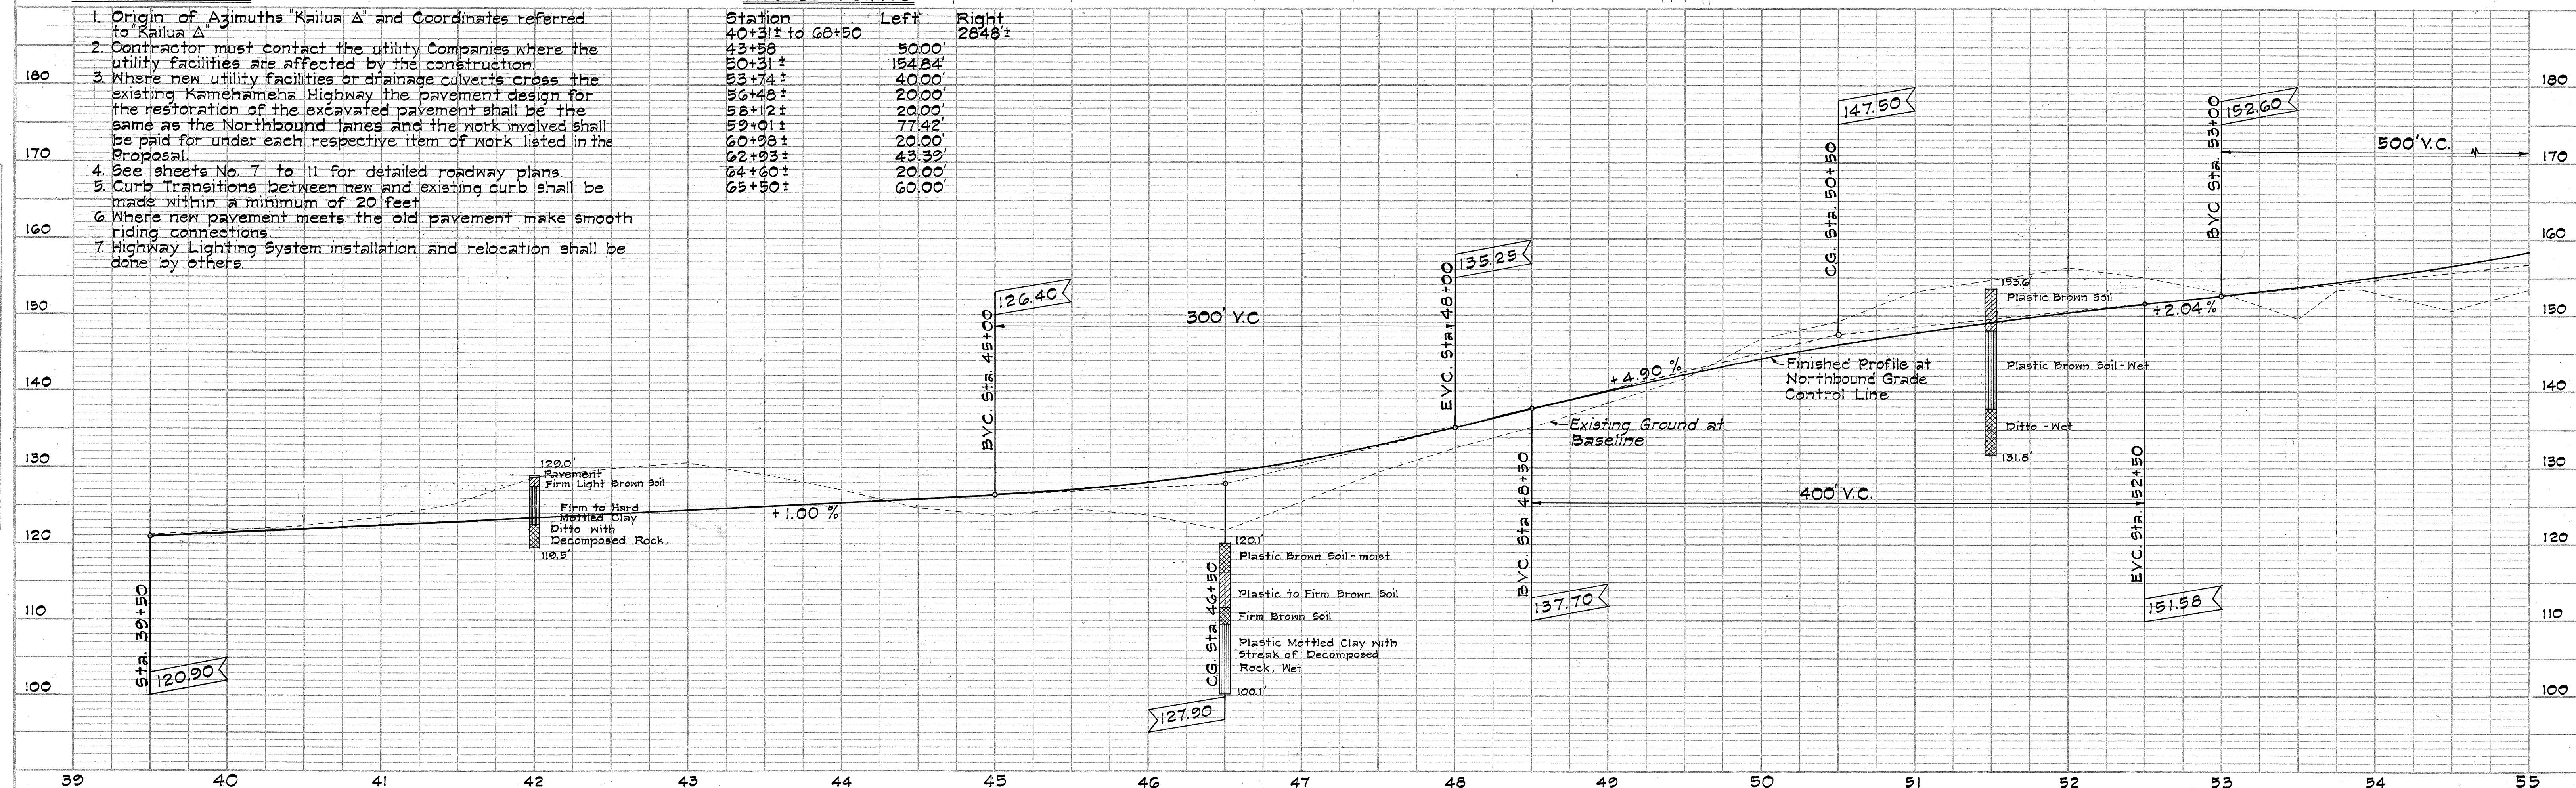

00-12-4

PLAN	SURVEYED	DATE	BY
	NOTED		
	NOTED		
	NOTED		


PROFILE	SURVEYED	DATE	BY
	NOTED		
	NOTED		
	NOTED		

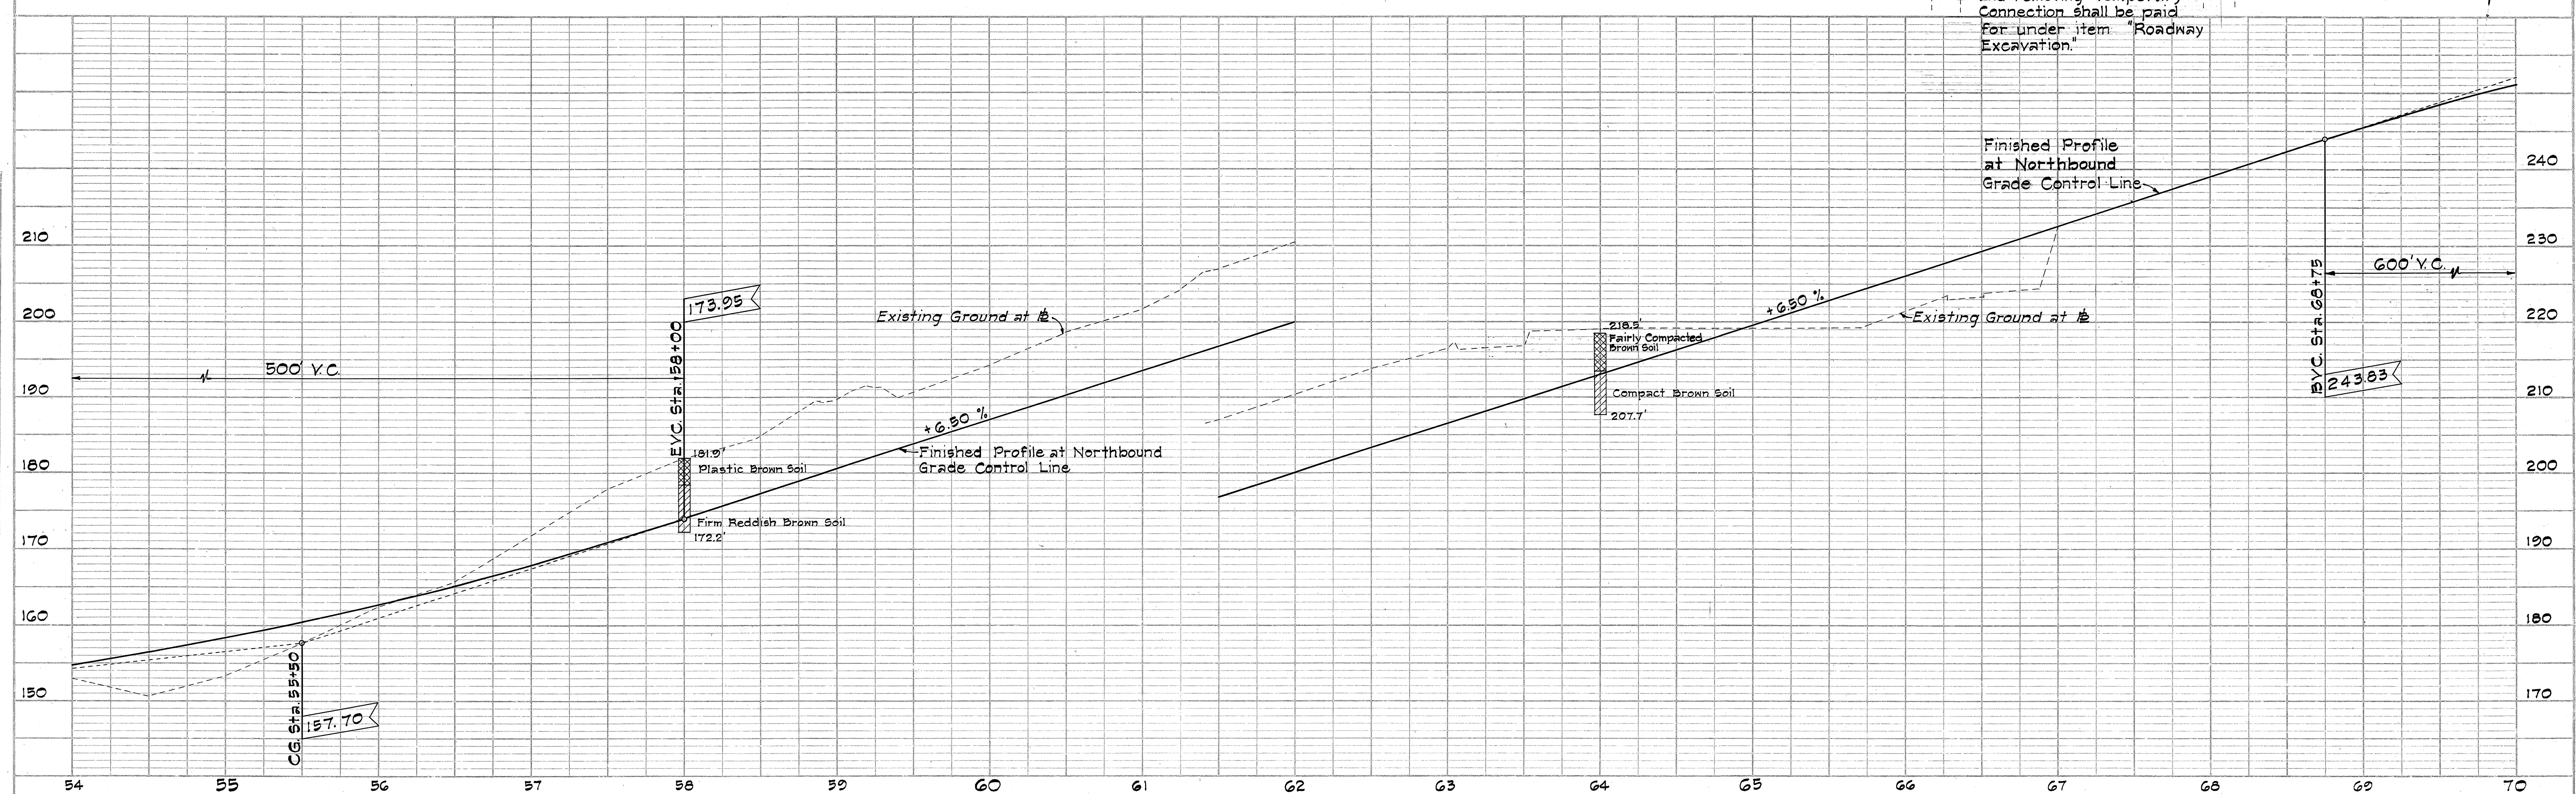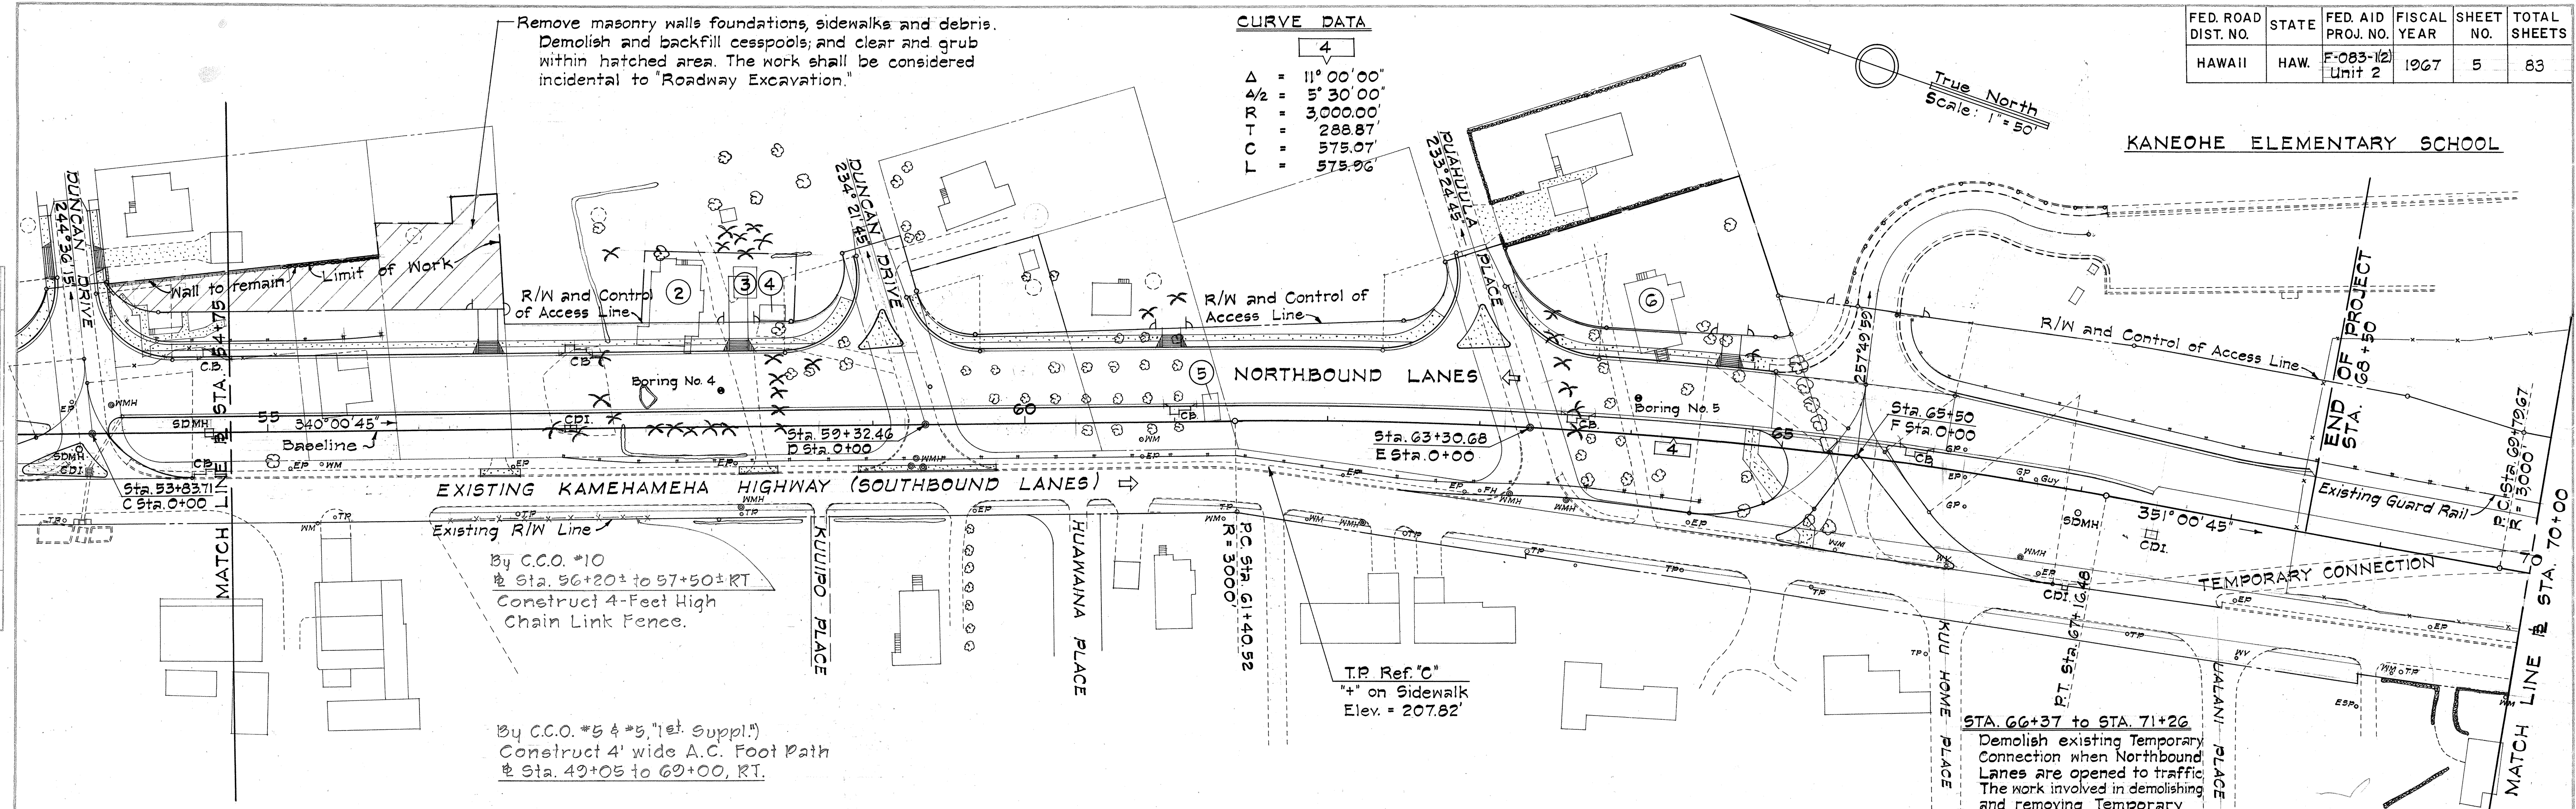

FED. ROAD DIST. NO.	STATE	FED. AID PROJ. NO.	FISCAL YEAR	SHEET NO.	TOTAL SHEETS
HAWAII	HAW.	F-083-1(2) Unit 2	1967	6	83

CURVE DATA

Δ = 21° 16' 00"
 $\Delta/2$ = 10° 38' 00"
 R = 3000.00'
 T = 563.24'
 C = 1,107.14'
 L = 1,113.52'

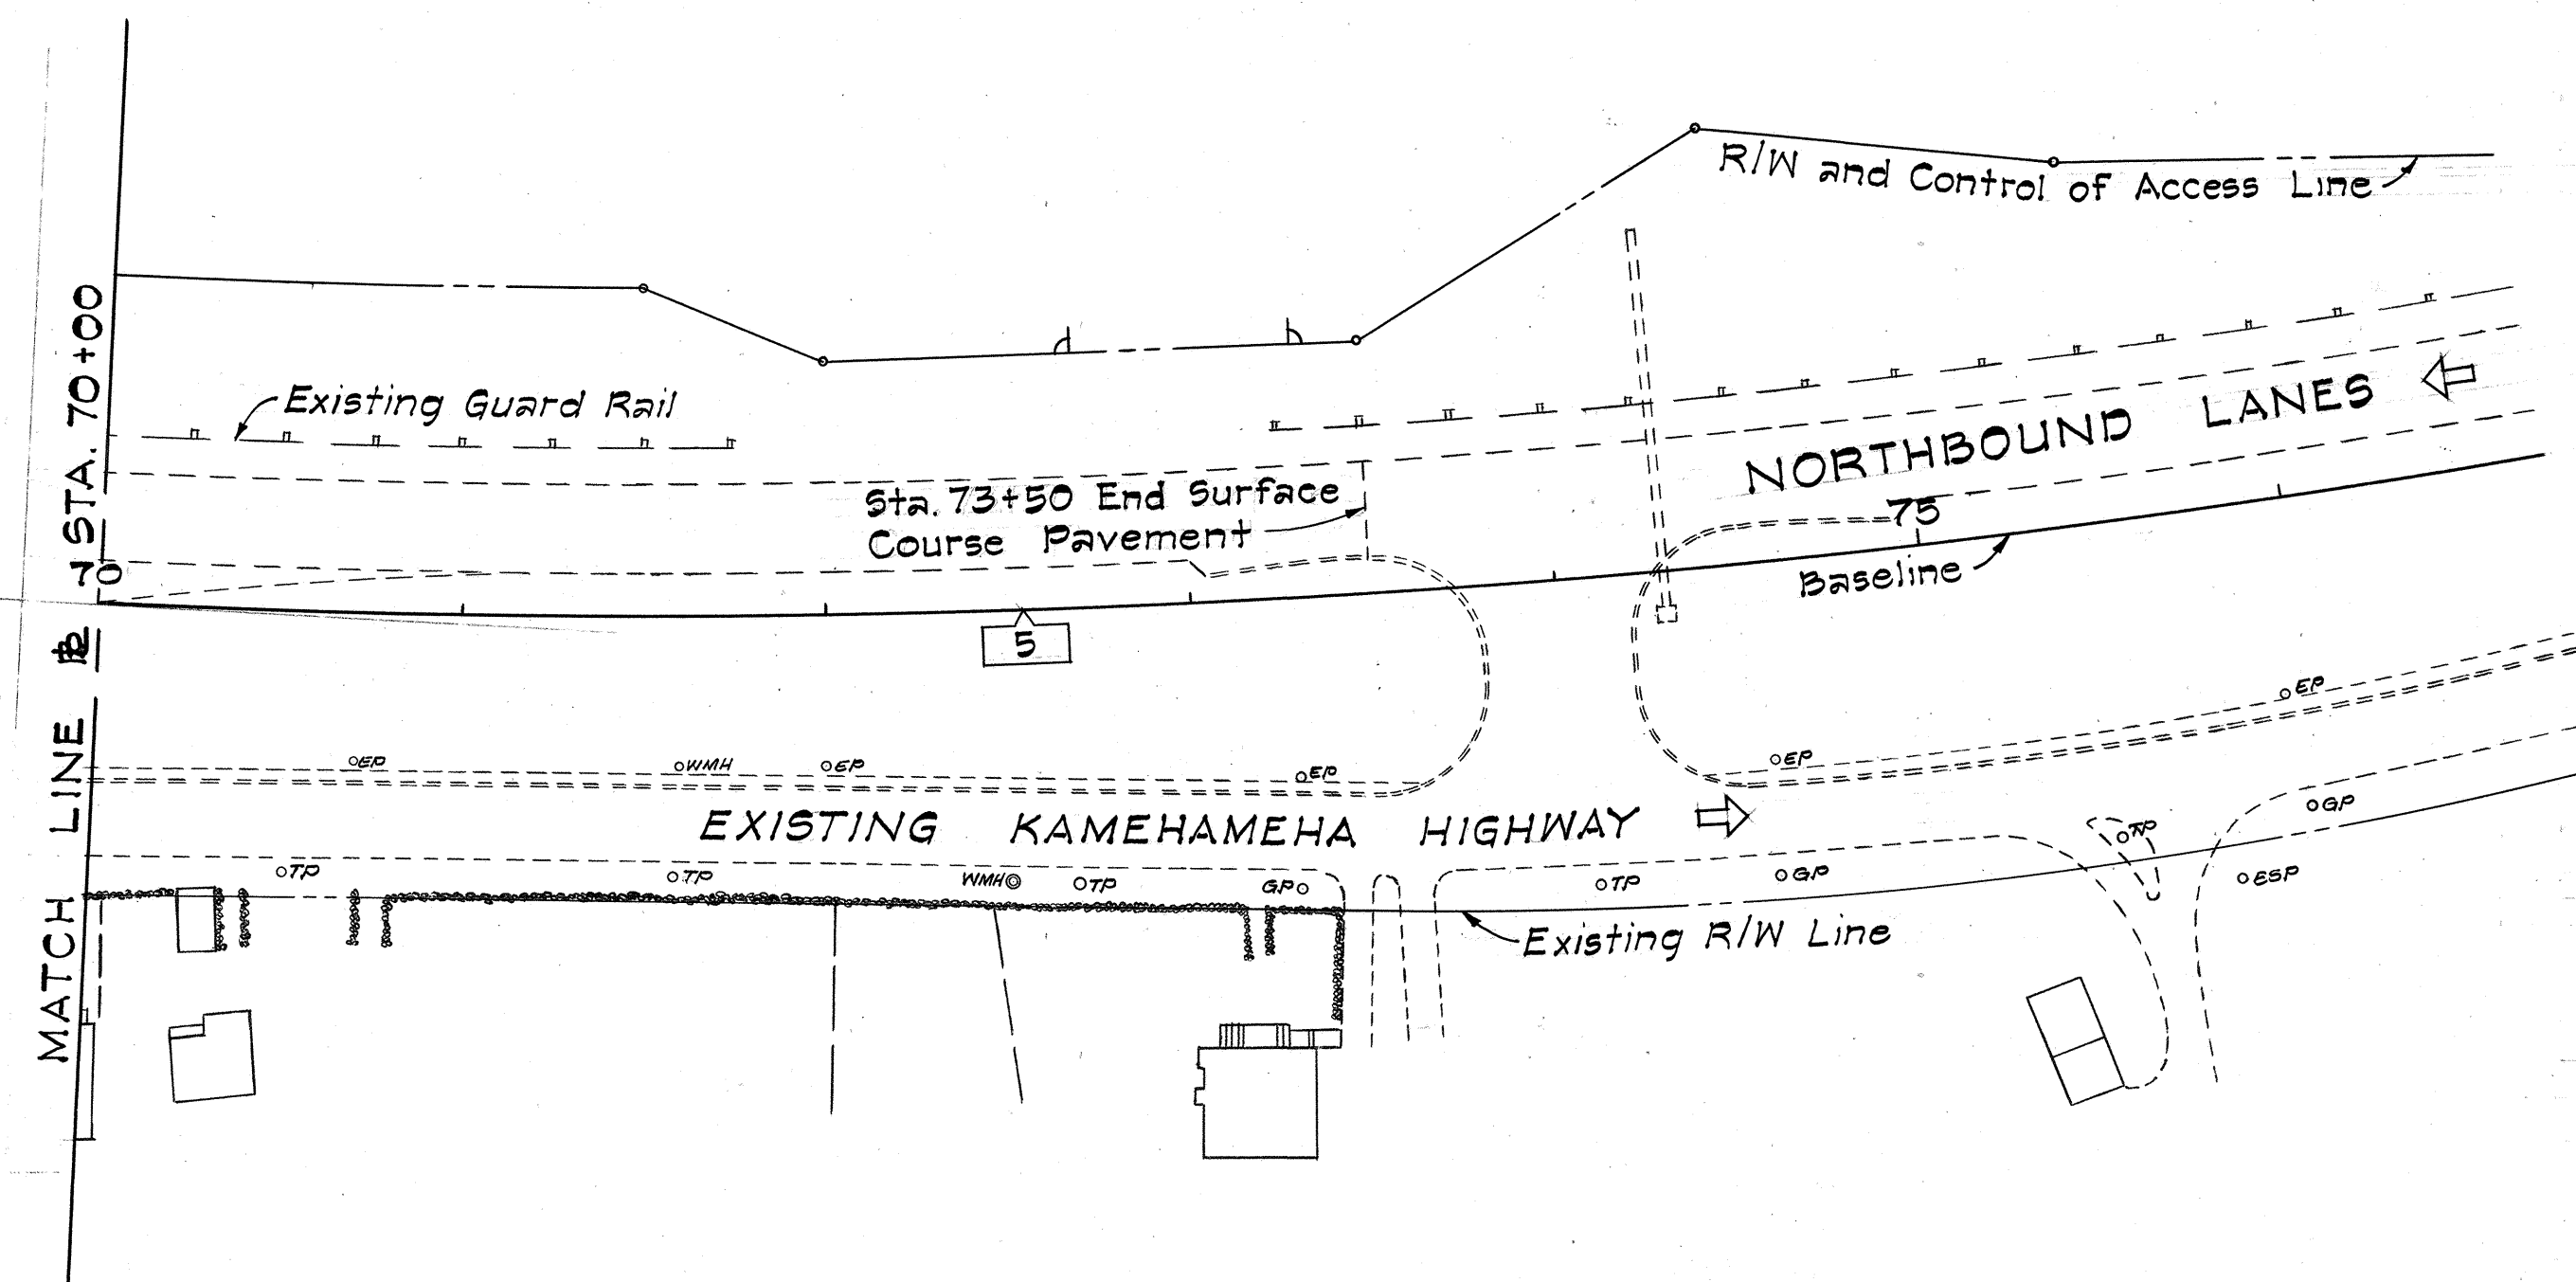

B.M. #4
 on gas pump foundation
 of Kaneohe Fender and
 Welding Shop (Shell Service
 Station near Sta. 80+00 for
 Proj. F-083-1(2), Unit 1)
 Elev. = 262.83'

