

INDEX TO DRAWINGS	
SHEET NO.	DESCRIPTION
1	Title Sheet
2-3	Typical Sections
4-6	Plan and Profile
7-11	Detail Roadway Plan
12	Superelevation Diagram
13-22	Misc. Roadway Details
23-25	Retaining Wall Details
*26-43	Utility Plans and Details
44-58	Drainage Plans and Details
59-72	Traffic Signing Plans and Details
73-74	Landscaping Plans
**75-83	Cross Sections
*	Utility Plans and Details
	CO 26S, CO 27S, CO 28S,
	CO 29S, CO 30S, CO 31S(1),
	CO 31S(2), CO 33S(1), CO 33S(2),
	CO 33S(3), CO 33S(4), CO 43S(1),
	CO 43S(2), CO 43S(3), CO 43S(4),
	CO 43S(5), CO 43S(6), CO 43S(7),
	CO 43S(8), CO 43S(9), CO 43S(10)
CO 84S	Kaneohe Elem. School Access
**CO 85S	Cross Section

STATE OF HAWAII

DEPARTMENT OF TRANSPORTATION

HIGHWAYS DIVISION

HONOLULU, HAWAII

"AS BUILT"

PLANS FOR

CONSTRUCTION OF

KAMEHAMEHA HIGHWAY

PALI GOLF COURSE TOWARD KANEOHE

(KANEOHE BAY DRIVE TO KANEOHE ELEMENTARY SCHOOL)

FEDERAL AID PROJECT NO. F-083-I(2), UNIT 2

AND

FEDERAL AID PROJECT NO. F-083-I(7)

DISTRICT OF KOOLAUPOKO

ISLAND OF OAHU

PLAN & PROFILE


HOR. 1" = 50'

VER. 1" = 10'

CROSS SECTION

HOR. 1" = 10'

VER. 1" = 10'

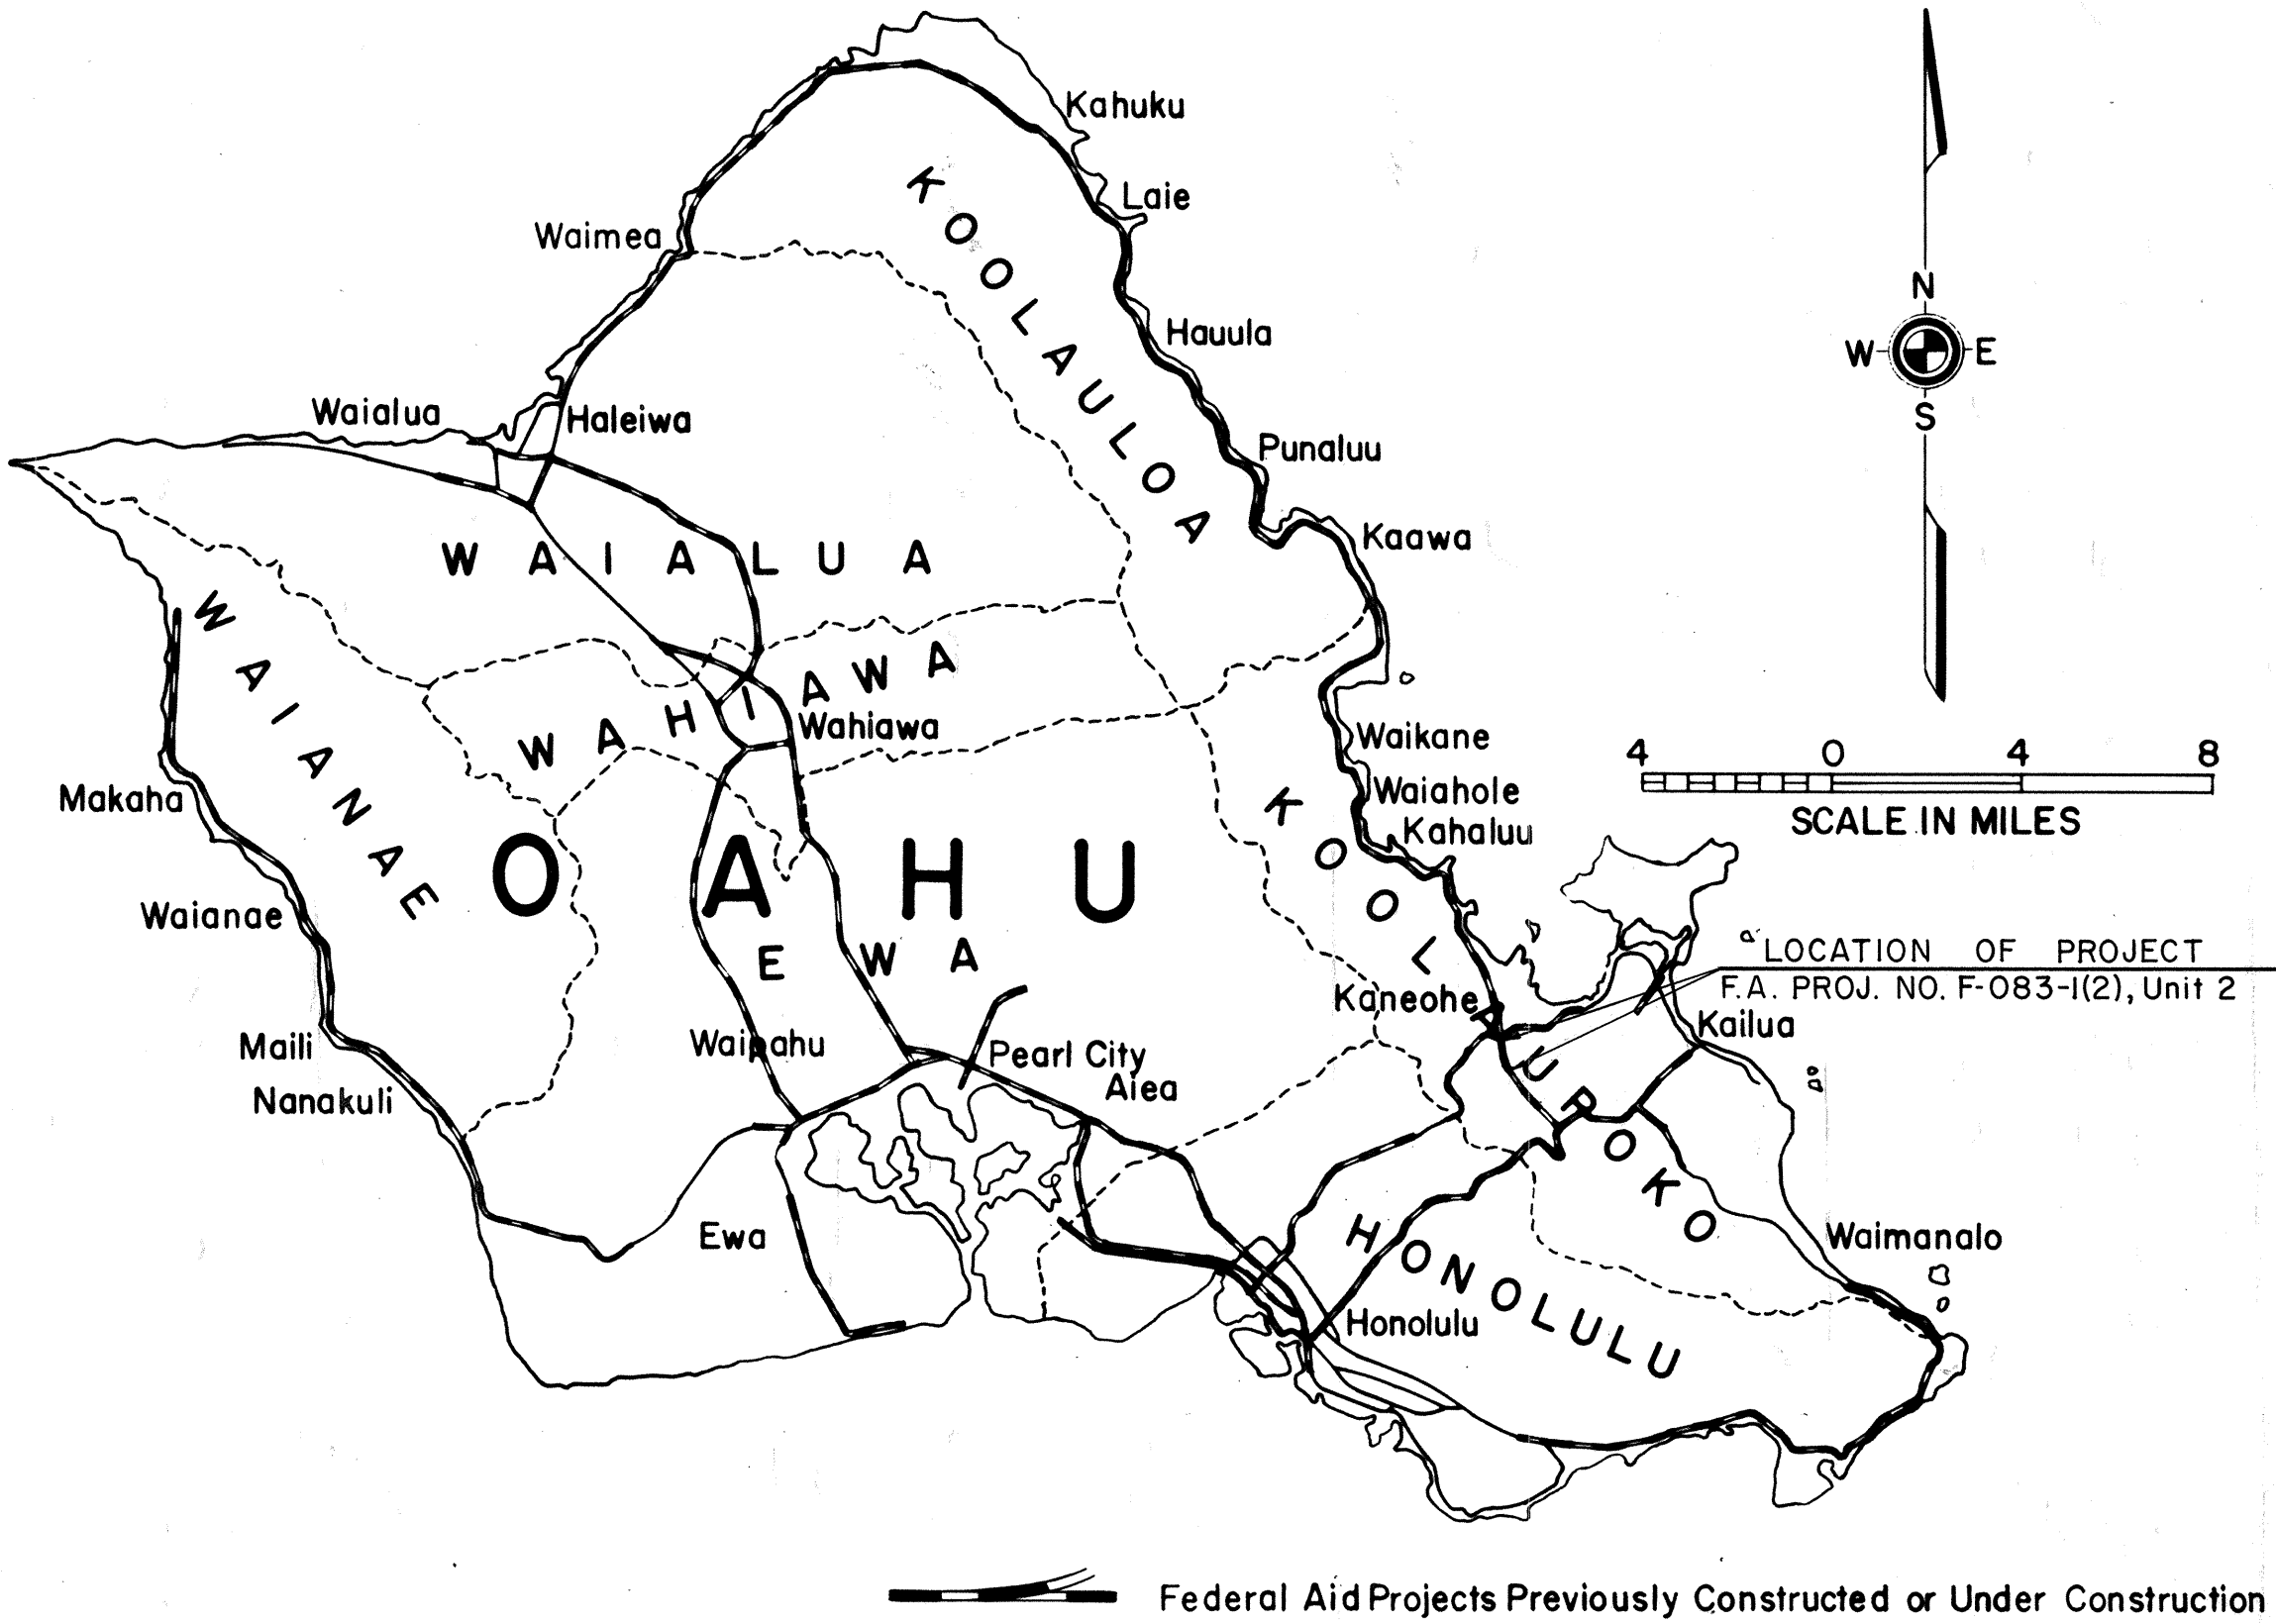

NOTE:


ALL CHANGES MADE DURING CONSTRUCTION HAVE BEEN NOTED IN RED ON THESE TRACINGS AND CHECKED BY:

H. Hasuike

PROJECT ENGINEER

10/22/71

DATE

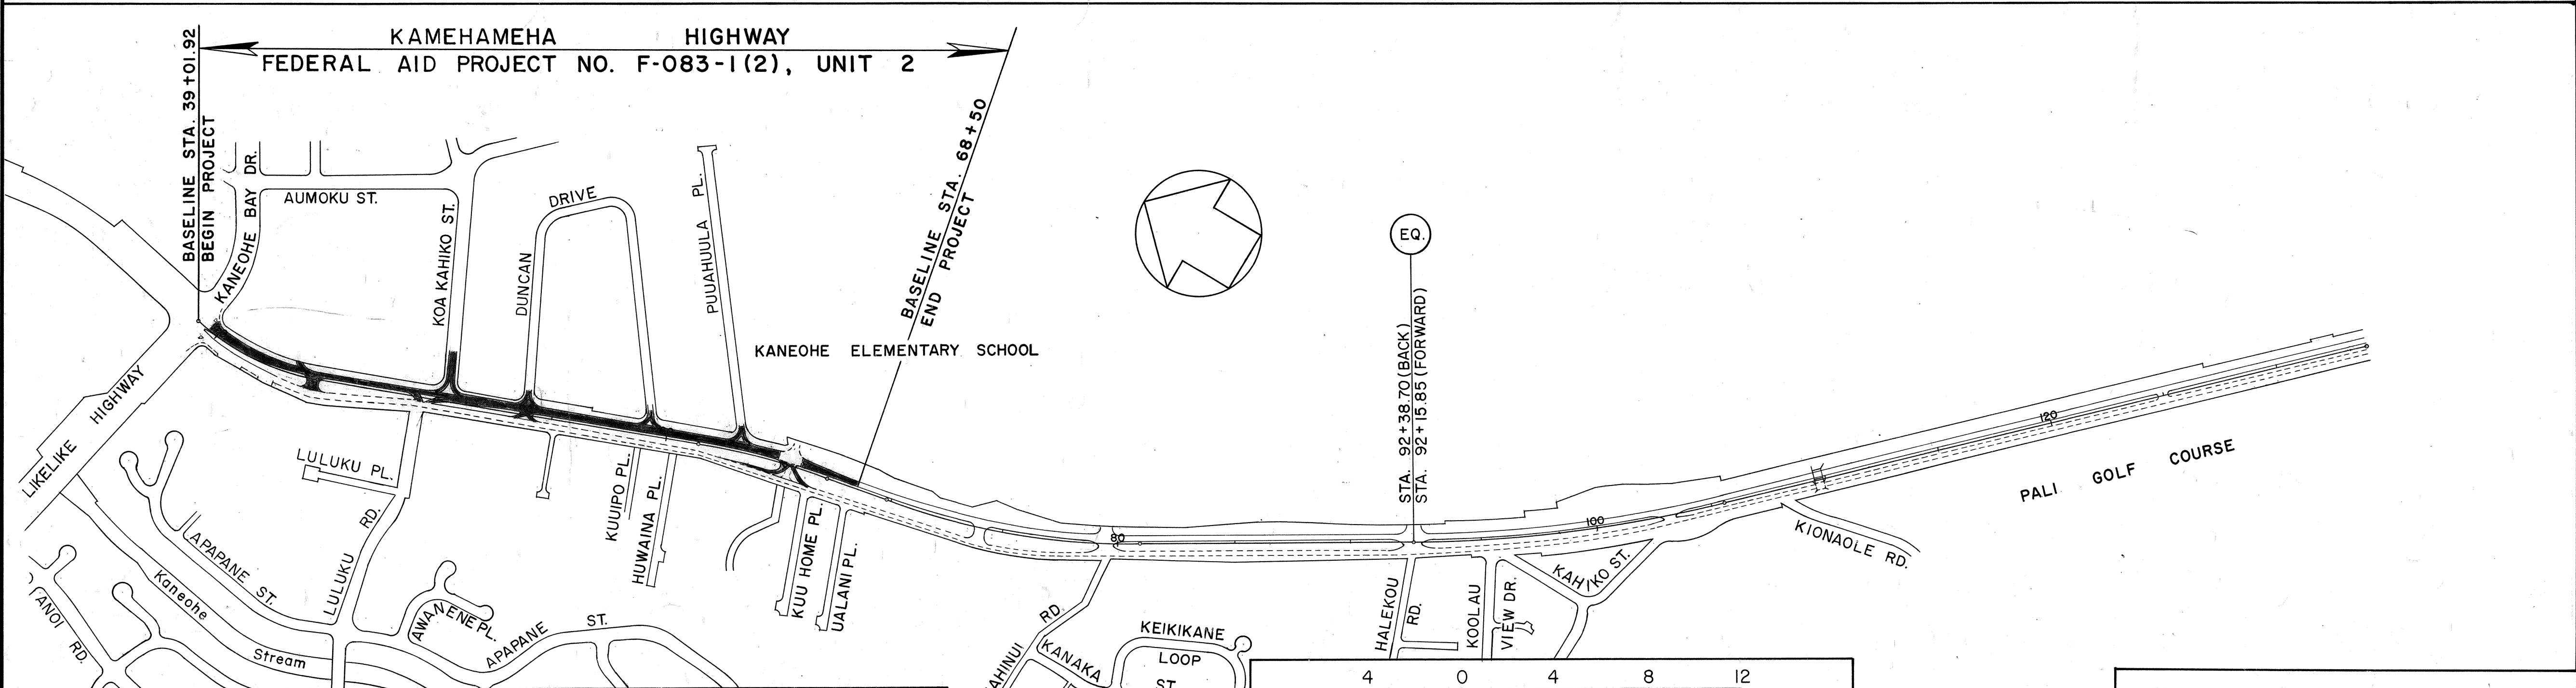

DESIGN CLASSIFICATION			
ADT (1968)	17,600	D	60/40
DESIGN ADT (1988)	31,850	T	3.5 %
DHV	2,900	V	40 M.P.H.

LAYOUT PLAN	
GROSS LENGTH OF PROJECT	0.558 Mi.
BRIDGES OVER 20.00' SPAN	0.000 Mi.
NET LENGTH OF ROADWAY	0.558 Mi.

DEPARTMENT OF TRANSPORTATION

BUREAU OF PUBLIC ROADS

APPROVED:

John M. [Signature]

10/25/67

DATE

DEPARTMENT OF TRANSPORTATION

STATE OF HAWAII

APPROVED:

John M. [Signature]

10/16/67

DATE

S.F. Yuen

DESIGN ENGR.

50511 Local 301

PHONE

Aug. 1967

DATE