

INDEX TO DRAWINGS	
SHEET NO.	DESCRIPTION
1	Title Sheet
2-14	Roadway Plans
15	Raised Pavement Markers

STATE OF HAWAII

DEPARTMENT OF TRANSPORTATION

HIGHWAYS DIVISION

HONOLULU, HAWAII

"AS-BUILT"

PLANS FOR



RESURFACING A PORTION OF

KAMEHAMEHA HIGHWAY

Waiahole Valley Road Toward Kahana Bay

PROJECT NO. 83E-02-68

DISTRICTS OF KOOLAUPOKO AND KOOLAULOA  
ISLAND OF OAHU

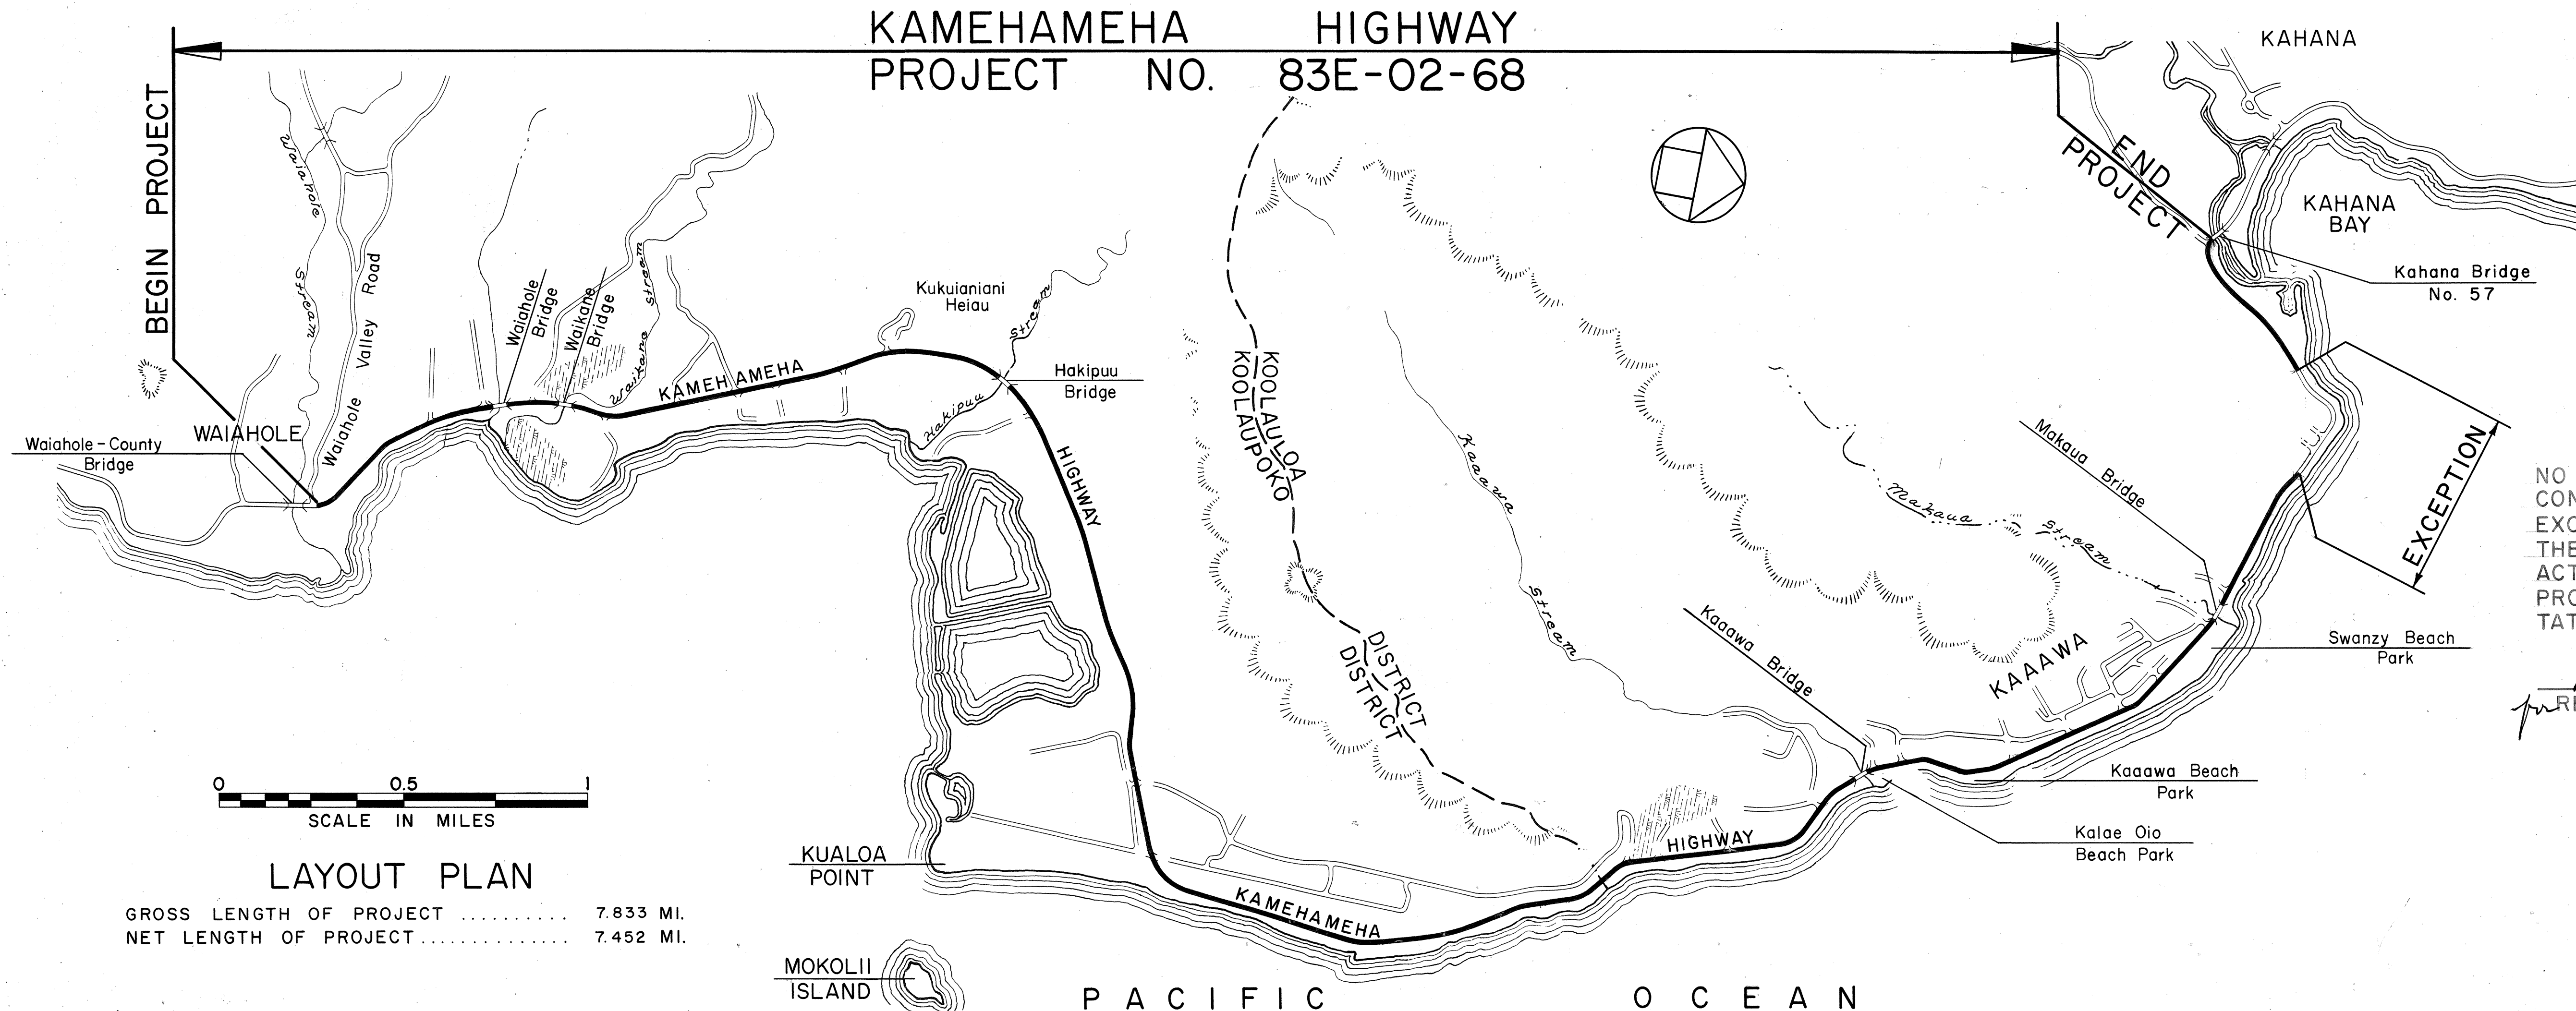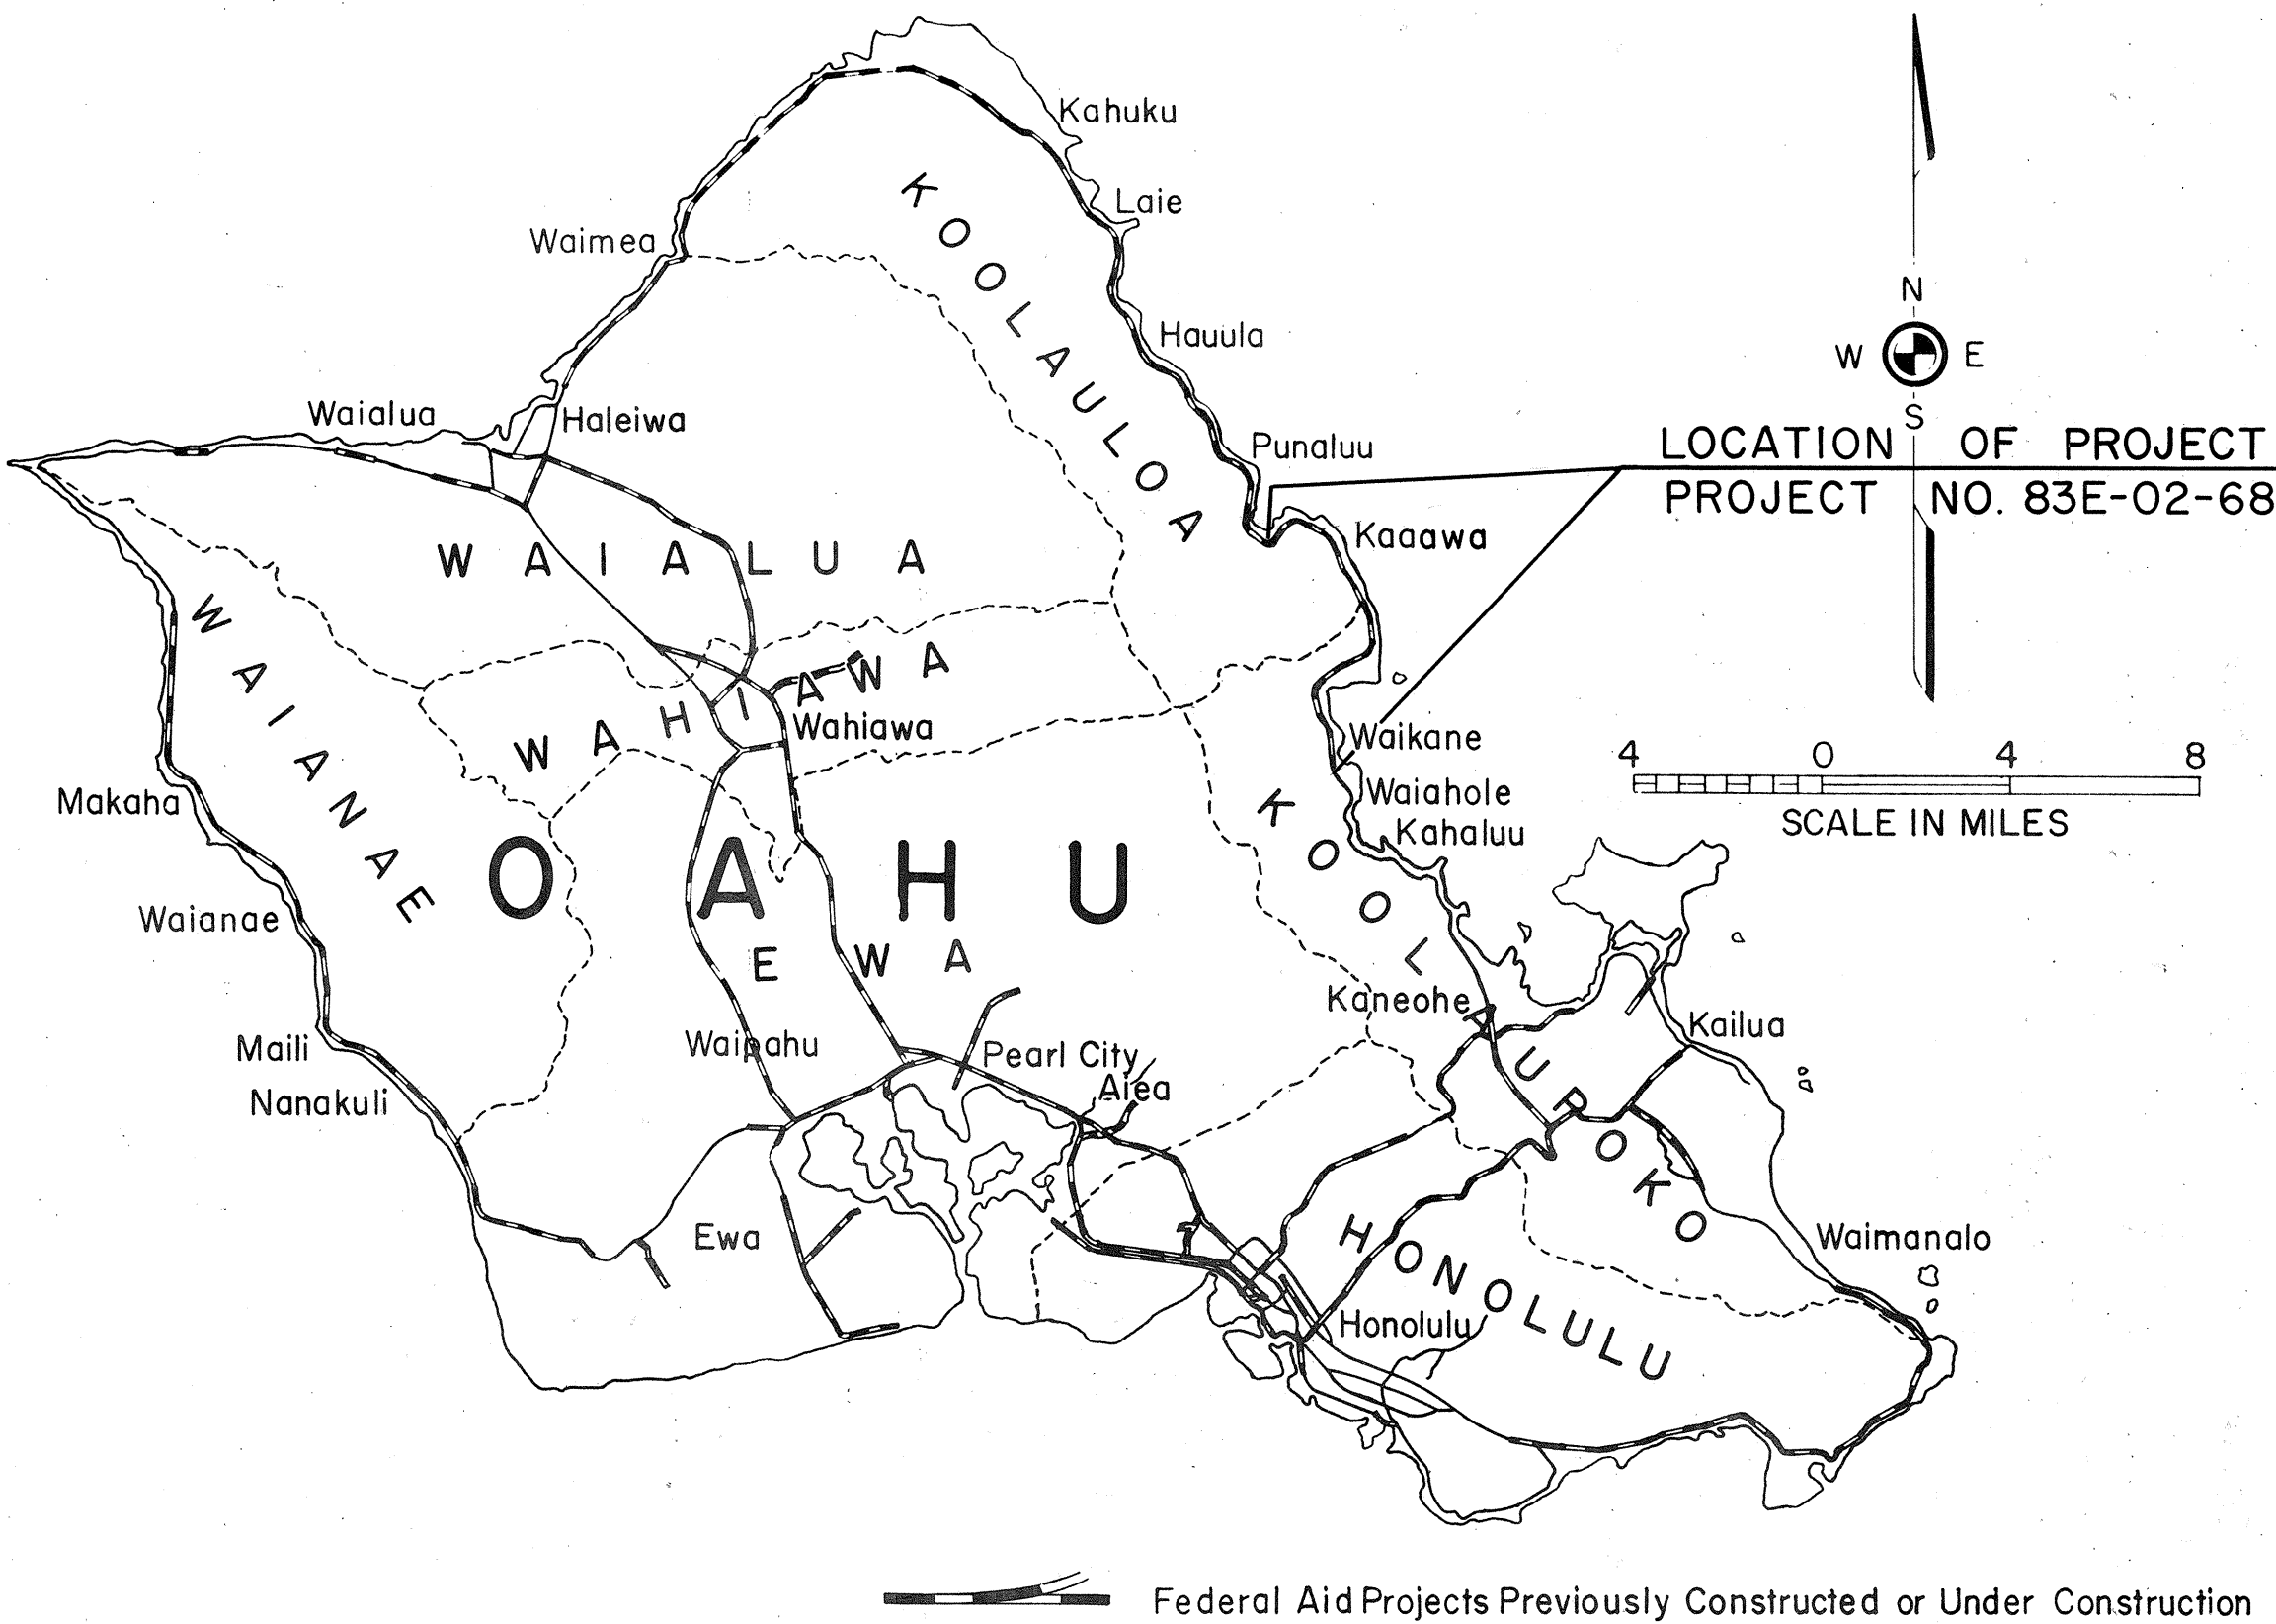

LAYOUT PLAN

GROSS LENGTH OF PROJECT . . . . . 7.833 MI.

NET LENGTH OF PROJECT . . . . . 7.452 MI.

NO CHANGES WERE MADE DURING CONSTRUCTION ON THESE PLANS EXCEPT CHANGES IN THE ORIGINAL THEORETICAL QUANTITIES. FOR ACTUAL QUANTITIES, REFER TO PROJECT LEDGER AND/OR COMPUTATION BOOK.

*R. T. Jansen*

for

PRESIDENT ENGINEER

11-9-81

DATE

DEPARTMENT OF TRANSPORTATION

STATE OF HAWAII

APPROVED:

*John M. Smith*

2/23/68

DIRECTOR OF TRANSPORTATION

DATE