	NDEX TO DRAWINGS
SHEET NO.	DESCRIPTION
www.com.	TITLE SHEET
2-3	FOOTBRIDGE DETAILS
<u> </u>	
	•
	1
*	No.
-	

STATE OF HAWAII

DEPARTMENT OF TRANSPORTATION

HIGHWAYS

DIVISION


HONOLULU, HAWAII

"AS BUILT" PLANS OF

KAMEHAMEHA HIGHWAY, VICINITY OF WAIKANE (FOOTBRIDGES)

PROJECT NO. 83E-04-68

DISTRICT OF KOOLAUPOKO ISLAND OF OAHU

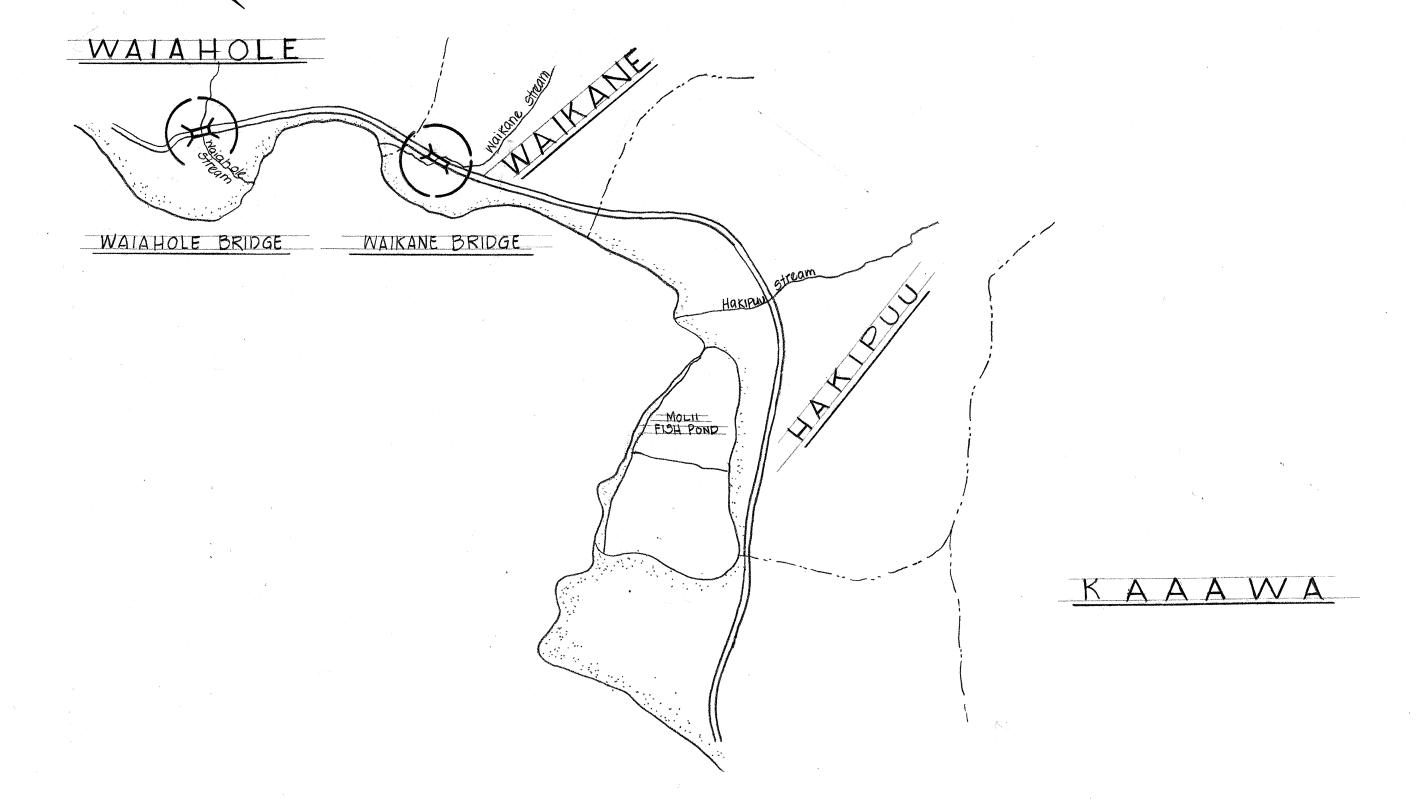

NO CHANGE WAS MADE DURING

FED. ROAD DIST. NO.

> Project Nº 83E-04-68

Federal Aid Projects Previously Constructed or Under Construction

PROJ. NO. YEAR NO. SHEETS

CONSTRUCTION OF THIS PROJECT.

R-T. Incom
11-10-81

PRESIDENT ENGINEER DATE

LAYOUT OF PROJECT

DEPARTMENT OF TRANSPORTATION
STATE OF HAWAII

APPROVED

DIR. OF TRANSPORTATION DATE

01-9-7