


[illegible]

STATE OF HAWAII
DEPARTMENT OF TRANSPORTATION
HIGHWAYS DIVISION
HONOLULU, HAWAII

PLANS FOR
CONSTRUCTION OF
KAMEHAMEHA HIGHWAY
PALI GOLF COURSE TOWARD KANEOHE
(PEDESTRIAN OVERPASS AT KANEOHE ELEMENTARY SCHOOL)
FEDERAL AID PROJECT NO. F-083-1(2), UNIT 3

DISTRICT OF KOOLAUPOKO
ISLAND OF OAHU


FED. ROAD DIST. NO.	STATE	FED. AID PROJ. NO.	FISCAL YEAR	SHEET NO.	TOTAL SHEETS
HAWAII	HAW.	F083-12 UNIT 3	1968	1	16

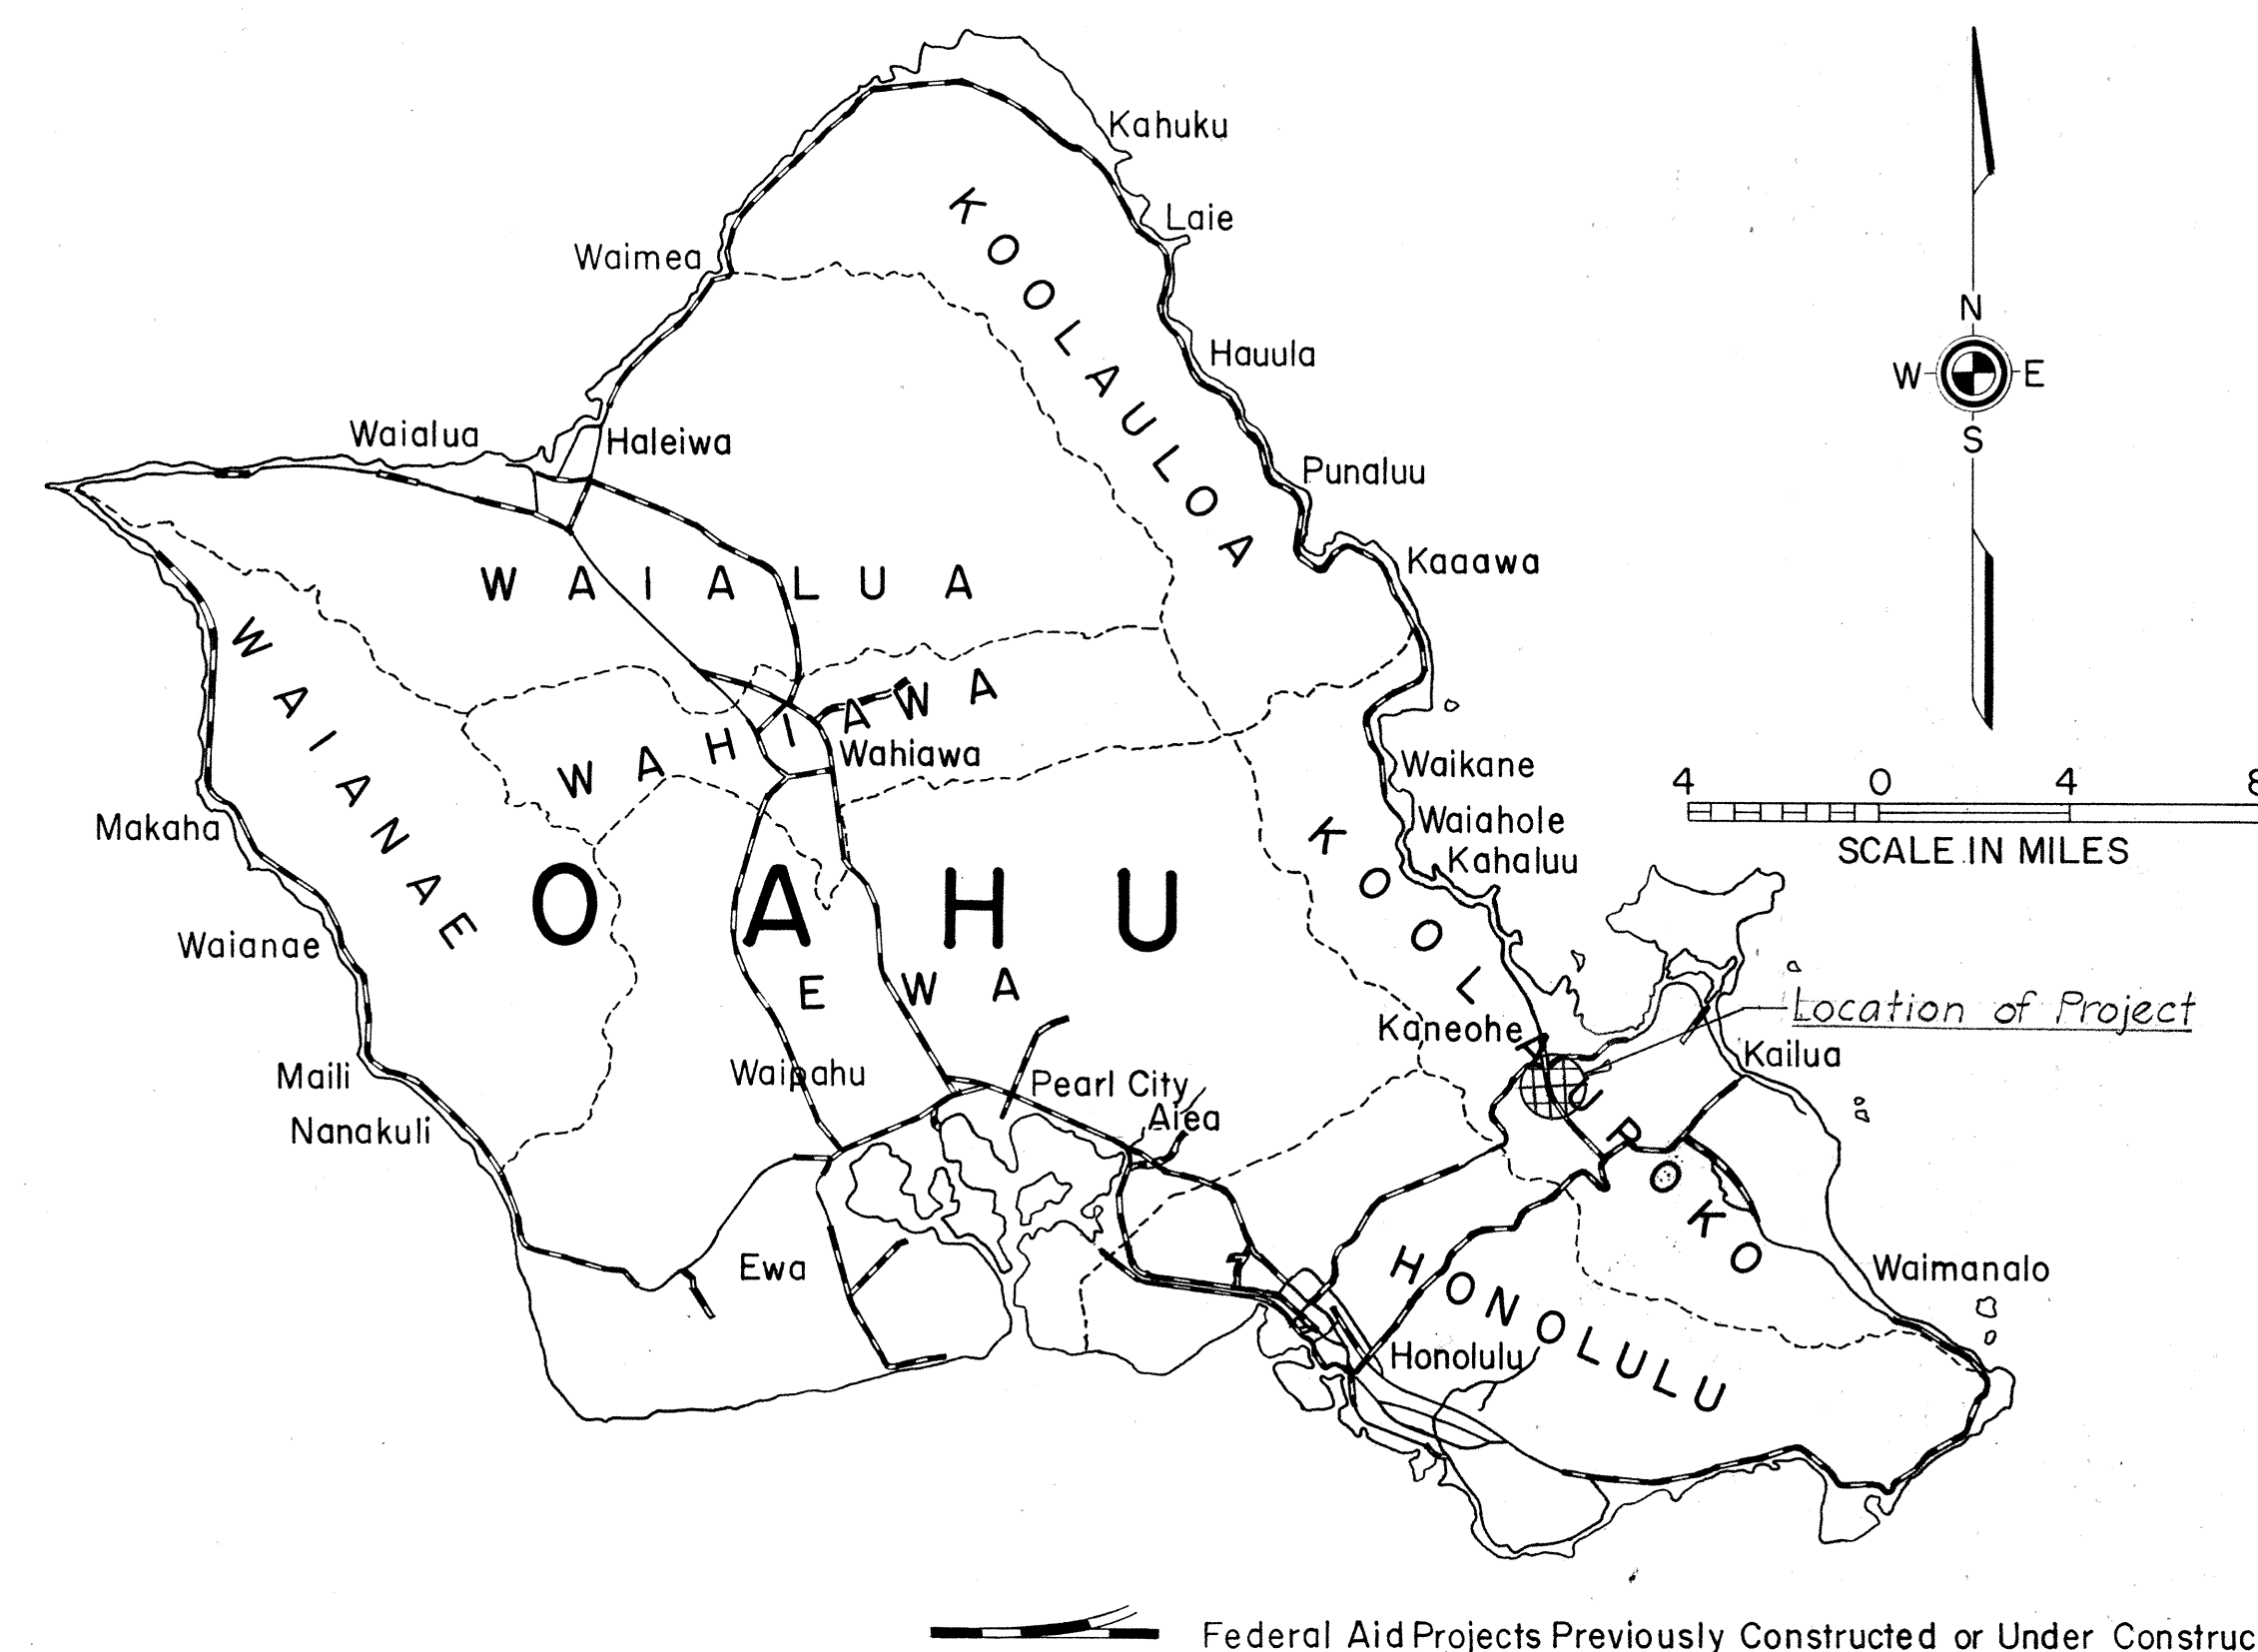

NO AS-BUILT CHANGES

H. Asmita 7/5/73
PROJECT ENGINEER DAT

DESIGN CLASSIFICATION
ADT (1968)-----17,600
V-----40 M.P.H.

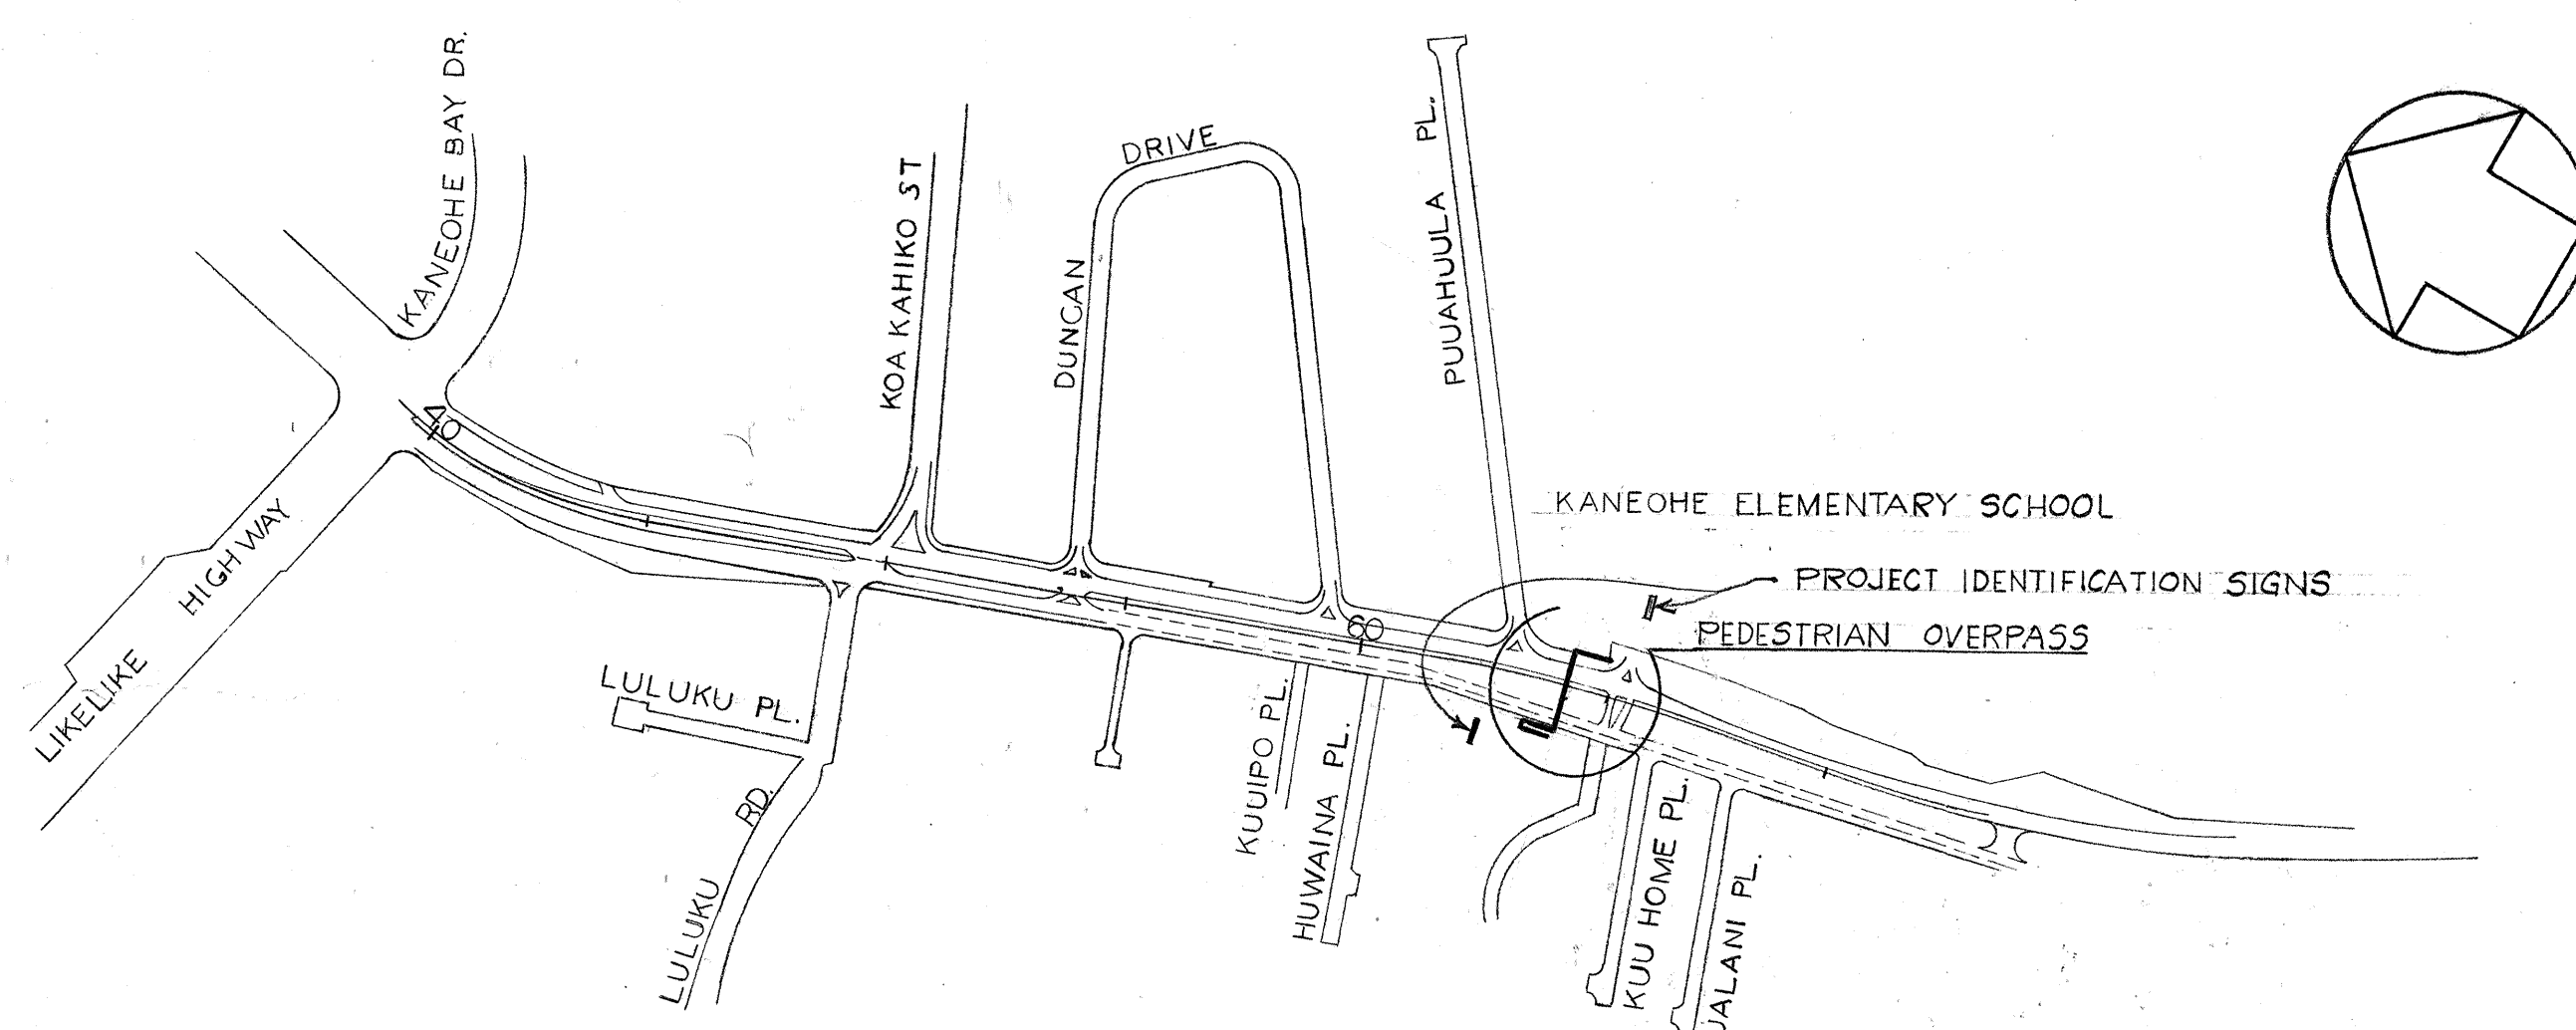


LAYOUT PLAN



SCALE IN HUNDRED FEET

LENGTH OF PROJECT-----0.0 MI.

DEPARTMENT OF TRANSPORTATION BUREAU OF PUBLIC ROADS	
APPROVED:	
 DIVISION ENGINEER	6-14-6 DATE

 DEPARTMENT OF TRANSPORTATION STATE OF HAWAII	
APPROVED:  Tania Watanabe DIR. OF TRANSPORTATION DATE	
SHEET No. 1 OF 16 SHEETS	