



REV. Oct. 1968


FED. ROAD DIST. NO.	STATE	PROJ. NO.	FISCAL YEAR	SHEET NO.	TOTAL SHEETS
HAWAII	HAW.	GD 65-335	1968	3	12

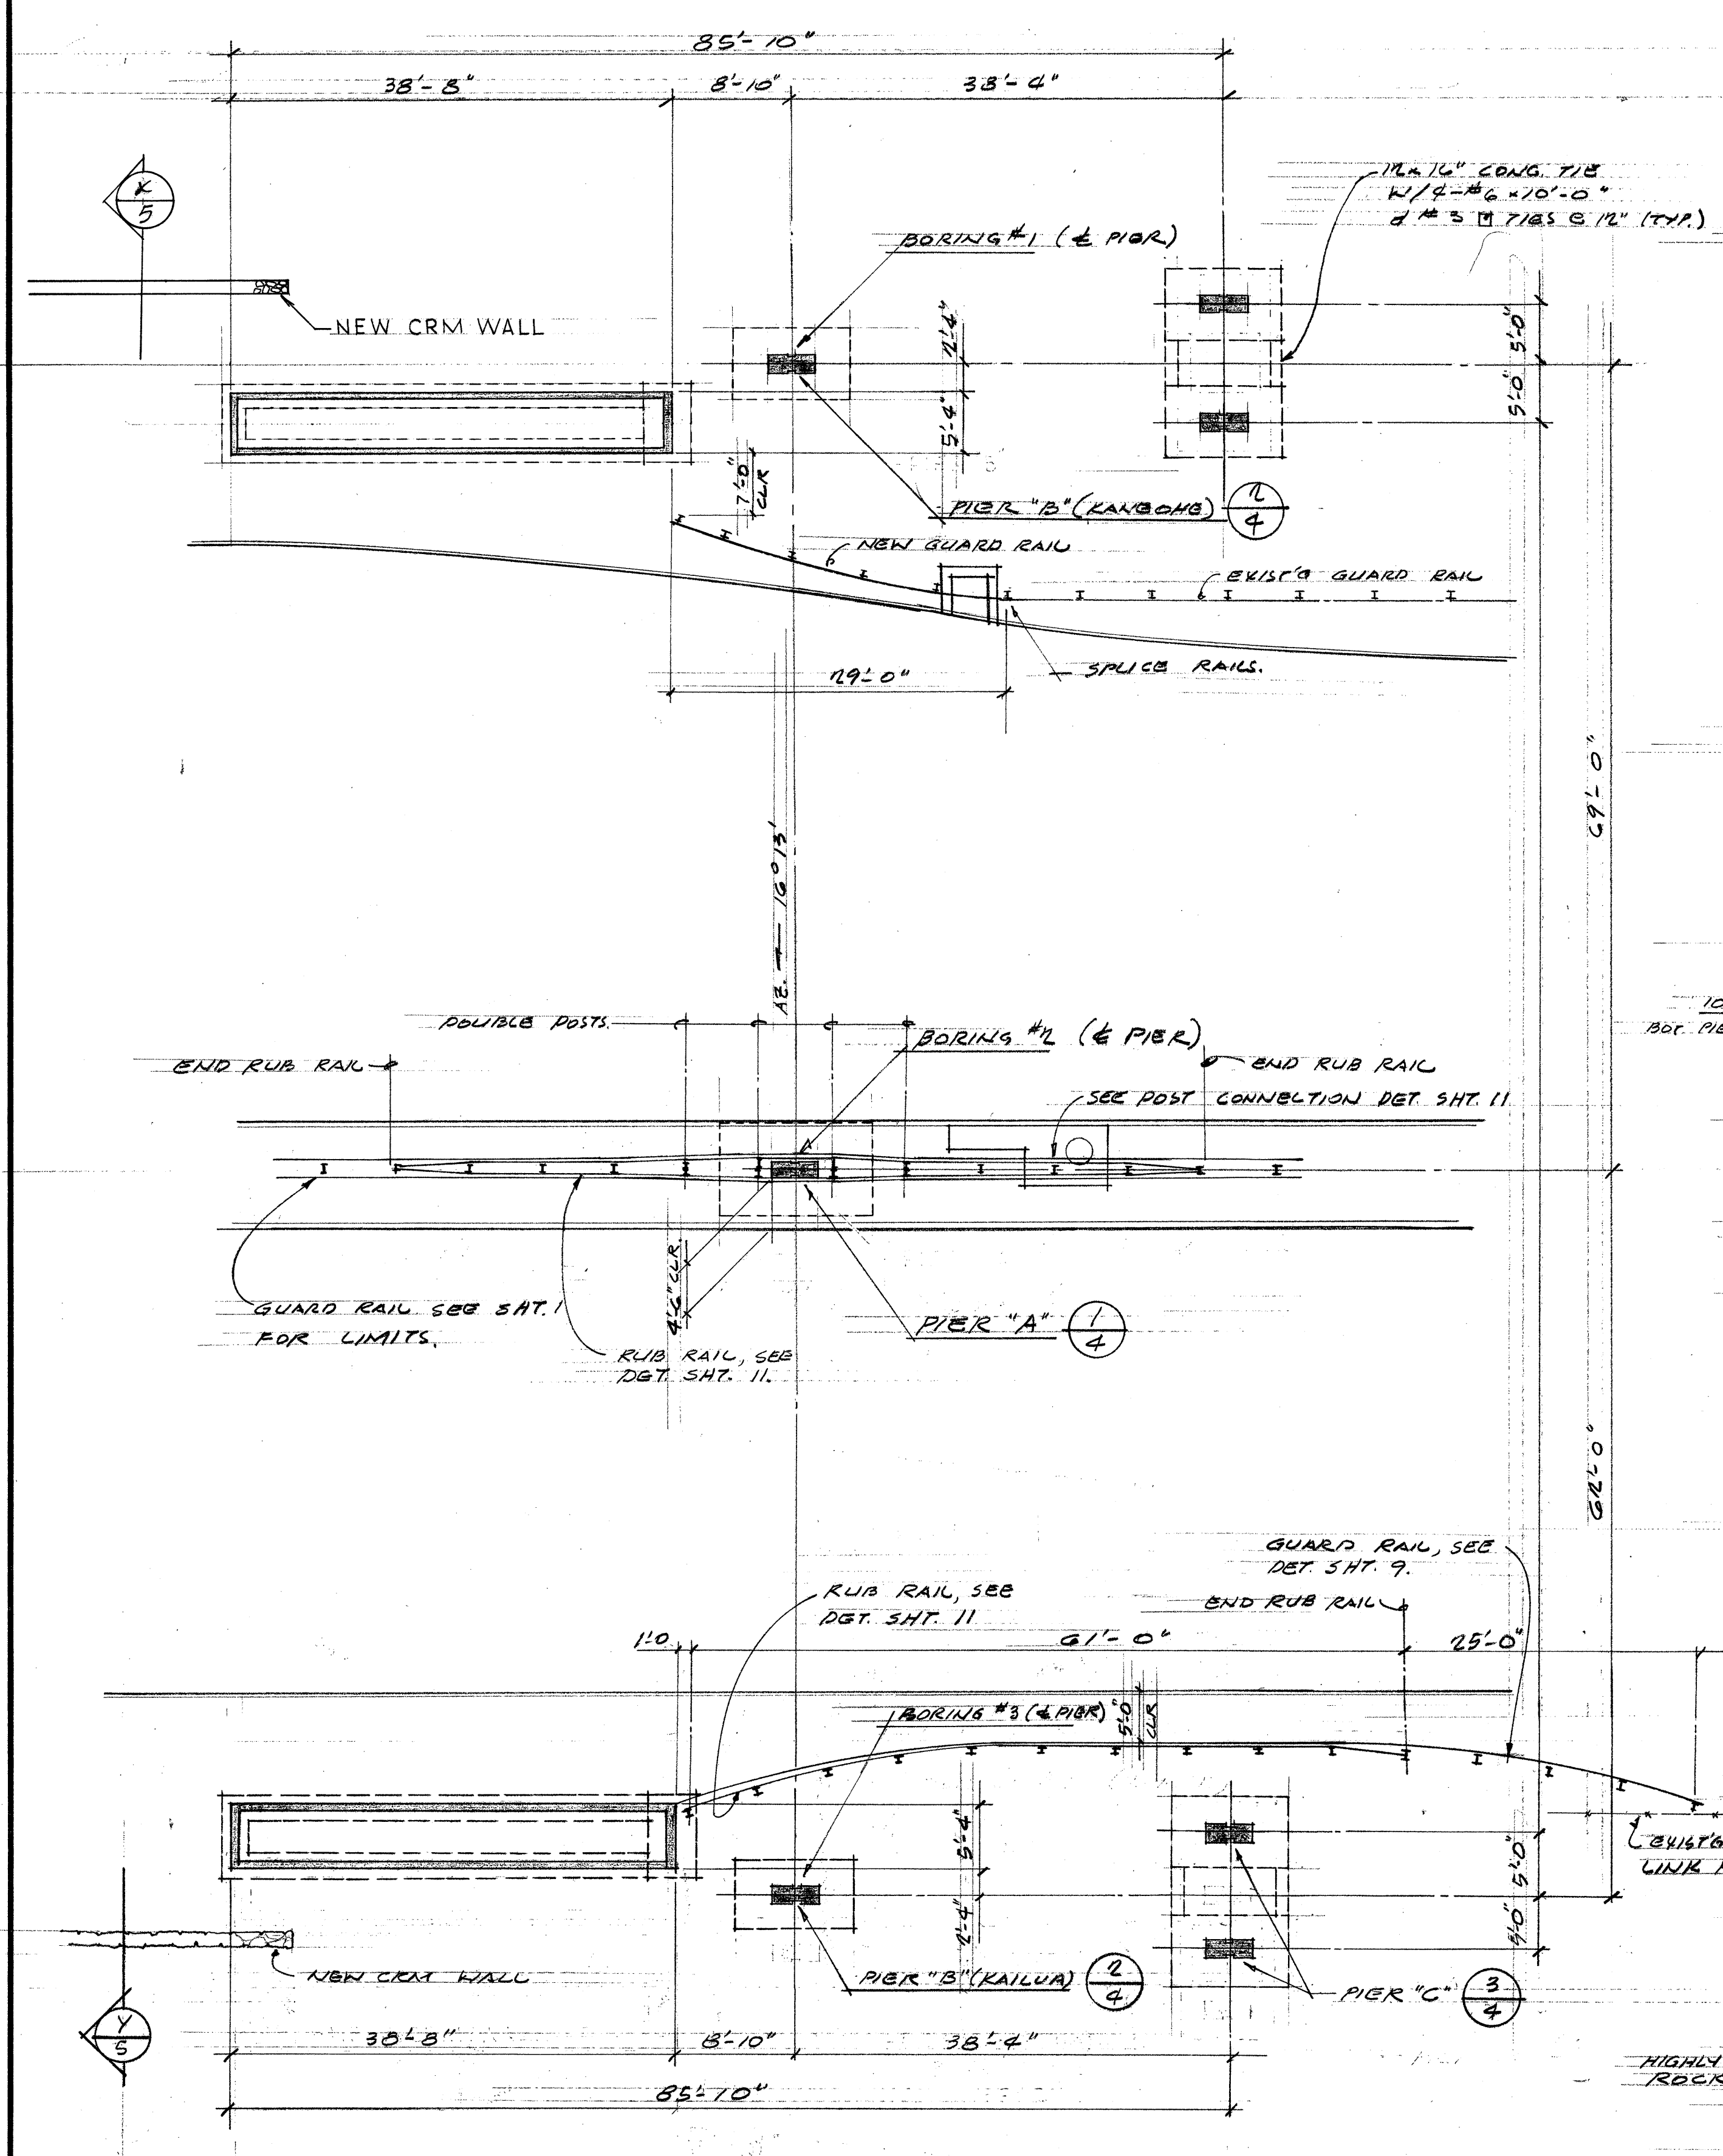


FOUNDATION PLAN
SCALE: 1"=10'-0"

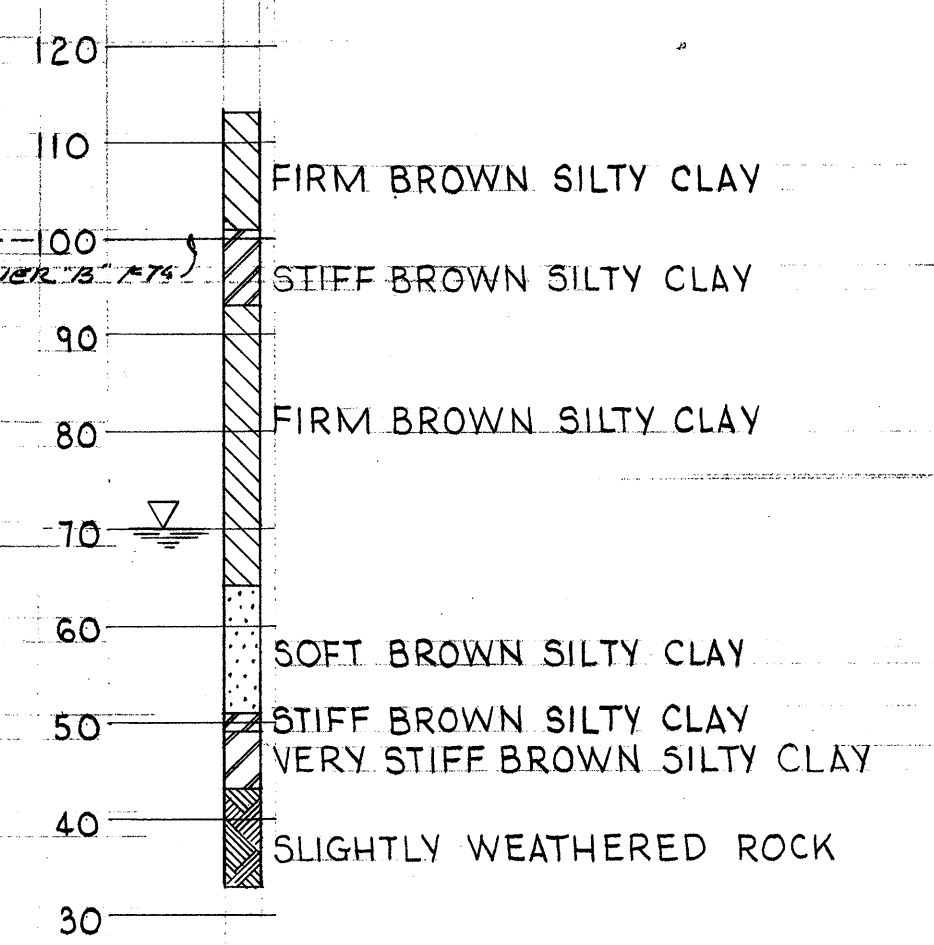


BORING #1

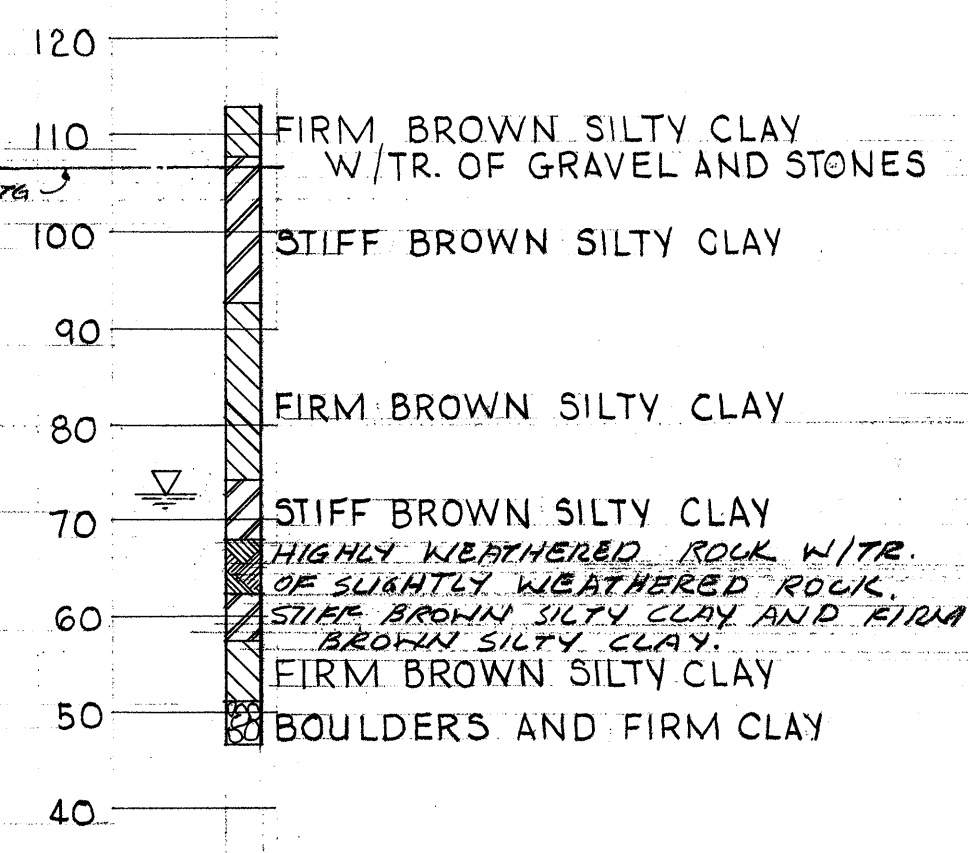

BORING #2

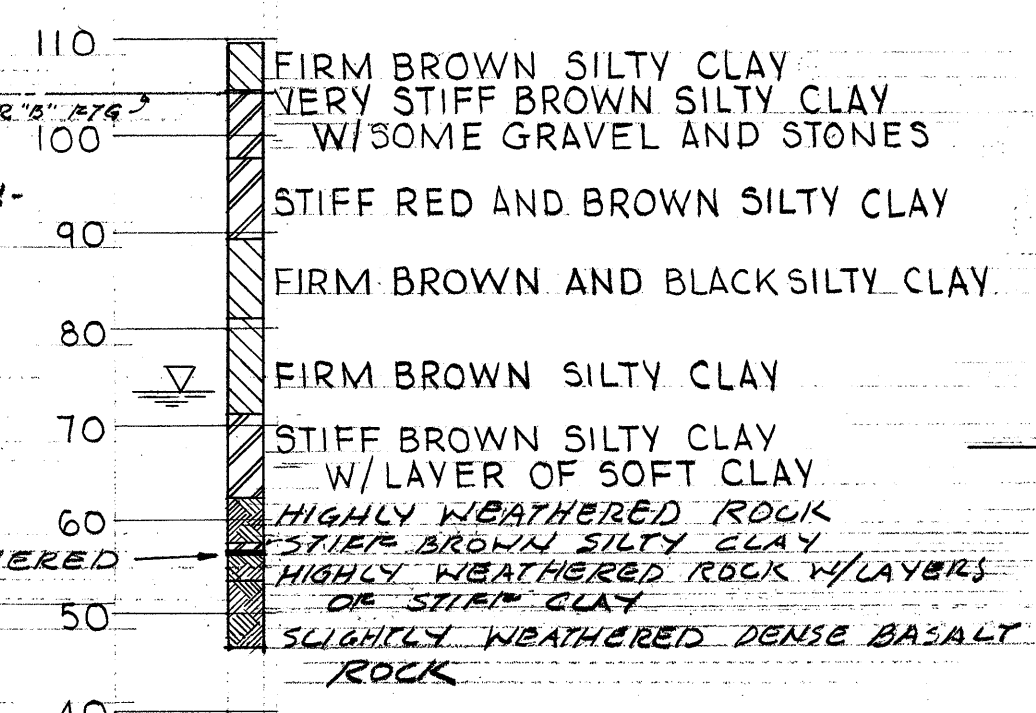


BORING #3

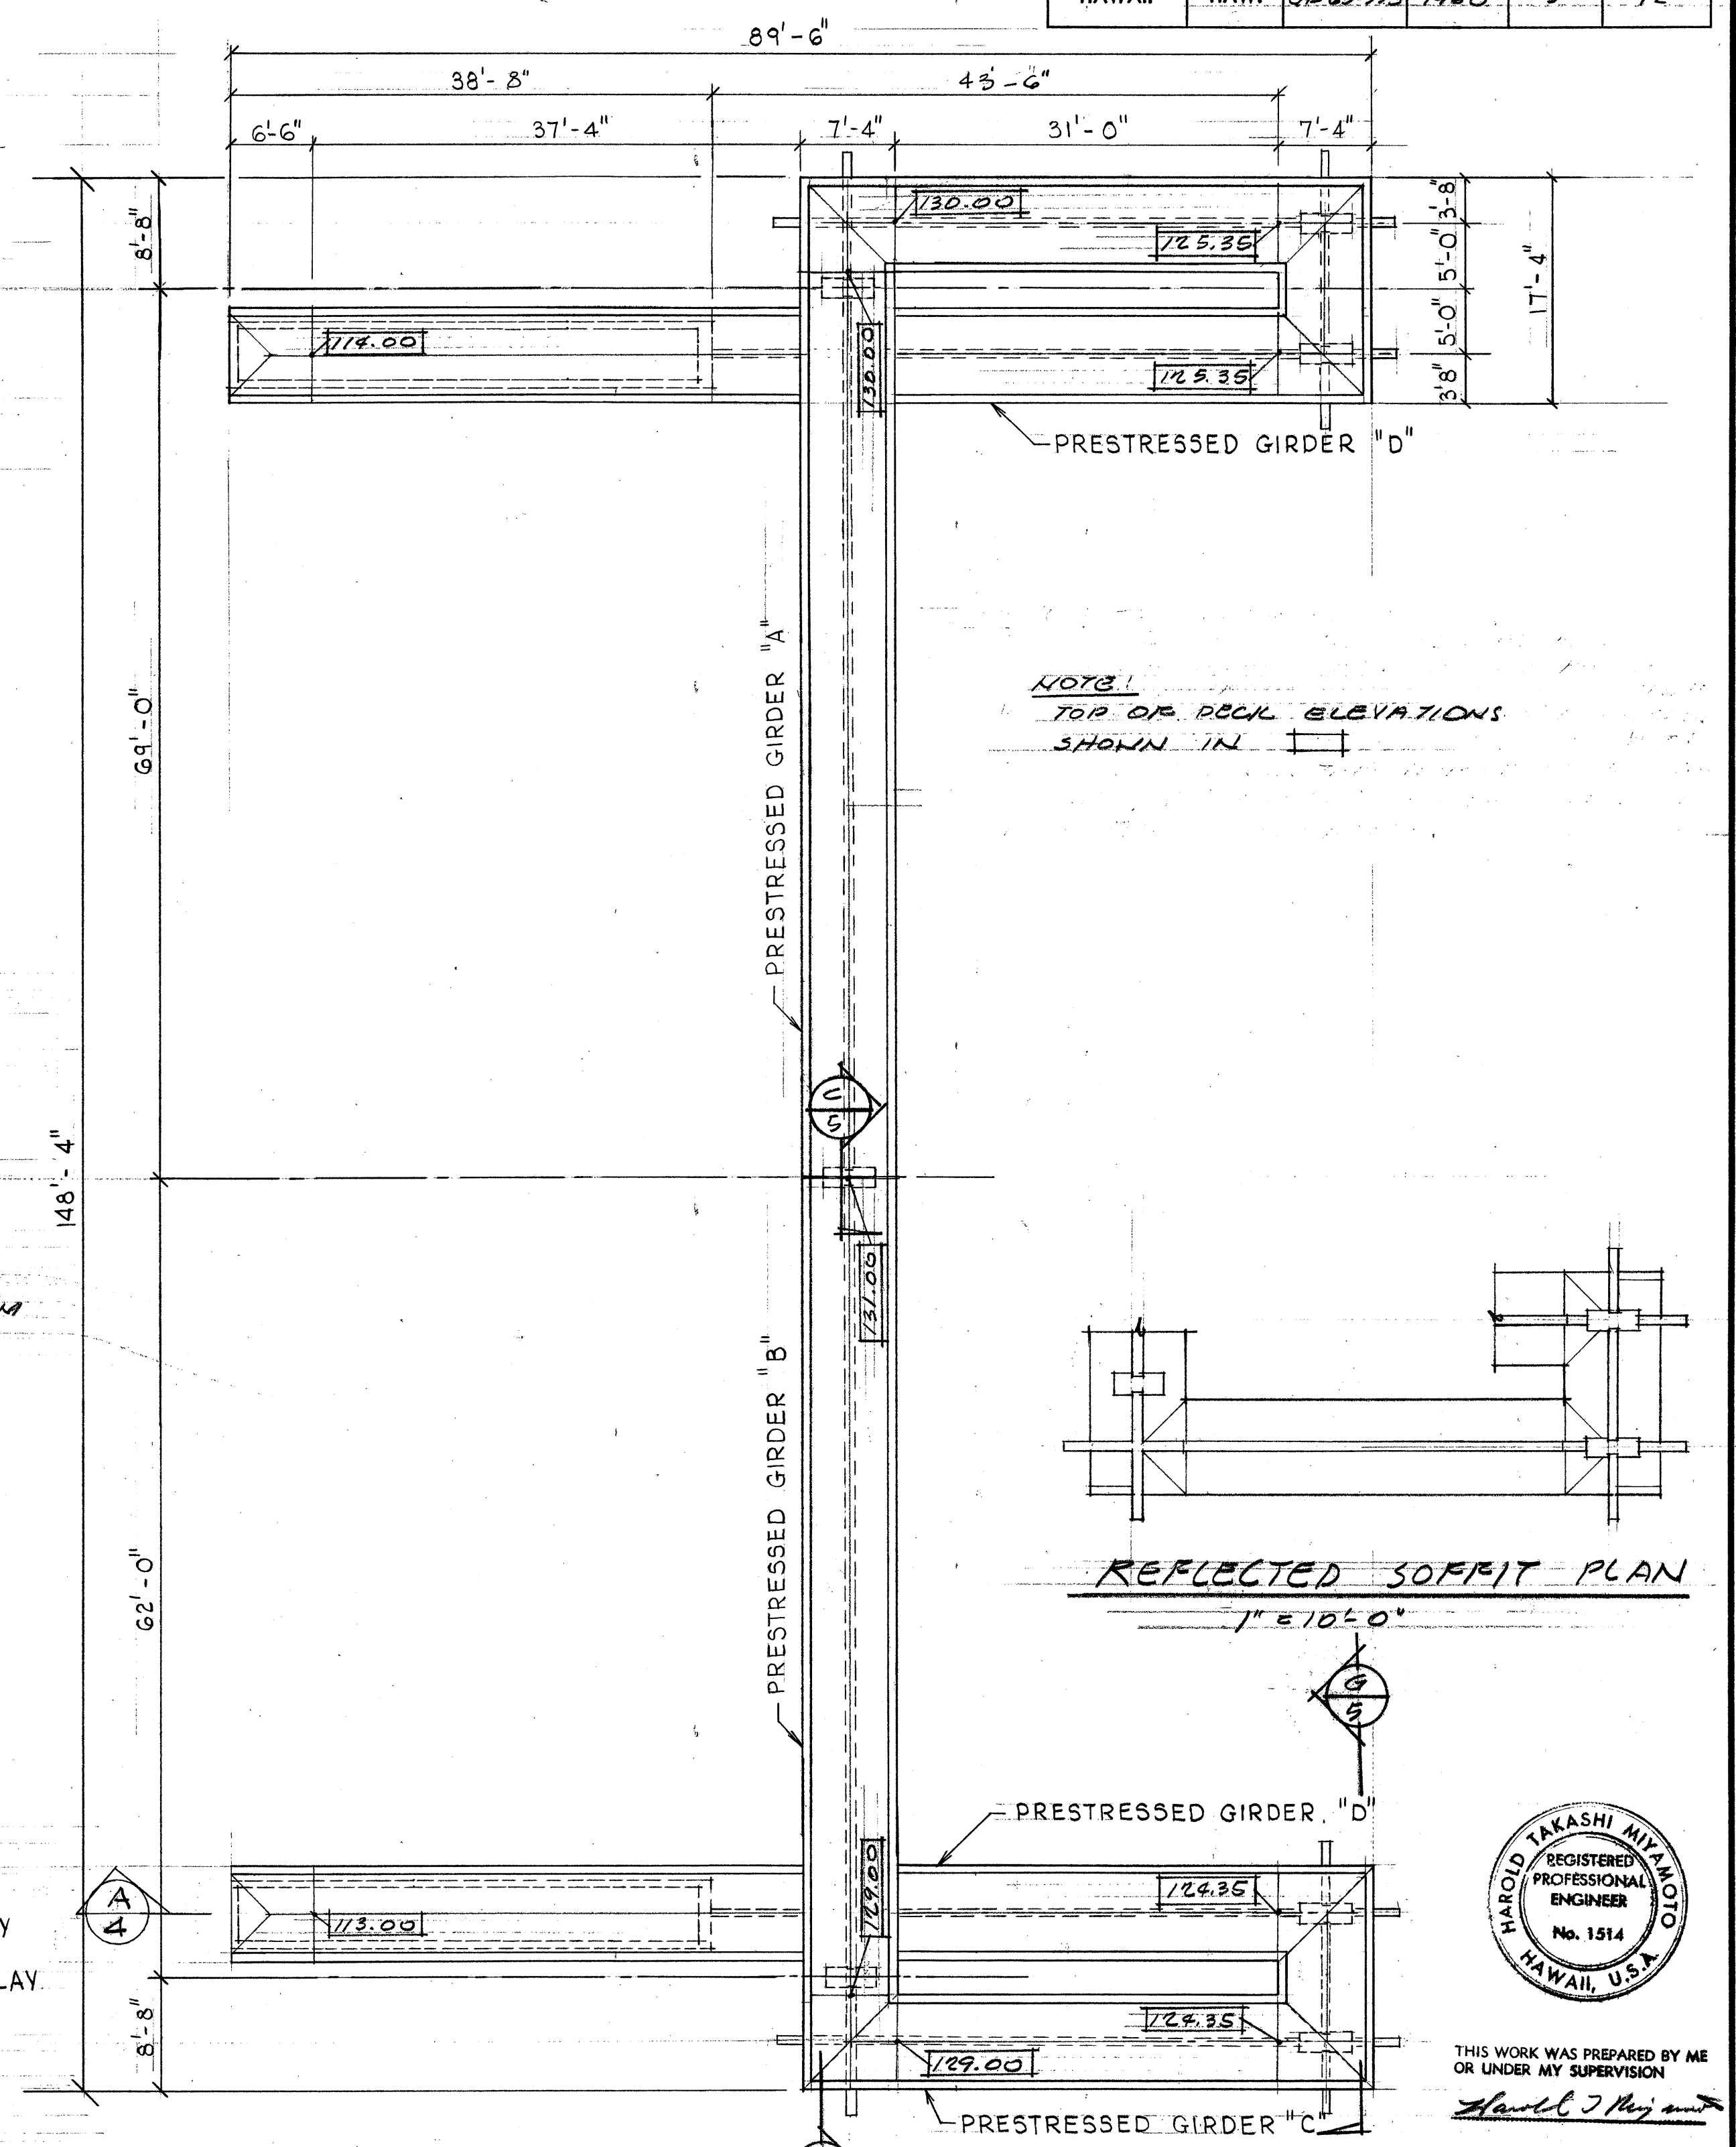


FLOOR PLAN
SCALE: 1"=10'-0"

NOTE:
TOP OF PIER ELEVATIONS
SHOWN IN

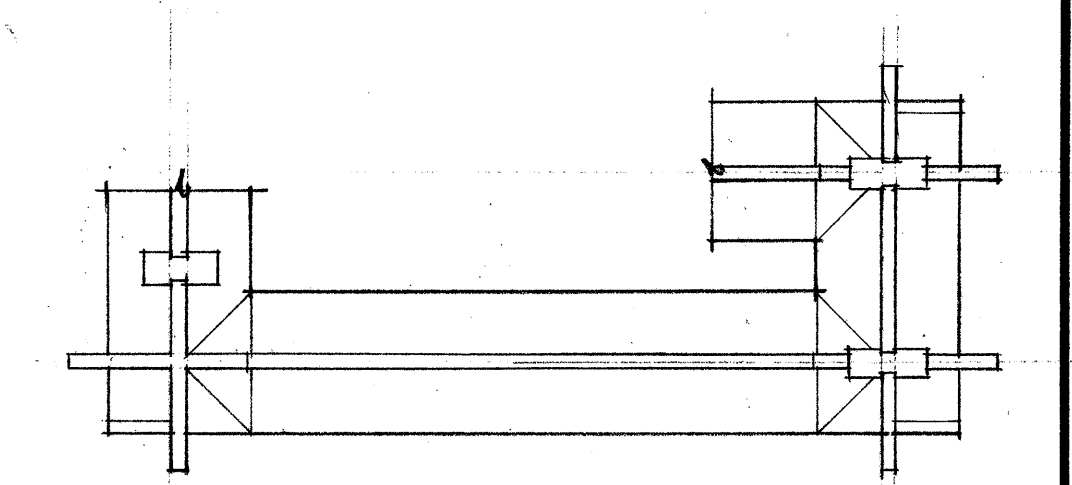

REFLECTED SOFFIT PLAN
1"=10'-0"

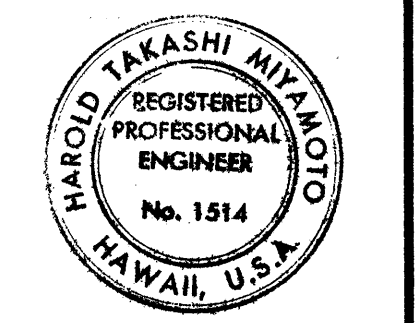

THIS WORK WAS PREPARED BY ME
OR UNDER MY SUPERVISION
Harold C. Miyamoto

STATE OF HAWAII
DEPARTMENT OF TRANSPORTATION
HIGHWAYS DIVISION
PEDESTRIAN OVERPASS
PROJECT No. GD 65-335
FOUNDATION AND FLOOR PLANS
LIKELIKE HIGHWAY AT ANOI RD, KANELOE, OAHU
Scale: As Noted
Sept. 27, 1968