




FED. ROAD DIST. NO.	STATE	PROJ. NO.	FISCAL YEAR	SHEET NO.	TOTAL SHEETS
HAWAII	HAW.	GD 65-335	1965	4	12

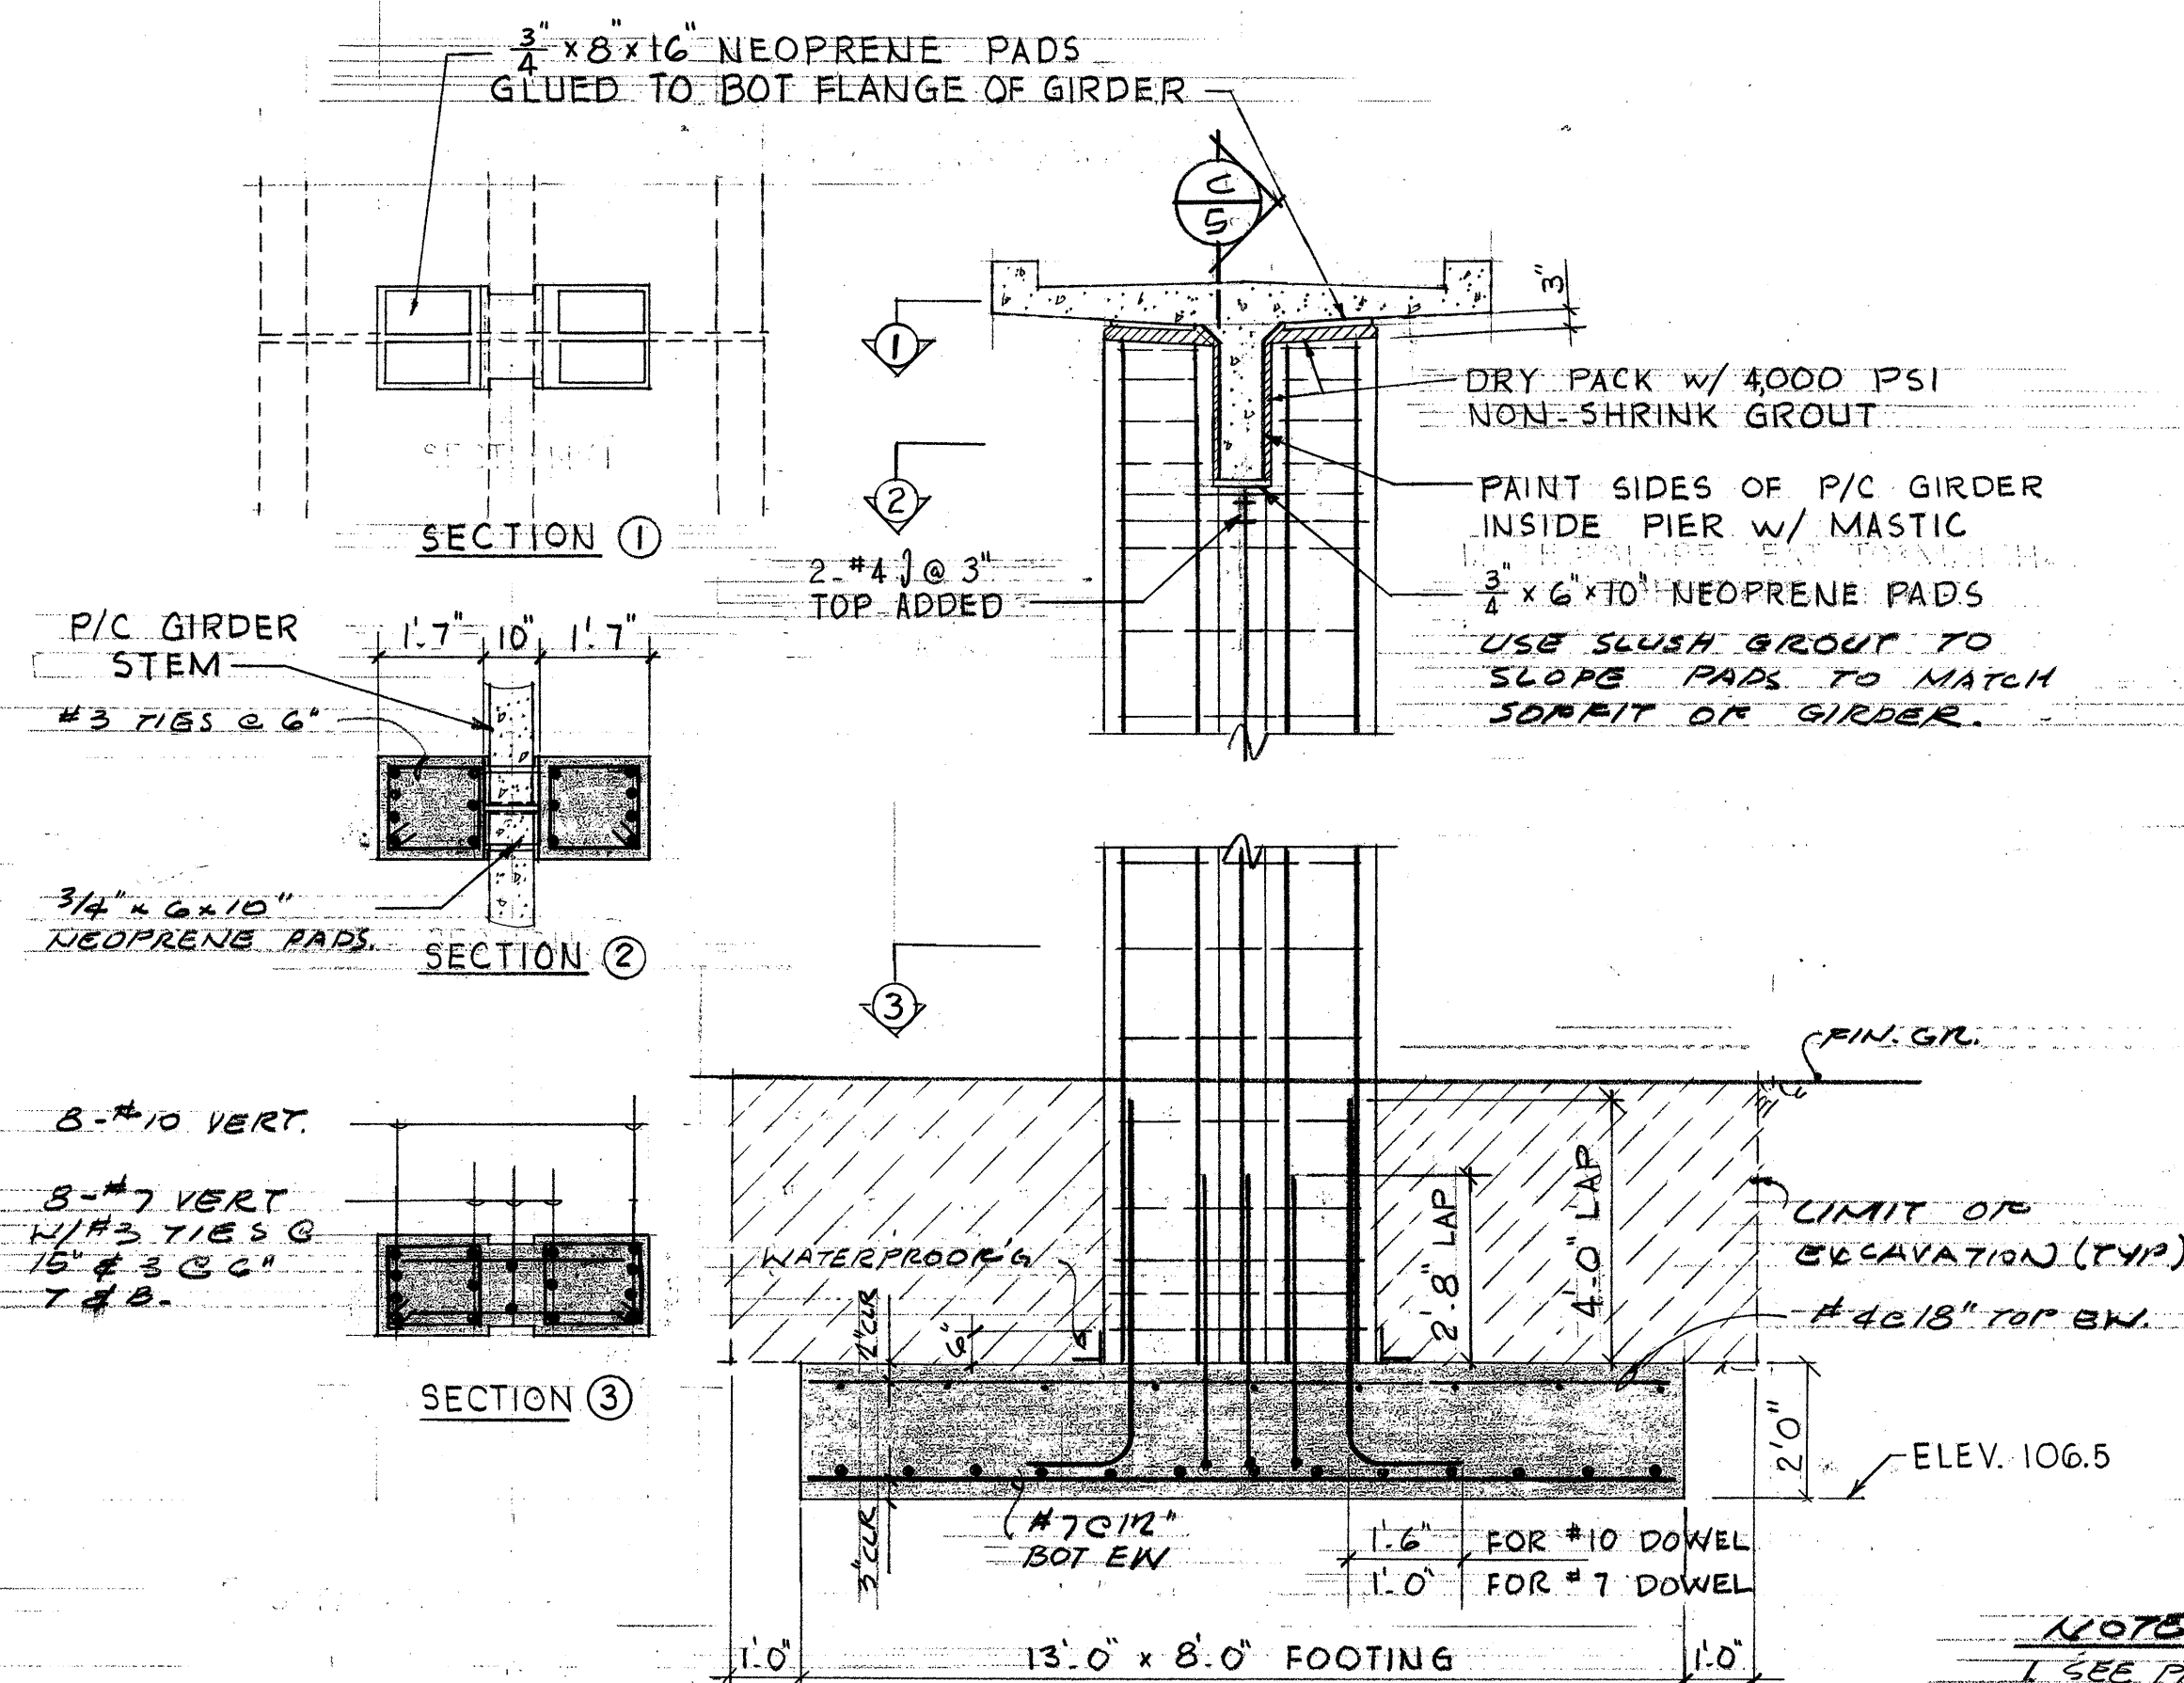


PIER A
SCALE: $\frac{3}{8}" = 1'-0"$

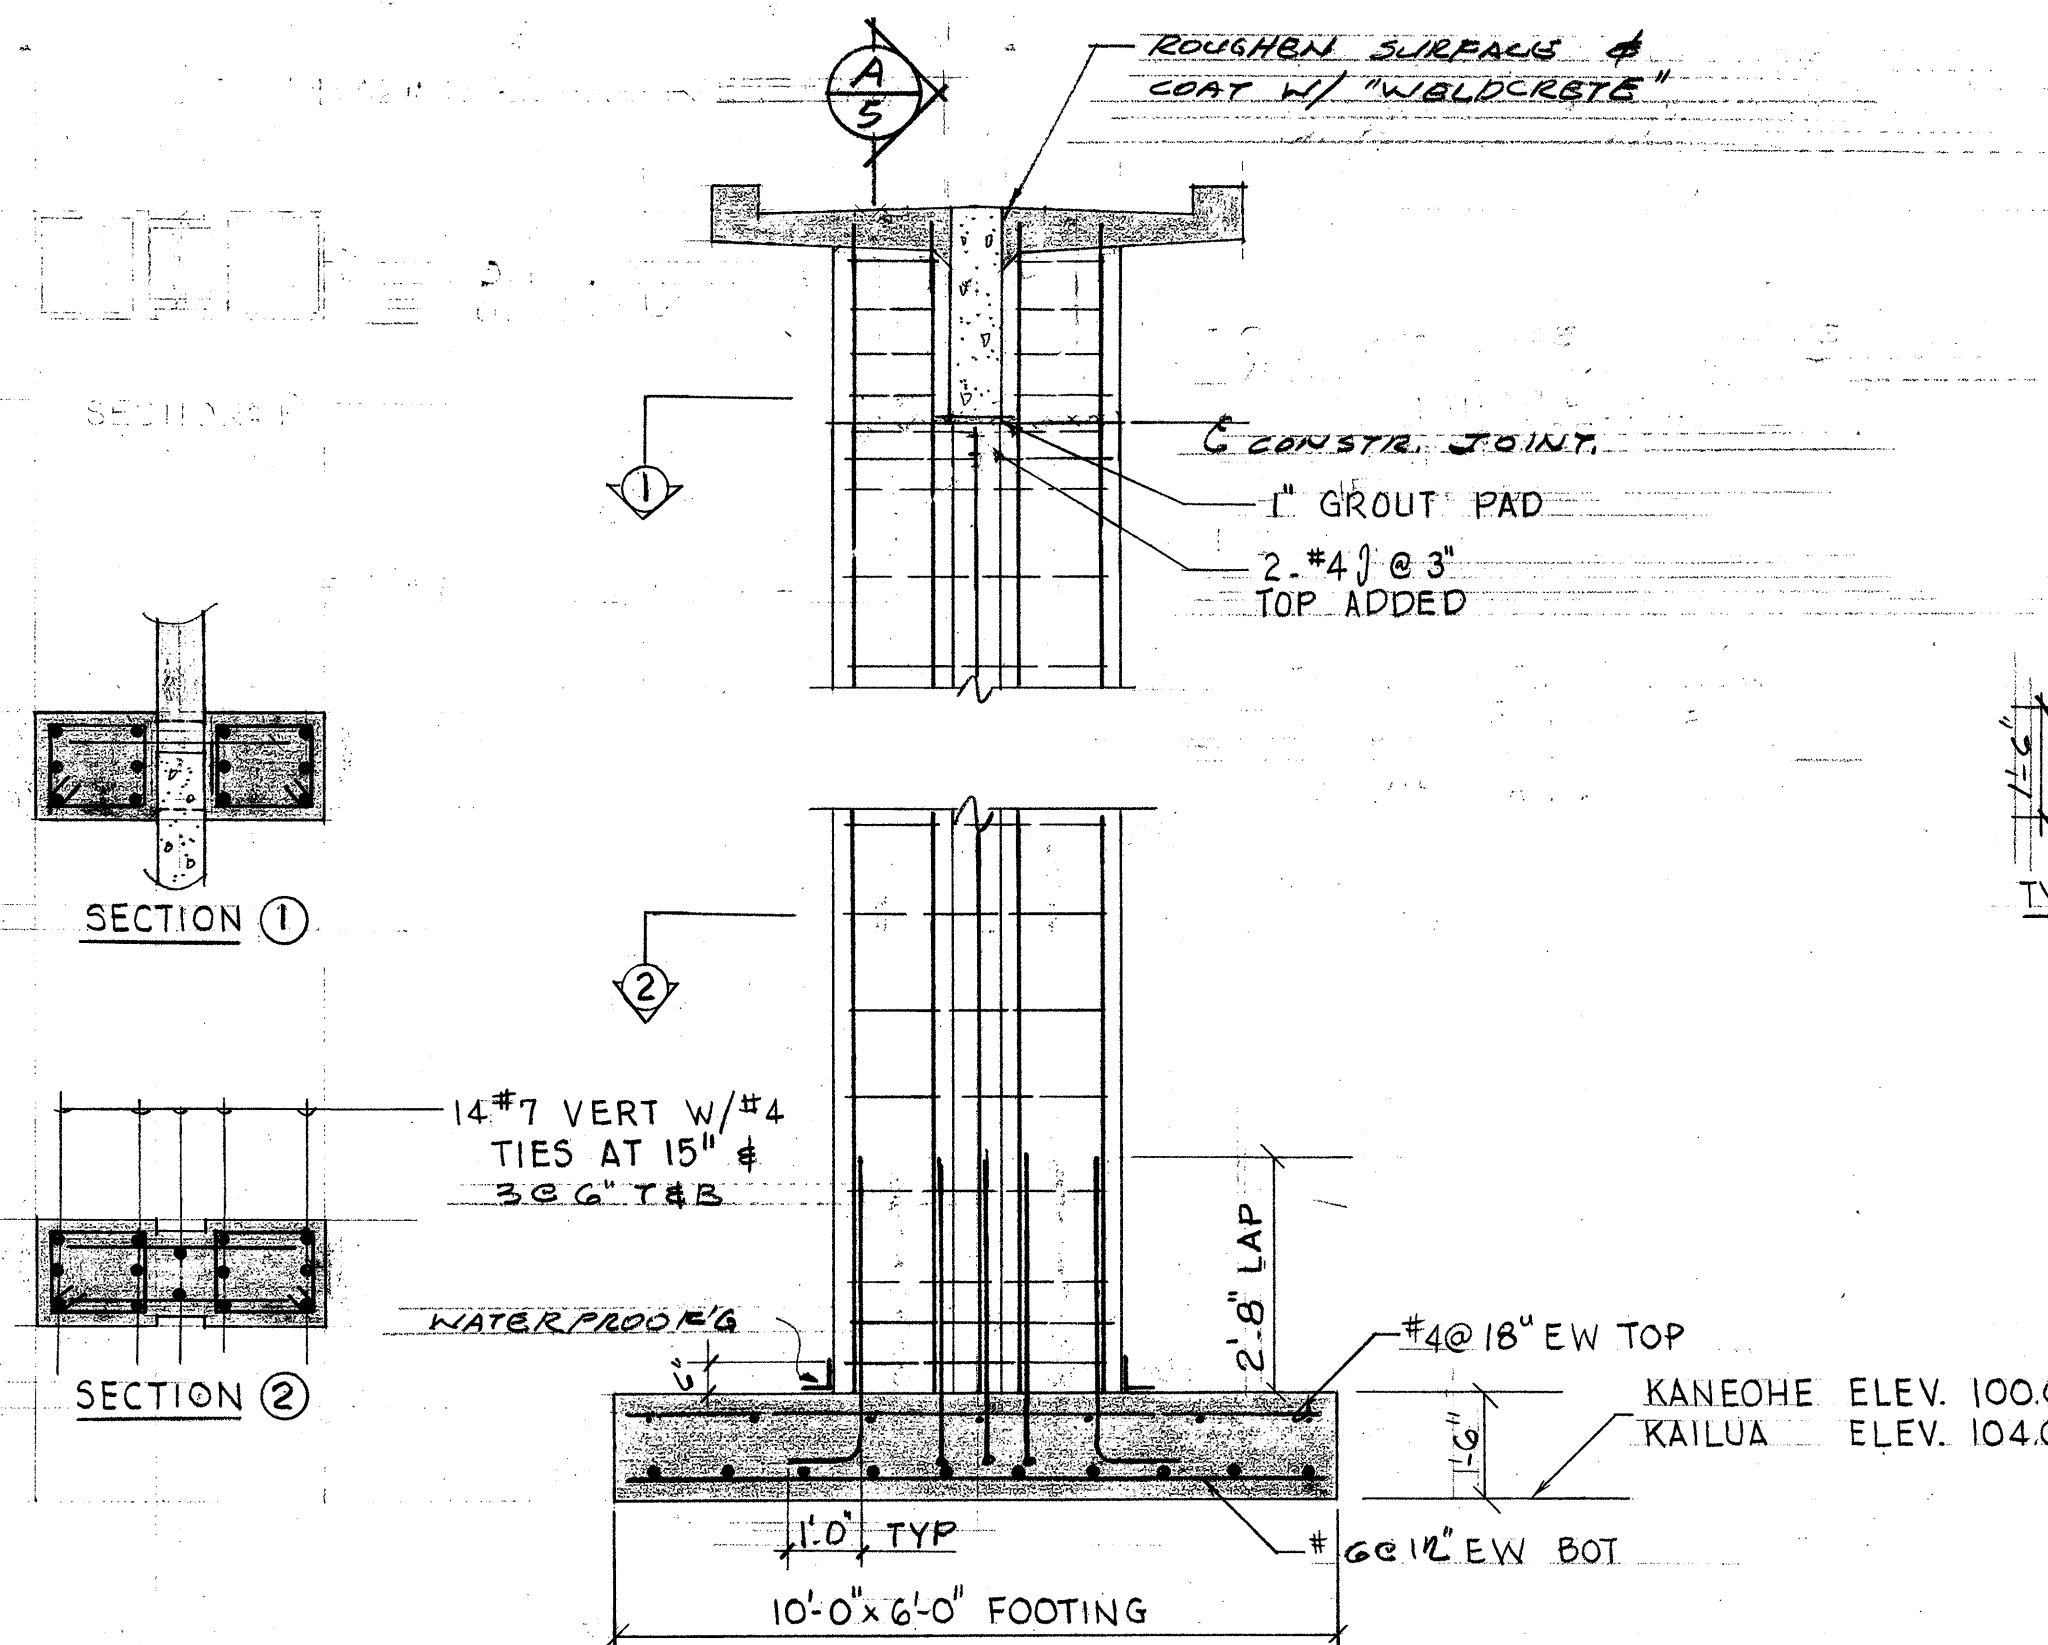

PIER B
SCALE: $\frac{3}{8}" = 1'-0"$

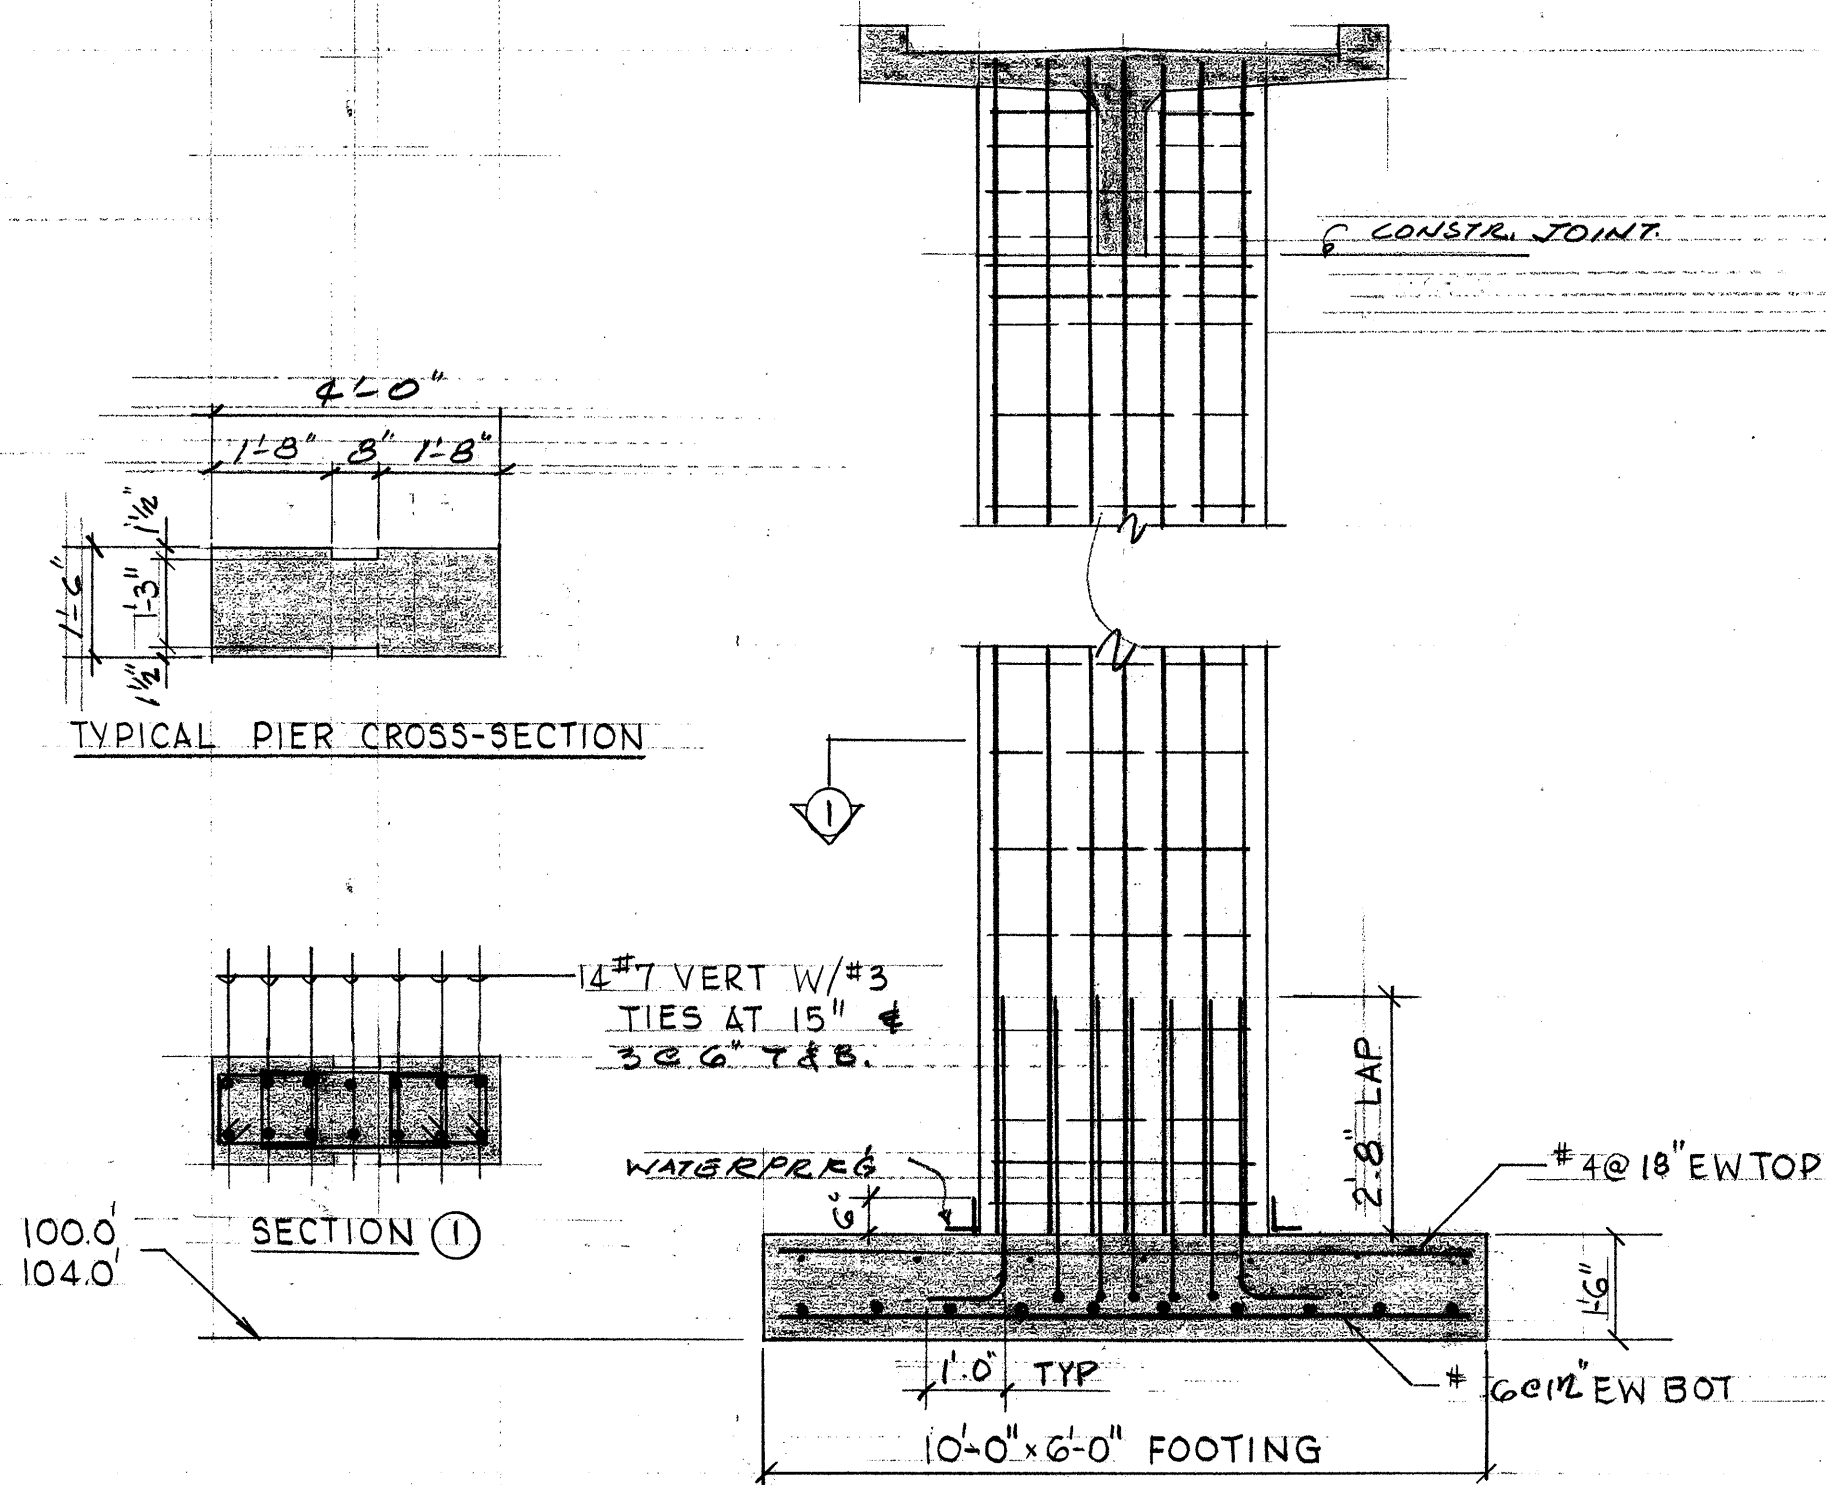


PIER C
SCALE: $\frac{3}{8}" = 1'-0"$

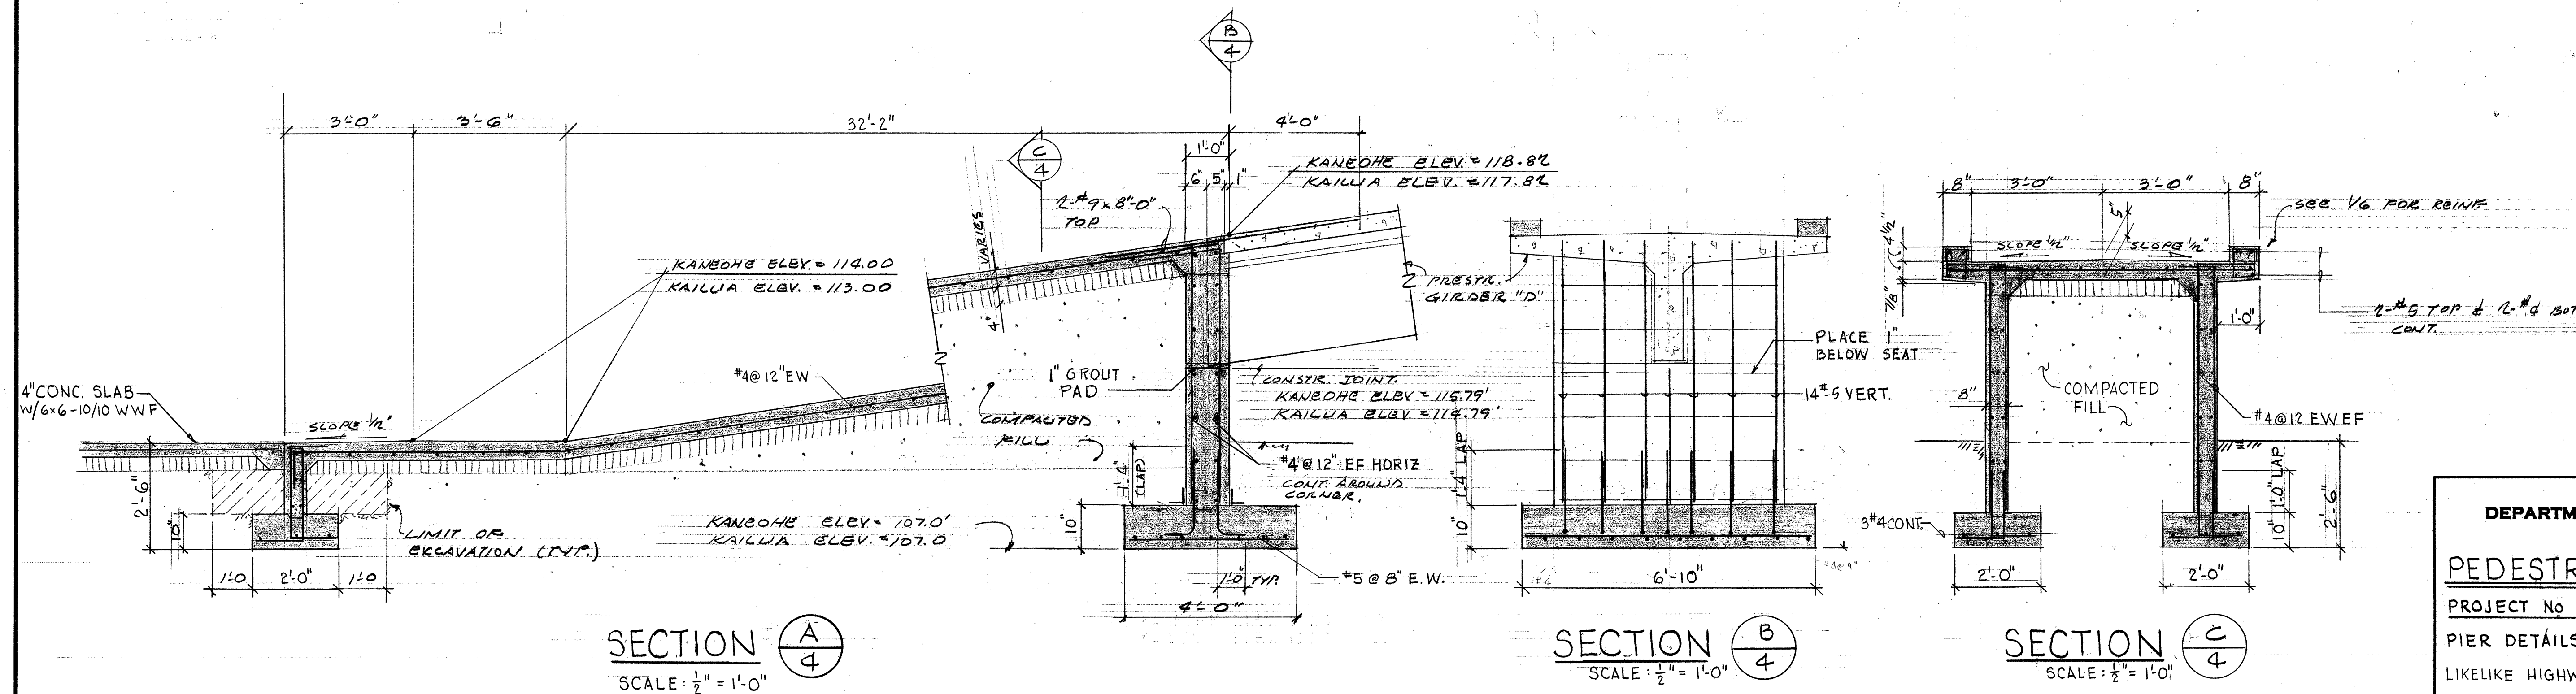

SECTION A
SCALE: $\frac{1}{2}" = 1'-0"$

SECTION B
SCALE: $\frac{1}{2}" = 1'-0"$

SECTION C
SCALE: $\frac{1}{2}" = 1'-0"$

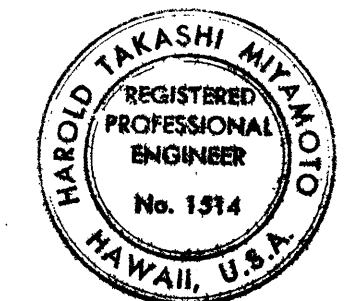

THIS WORK WAS PREPARED BY ME OR UNDER MY SUPERVISION
Harold Takashi Miyamoto

STATE OF HAWAII
DEPARTMENT OF TRANSPORTATION
HIGHWAYS DIVISION
PEDESTRIAN OVERPASS
PROJECT No. GD 65-335
PIER DETAILS AND SECTIONS
LIKELIKE HIGHWAY AT ANOI RD. KANEHOE, OAHU
Scale: As Noted
Sept. 27, 1965
SHEET No. 4 OF 12 SHEETS