




FED. ROAD DIST. NO.	STATE	PROJ. NO.	FISCAL YEAR	SHEET NO.	TOTAL SHEETS
HAWAII	HAW.	30065-335	1963	5	12

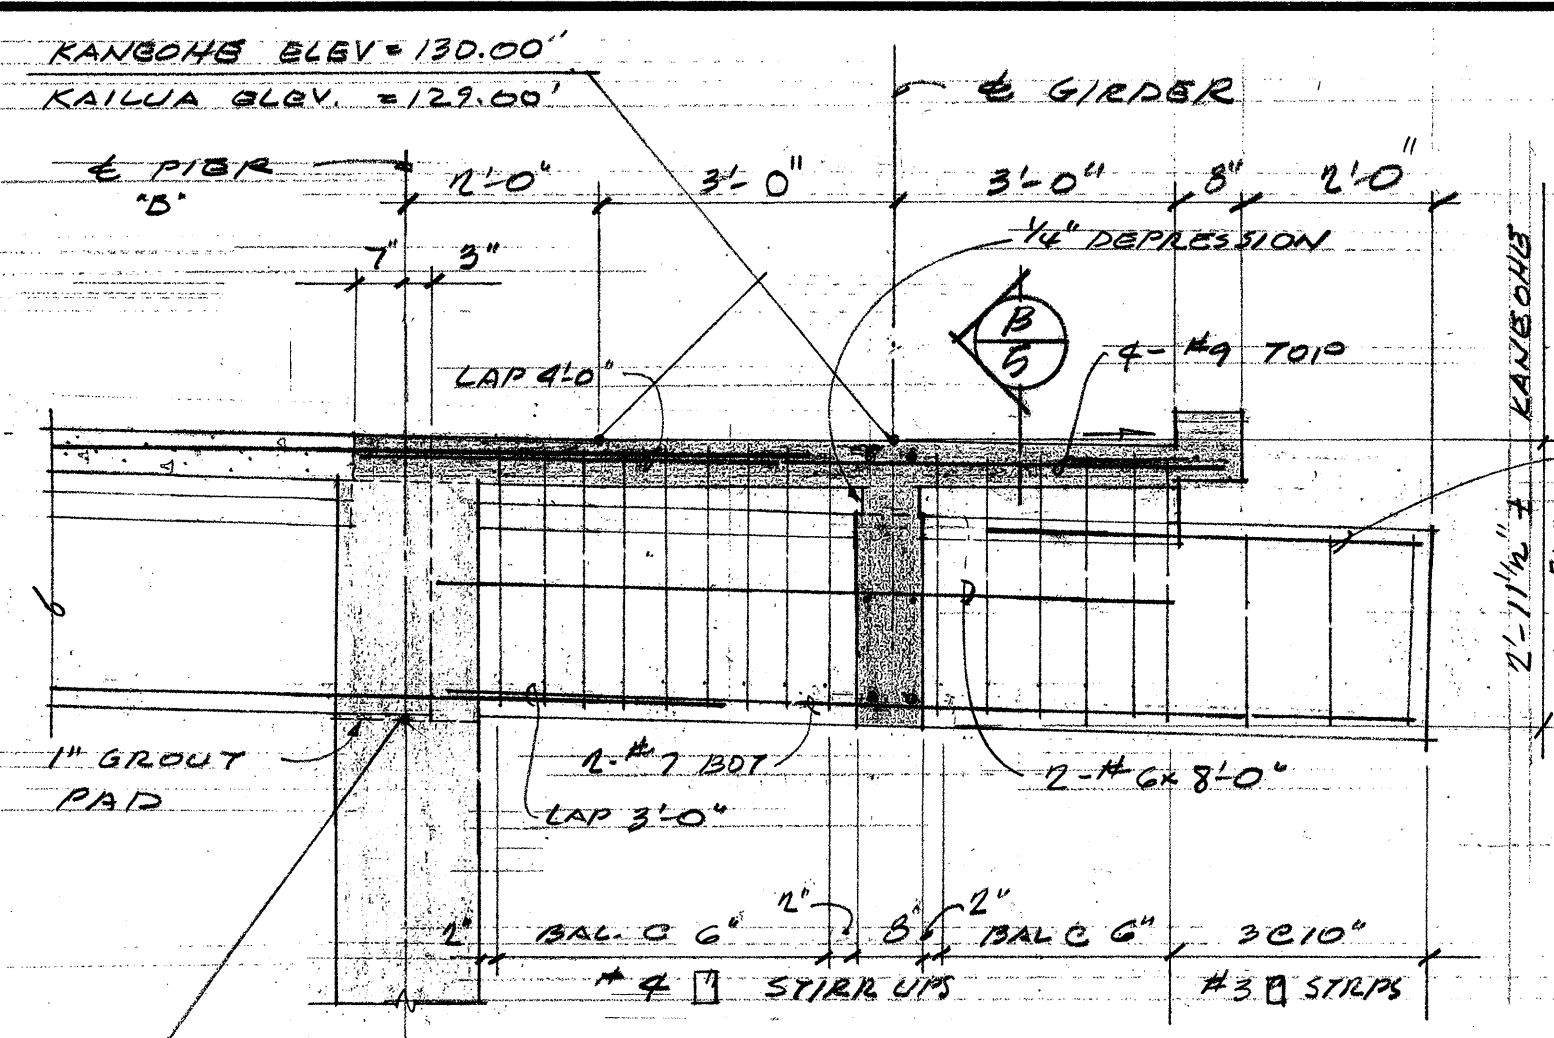


SECTION A-A
1/4" = 1'-0"

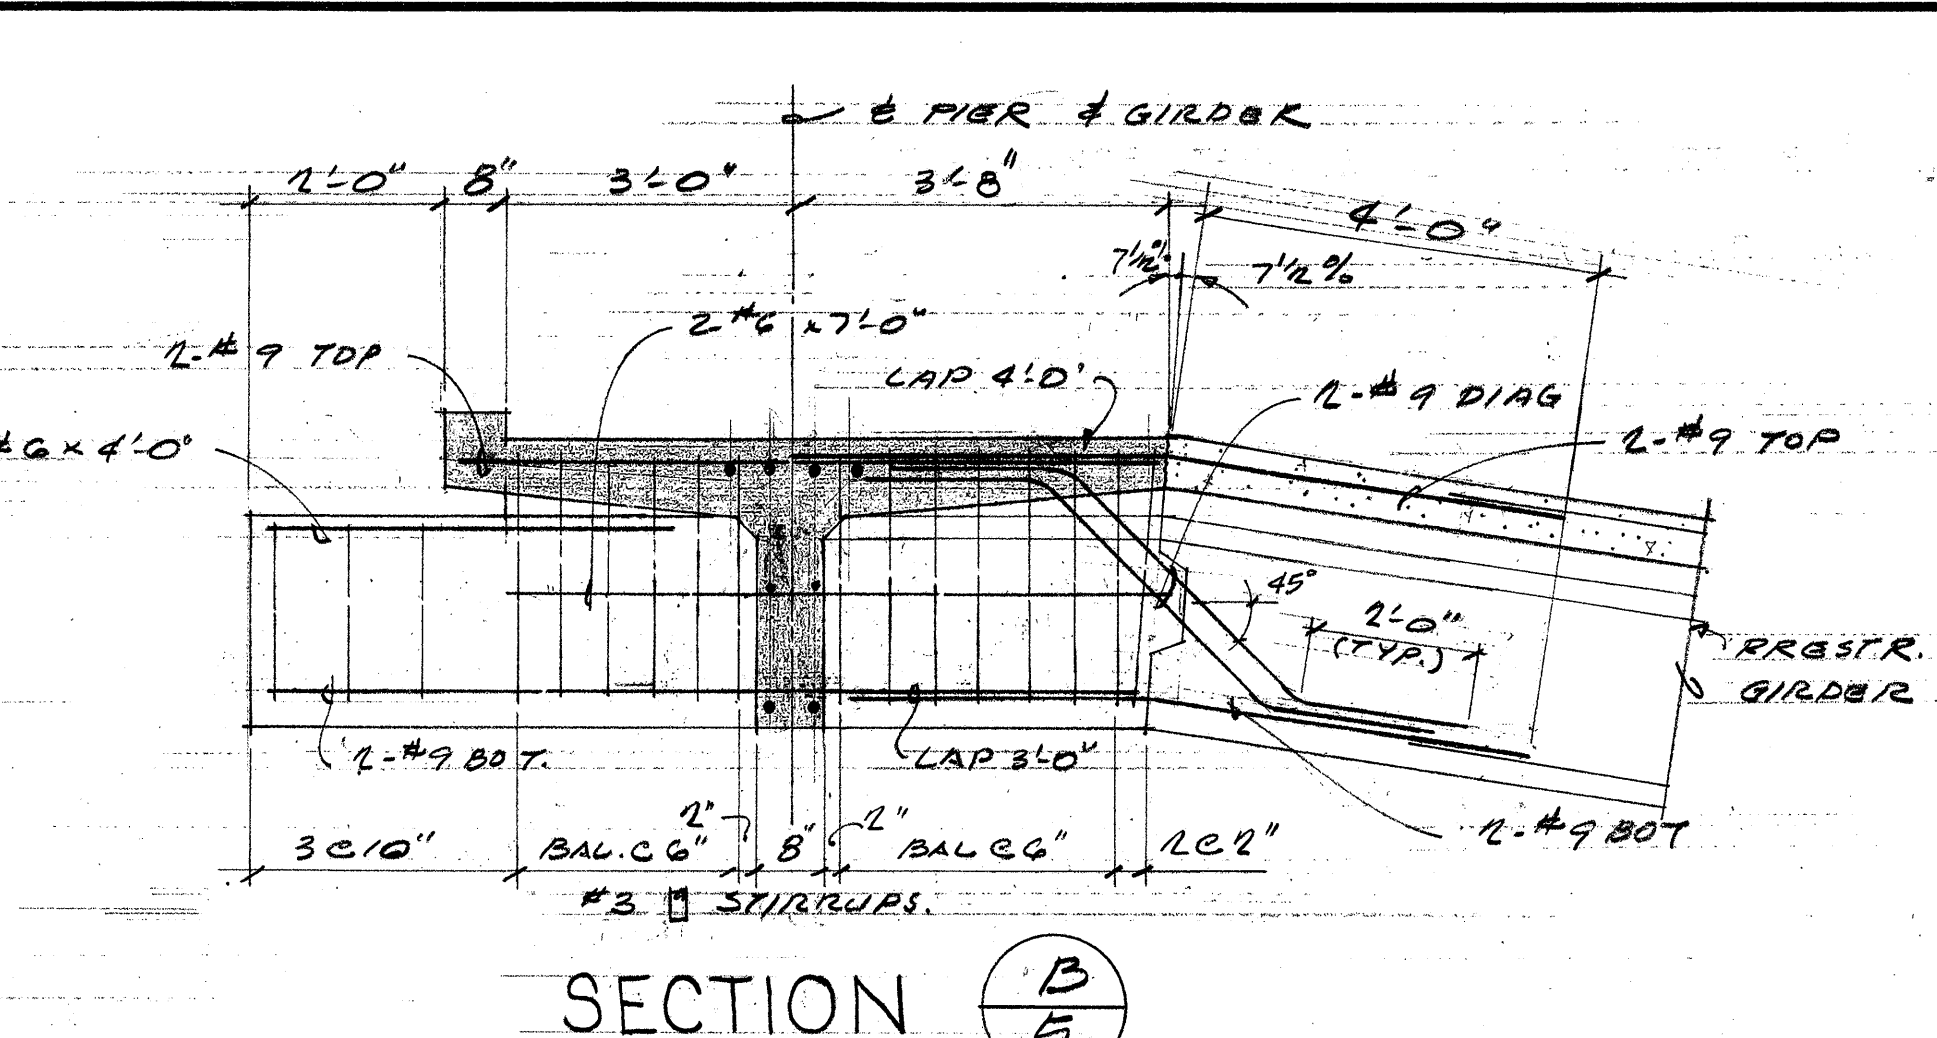


SECTION B-B
3/4" = 1'-0"

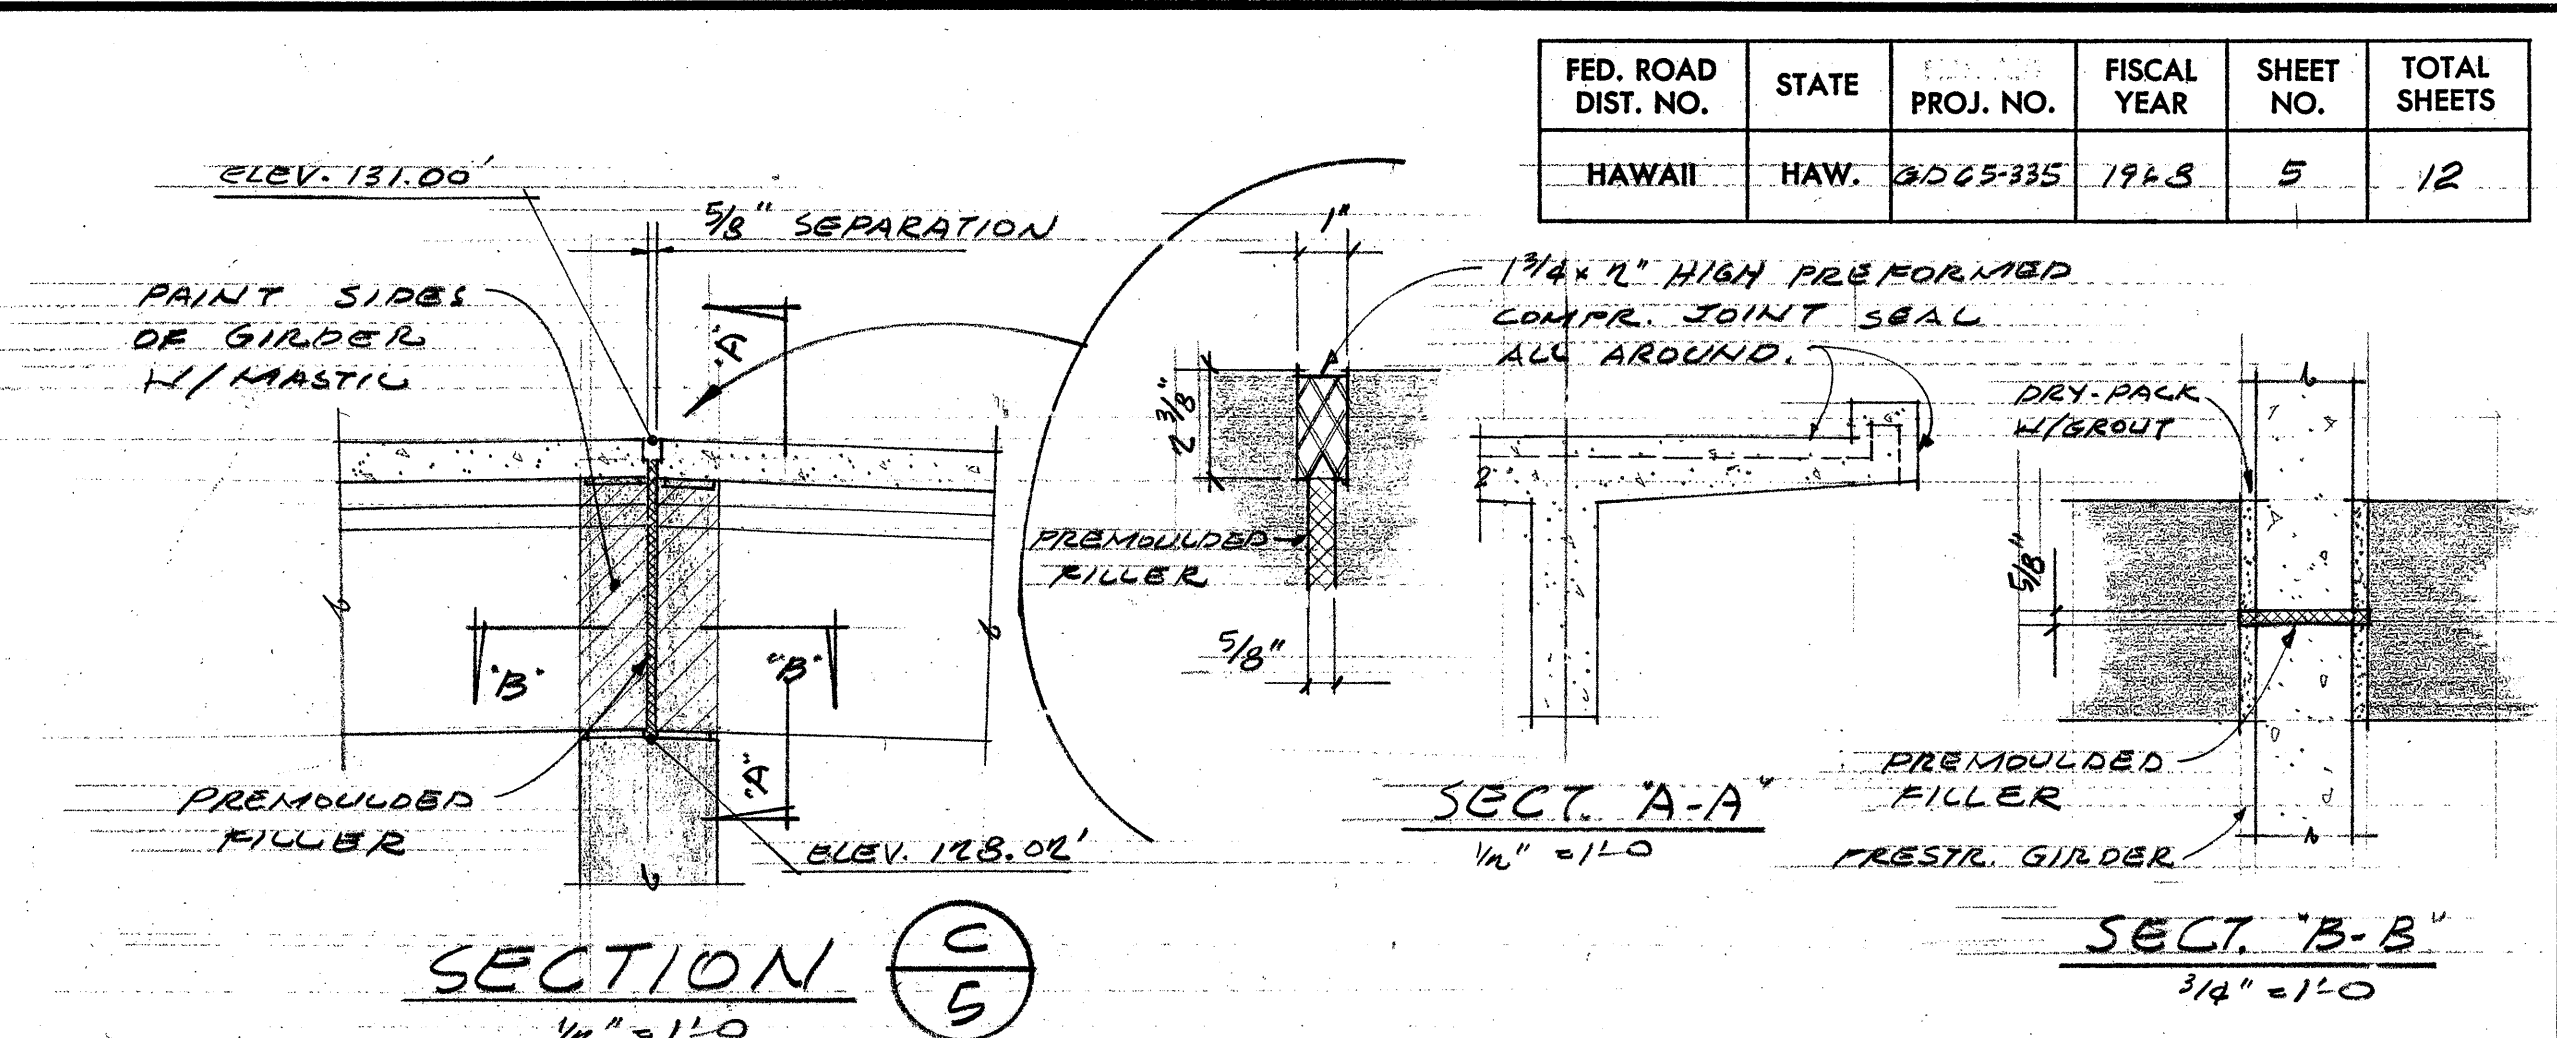

SECTION C-C
1/4" = 1'-0"

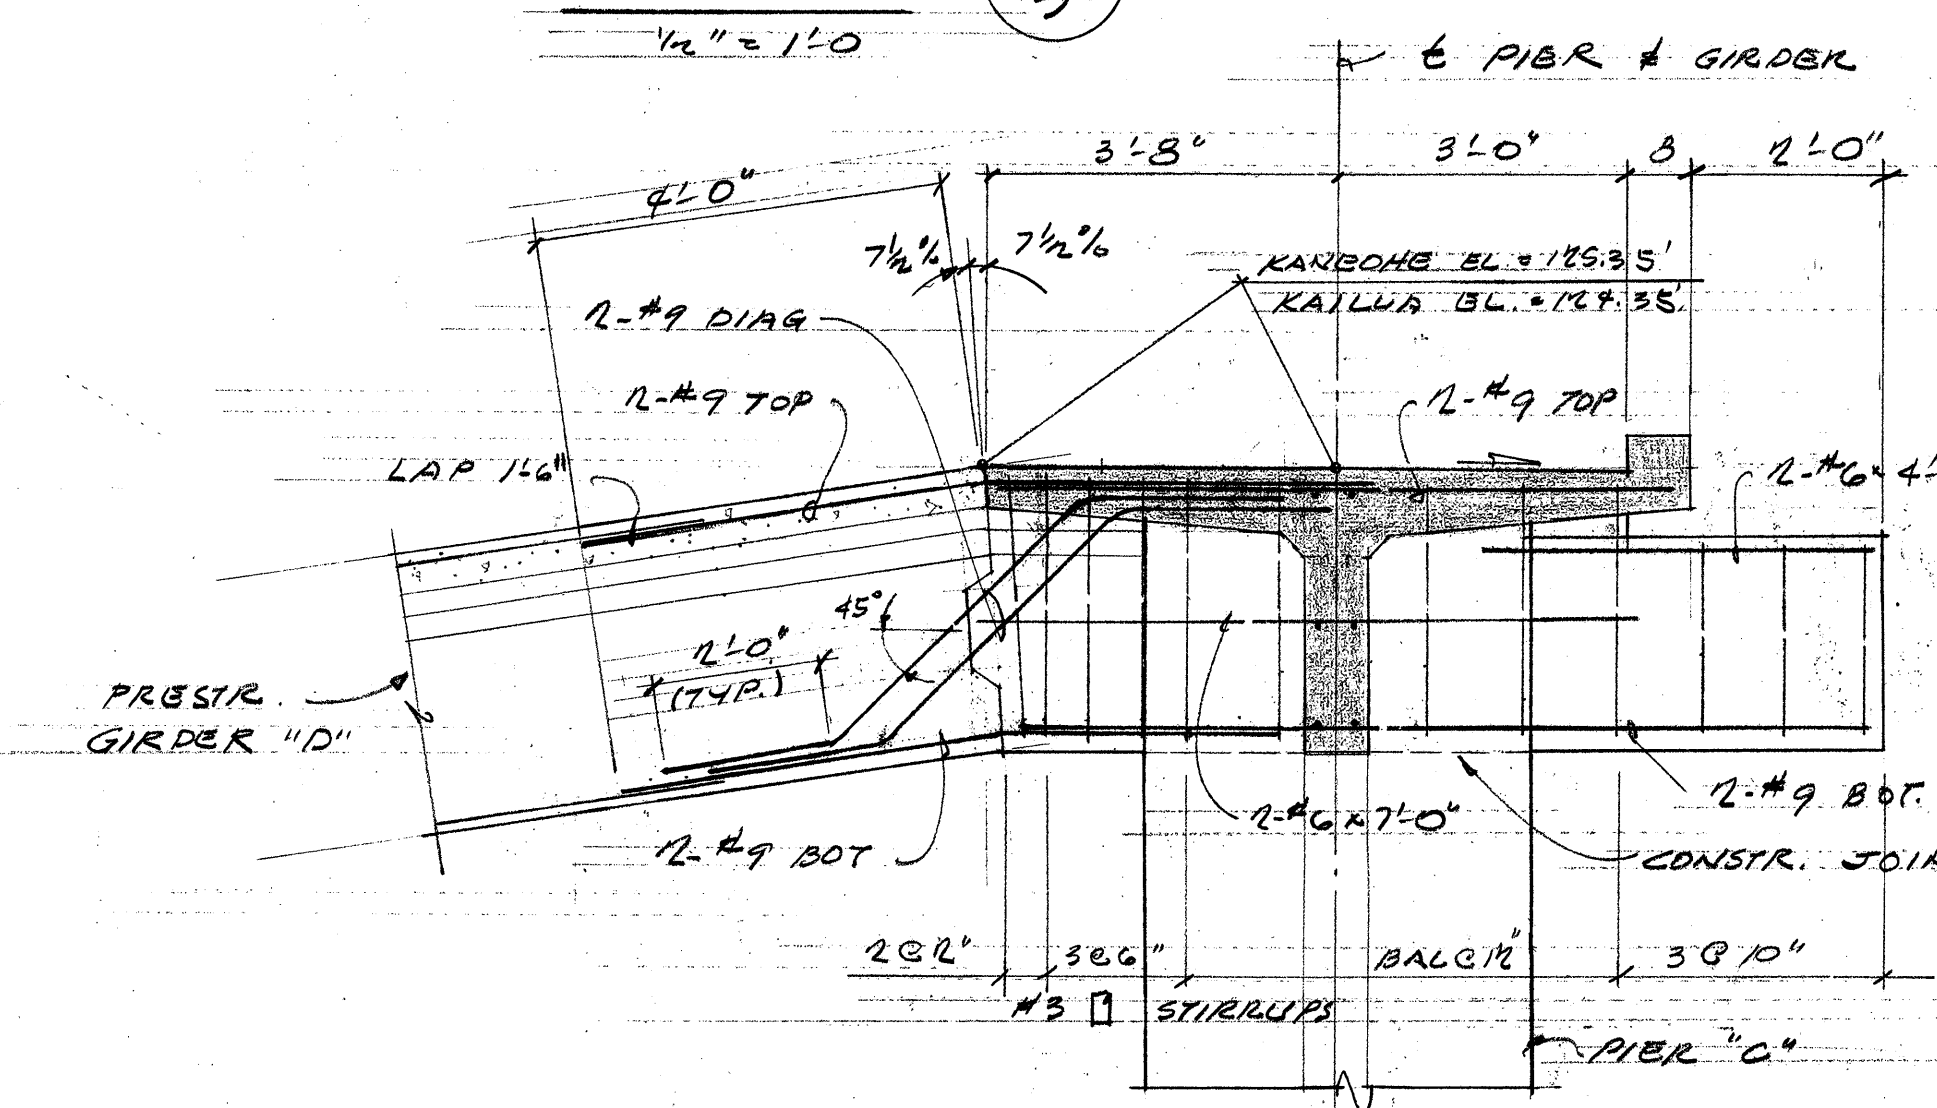


SECTION D-D
SCALE: 1/2" = 1'-0"

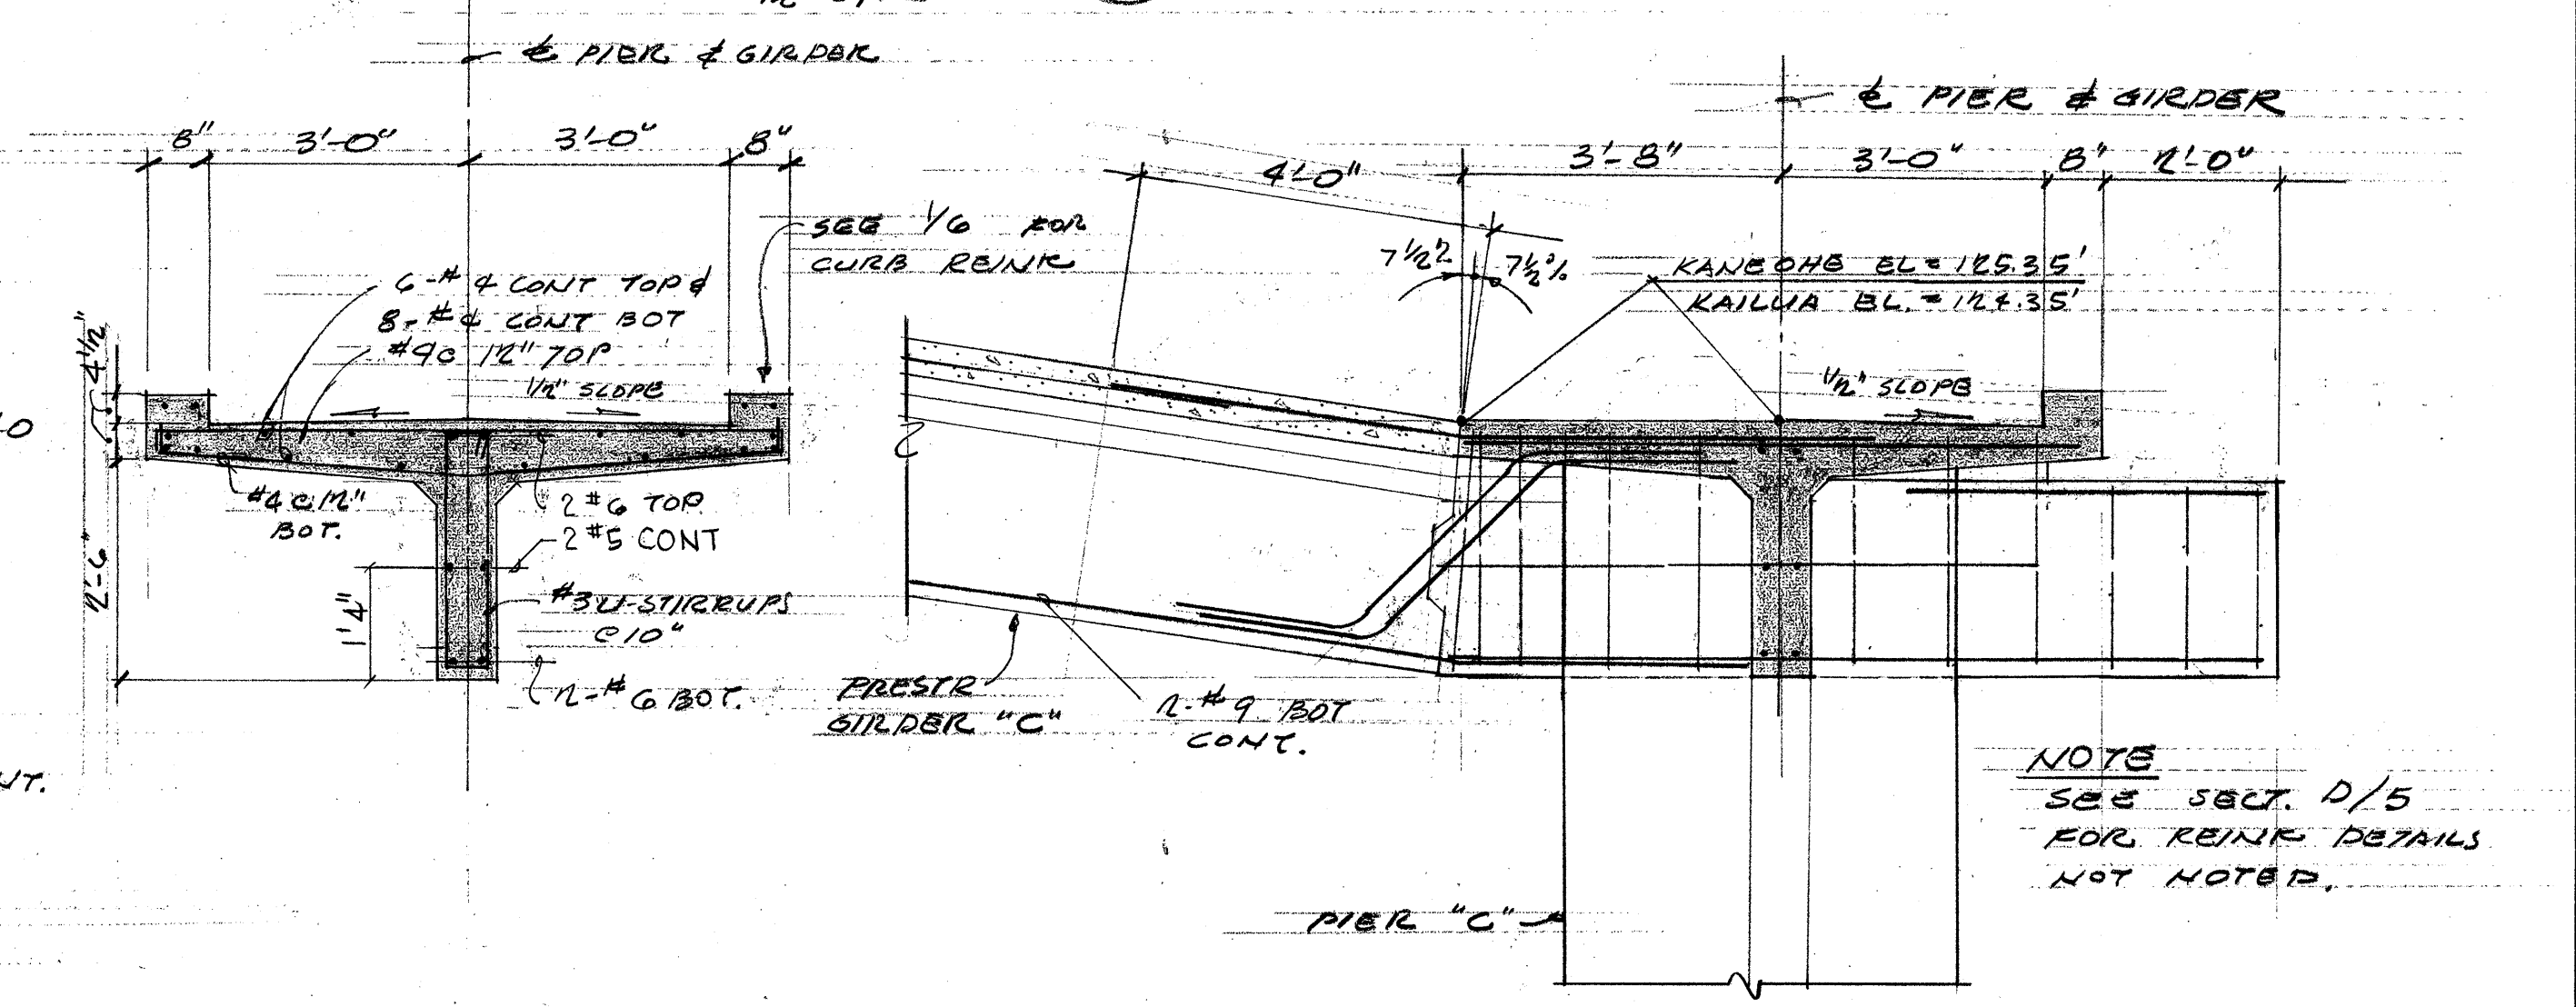


SECTION E-E
SCALE: 1/2" = 1'-0"


SECTION F-F
SCALE: 1/2" = 1'-0"

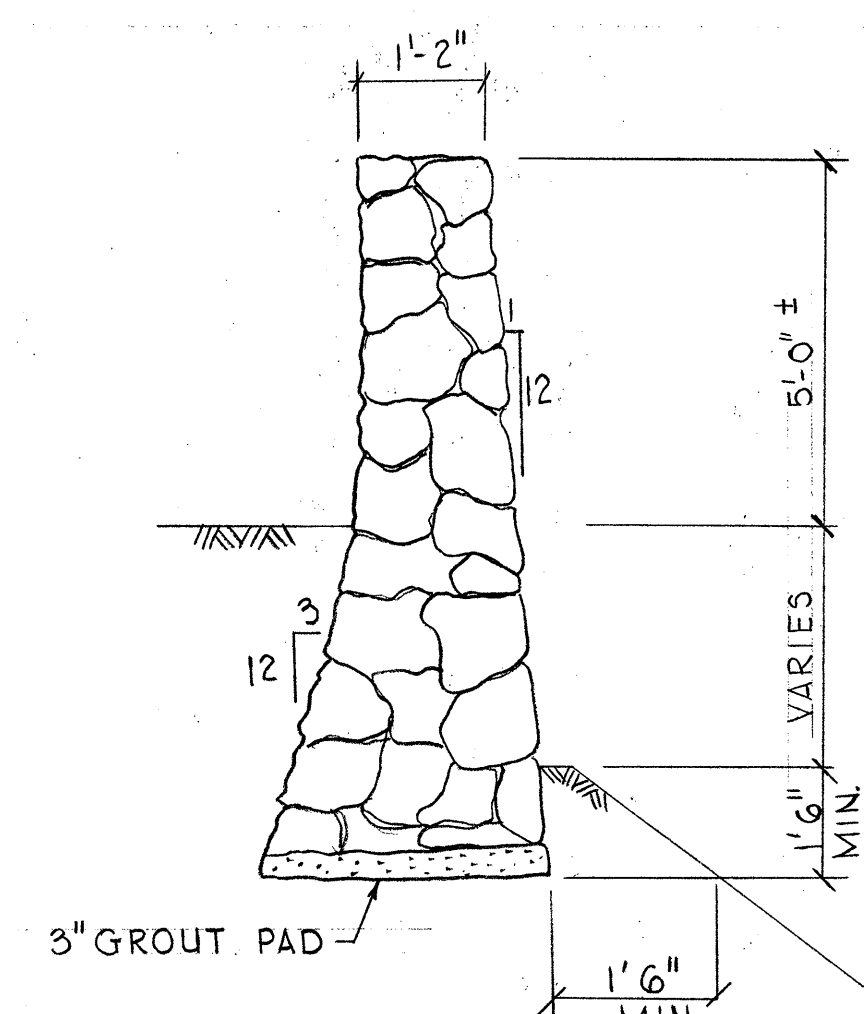


SECTION X-X
SCALE: 1/2" = 1'-0"

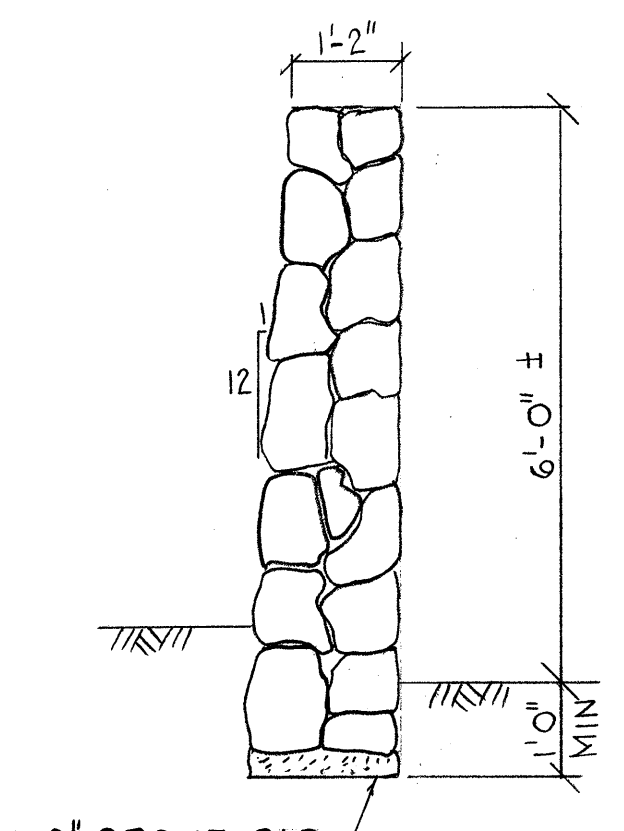

SECTION Y-Y
SCALE: 1/2" = 1'-0"

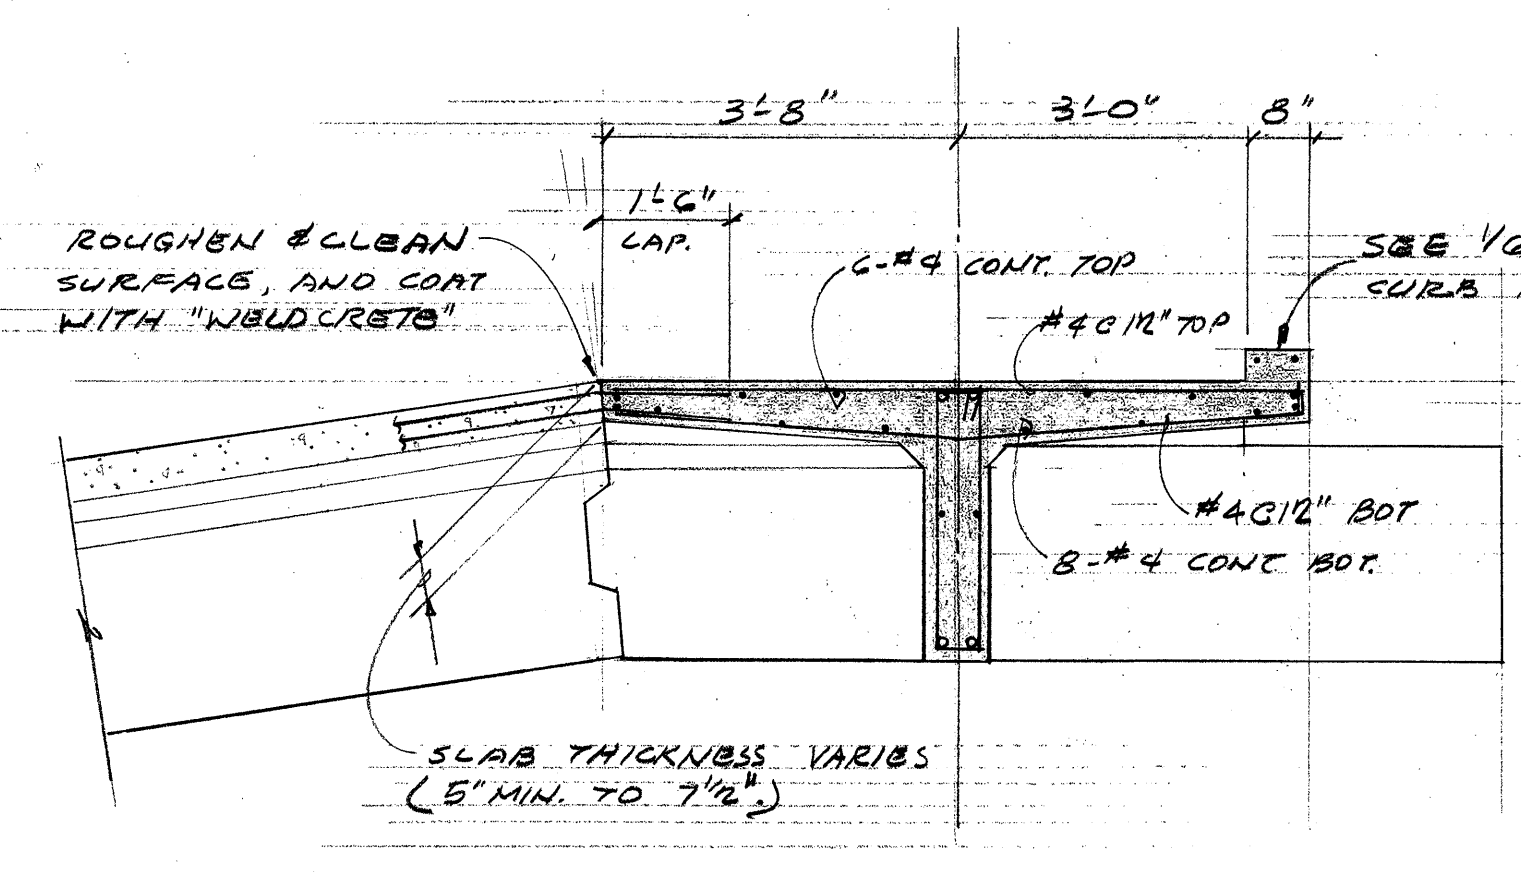


TYPICAL POURED-IN-PLACE
SLAB REINF DETAIL
3/4" = 1'-0"

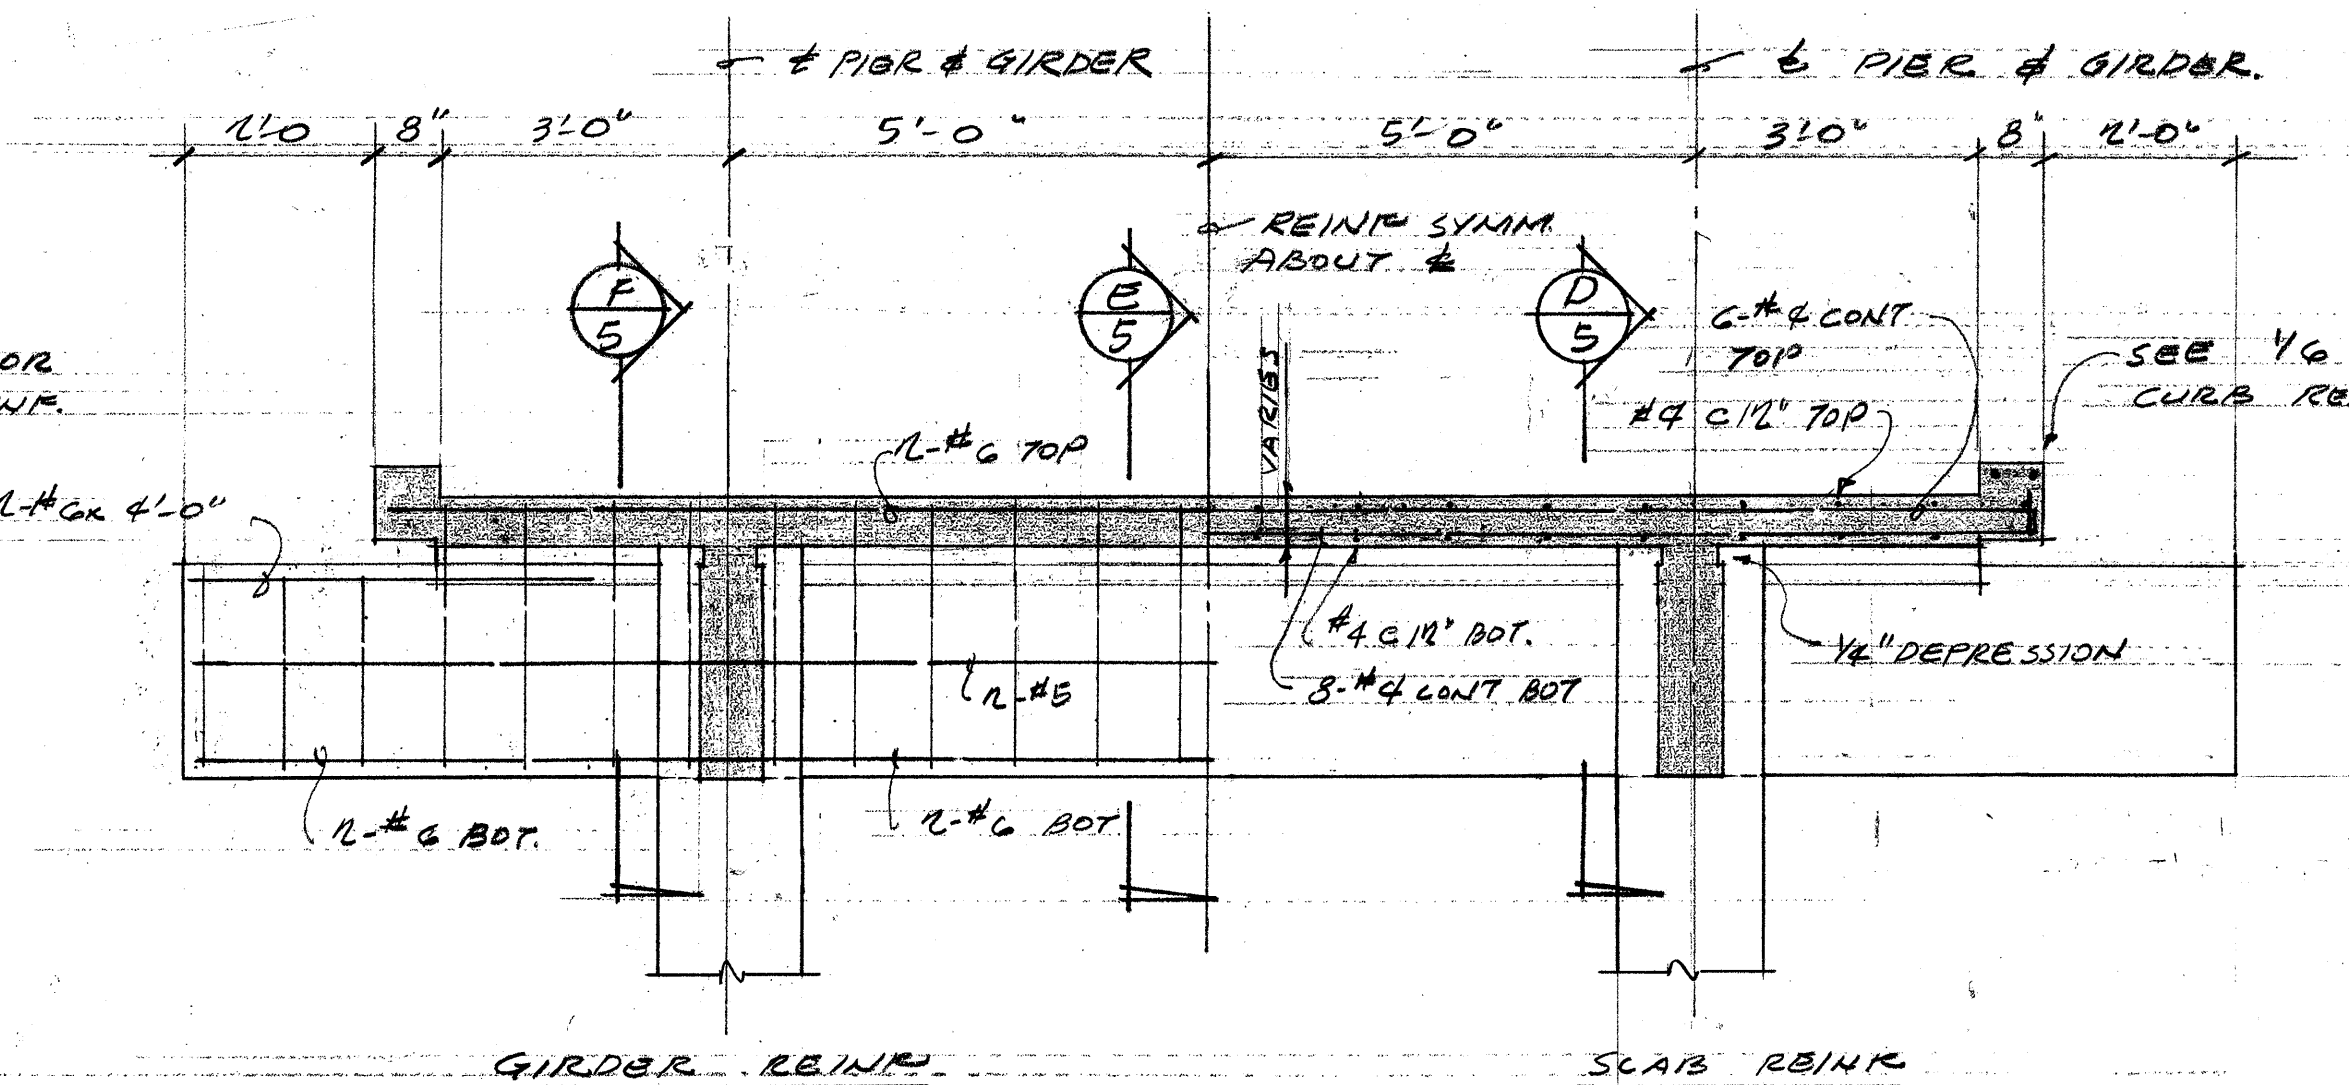

SECTION G-G
SCALE: 1/2" = 1'-0"

NOTE
SEE SECT. D/D
FOR REINF DETAILS
NOT NOTED.

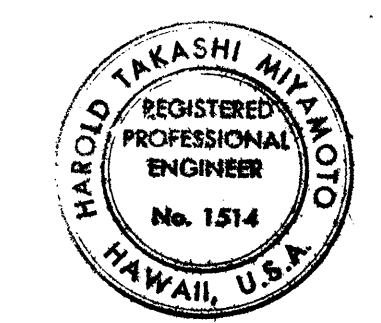

THIS WORK WAS PREPARED BY ME
OR UNDER MY SUPERVISION
Harold Takashi Miyamoto

STATE OF HAWAII
DEPARTMENT OF TRANSPORTATION
HIGHWAYS DIVISION

PEDESTRIAN OVERPASS

PROJECT No. GD 65-335

SECTIONS
LIKELIKE HIGHWAY AT ANOI RD. KANEHOE, OAHU

Scale: As Noted
Sept. 27, 1968

SHEET No. 5 OF 12 SHEETS

SURVEY PLOTTED BY	DATE
DESIGNED BY	
TRACED BY	
QUANTITIES BY	
CHECKED BY	
ORIGINAL PLAN	
NOTE BOOK	
NO.	