
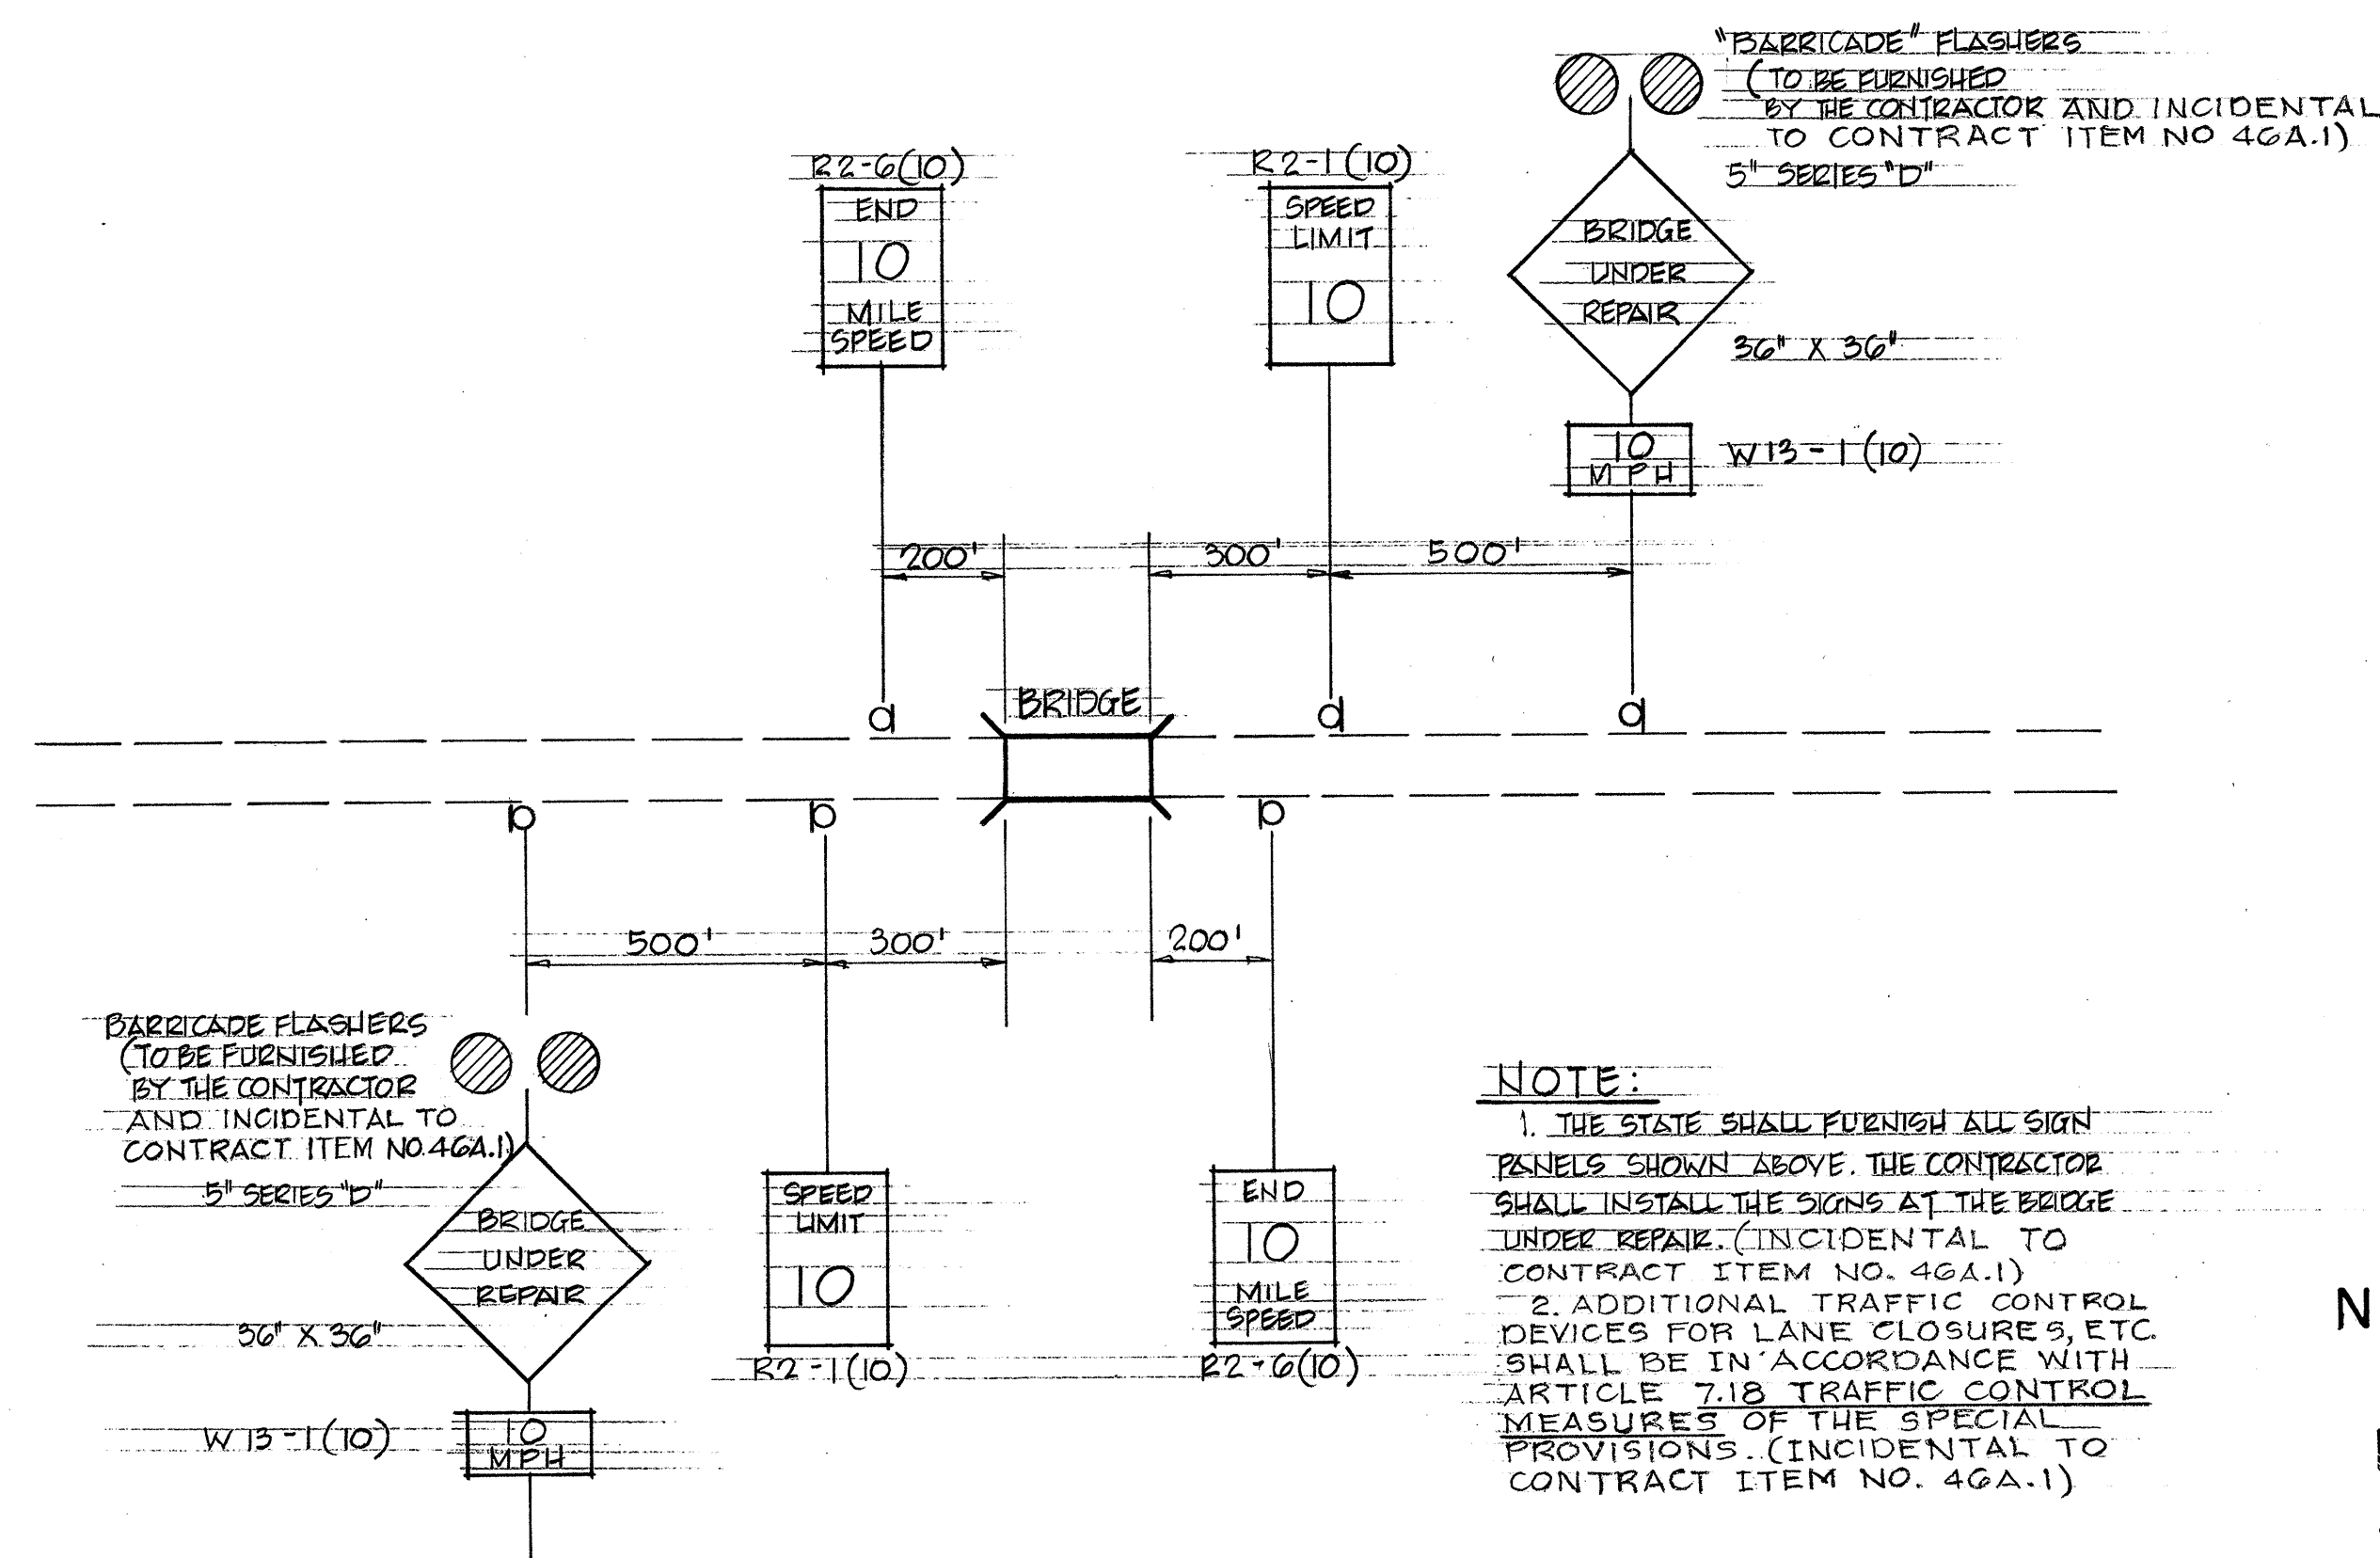


FED. ROAD DIST. NO.	STATE	PROJ. NO.	FISCAL YEAR	SHEET NO.	TOTAL SHEETS
HAWAII	HAW.	83E-05-09	1968	1	3

STATE OF HAWAII
DEPARTMENT OF TRANSPORTATION
HIGHWAYS DIVISION
HONOLULU, HAWAII

"AS BUILT"
PLANS OF
REPAIRS TO KAHANA BRIDGE #56

KAMEHAMEHA HIGHWAY
PROJECT NO. 83E-05-09
DISTRICT OF KOOLAULO
ISLAND OF OAHU

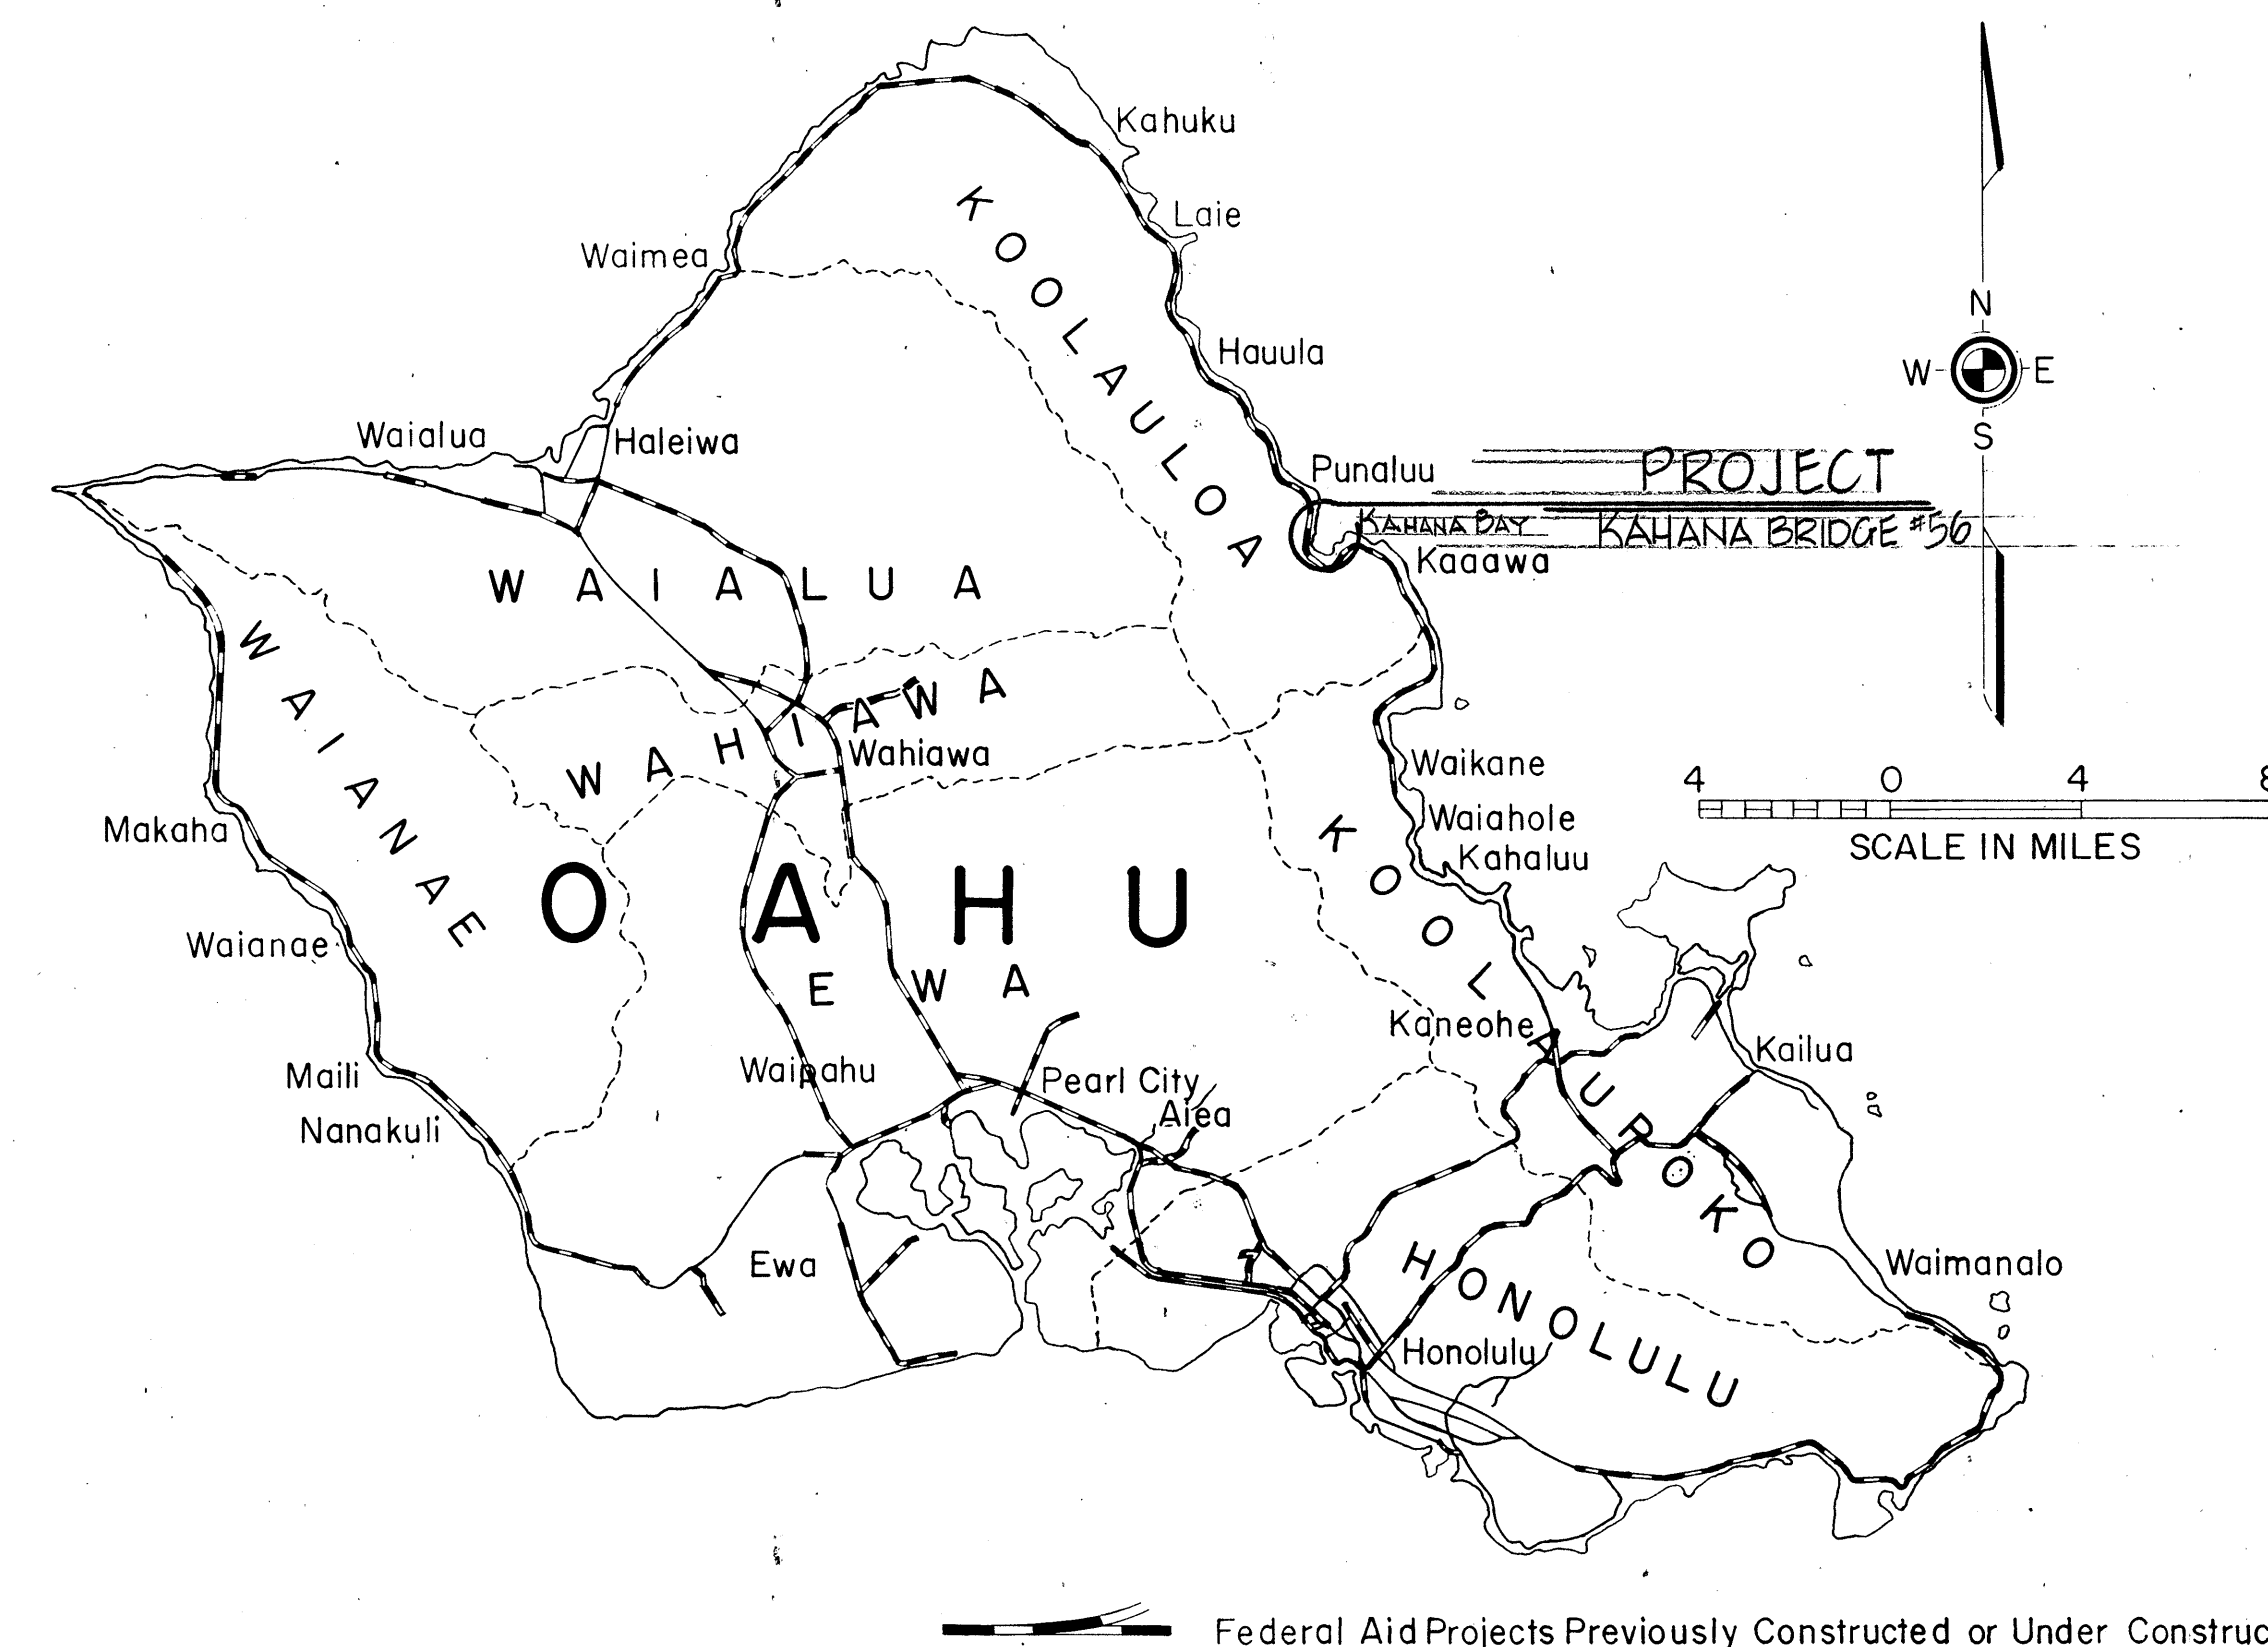

NOTE:
1. THE STATE SHALL FURNISH ALL SIGN PANELS SHOWN ABOVE. THE CONTRACTOR SHALL INSTALL THE SIGNS AT THE BRIDGE UNDER REPAIR. (INCIDENTAL TO CONTRACT ITEM NO. 46A.1)
2. ADDITIONAL TRAFFIC CONTROL DEVICES FOR LANE CLOSURES, ETC. SHALL BE IN ACCORDANCE WITH ARTICLE 7.18 TRAFFIC CONTROL MEASURES OF THE SPECIAL PROVISIONS. (INCIDENTAL TO CONTRACT ITEM NO. 46A.1)

NOTE:
ALL CHANGES MADE DURING CONSTRUCTION
HAVE BEEN NOTED IN RED ON THESE TRACINGS
AND CHECKED BY:

H. Hasuika
PROJECT ENGINEER
7/26/71
DATE

SITE PLAN
NOT TO SCALE

DEPARTMENT OF TRANSPORTATION
STATE OF HAWAII
APPROVED:
E. Alvey Wright 10/25/68
DIR. OF TRANSPORTATION DATE
SHEET No. 1 of 3 SHEETS

R. TERADA OCT. 1968

0-6-10