

INDEX TO DRAWINGS	
SHEET NO.	DESCRIPTION
1	TITLE SHEET
2 - 4	TYPICAL SECTIONS
5	SURCHARGE SITE PLAN
6 - 10	PLAN AND PROFILE
11	SUPERELEVATION DIAGRAM
12 - 13	INTERSECTION DETAIL PLANS
14 - 24	REGULATORY, WARNING, AND GUIDE SIGNS
25 - 34	MISCELLANEOUS STANDARD DETAILS
35 - 55	DRAINAGE SYSTEM
56 - 61	WATER SYSTEM
62 - 68	HIGHWAY LIGHTING AND ELECTRICAL SYSTEM
69 - 81	AHUMANU STREAM BRIDGE
82 - 109	CROSS SECTIONS

STATE OF HAWAII

DEPARTMENT OF TRANSPORTATION

HIGHWAYS DIVISION

HONOLULU, HAWAII

"AS BUILT" PLANS OF


KAHEKILI HIGHWAY

CONNECTION TO KAMEHAMEHA HIGHWAY

PROJECT NO. BD 67-320

DISTRICT OF KOOLAUPOKO

ISLAND OF OAHU

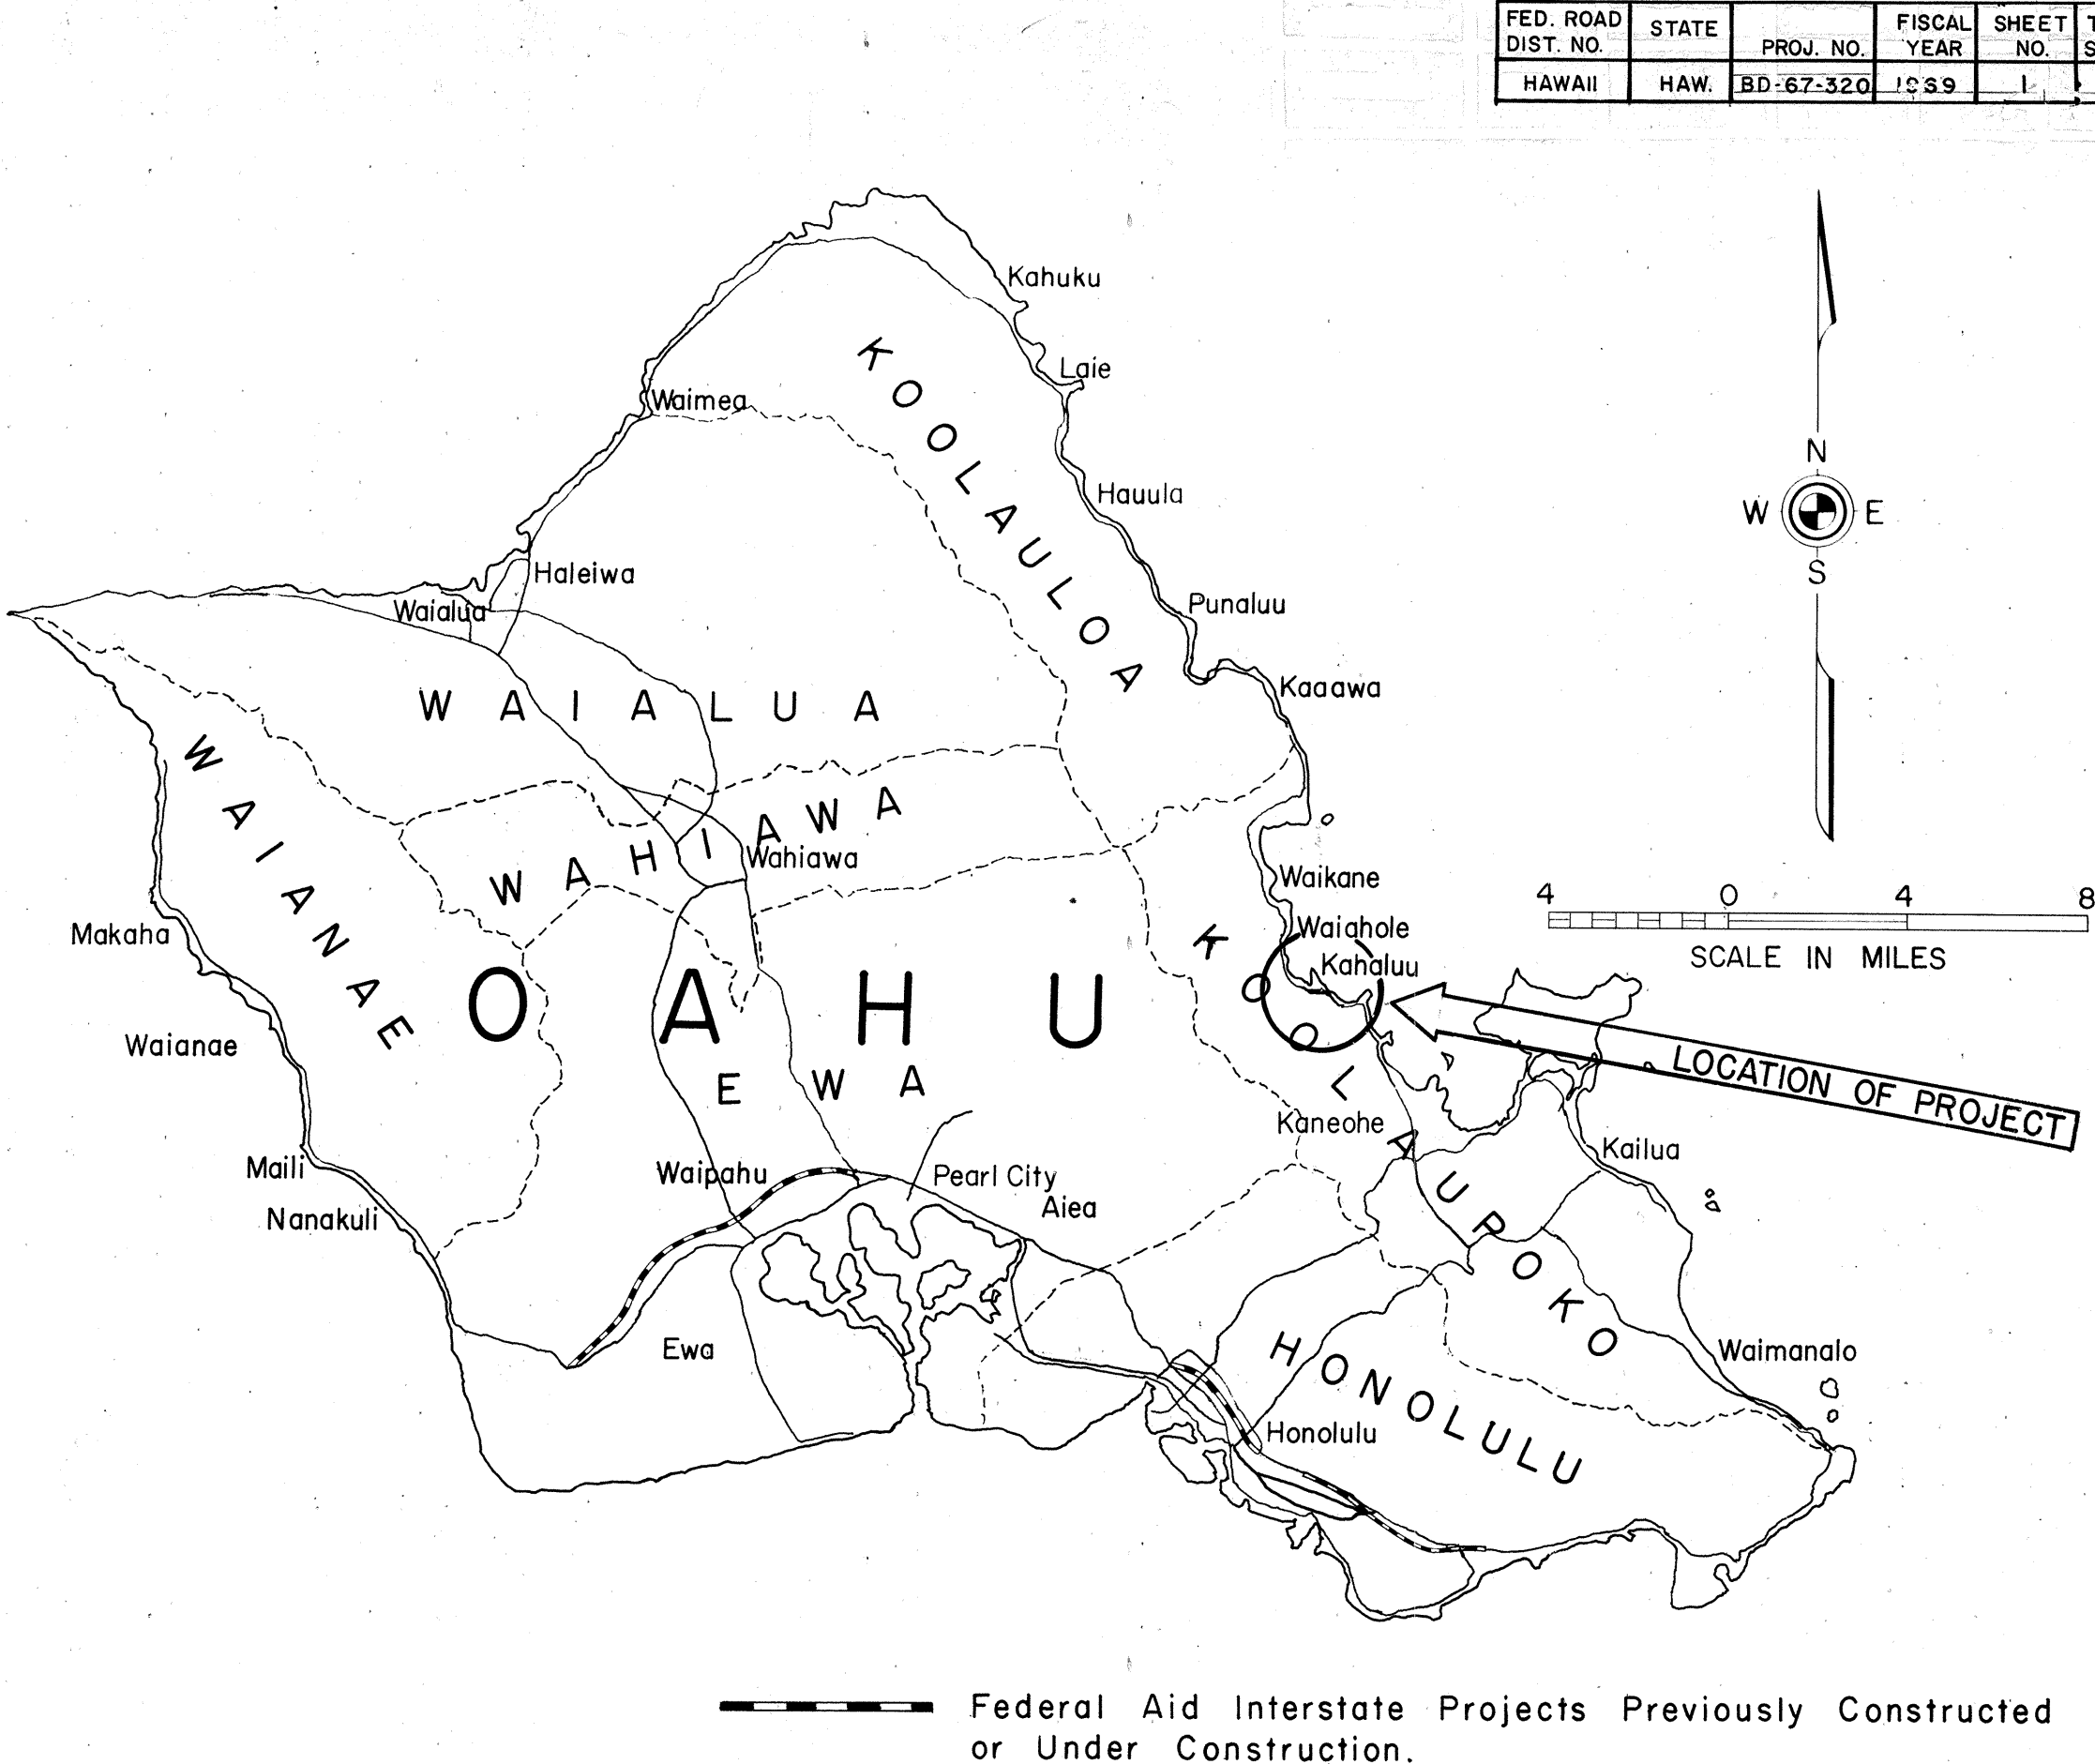

NOTE

ALL THE QUANTITIES SHOWN ARE ORIGINAL THEORETICAL QUANTITIES. FOR ACTUAL QUANTITIES, REFER TO PROJECT LEDGER AND/OR COMPUTATION BOOK. ALL CHANGES MADE DURING CONSTRUCTION HAVE BEEN INCORPORATED ON THESE PLANS.

[Signature] 12/4/77
RESIDENT ENGINEER

DESIGN CLASSIFICATION

ADT (1968)	6,000
INTERIM ADT (1978)	15,800
DESIGN ADT (1988)	25,400
DHV	2,540
D	80/20
T	3.0 %
T ₂₄	5.0 %
V	60 MPH

CHUNG DHO AHN & ASSOCIATES, INC.
CIVIL ENGINEERS


DEPARTMENT OF TRANSPORTATION STATE OF HAWAII	
APPROVED:	
<i>[Signature]</i>	7/5/69
DIR. OF TRANSPORTATION	DATE

SCALES

PLAN & PROFILE.....HOR VER 1" = 50' 1" = 5'

DETAIL ROADWAY PLAN.....1" = 20'

CROSS SECTION.....HOR VER 1" = 10' 1" = 10'

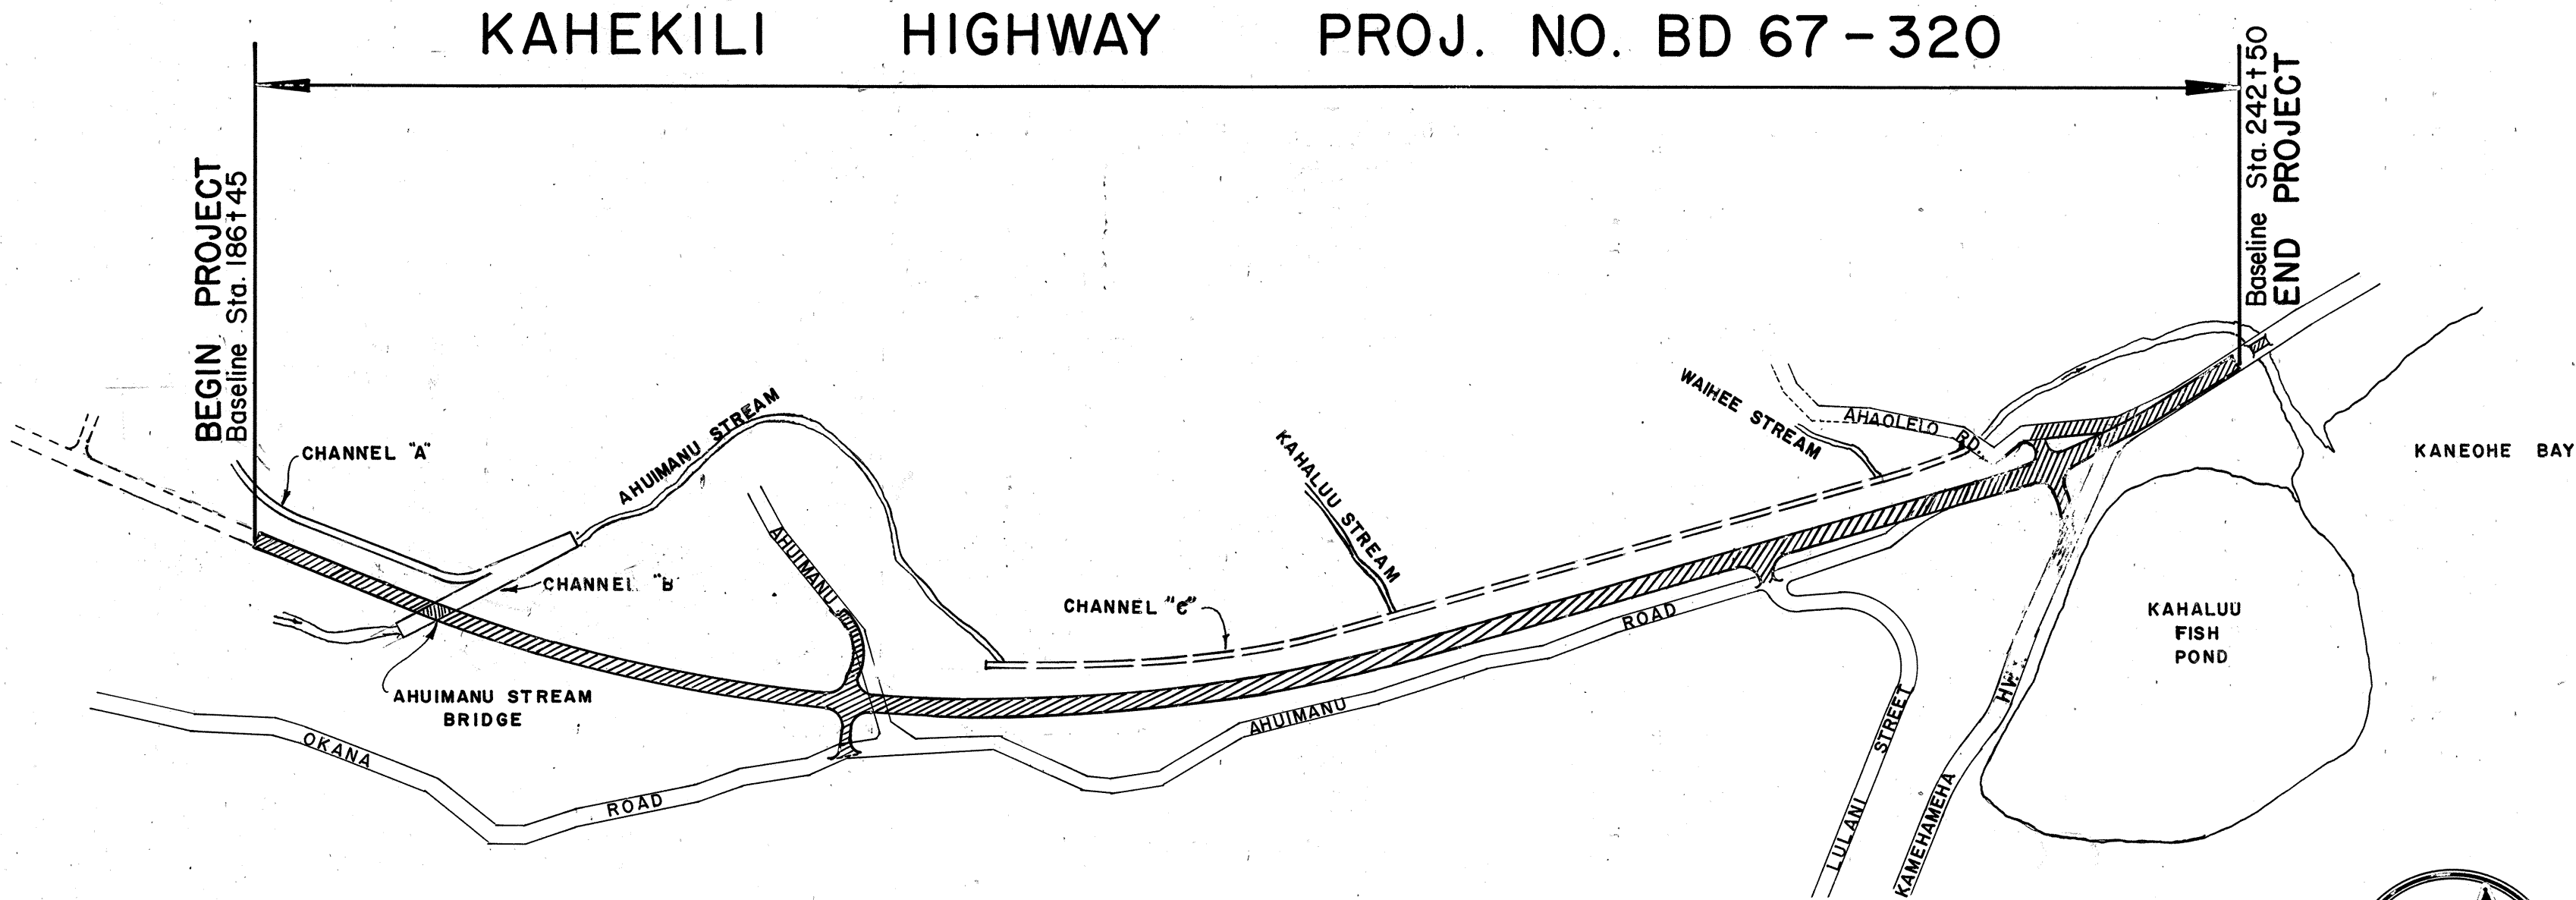


LAYOUT PLAN

GROSS LENGTH OF PROJECT 1.052 Miles

BRIDGE OVER 20.00' SPAN 0.014 Mile

NET LENGTH OF ROADWAY 1.040 Miles

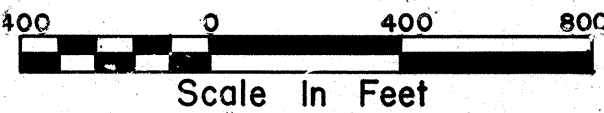

R. TERADA FEB. 1969