INDEX TO DRAWINGS	
SHEET NO.	DESCRIPTION
l	TITLE SHEET
2-5	PLAN, TYPICAL
Aller and a second policy of the second and a	SECTION AND DETAIL
	OF FOOTBRIDGES
	3
3	
	, , ,
and the second s	
<u> </u>	

STATE OF HAWAII

DEPARTMENT OF TRANSPORTATION HIGHWAYS DIVISION


HONOLULU, HAWAII


AS BUILT

PLANS FOR

KAMEHAMEHA HIGHWAY, FOOTBRIDGES AT WAIAHOLE AND KAHANA STREAMS

PROJECT NO. 83DE-02-71

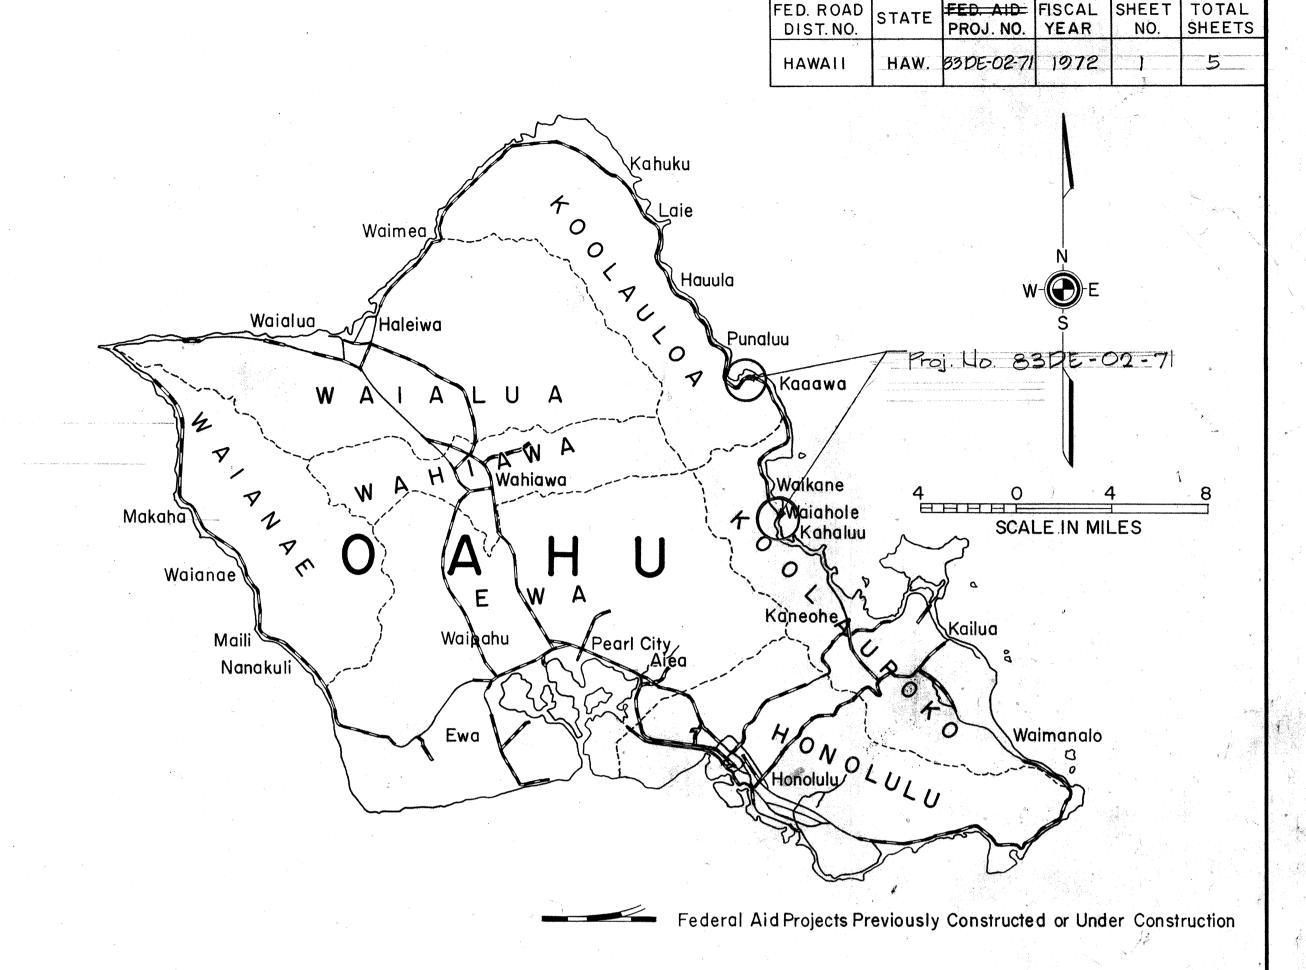

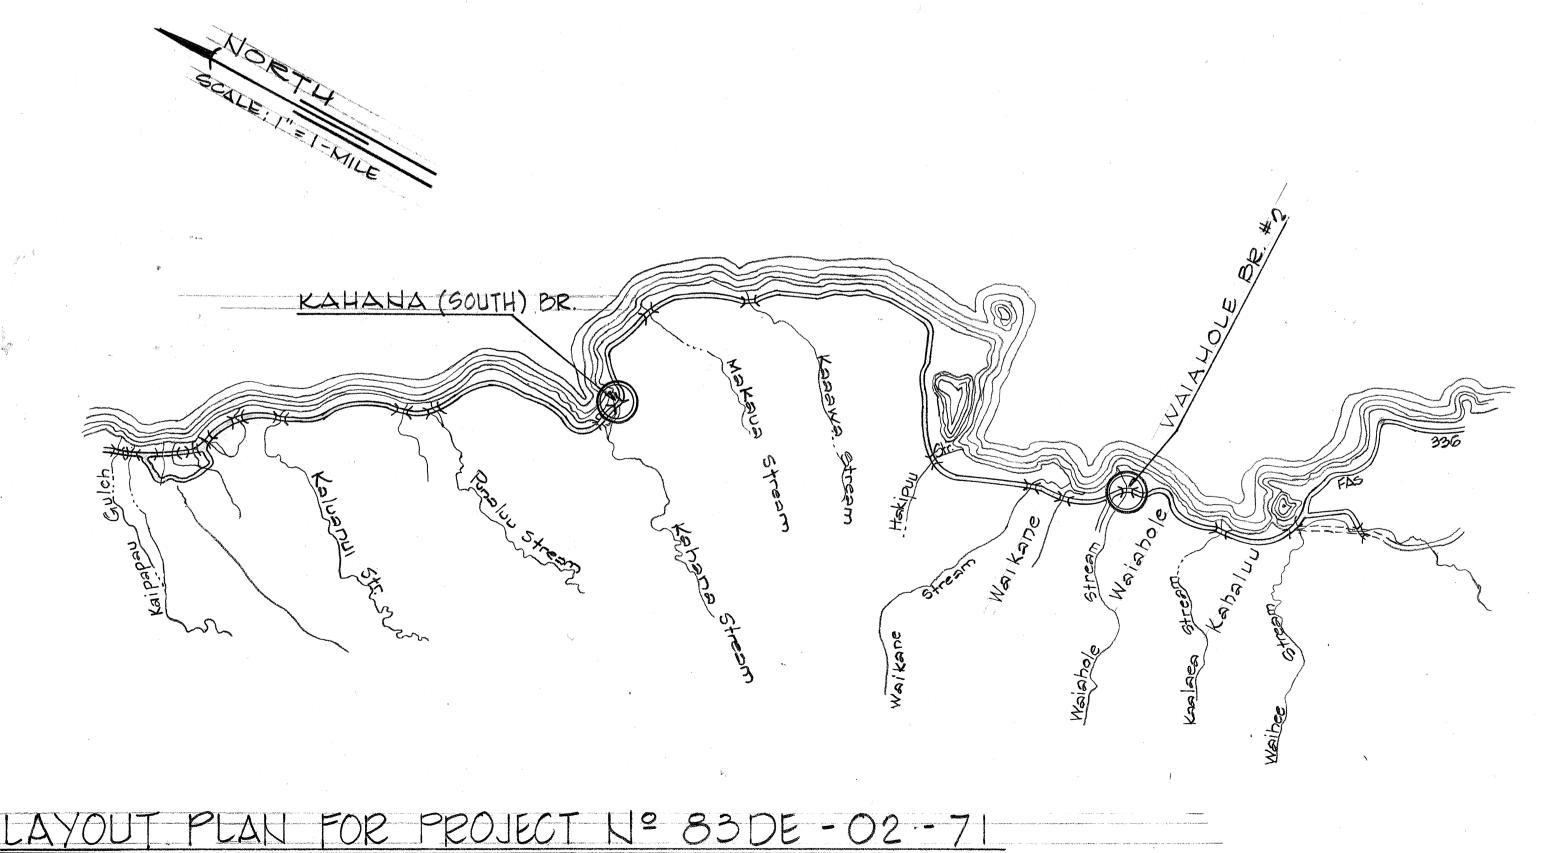

NOTE:

ALL CHANGES MADE DURING CONSTRUCTION HAVE BEEN NOTED IN RED ON THESE TRACINGS AND CHECKED BY:

STATE OF HAWAII APPROVED: FOR DIR. OF TRANSPORTATION