_? IN	DEX	TO	DRAWIN	IGS			
SHEET NO.	DESCRIPTION						
			SHEET				
2	ELE	CTRI	CAL PLA		Andreas of the same of the sam		
3	MIS	CELL	ANEOUS	DETA	IL5		
	;						
				*			
	7		,				
	•	•	,				
					,		
		,					
					,		
٠.			,				
				,			




STATE OF HAWAII


DEPARTMENT OF TRANSPORTATION HIGHWAYS DIVISION

> HONOLULU, HAWAII "AS BUILT" PLANS FOR

INSTALLATION OF HIGHWAY LIGHTS KAMEHAMEHA HIGHWAY, STREET LIGHTS BETWEEN WAIKANE & KUALOA POINT.

PROJECT NO. 83D - 03 - 71

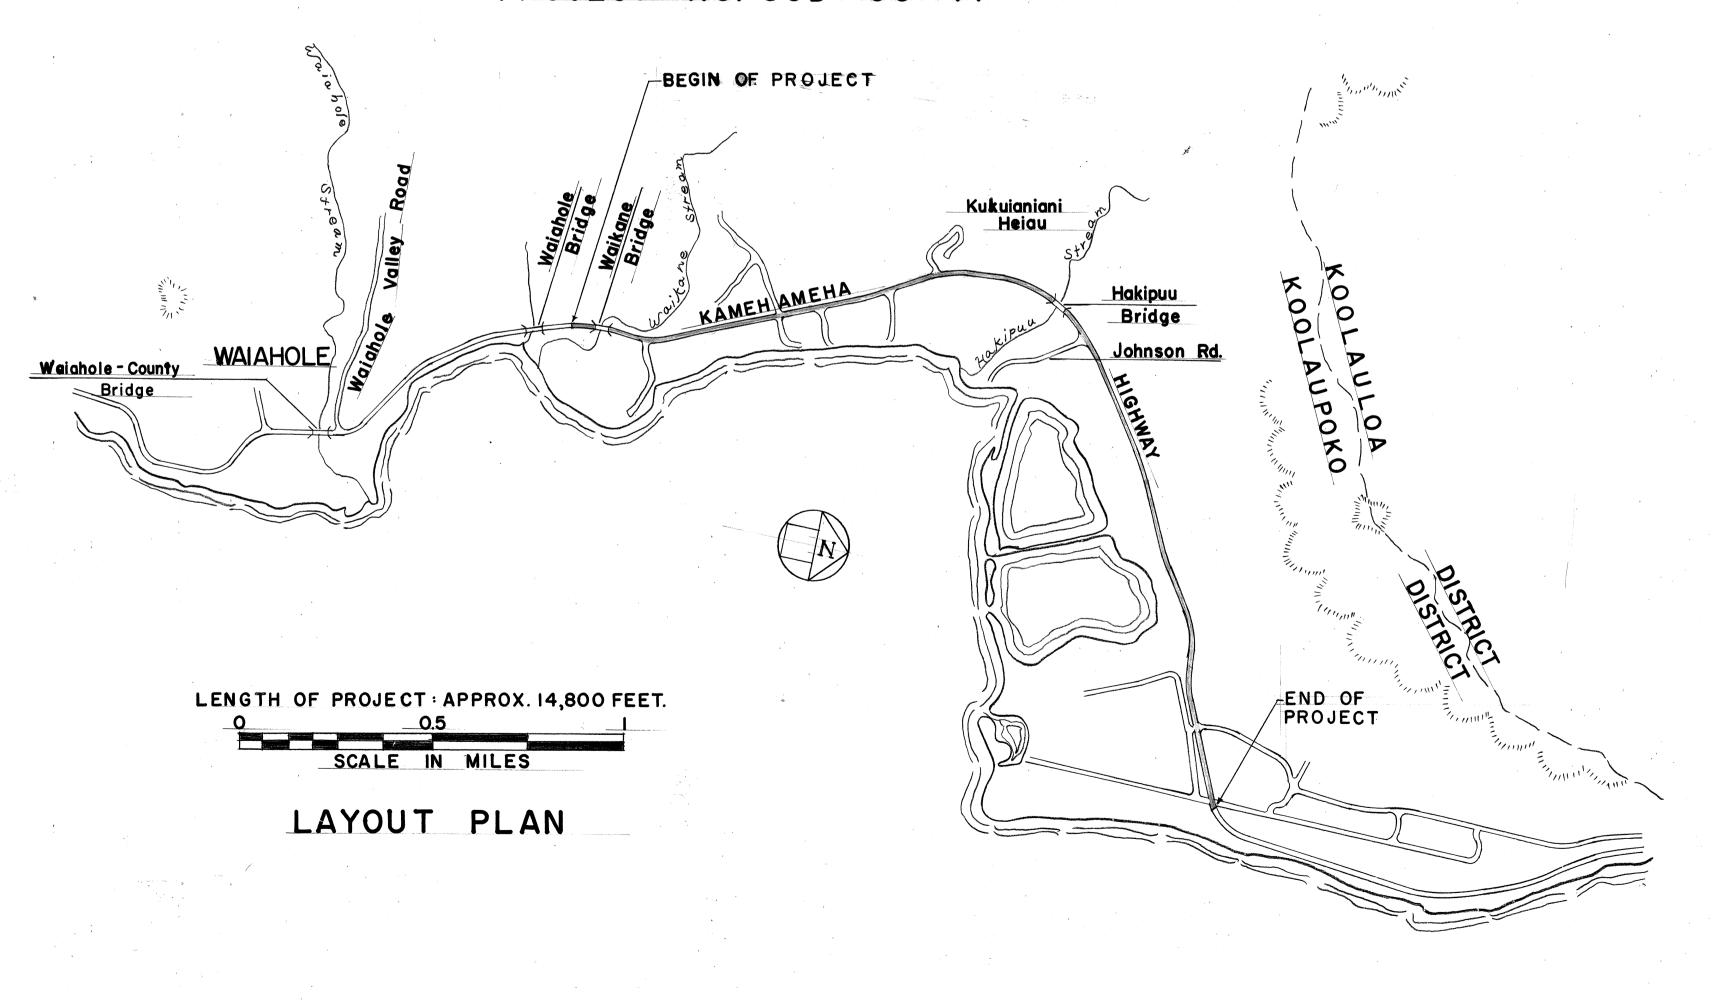

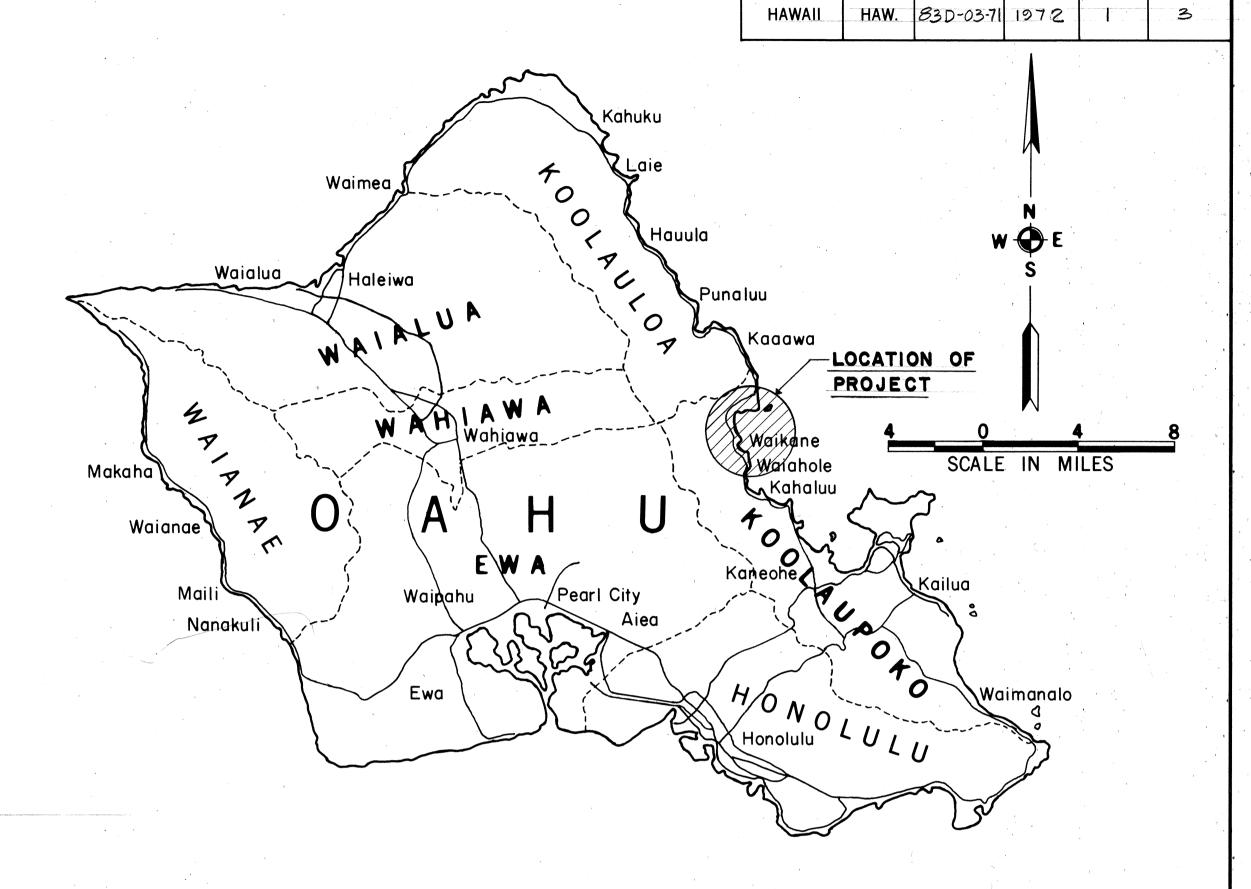

NOTE:

ALL CHANGES MADE DURING CONSTRUCTION HAVE BEEN NOTED IN RED ON THESE TRACINGS AND CHECKED BY

H. Hasinke

PROJECT ENGINEER	•	DATE	
APPROVALS:			
& Swahin	ť		4-17
AWAIIAN ELECTRIC Co.	,		DATE
F. Lum			4-17-
ANALIAN TELEPHONE G	 And the state of t		DATE

8-3-73

NAKAMURA, KAWABATA & ASSOC., INC. Consulting Electrical Engineers 1507 S. King Street Honolulu, Hawaii 96814 ENGINEER

DEPARTMENT OF TRANSPORTATION STATE OF HAWAII APPROVED:

FOR DIR. OF TRANSPORTATION

Tynn Nakamina

548-7532 PHONE