



FED. ROAD DIST. NO.	STATE	PROJ. NO.	FISCAL YEAR	SHEET NO.	TOTAL SHEETS
HAWAII	HAW.	89D-01-72	1972	2	26

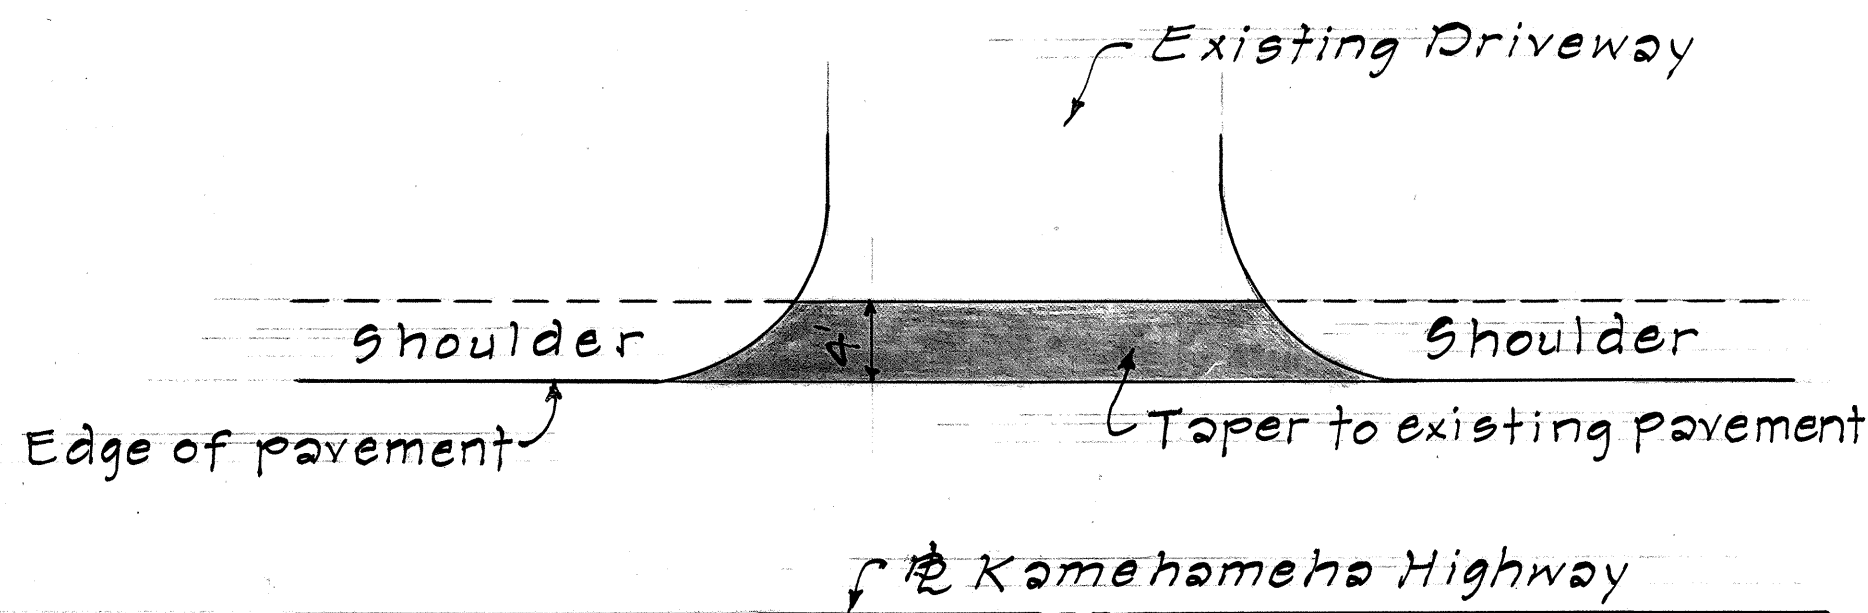

TYPICAL PLAN
DRIVEWAY CONNECTION
NOT TO SCALE

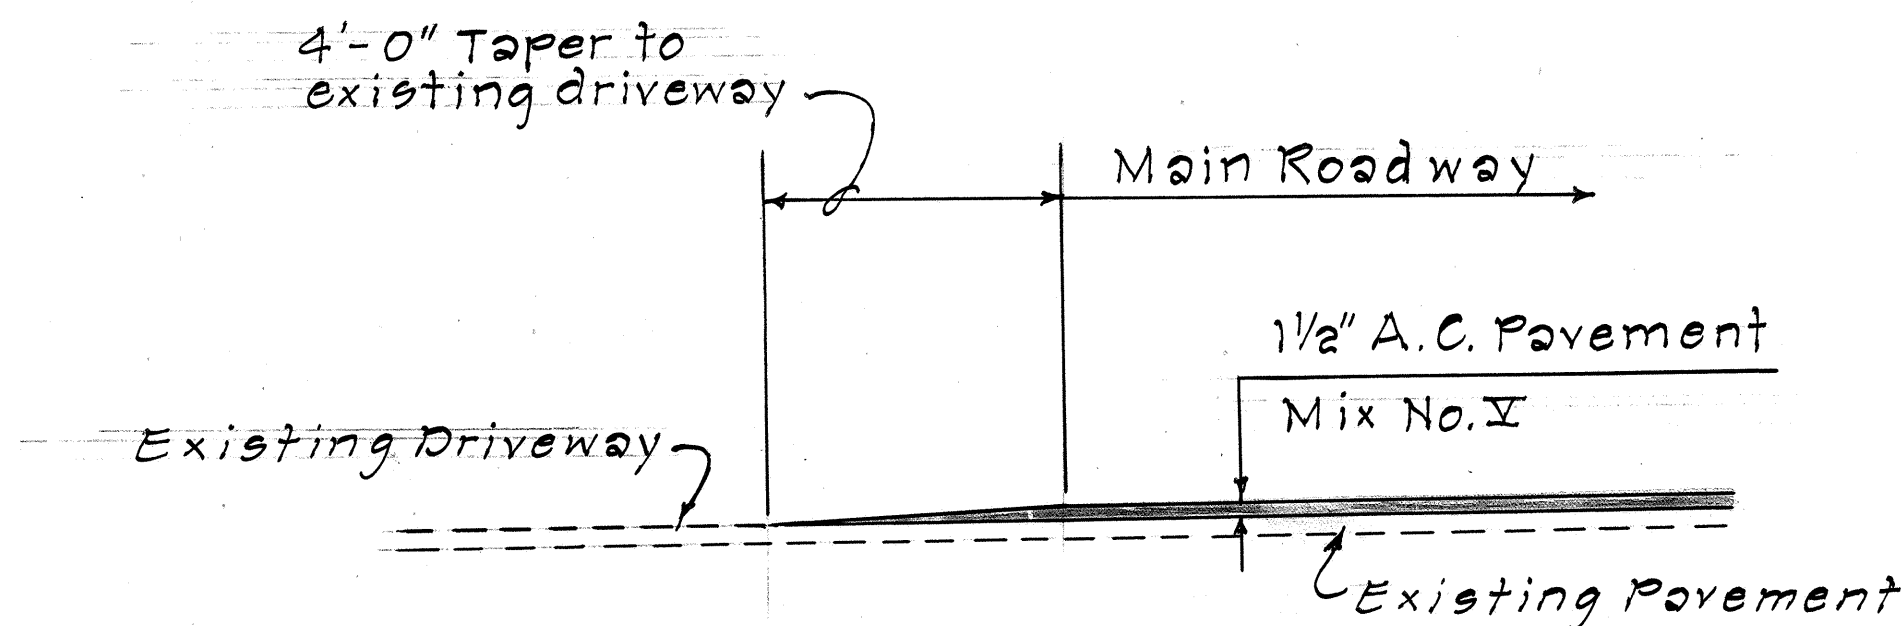


TYPICAL SECTION
DRIVEWAY CONNECTION
NOT TO SCALE

NOTE:


- Between Station 906+50 to Station 910+00 only resurfacing with 1 1/2" A.C. Pavement Mix No. V and installation of pavement markers will be required

Existing Outbound Lane Width	10.0'
Existing Inbound Lane Width	10.0' Except at
Sta. 914+00 ±	10.0'
" 914+35 ±	11.1'
" 915+46.5 ±	12.0'
" 916+33.4 ±	12.2'
" 916+85 ±	14.0'
" 918+52	14.0'
" 919+07.4	12.16'
" 919+63	10.0'


For Info. Only

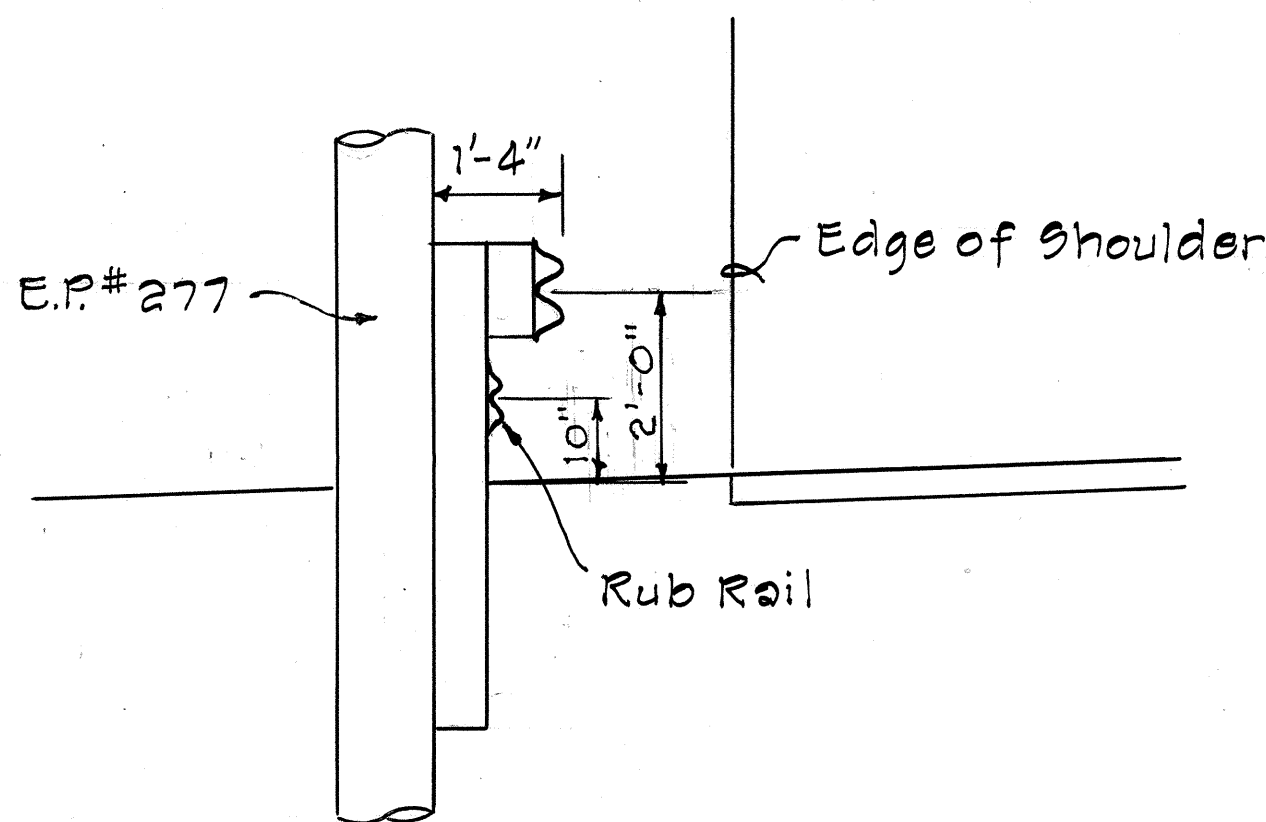

TYPICAL SECTION AT E.P. #277
FOR INSTALLATION OF GUARD RAIL
WITH RUB RAIL ON STEEL POST
SCALE: 1/2" = 1'-0"

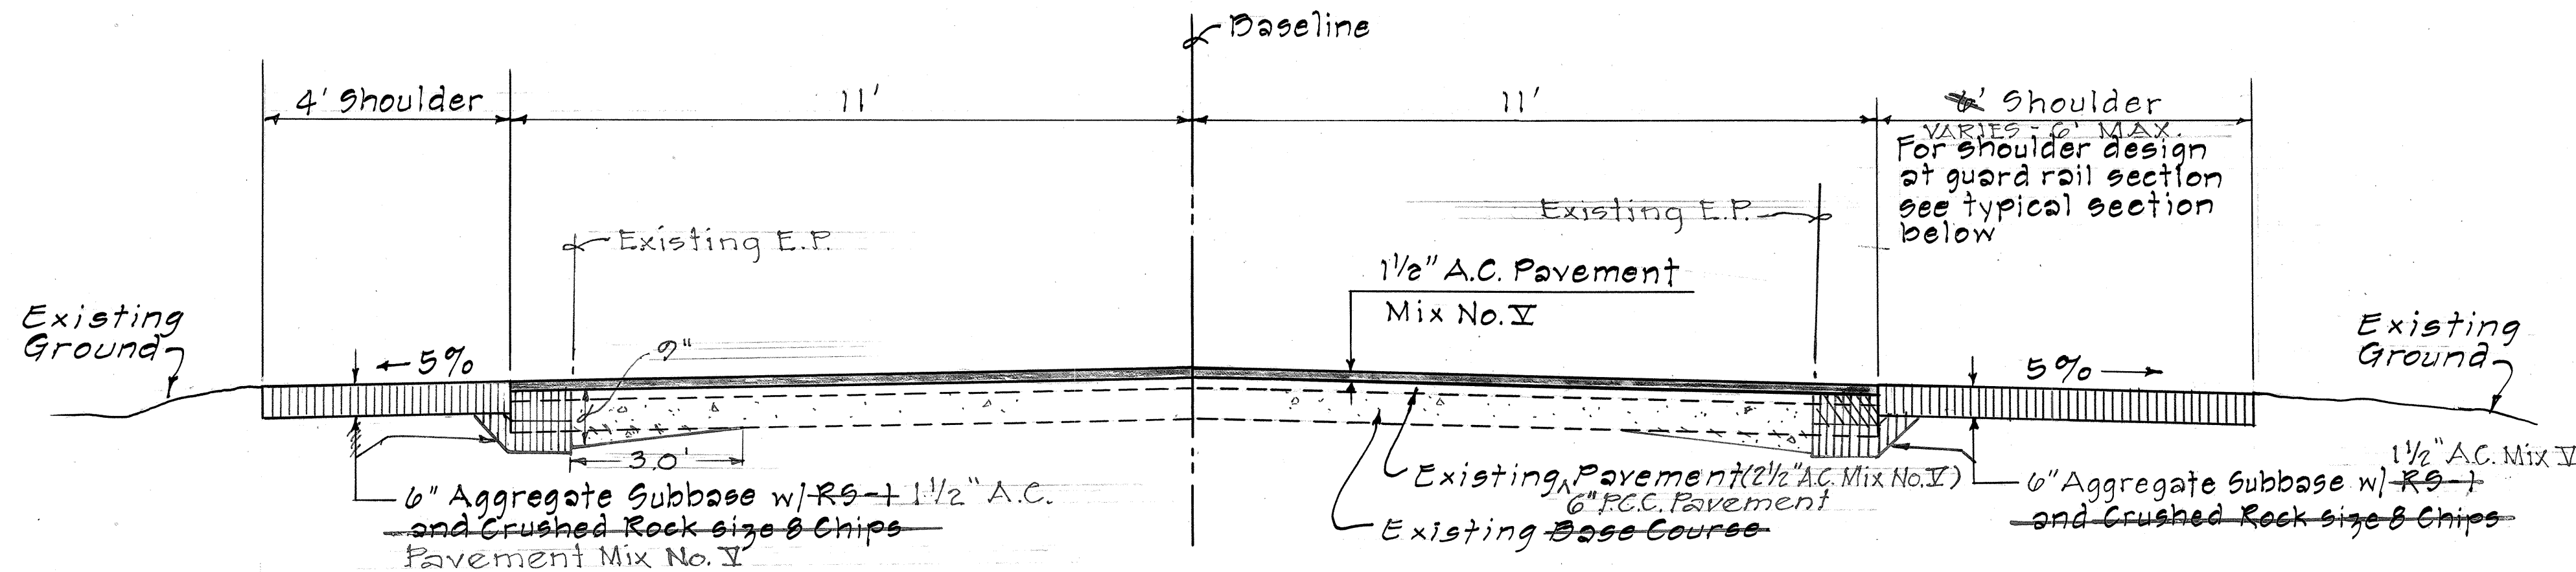


TYPICAL SECTION ON TANGENT
STA. 910+00 TO STA. 913+79.4
STA. 919+07.4 TO STA. 925+00
SCALE: 1/2" = 1'-0"

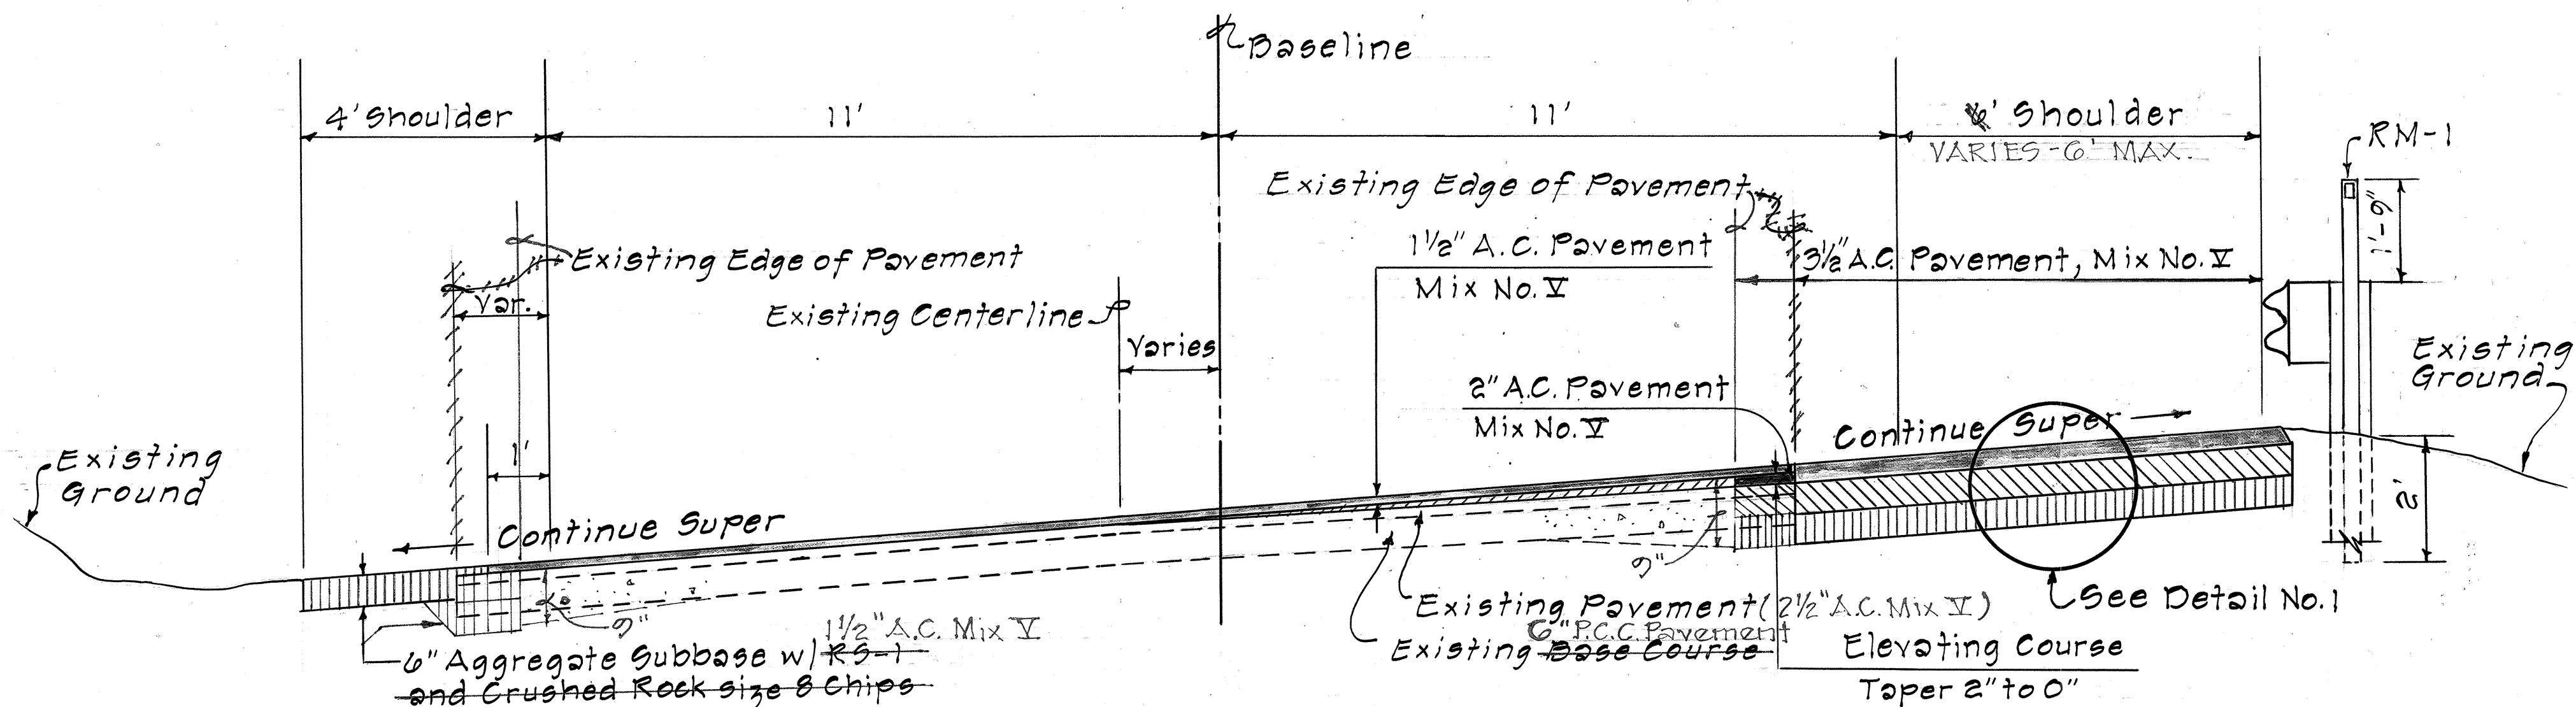

TYPICAL SECTION ON CURVE
STA. 913+79.4 TO STA. 919+07.4
SCALE: 1/2" = 1'-0"

(NOTE: Lt. & Rt. Edge of Pavement Edge Striped.)

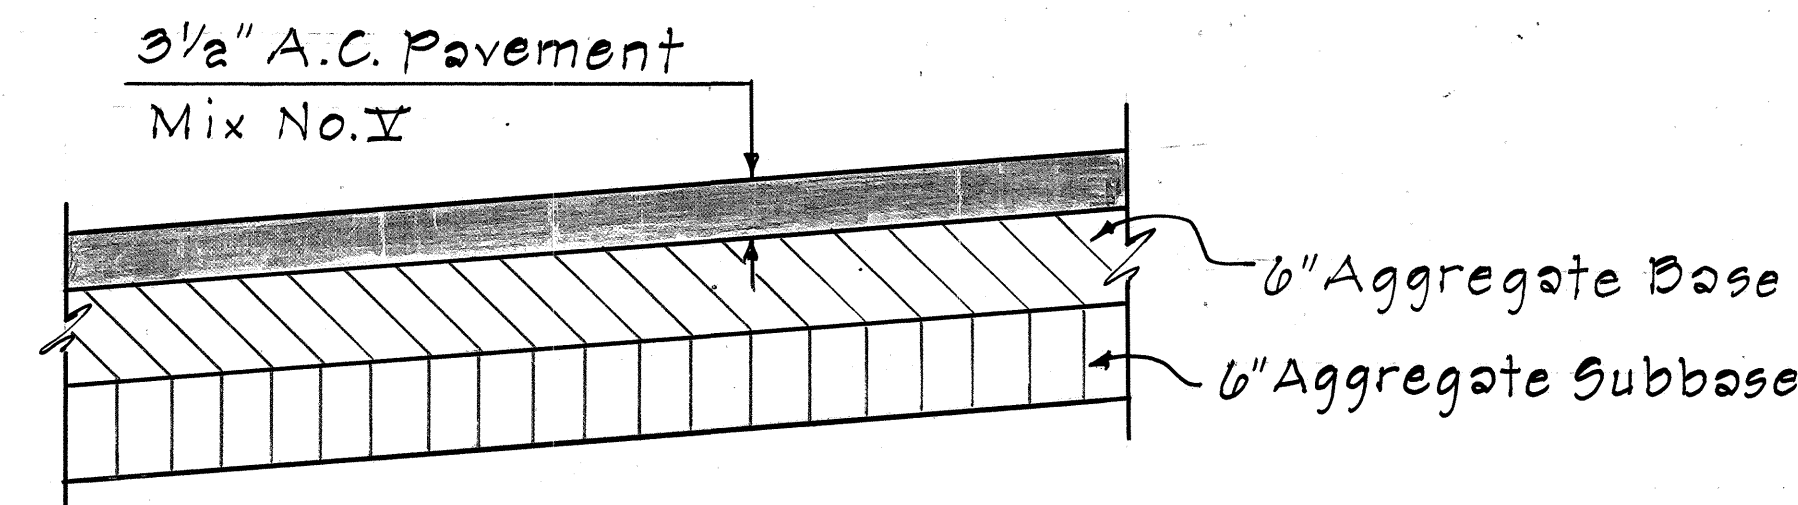

DETAIL NO. 1
SCALE: 1" = 1'-0"

STATE OF HAWAII
DEPARTMENT OF TRANSPORTATION
HIGHWAYS DIVISION
TYPICAL DETAILS
FOR
ROADWAY IMPROVEMENTS ON
KAMEHAMEHA HWY AT KAHANA BAY
PROJ. No. 89D-01-72
SCALE: AS NOTED DATE: MARCH, 1972
SHEET No. 1 OF 1 SHEETS

DATE	_____
SURVEY PLOTTED BY	_____
DRAWN BY	_____
DESIGNED BY	_____
CHECKED BY	_____
ORIGINAL PLAN	_____
NOTE BOOK	_____
No.	_____