





STATE OF HAWAII  
DEPARTMENT OF TRANSPORTATION  
HIGHWAYS DIVISION

HONOLULU, HAWAII

"AS BUILT" PLANS OF  
REPAIRS TO PUNALUU BRIDGE NO. 55  
KAMEHAMEHA HIGHWAY

PROJECT NO. 83D-01-74  
DISTRICT OF KOOLAULOA  
ISLAND OF OAHU

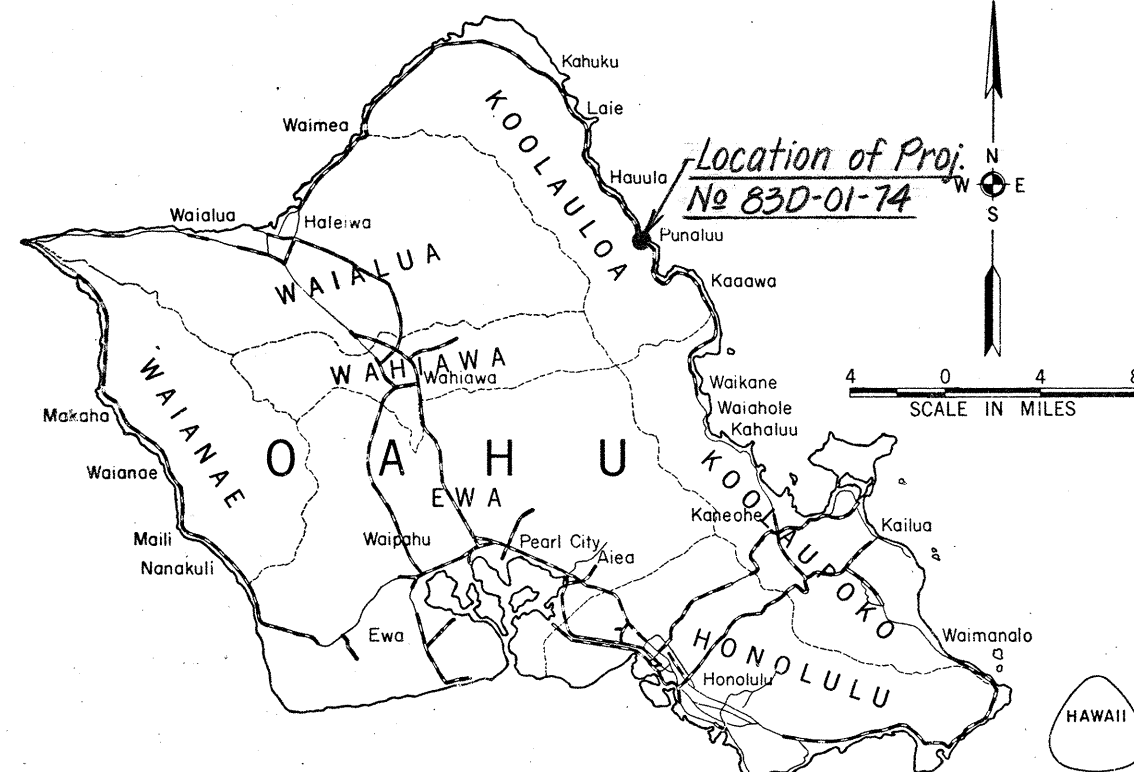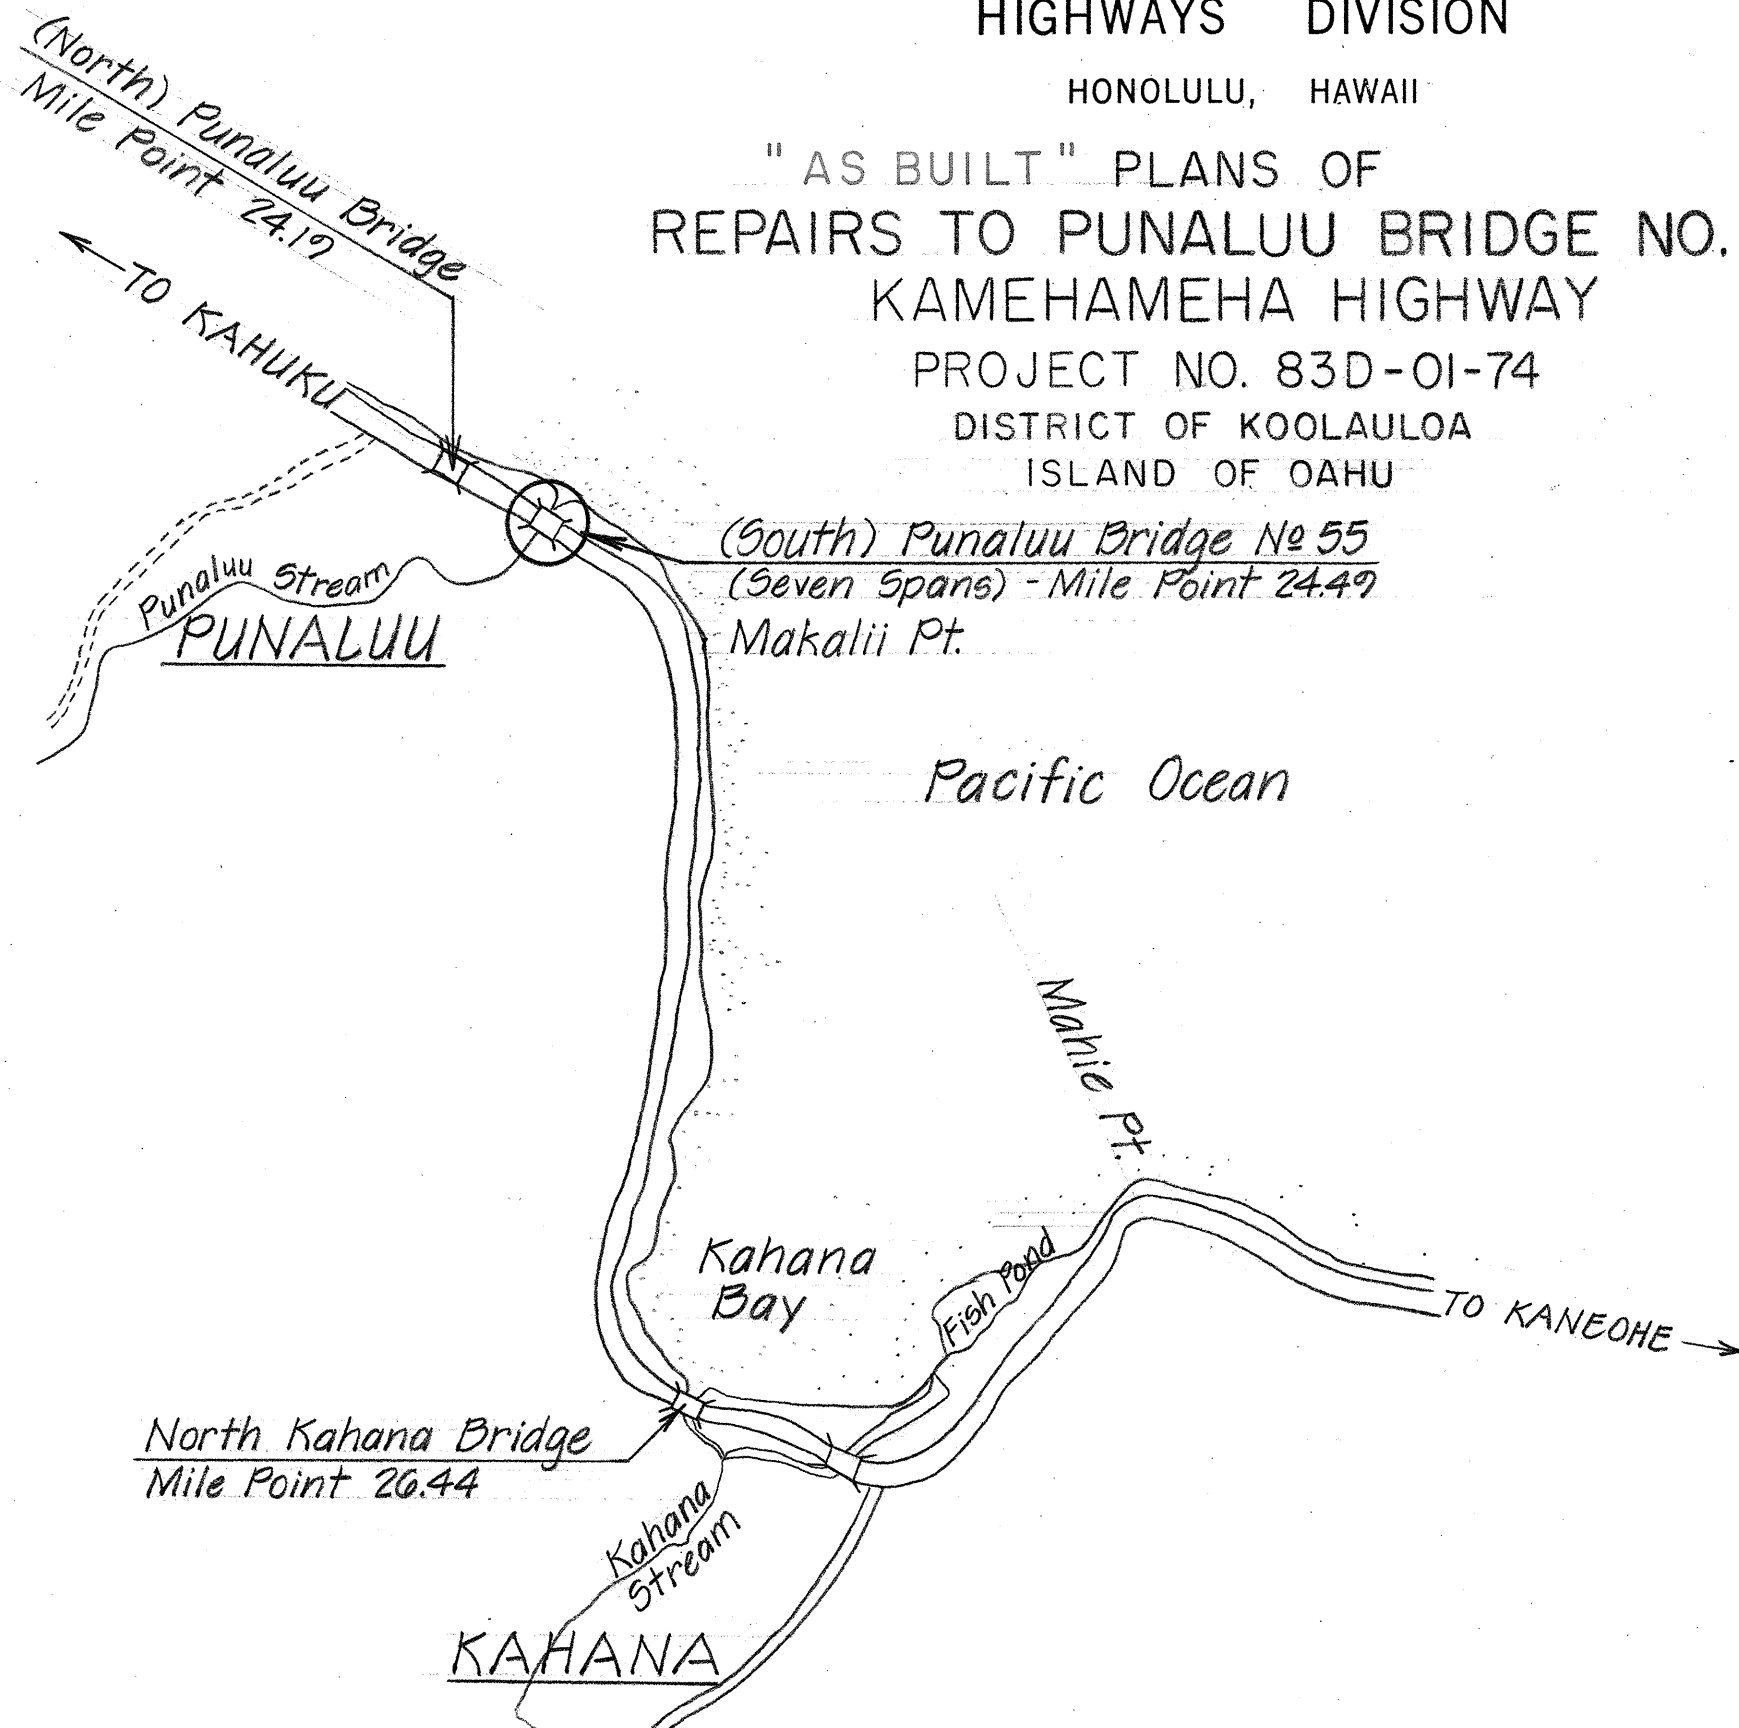

Location of Proj.  
No 83D-01-74

- NOTE: 1. NO STRUCTURAL CHANGES WERE  
MADE IN THIS PROJECT.  
2. ALL RED MARKINGS INDICATE  
REPAIRED WORK ONLY.

*John Y. J. Chun*  
RESIDENT ENGINEER

12/7/81  
DATE

DEPARTMENT OF TRANSPORTATION  
STATE OF HAWAII  
APPROVED:  
*Murray Lee* 12/8/73  
FOR DIR. OF TRANSPORTATION DATE