



FED. ROAD DIST. NO.	STATE	PROJ. NO.	FISCAL YEAR	SHEET NO.	TOTAL SHEETS
HAWAII	HAW.	83H-01-73	1973	2	4


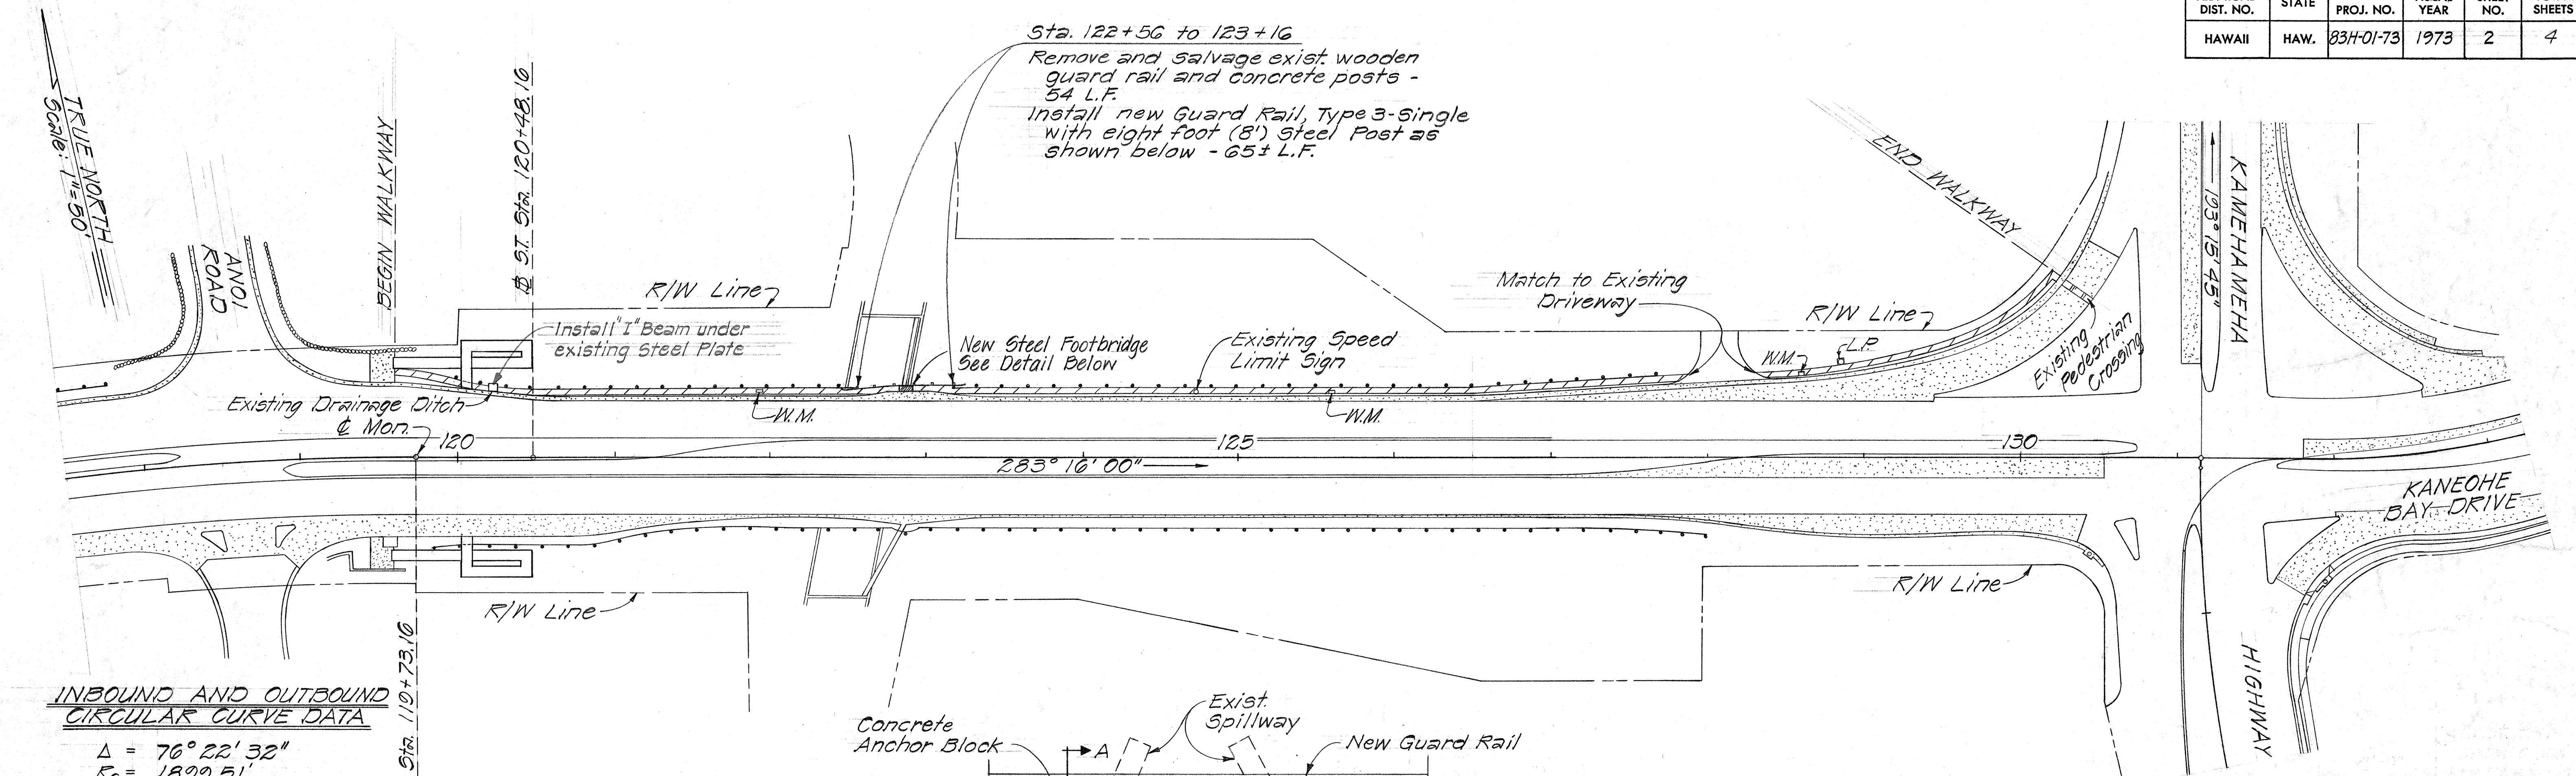


INBOUND AND OUTBOUND CIRCULAR CURVE DATA

$\Delta = 76^\circ 22' 32''$
 $R_c = 1839.51'$
 $D_c = 3^\circ 00' 59''$
 $T_c = 1424.11$
 $C_c = 2348.71$
 $L_c = 2532.00$

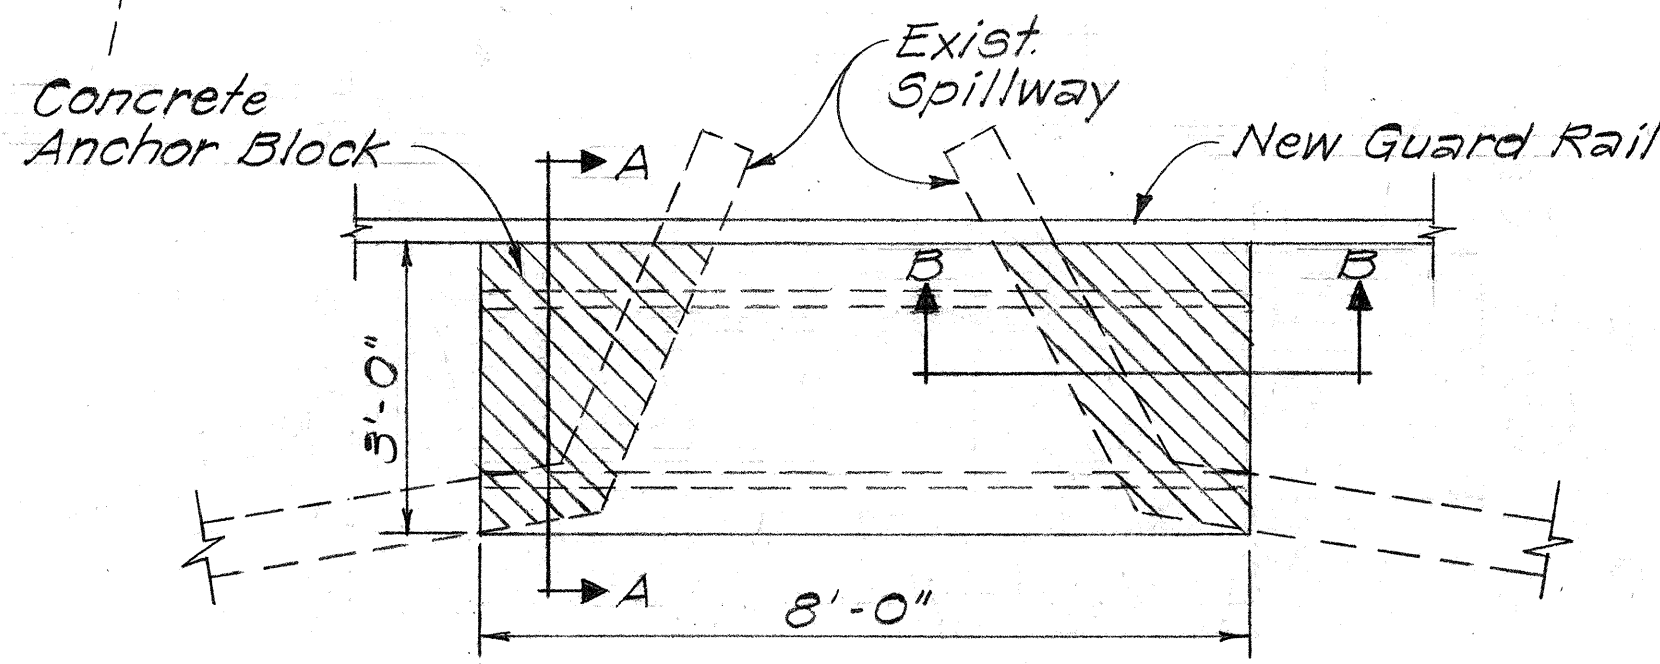


PLAN

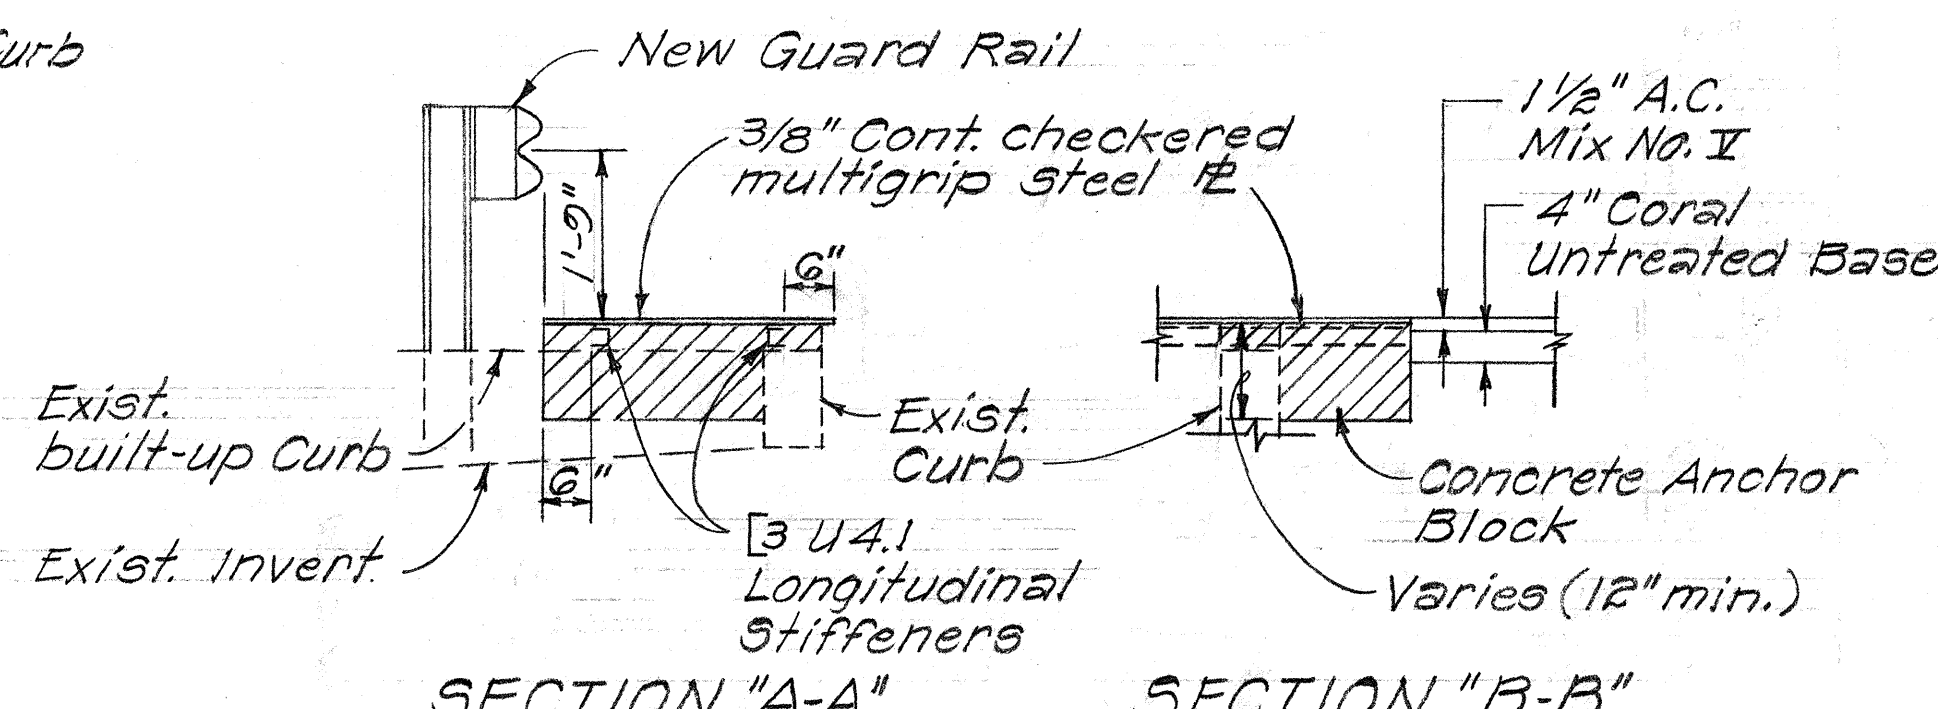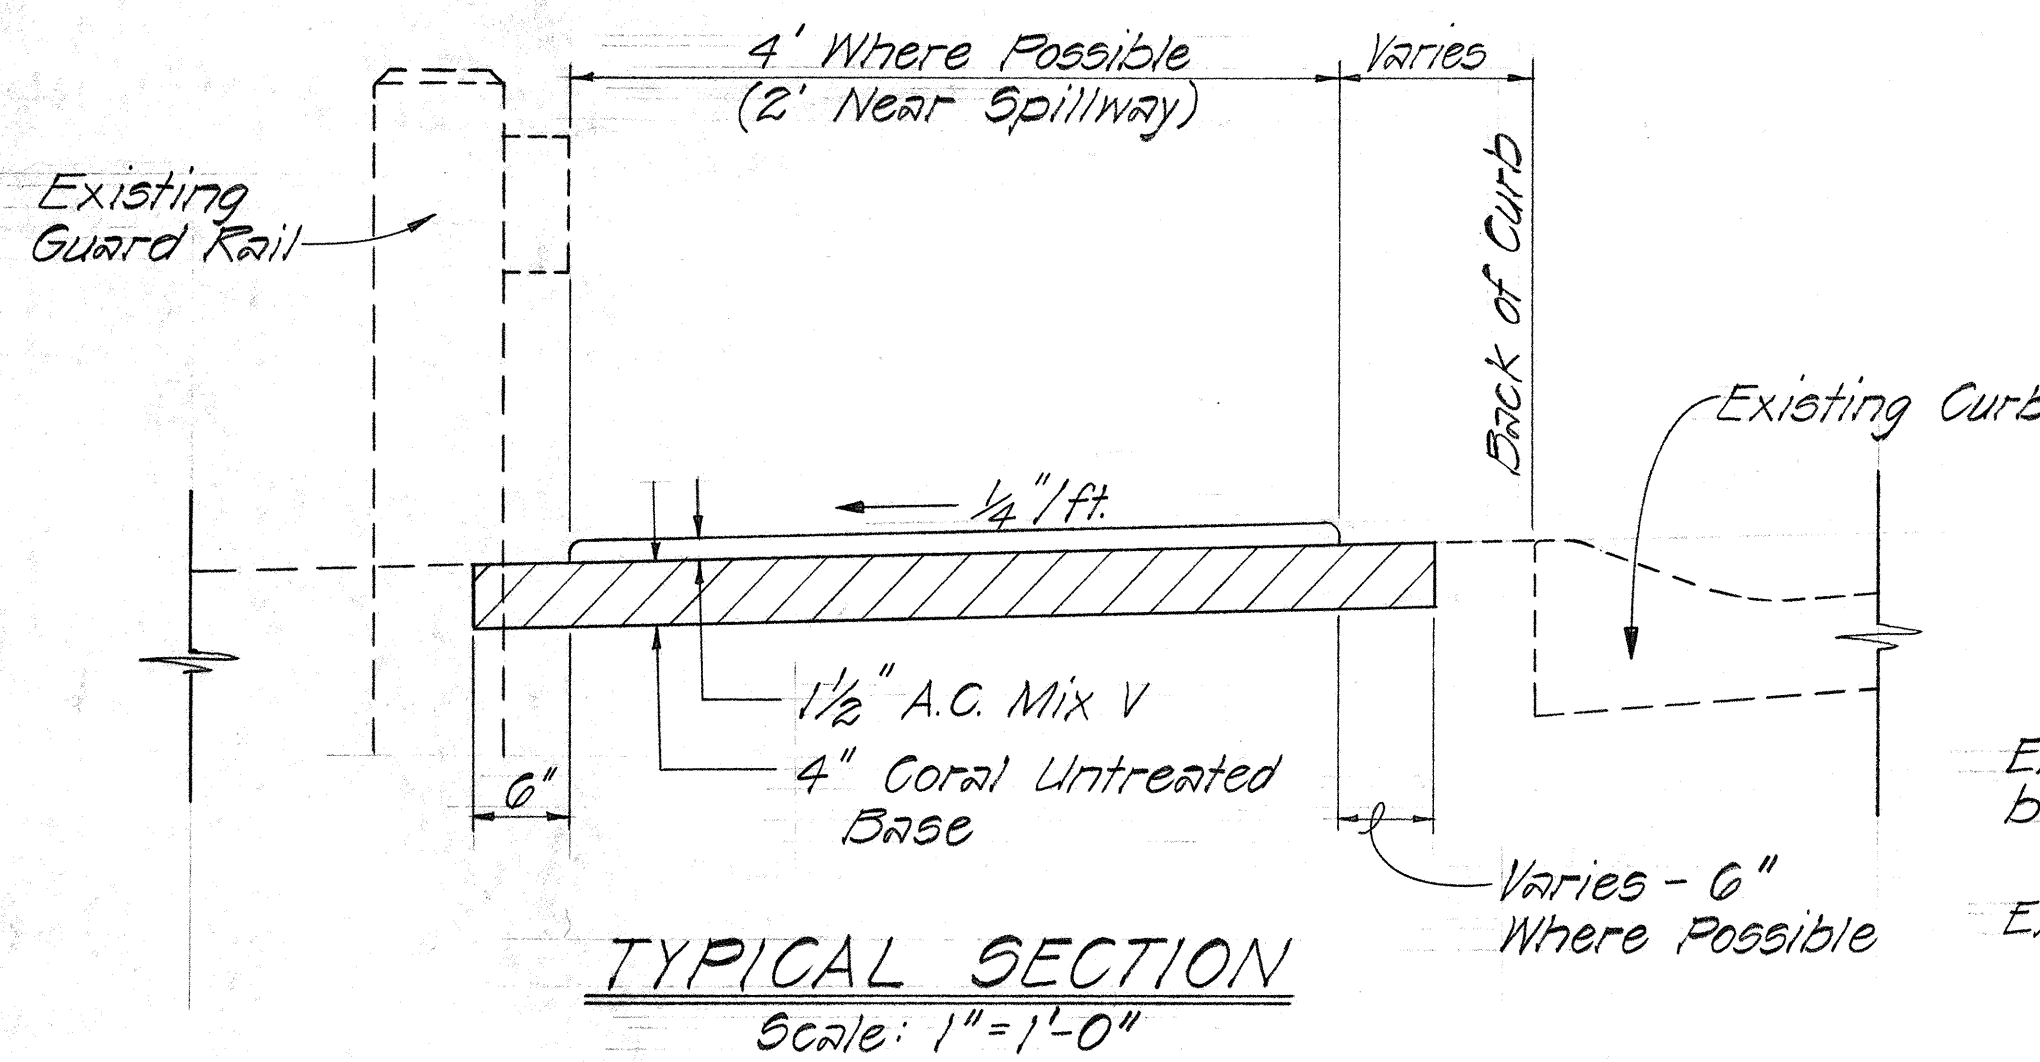

DETAILS OF NEW STEEL FOOTBRIDGE
Scale: 1/2"=1'-0"

- NOTES:**
1. All structural steel to be ASTM A-36.
 2. Channels shall be welded to deckplate.
 3. Channels shall be grouted or partially cast into the anchor block.
 4. Painting for all structural steel & members:
1 Coat: Zinc dust - zinc oxide primer.
1 Coat: Zinc oxide - zinc dust paint.
 5. All concrete to be Class A.

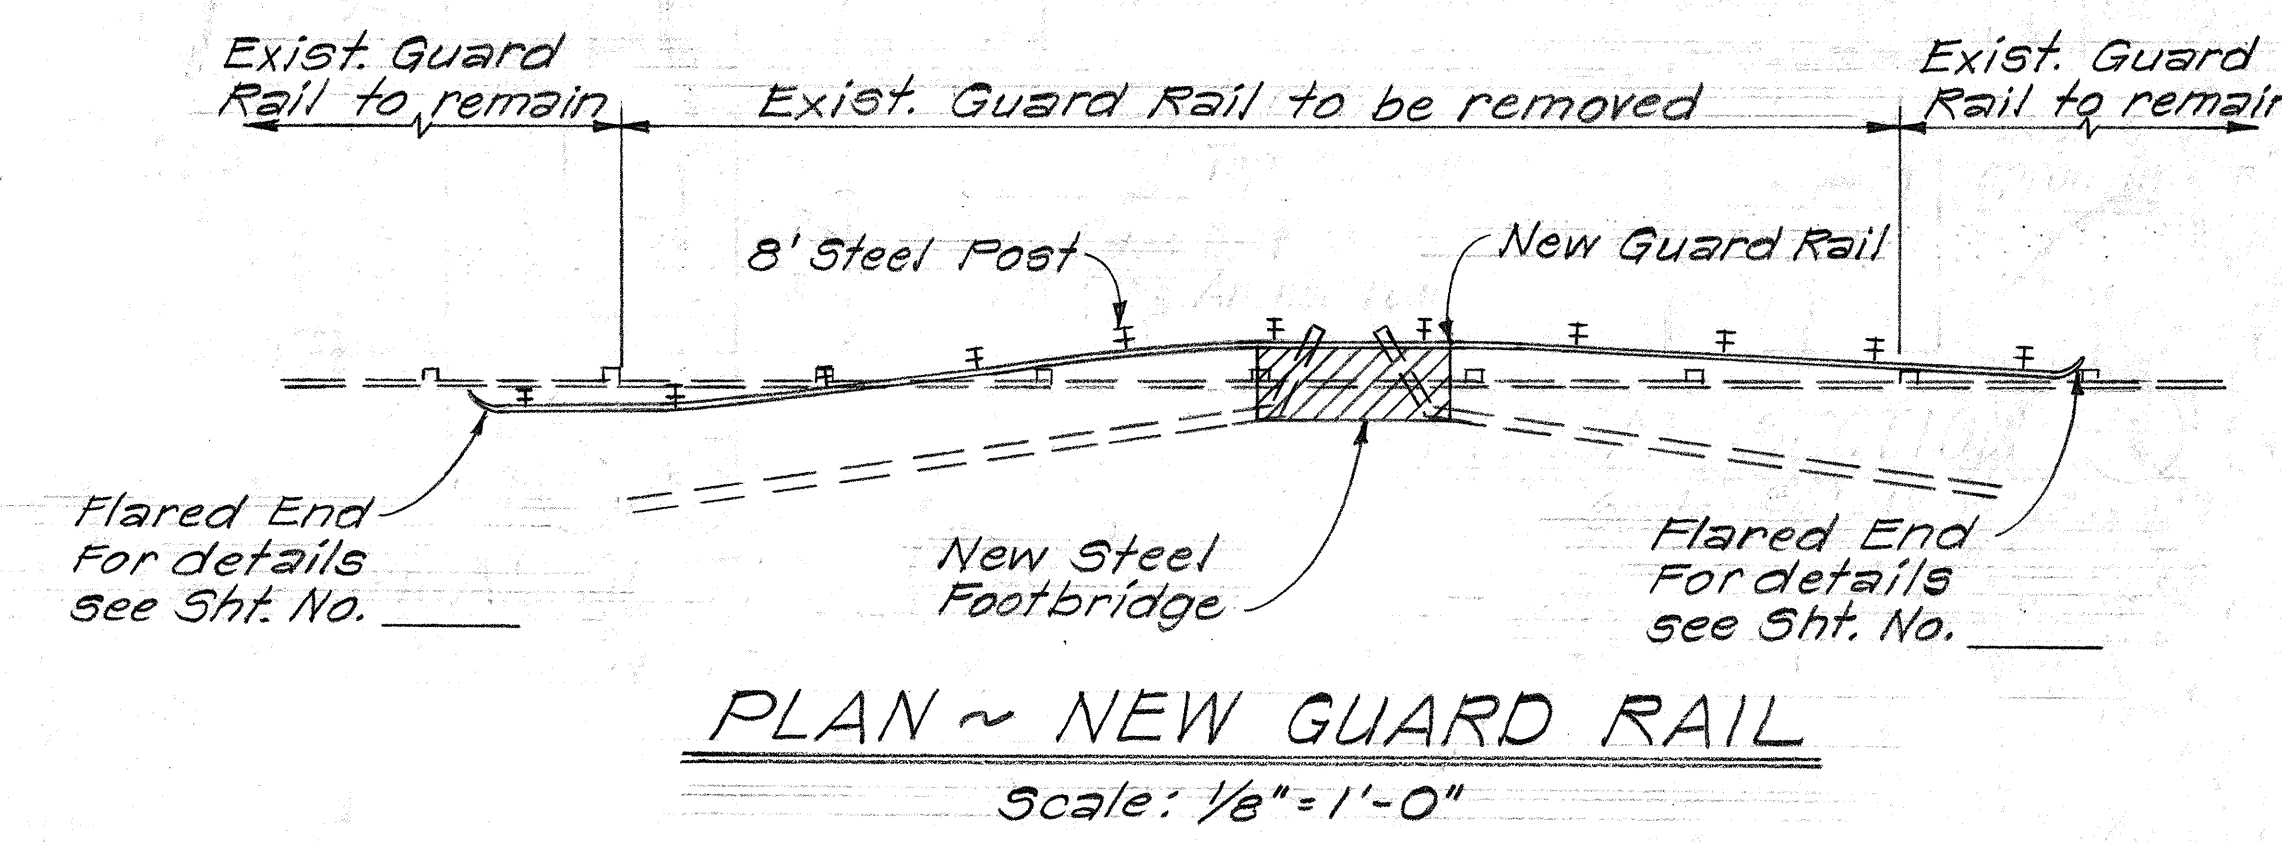

STATE OF HAWAII
DEPARTMENT OF TRANSPORTATION
HIGHWAYS DIVISION

PLAN, TYPICAL SECTION & DETAILS

LIKELIKE HIGHWAY PEDESTRIAN WALKWAY
Anoi Road to Kamehameha Hwy.
Project No. 83H-01-73

Scale: As Shown Date: Nov. 1973

SHEET No. 1 OF 1 SHEETS

DATE	
DESIGNED BY	
CHECKED BY	
ORIGINAL PLAN	
NOTE BOOK	
No.	