
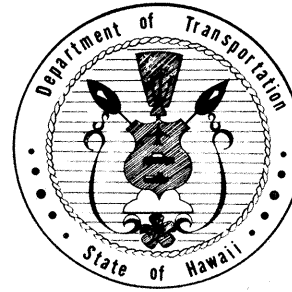


INDEX TO DRAWINGS	
SHEET NO.	DESCRIPTION
1	TITLE SHEET
2	PLAN, TYPICAL SECTION & DETAILS
3 - 4	STANDARD DETAILS

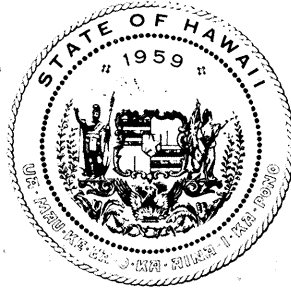

STATE OF HAWAII

DEPARTMENT OF TRANSPORTATION
HIGHWAYS DIVISION

HONOLULU, HAWAII

"AS BUILT"

PLANS FOR

CONSTRUCTION OF



LIKELIKE HIGHWAY PEDESTRIAN WALKWAY

ANOI ROAD TO KAMEHAMEHA HIGHWAY


PROJECT NO. 83H-01-73

DISTRICT OF KOOLAUPOKO
ISLAND OF OAHU

FED. ROAD DIST. NO.	STATE	PROJ. NO.	FISCAL YEAR	SHEET NO.	TOTAL SHEETS
HAWAII	HAW.	83H-01-73	1973	1	4

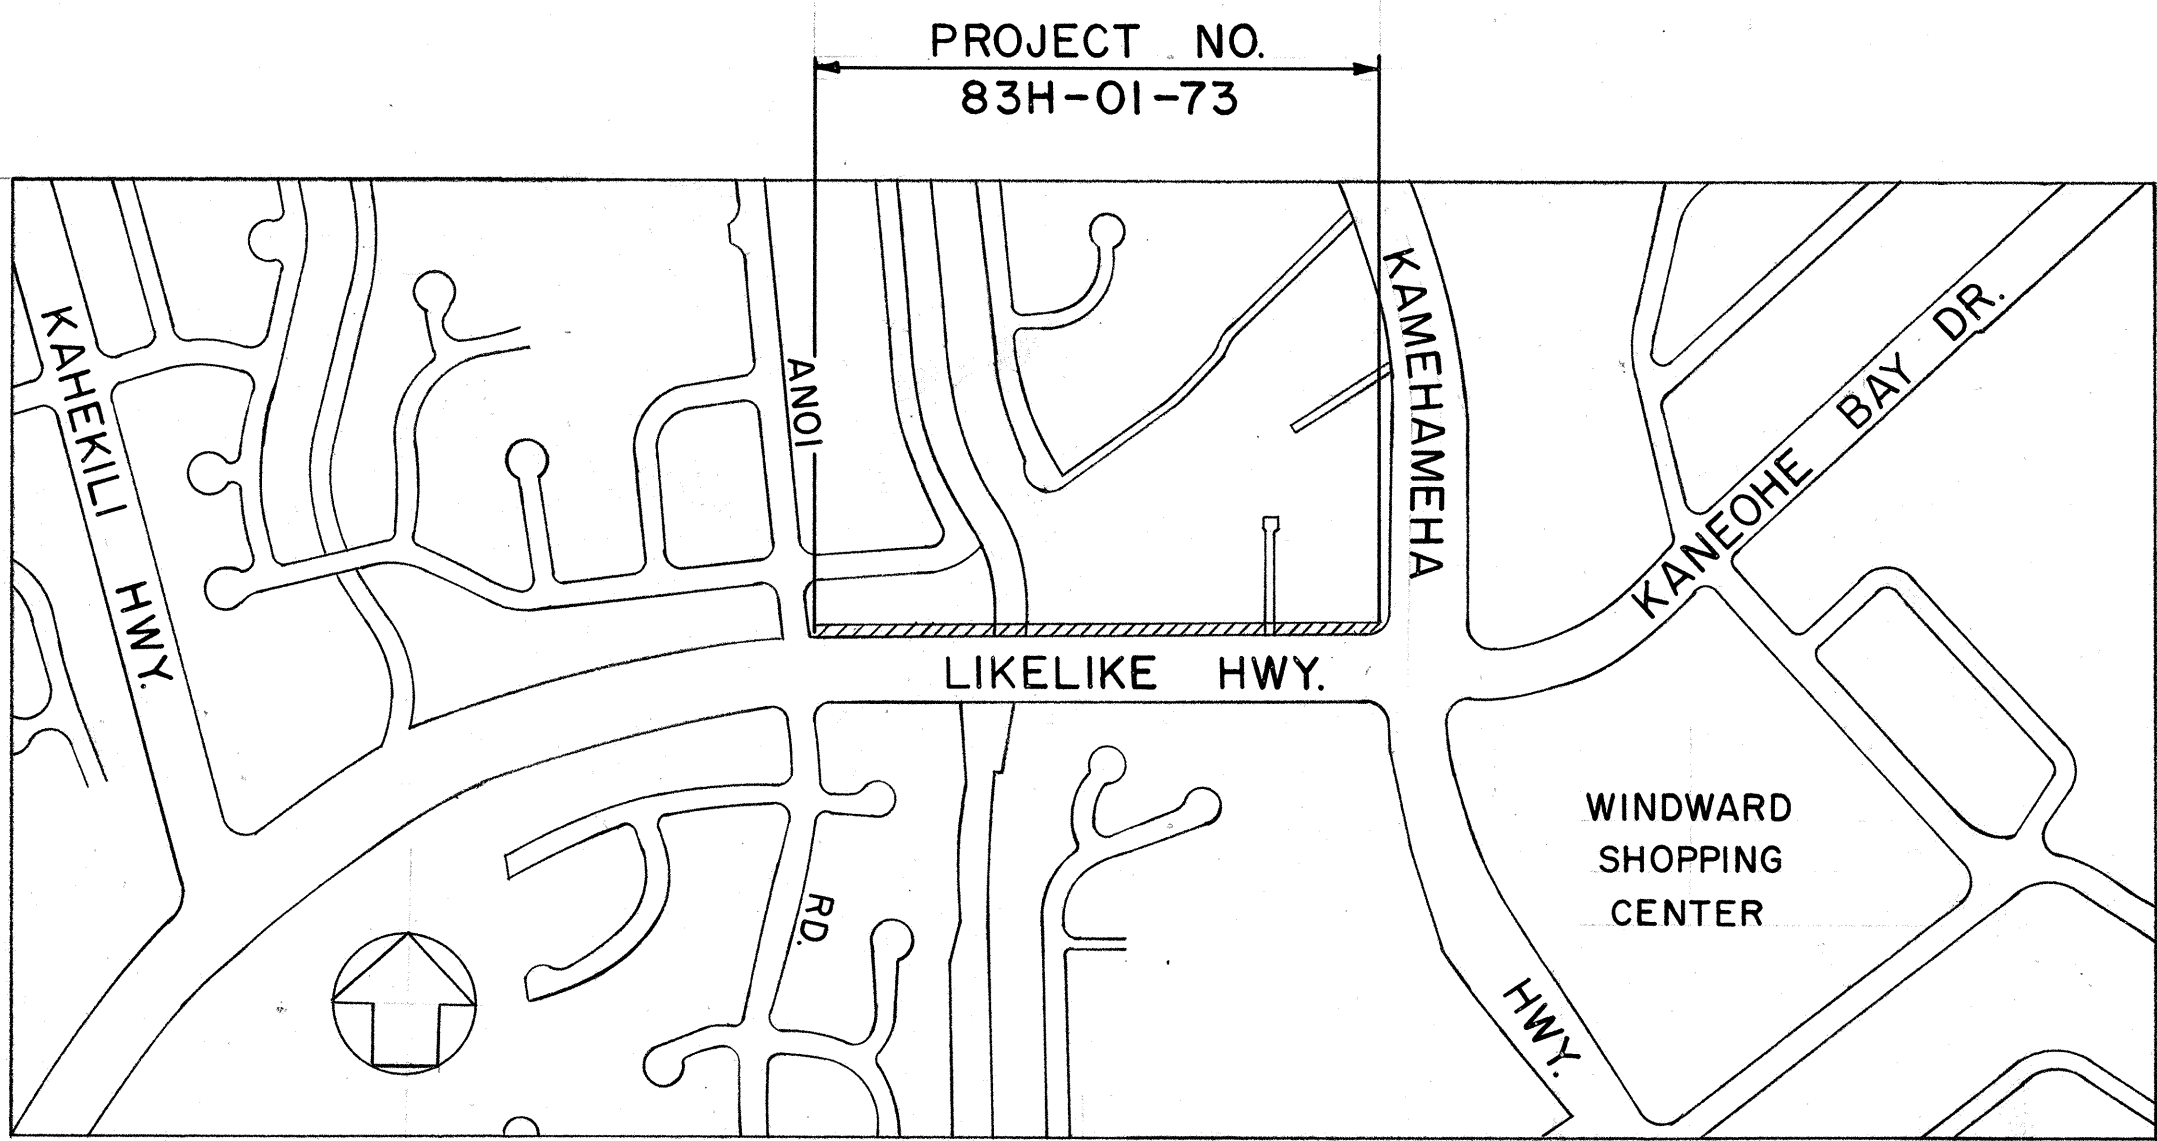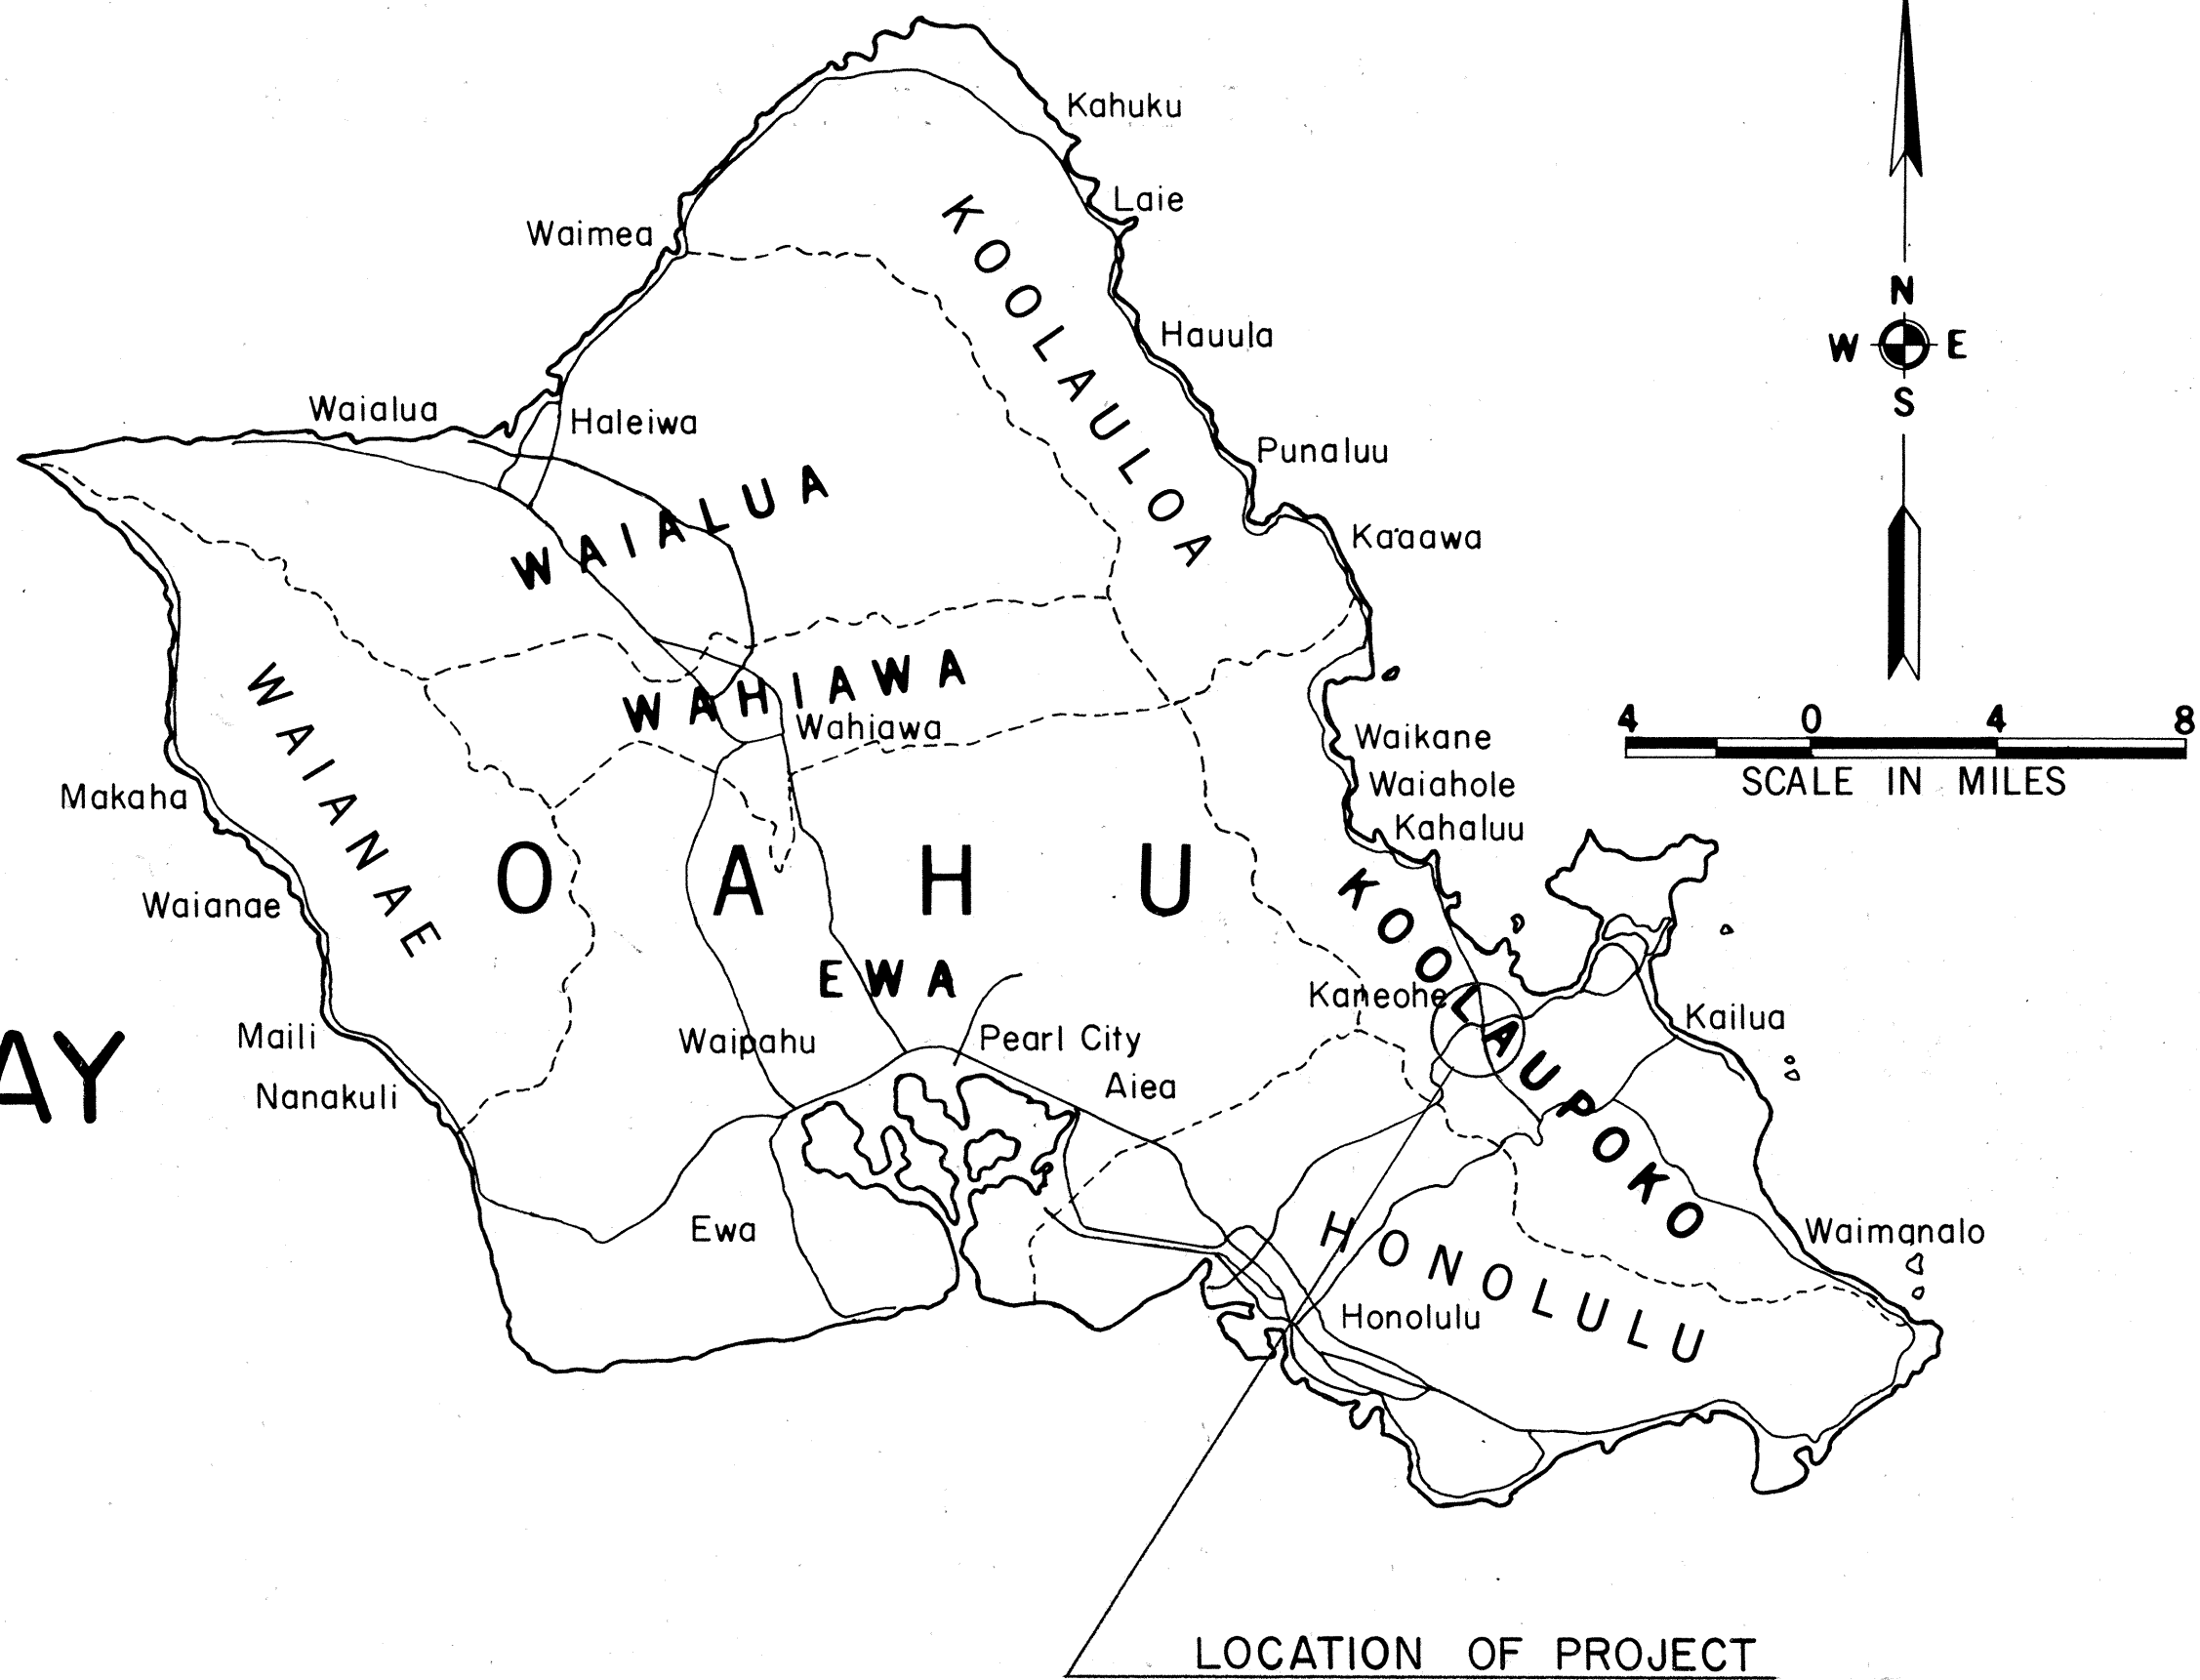

LAYOUT PLAN

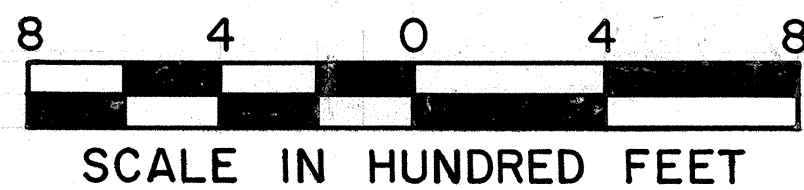

NOTE:
ALL CHANGES MADE DURING CONSTRUCTION HAVE BEEN NOTED IN RED ON THESE TRACINGS AND CHECKED BY:

Mike Uyean 9/1/76
PROJECT ENGINEER DATE

DEPARTMENT OF TRANSPORTATION STATE OF HAWAII	
APPROVED:	
<i>Munny Lee</i>	4/19/74
FOR DIR. OF TRANSPORTATION	DATE

DESIGNED BY *R. TSUZUKI* P. S. & E. BY *R. TSUZUKI* 548-2450 OCT 1973 DATE
PHONE