




FED. ROAD DIST. NO.	STATE	PROJ. NO.	FISCAL YEAR	SHEET NO.	TOTAL SHEETS
HAWAII	HAW.	83E-01-74 83E-01-73	1974	2	18

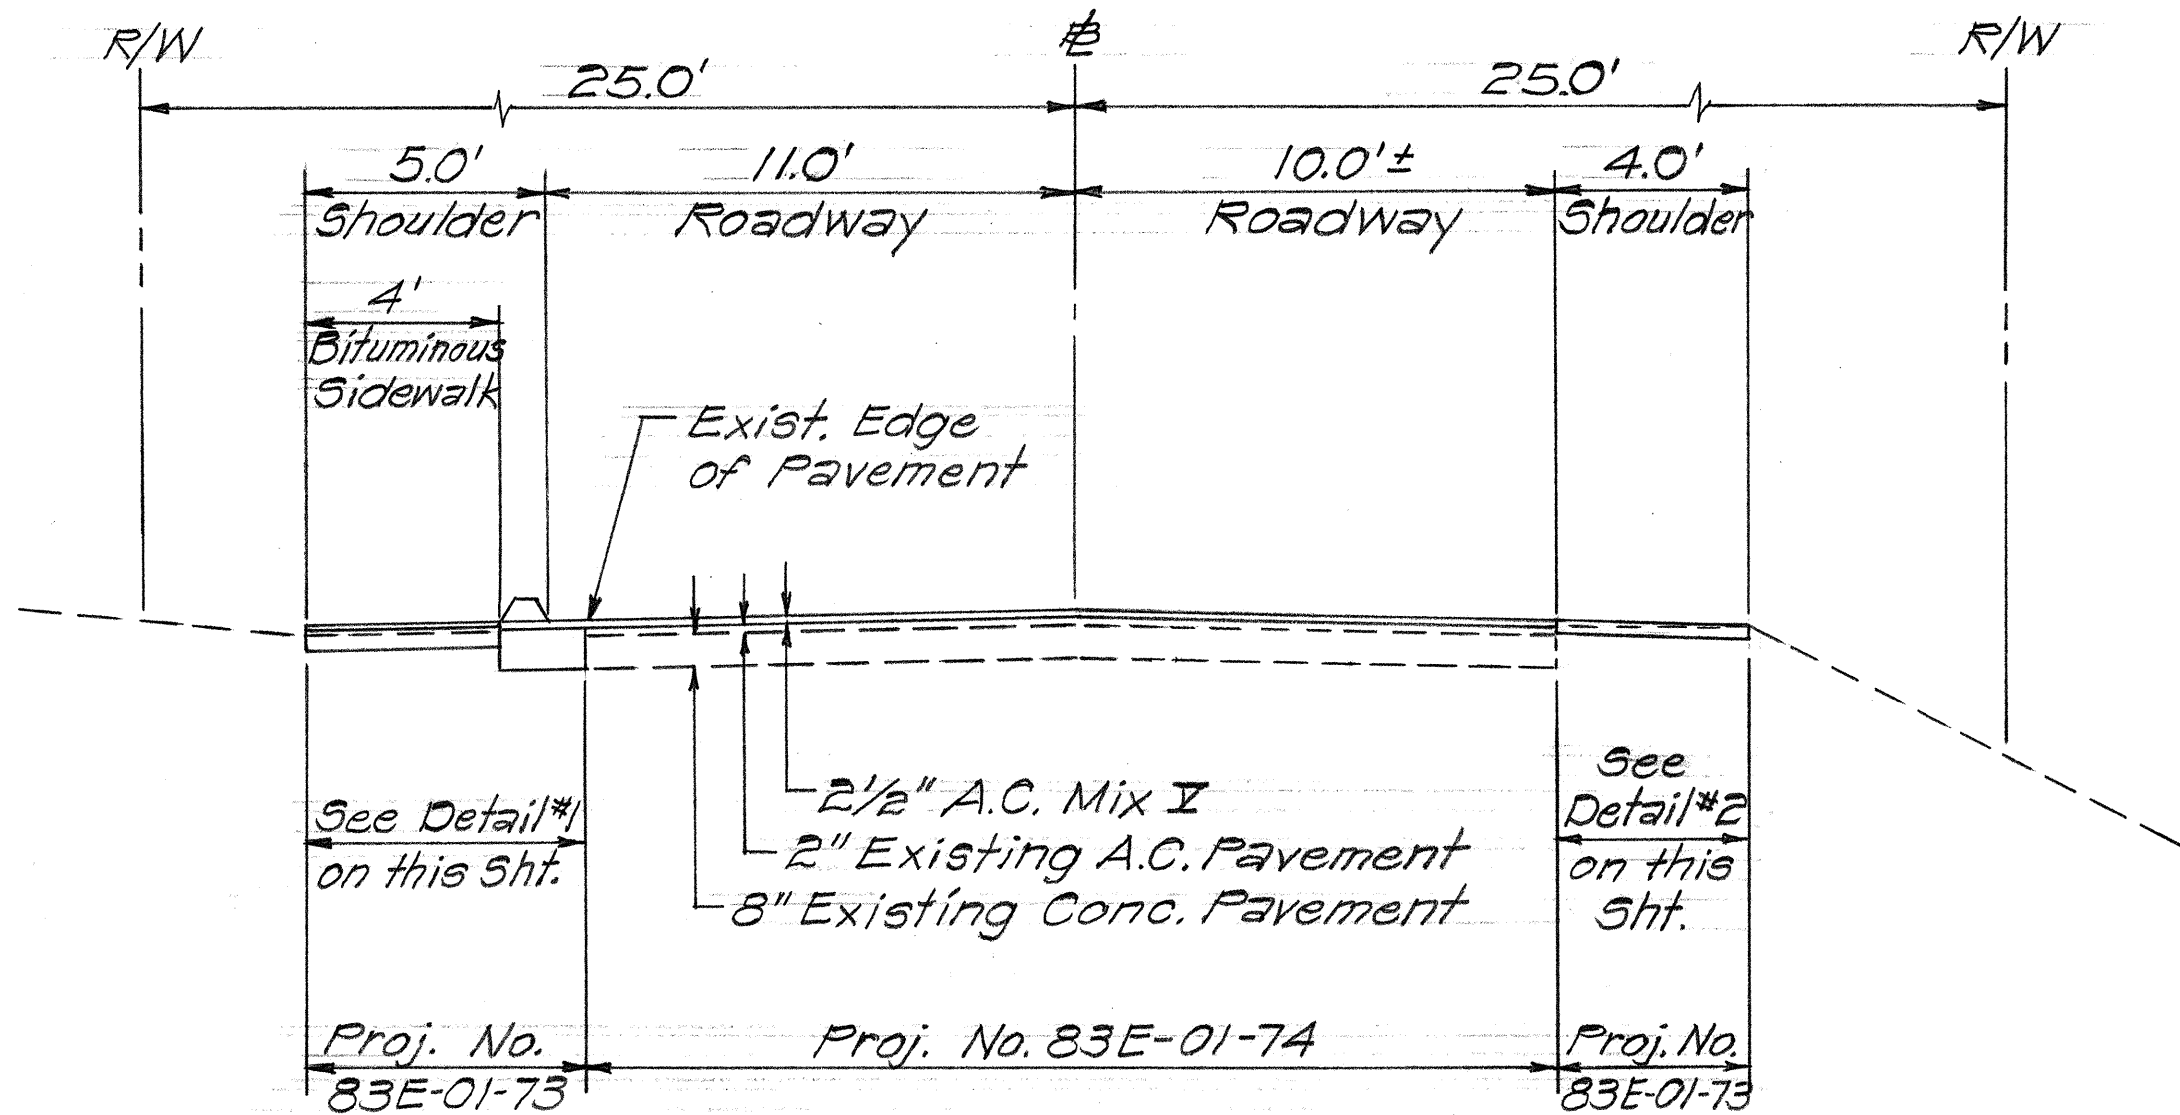


TYPICAL SECTION
 ± STA. 421+33 to ± STA. 455+80
 Scale: 1/4"=1'-0"

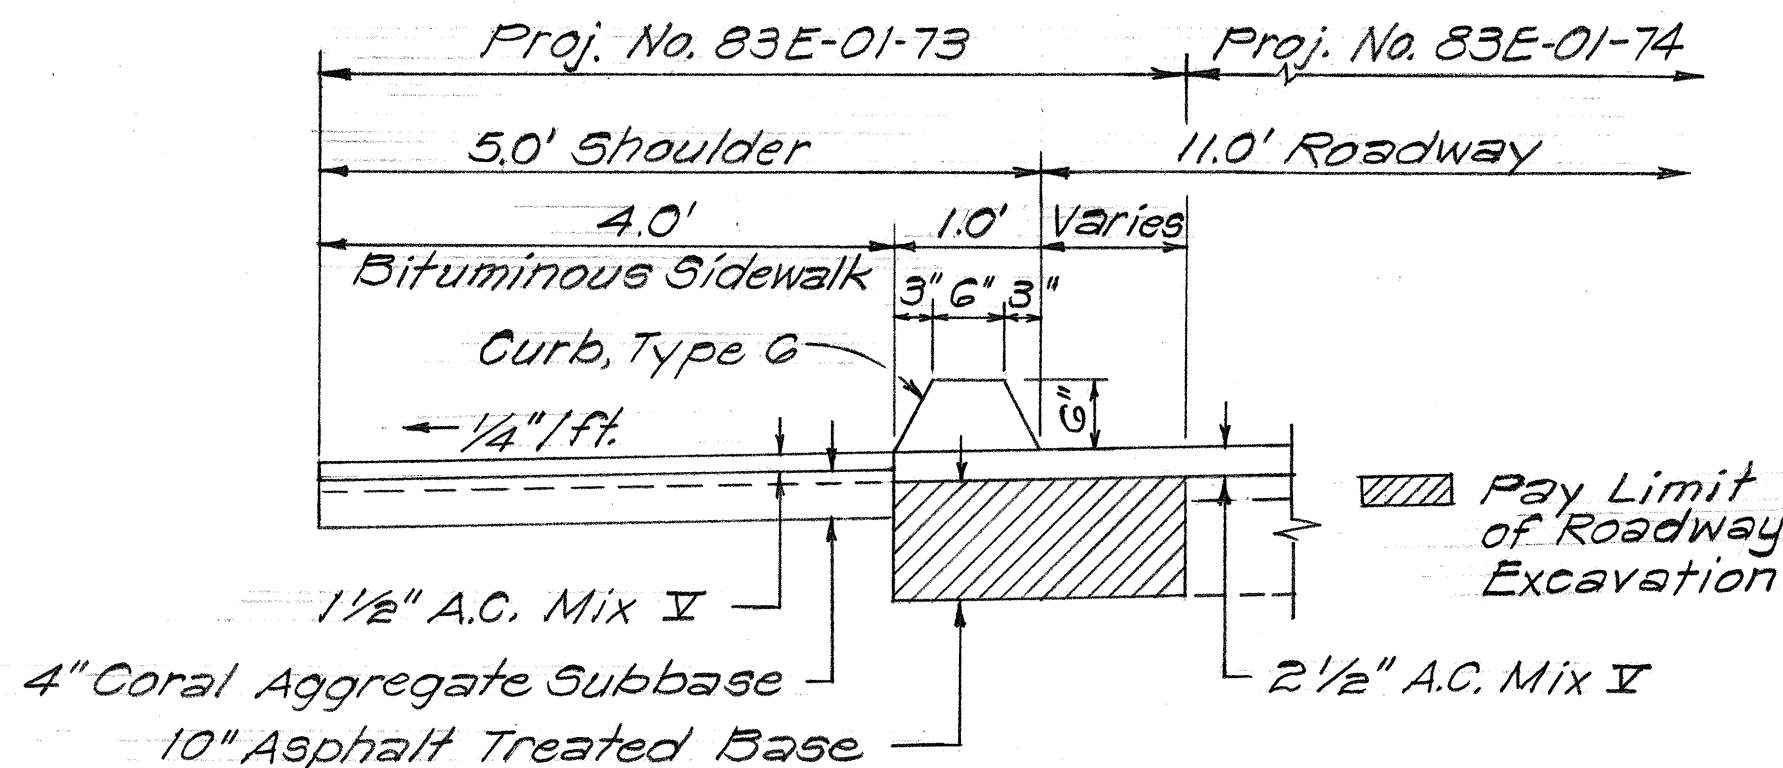


DETAIL #1 FOR PROJ. NO. 83E-01-73 (LEFT)
 ± STA. 421+33 to ± STA. 455+80
 Scale: 3/4"=1'-0"

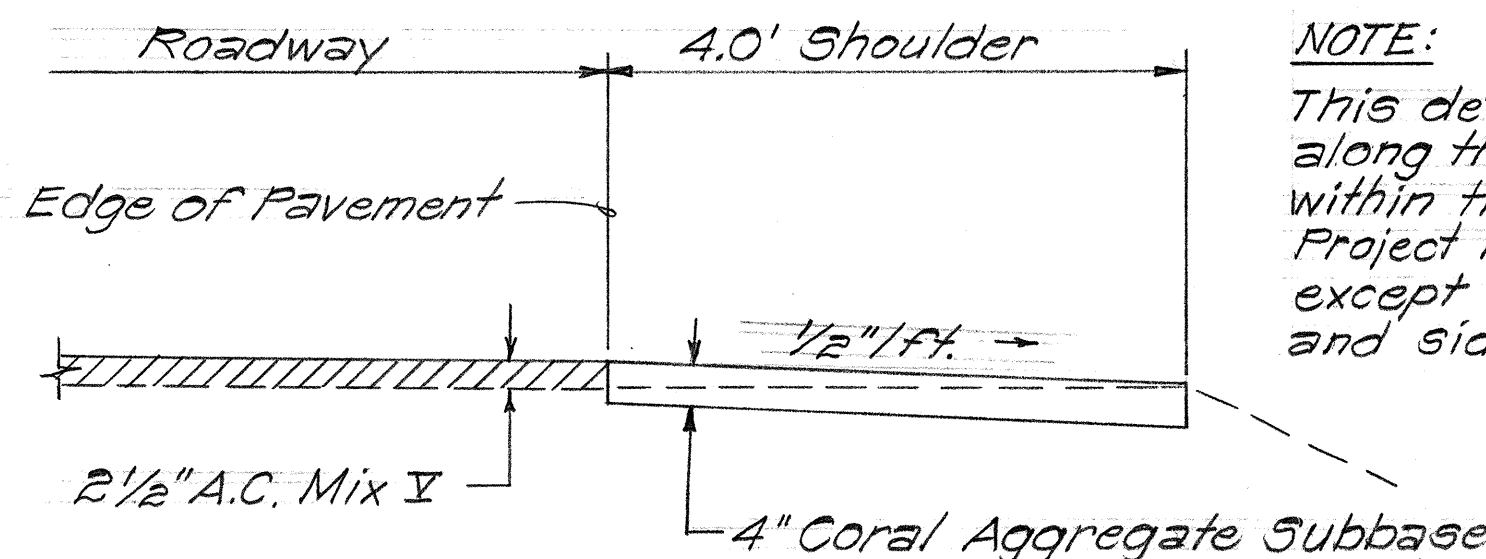


DETAIL #2 FOR PROJ. NO. 83E-01-73 (RIGHT)
 ± STA. 421+33 to ± STA. 455+80
 Scale: 3/4"=1'-0"

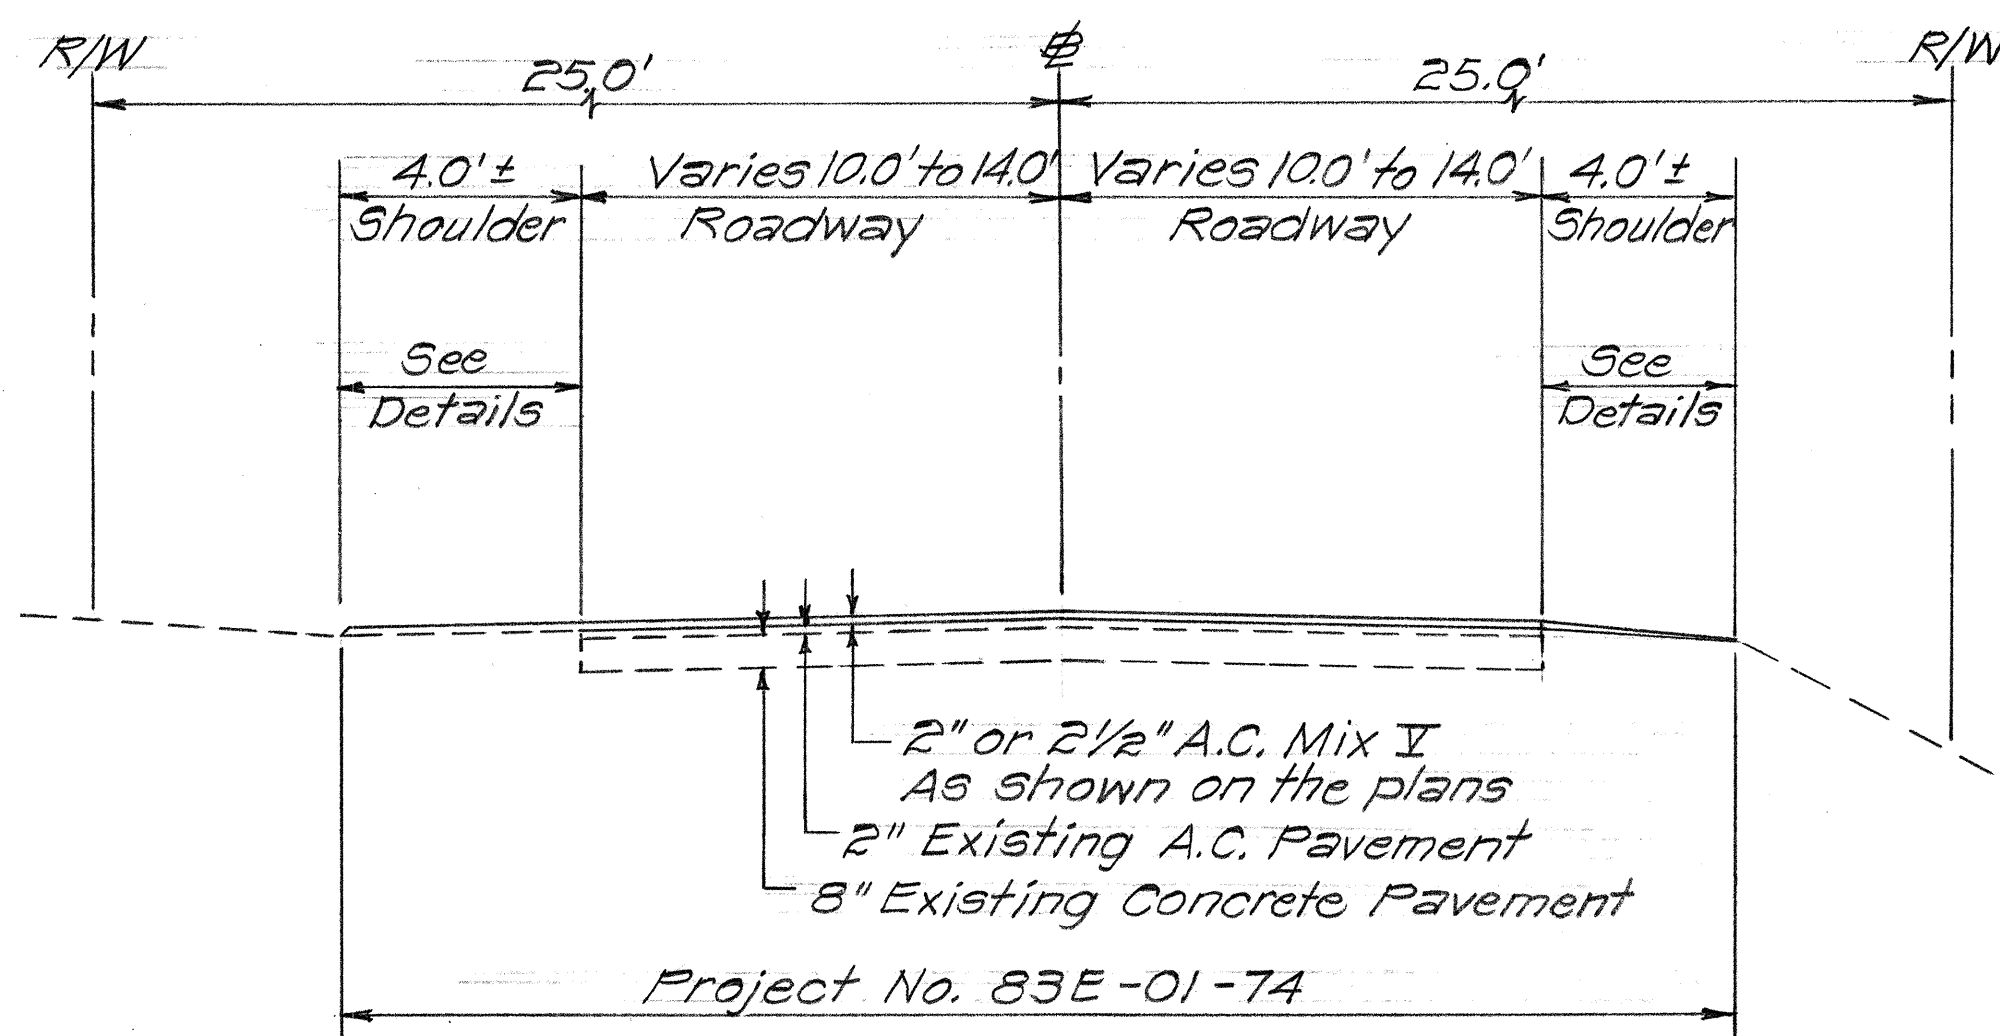


TYPICAL SECTION
 ± STA. 419+03 to ± STA. 420+15
 ± STA. 455+80 to ± STA. 419+25
 Scale: 1/4"=1'-0"

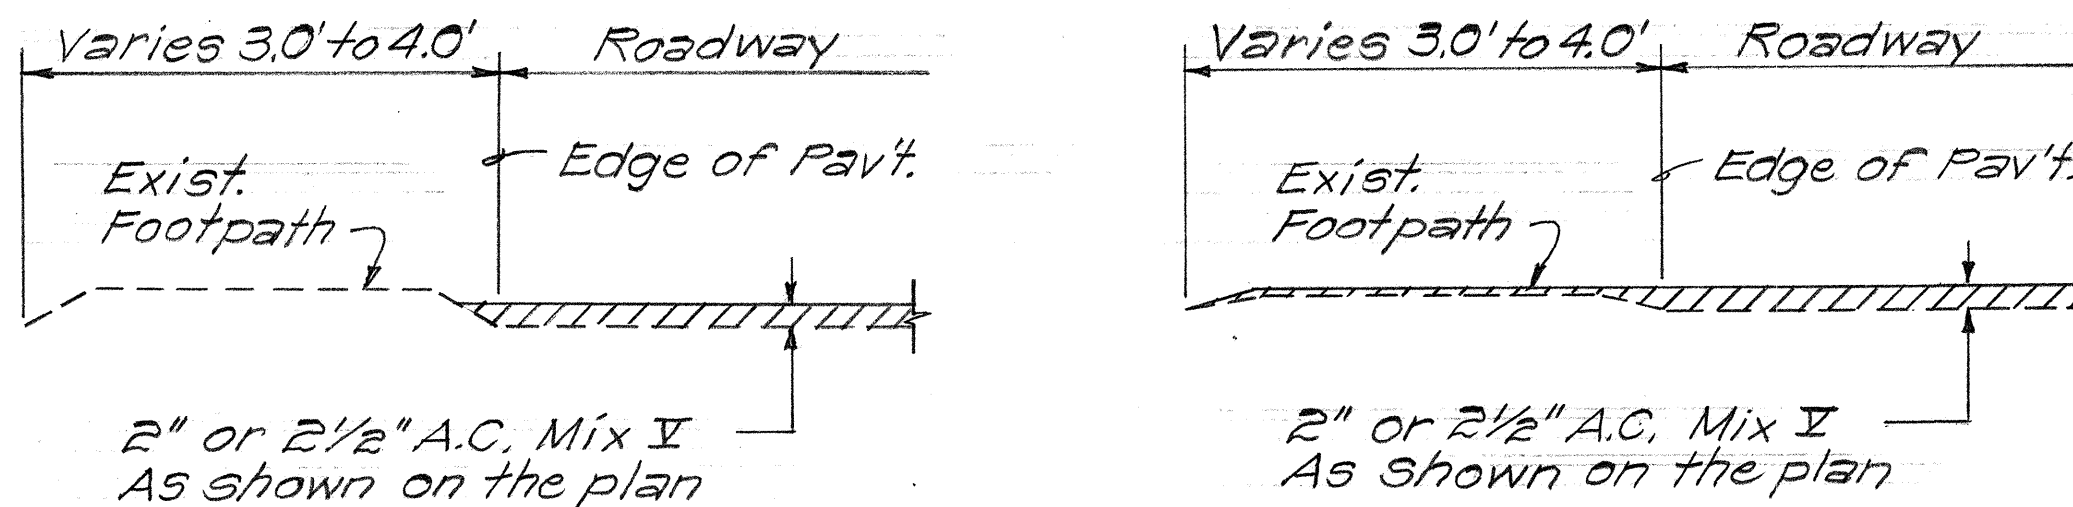


DETAIL WHERE FOOTPATH IS HIGHER OR LOWER THAN RESURFACING THICKNESS
 ± STA. 455+80 to ± STA. 519+25
 Scale: 3/4"=1'-0"

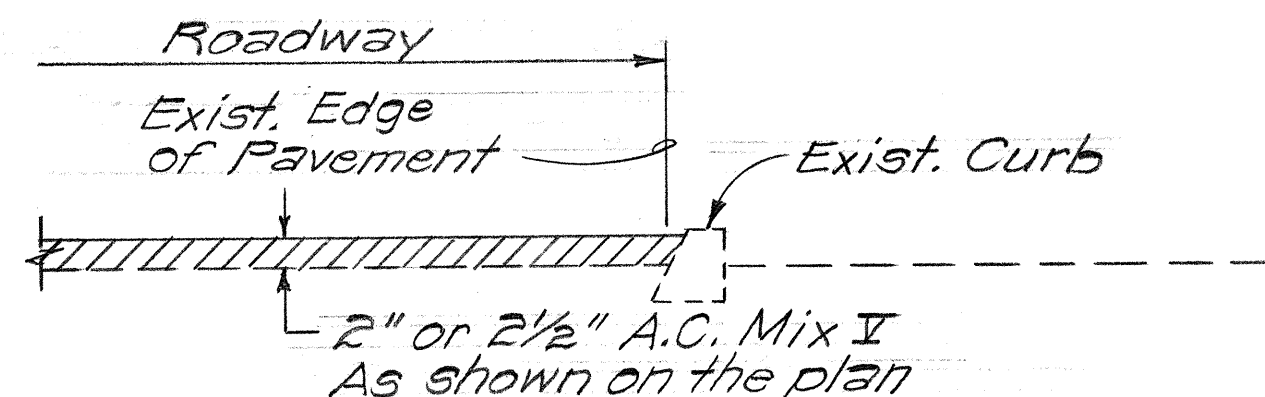

DETAIL WHERE CURB EXISTS
 ± STA. 455+80 to ± STA. 519+25
 Scale: 3/4"=1'-0"

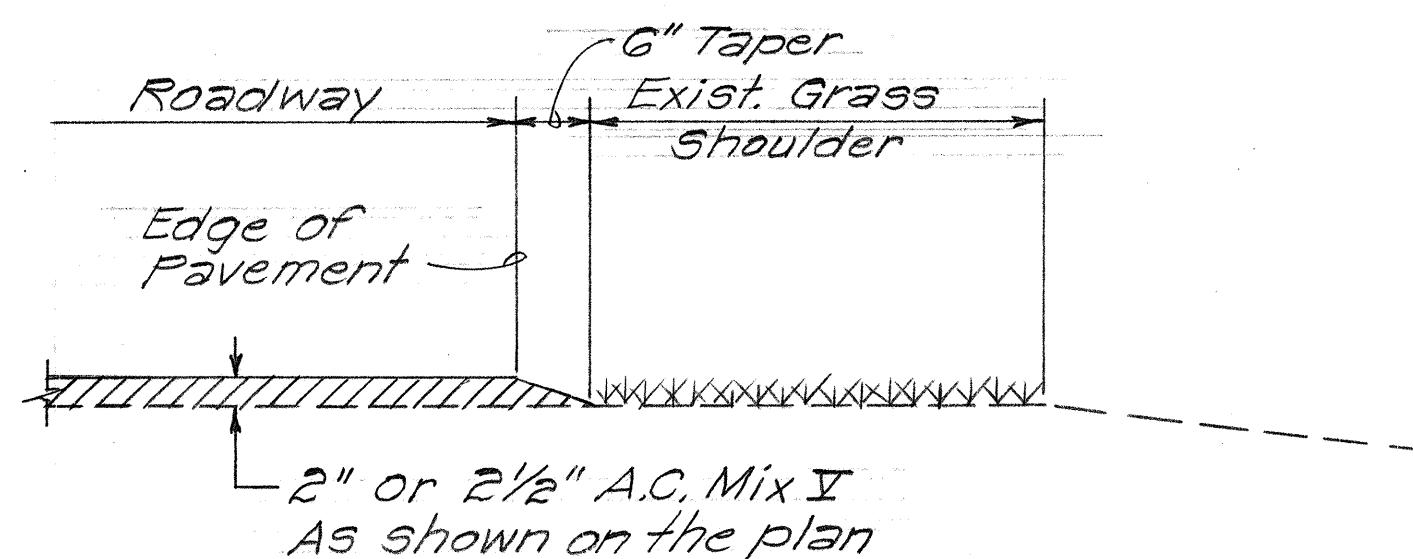

DETAIL WHERE GRASS SHOULDER EXISTS
 ± STA. 455+80 to ± STA. 519+25
 Scale: 3/4"=1'-0"

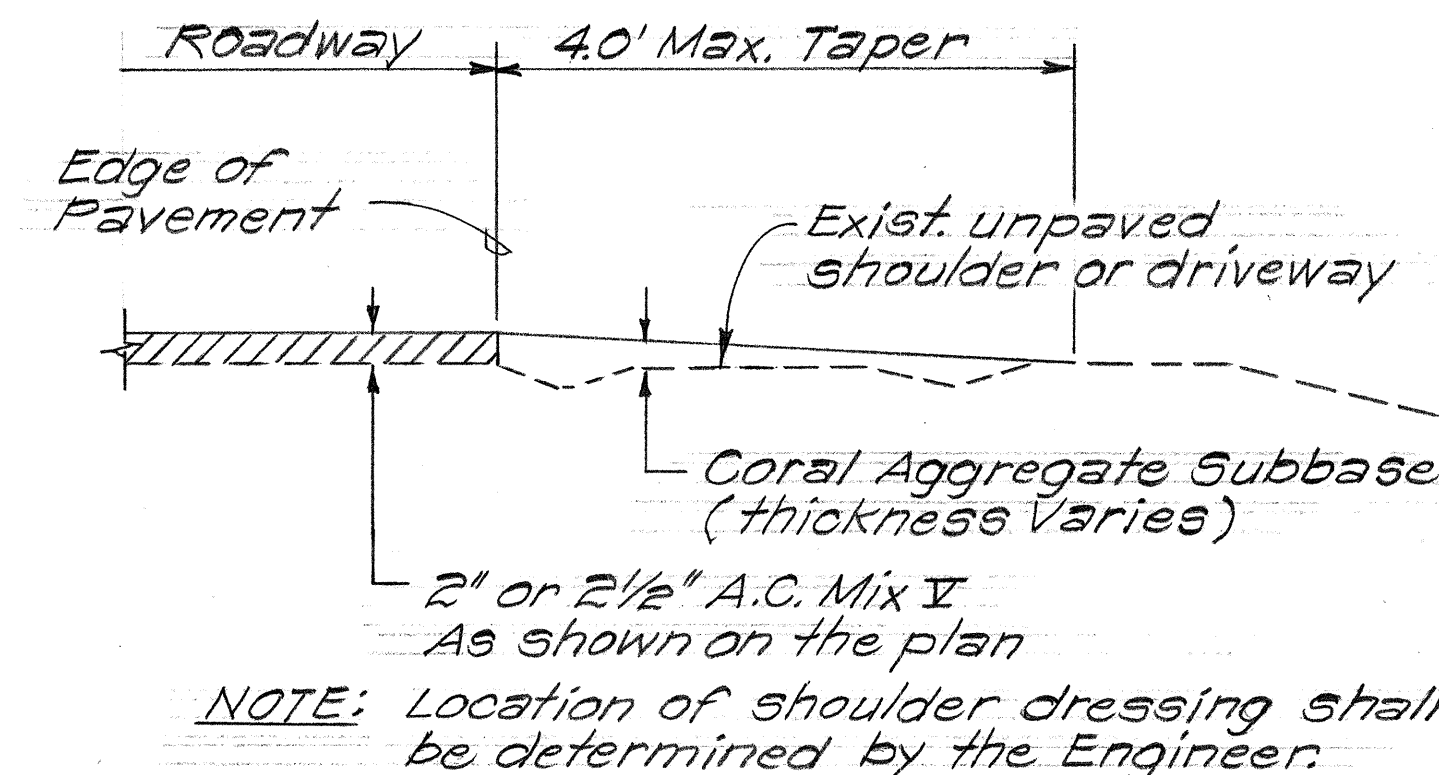

DETAIL OF SHOULDER DRESSING
 ± STA. 419+03 to ± STA. 519+25
 Scale: 3/4"=1'-0"

GENERAL NOTES

1. The Contractor's attention is directed to Section 107.21 - Contractor's responsibility for Utility Property and Services and Section 401.03(k) - Resurfacing over Manholes of the Special Provisions.
2. When the operations of the Contractor results in any damages to any structure, he shall assume full responsibility for such damages and shall repair the damage at his expense.
3. The Contractor's attention is directed to Section 107.13 - Public Convenience and Safety of the Special Provisions.
4. No Bituminous Sidewalk and Type G Curb shall be constructed where driveways exist.


DATE	*****
SURVEY PLOTTED BY	
DRAWN BY	
DESIGNED BY	
CHECKED BY	
ORIGINAL PLAN	
NOTE BOOK	
No.	

STATE OF HAWAII
DEPARTMENT OF TRANSPORTATION
HIGHWAYS DIVISION

TYPICAL SECTIONS & GEN. NOTES
FOR
KAMEHAMEHA HIGHWAY RESURFACING
Proj. No. 83E-01-74
KAMEHAMEHA HIGHWAY WIDENING
Proj. No. 83E-01-73
Scale: As Shown Date: May, 1974


SHEET No. 1 OF 2 SHEETS

FED. ROAD DIST. NO.	STATE	PROJ. NO.	FISCAL YEAR	SHEET NO.	TOTAL SHEETS
HAWAII	HAW.	83E-01-74	1974	3	18

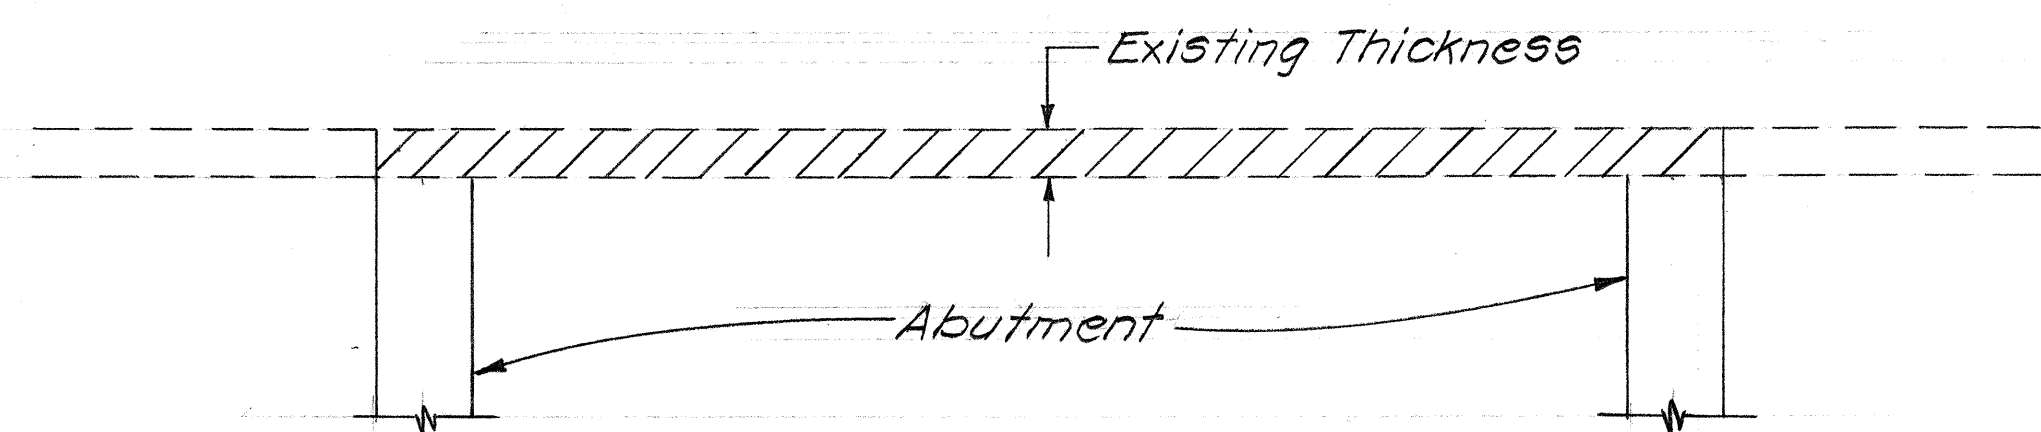


NOTE: The existing A.C. Pavement shall be removed, disposed of, and replaced with A.C. Mix No. I. The removal and disposal of the existing A.C. Pavement shall be considered incidental to the various contract items.


PAVING DETAIL #3 FOR KAHALUU, KAALAEA, & WAIHAOLE STR. BRIDGES
Not to Scale

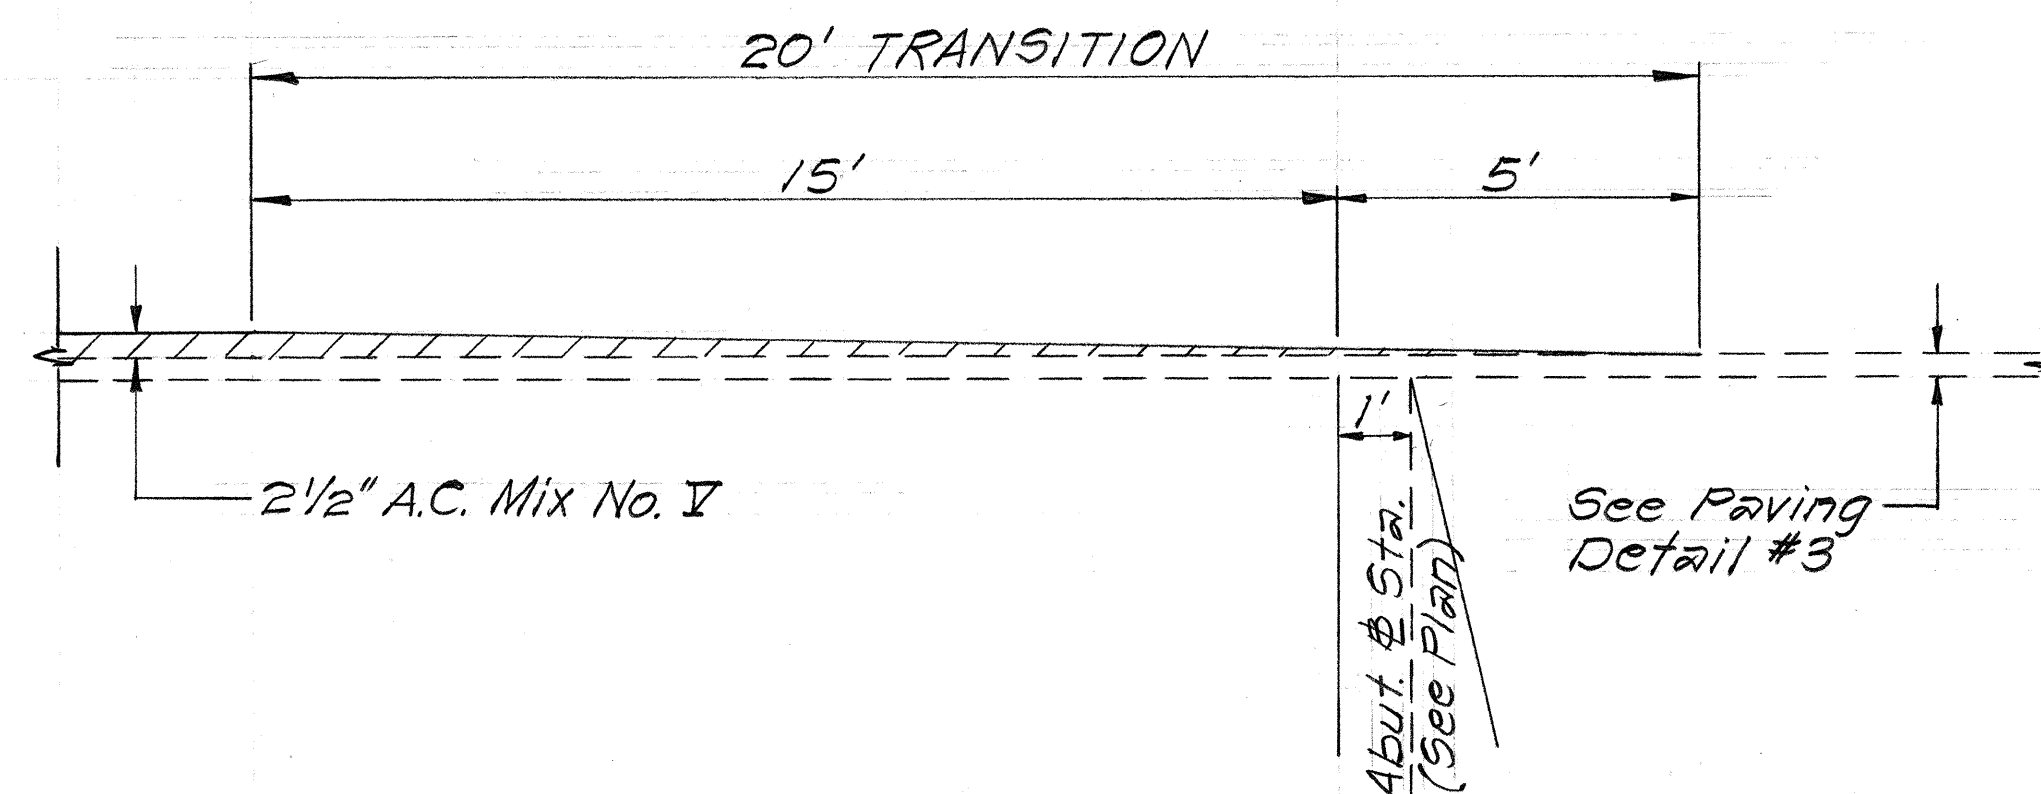


TRANSITION DETAIL FOR KAHALUU STREAM BRIDGE
Not to Scale

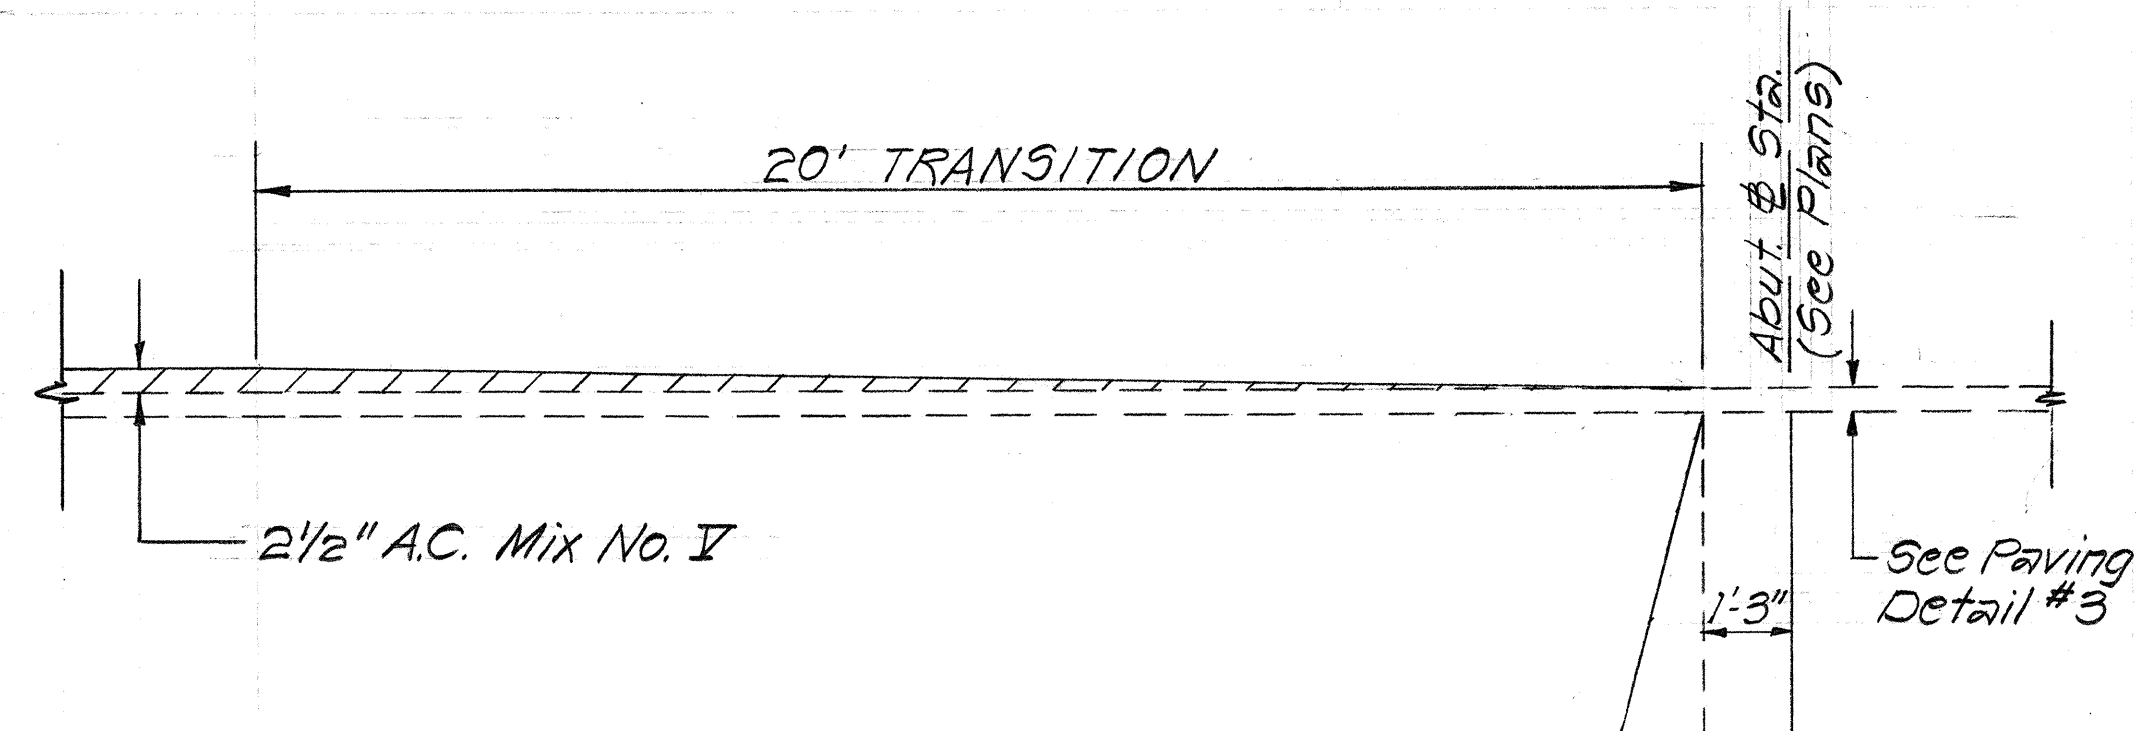






TRANSITION DETAIL FOR KAALAEA STREAM BRIDGE
Not to Scale

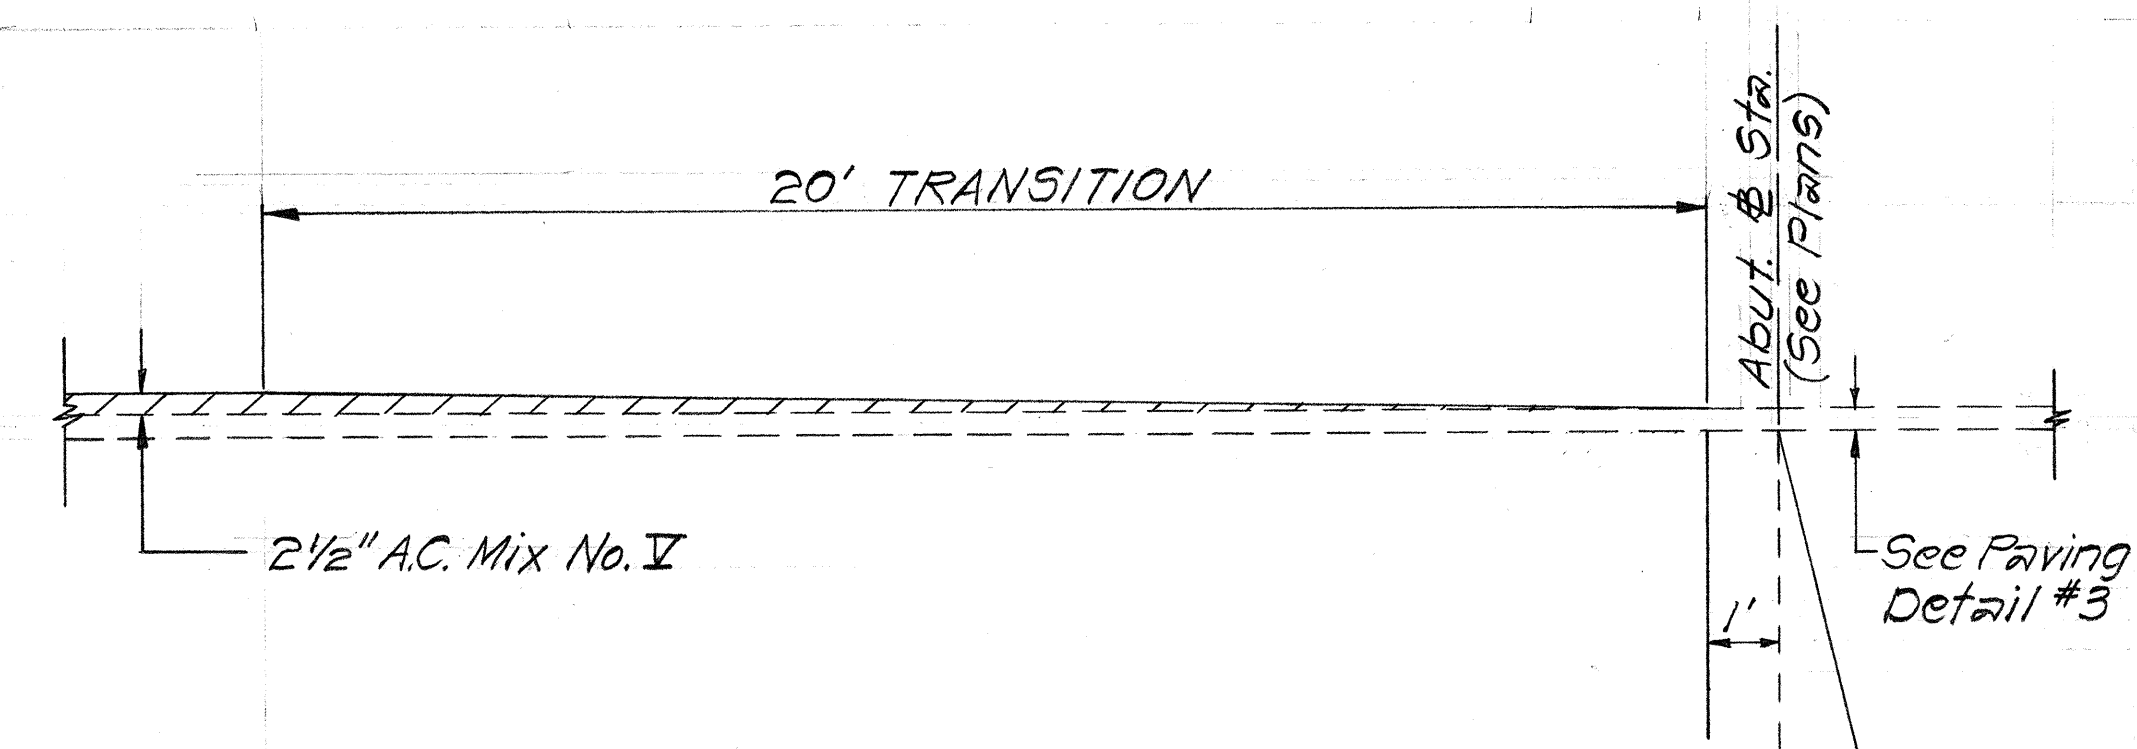


TRANSITION DETAIL FOR WAIHAOLE STREAM BRIDGE
Not to Scale

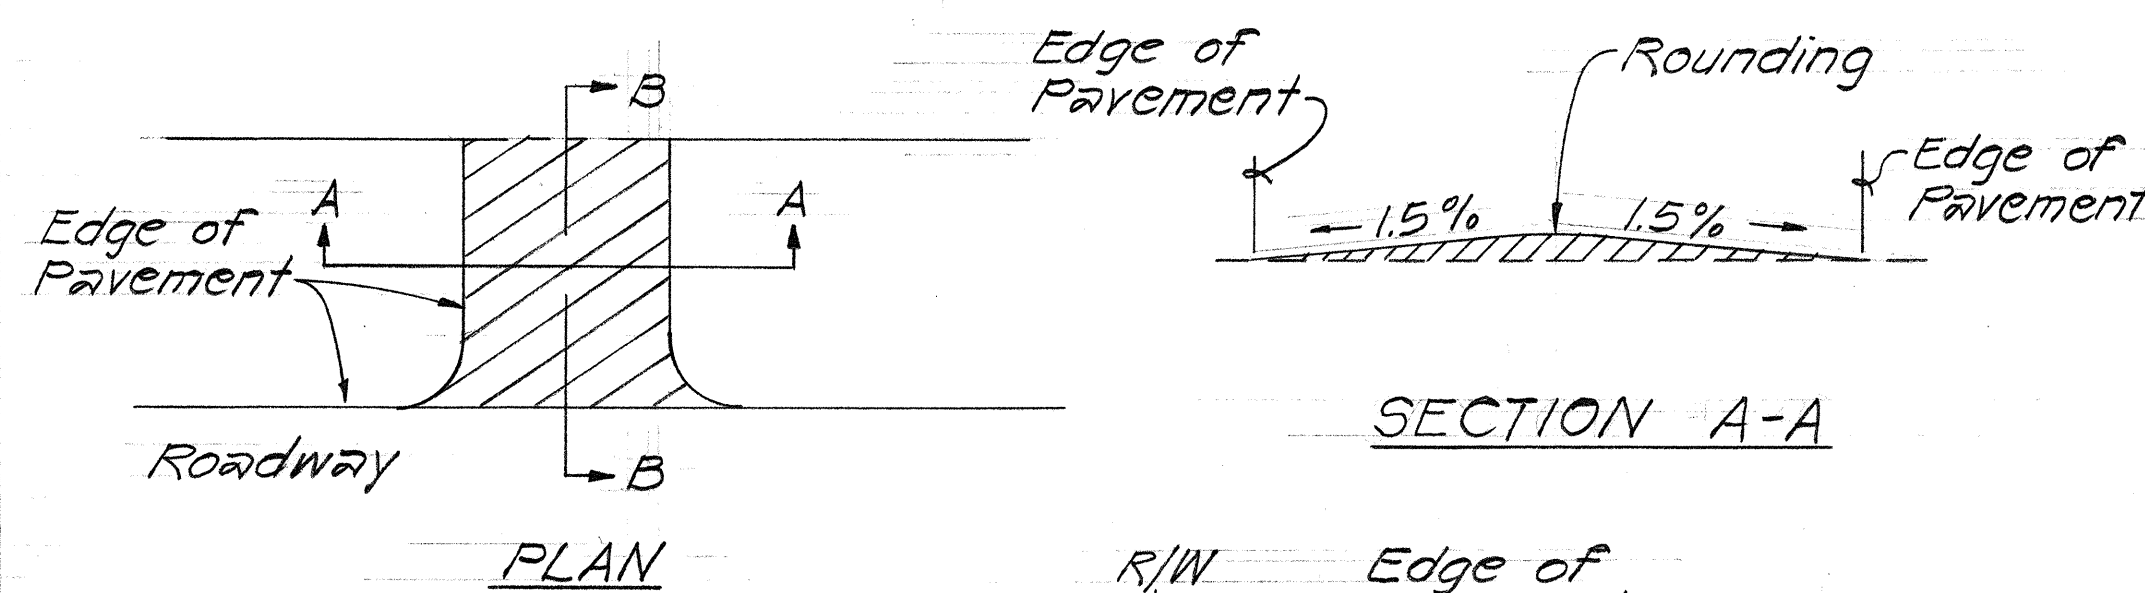

DETAIL WHERE PAVED SIDE ROADS EXIST
Not to Scale

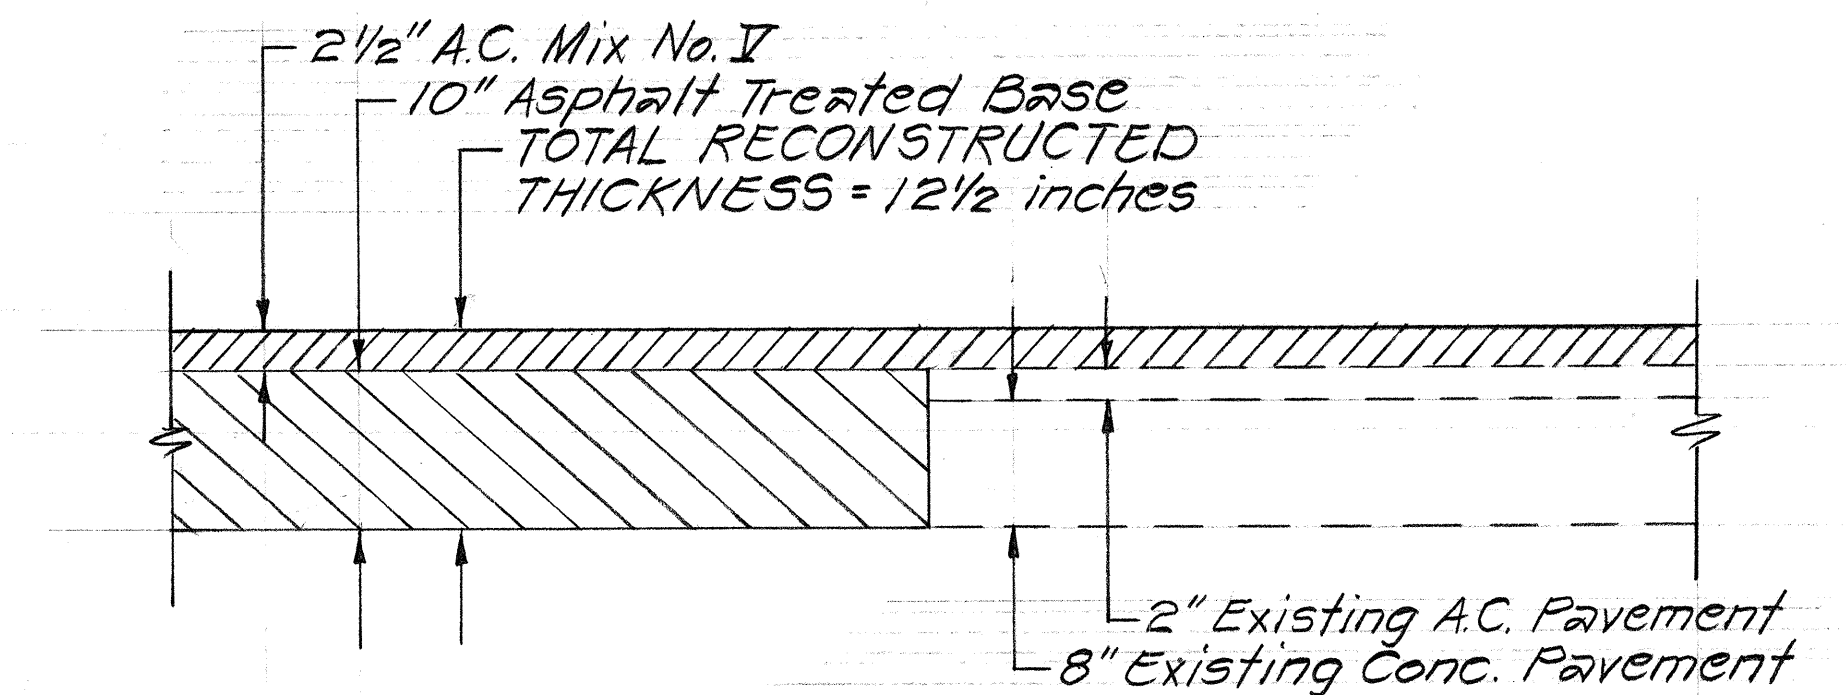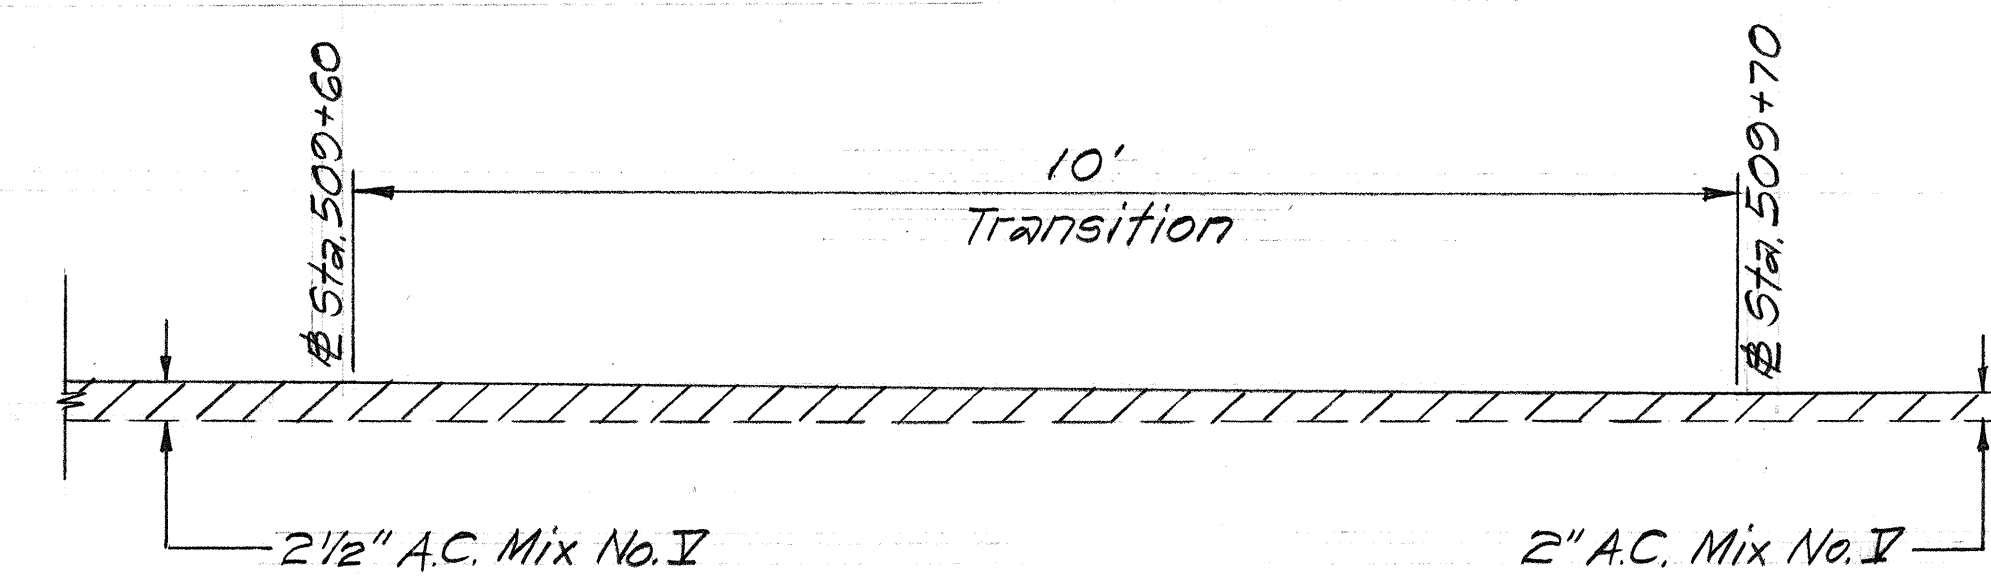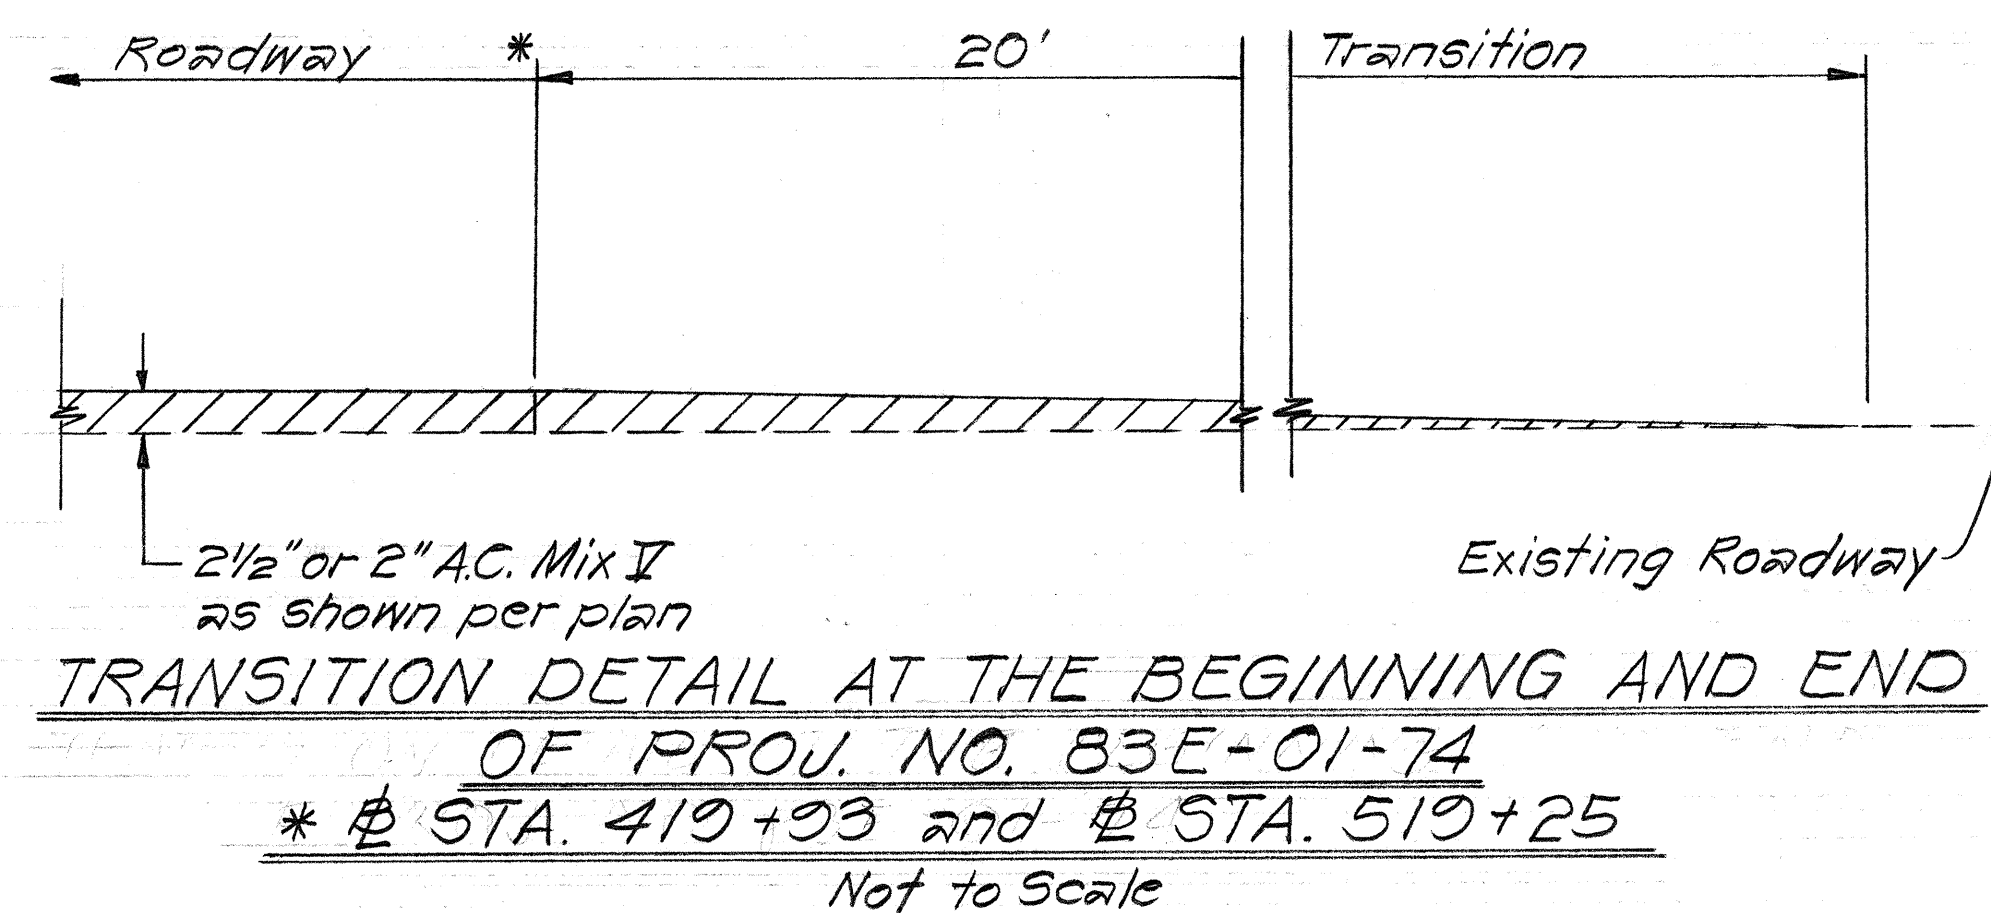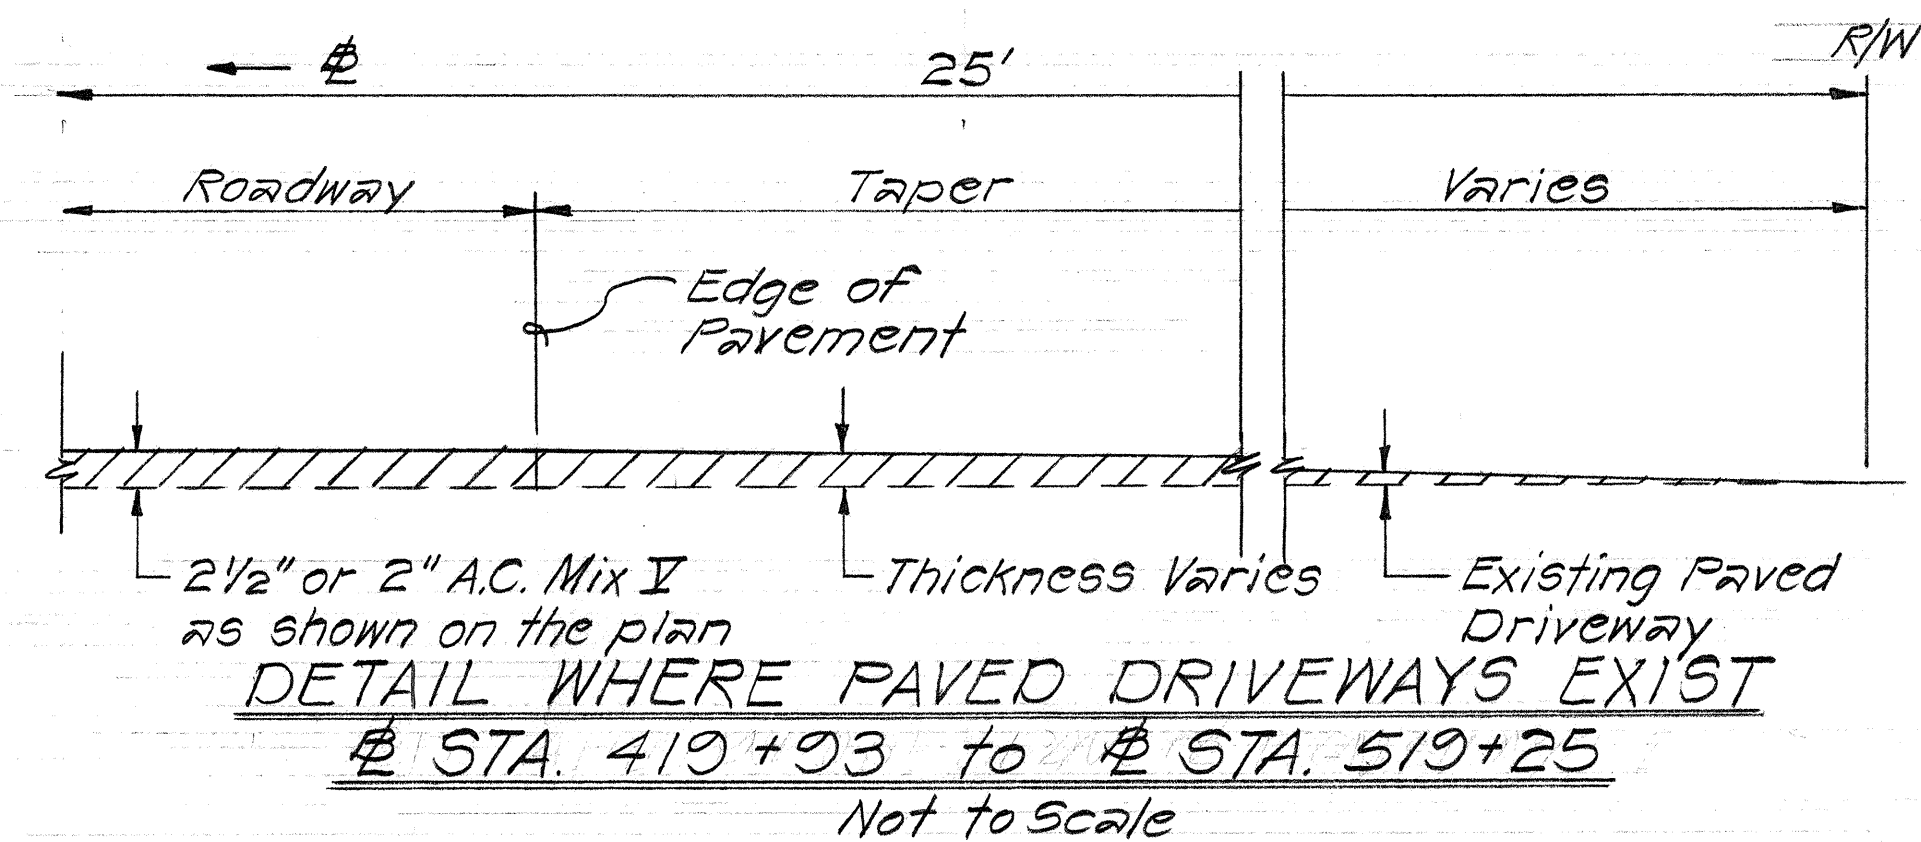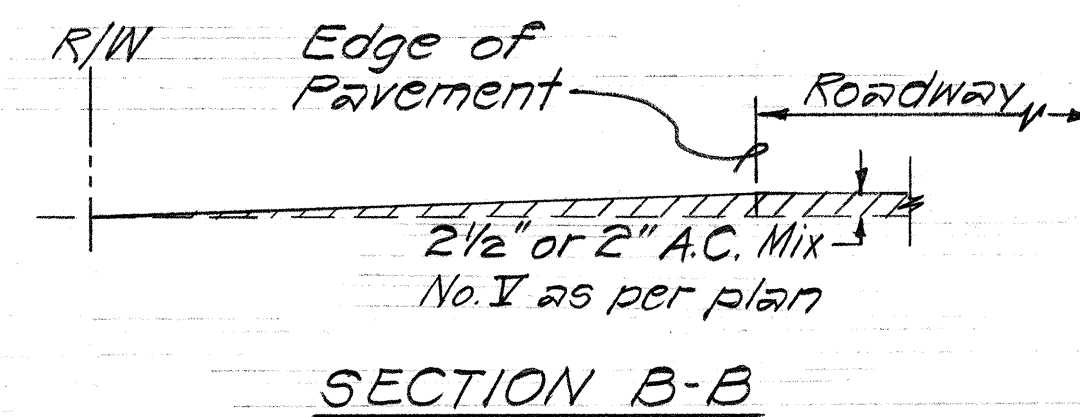

DETAIL FOR RECONSTRUCTION OF WEAKENED AREAS
Not to Scale

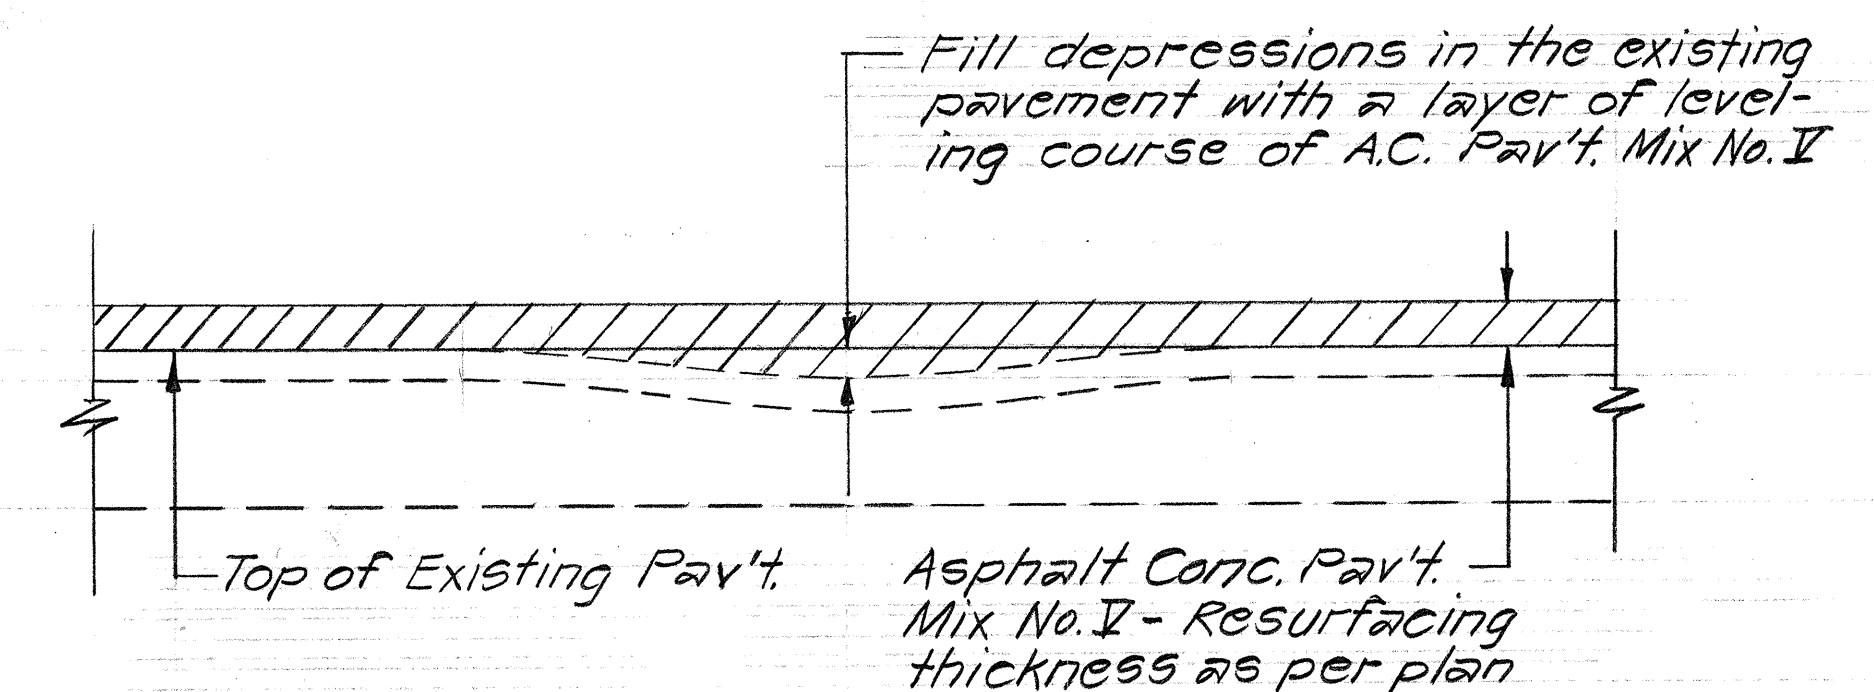

LEVELING COURSE DETAIL
Not to Scale

STATE OF HAWAII
DEPARTMENT OF TRANSPORTATION
HIGHWAYS DIVISION

MISCELLANEOUS DETAILS
FOR
KAMEHAMEHA HIGHWAY RESURFACING
Proj. No. 83E-01-74

Scale: As Shown Date: May, 1974

SHEET No. 2 OF 2 SHEETS

DESIGNED BY	DATE
DRAWN BY	
CHECKED BY	
NOTED BY	
NO.	