
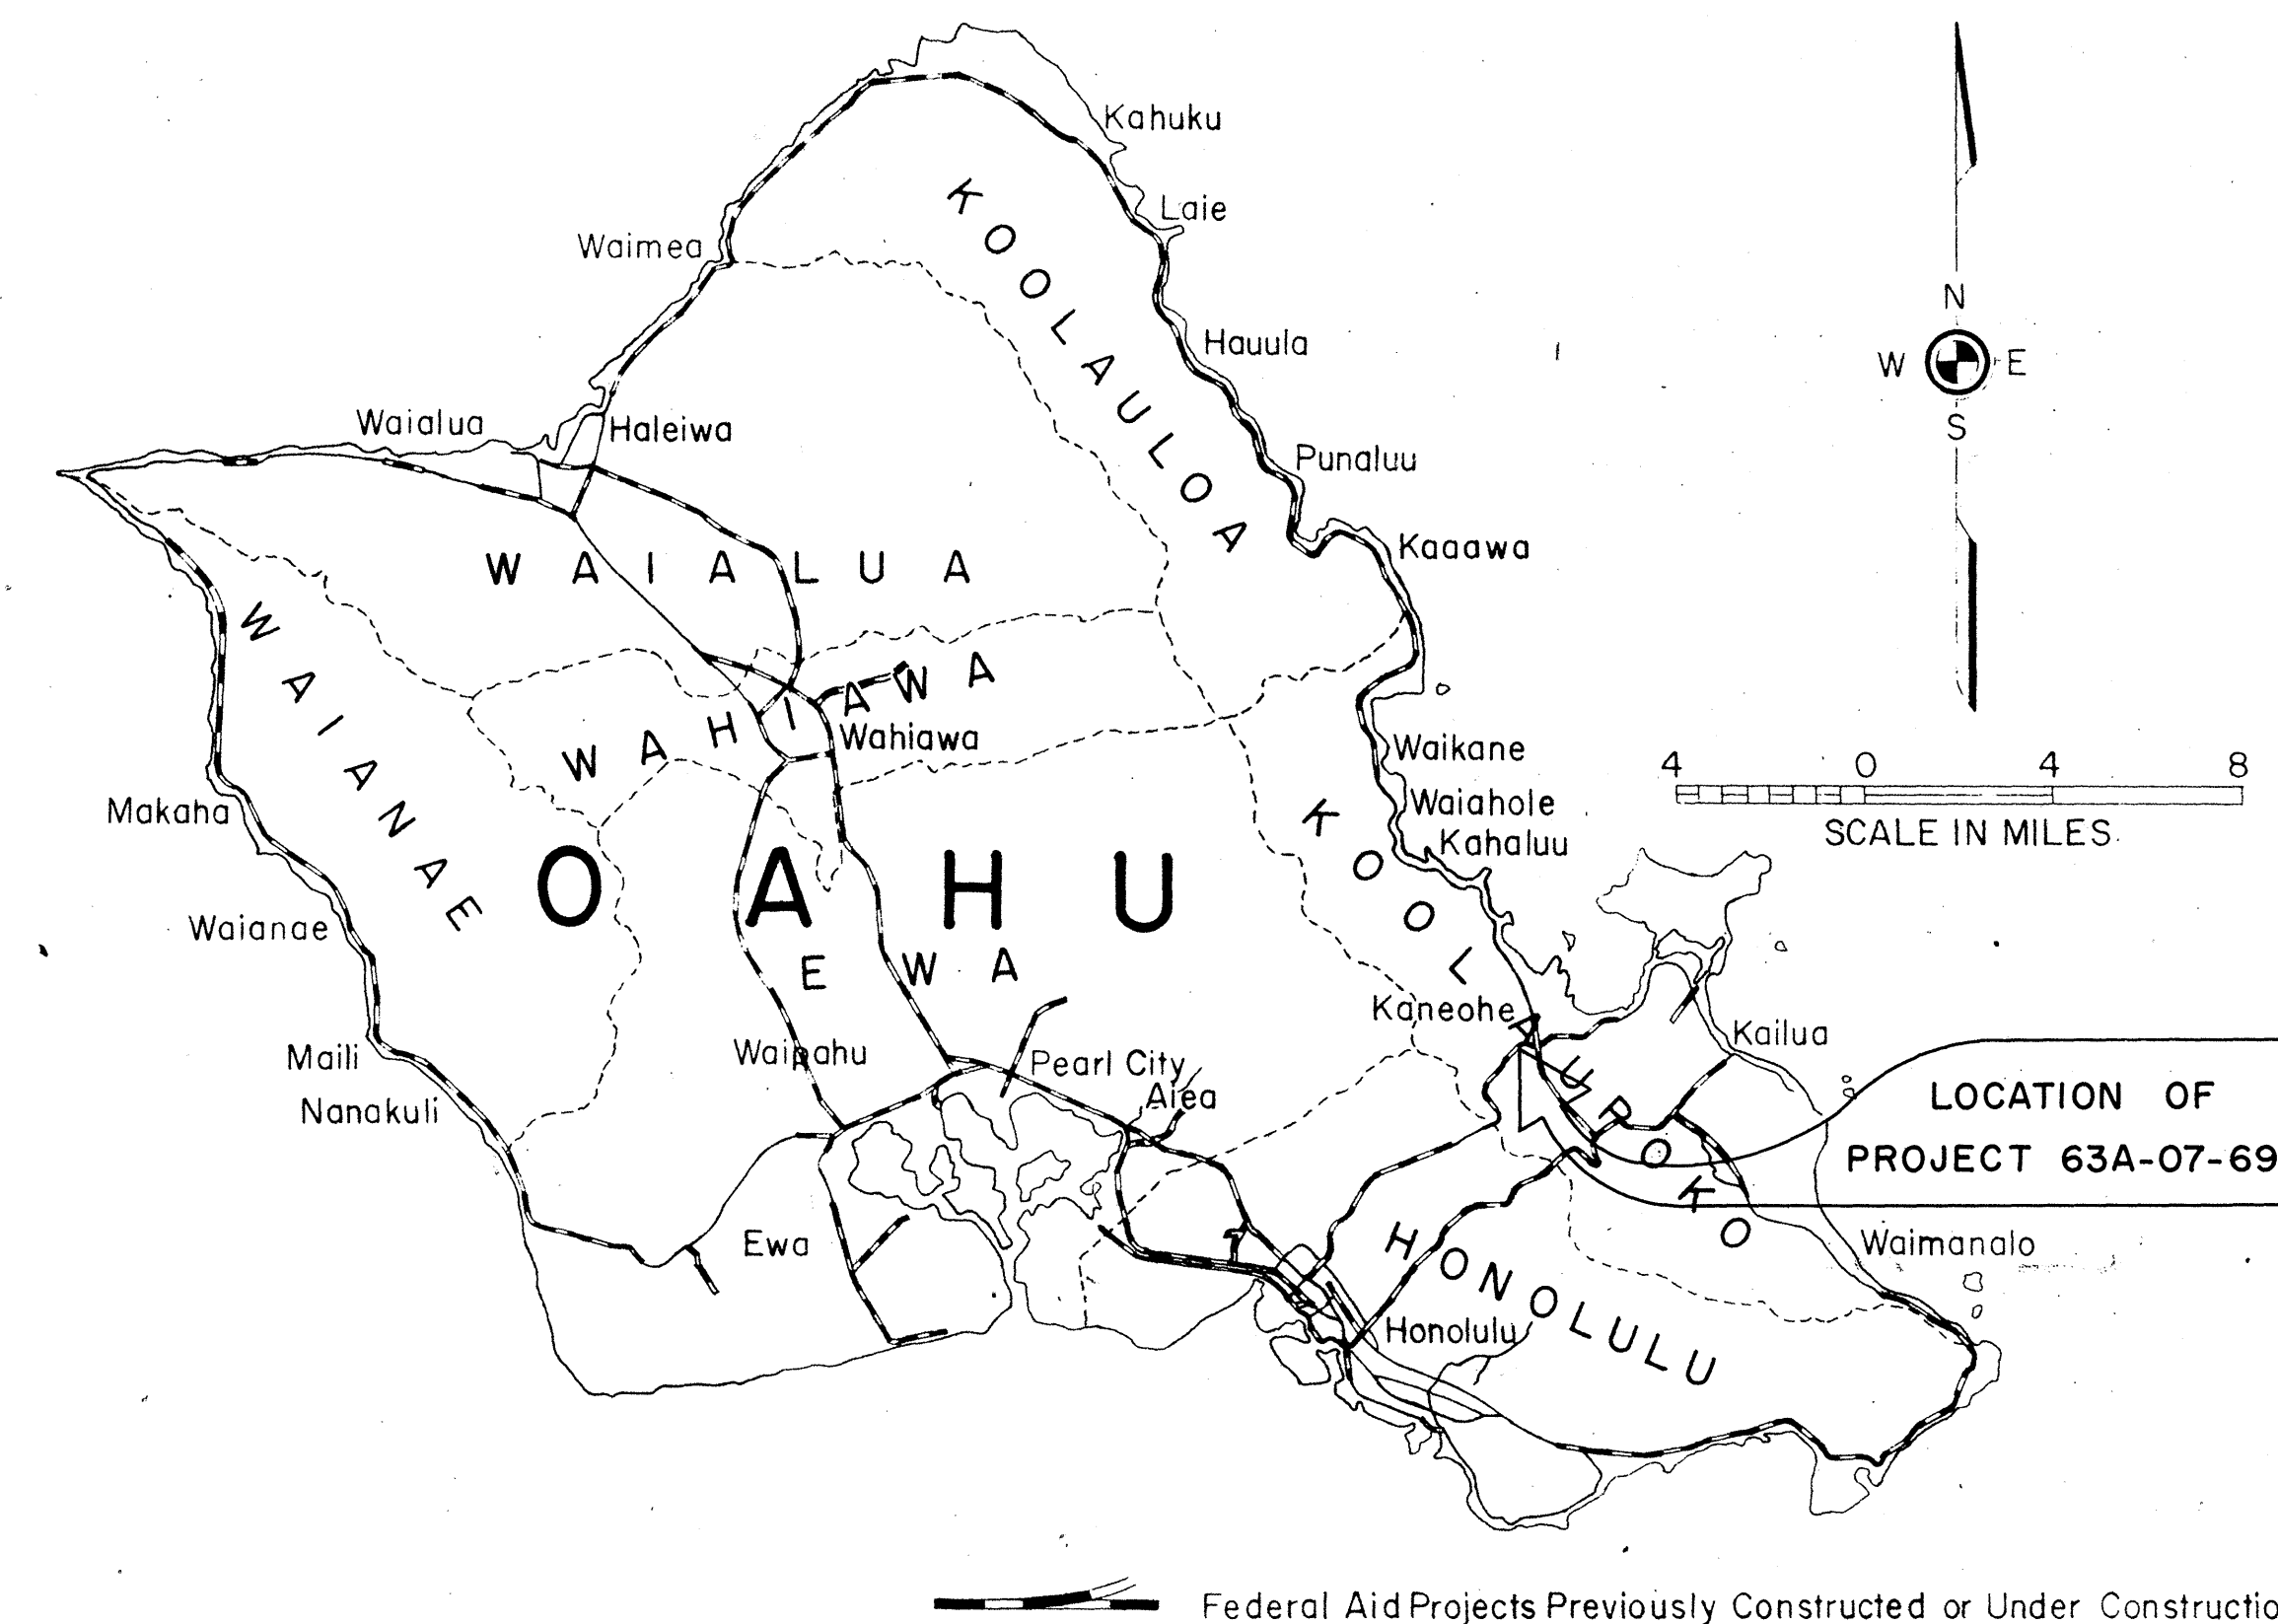
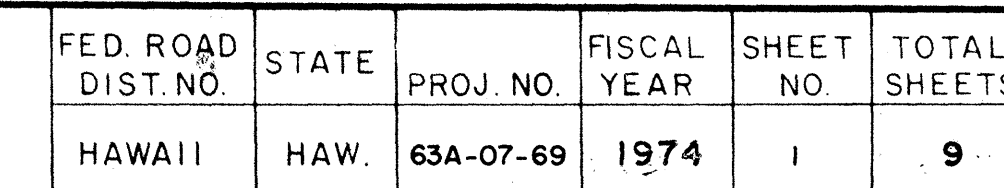


M. Miura C 548-7490 6/5/74
POST BY HIGHWAY DESIGN UNIT PHONE DATE

PROJECT NO.
63A-07-69
DISTRICT OF KOOLAUPOKO
ISLAND OF OAHU

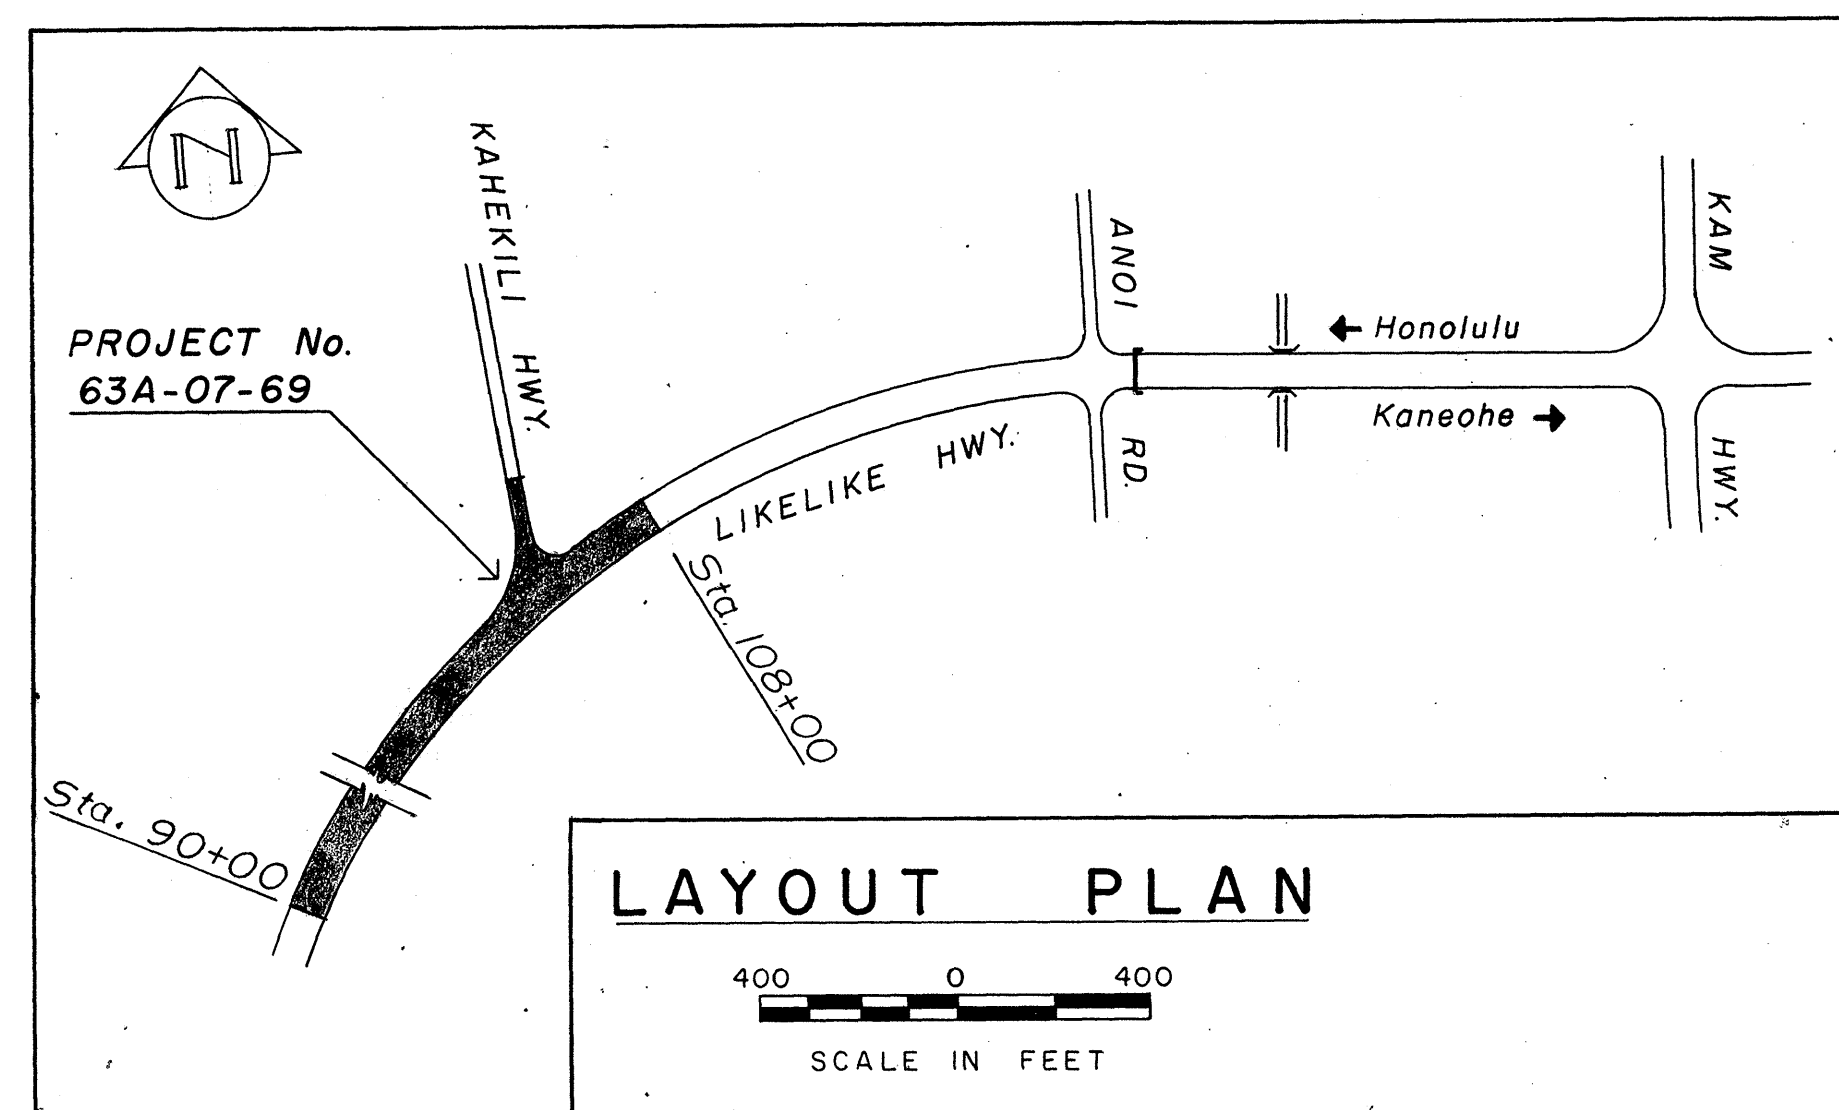

NOTE:
ALL CHANGES MADE DURING CONSTRUCTION HAVE
BEEN NOTED IN RED ON THESE TRACINGS, AND
CHECKED BY:

Mike Upesaw 9/1/76
PROJECT ENGINEER DATE

DEPARTMENT OF TRANSPORTATION
STATE OF HAWAII

APPROVED: Murray Lee 5/29/2004

FOR DIRECTOR OF TRANSPORTATION DATE