
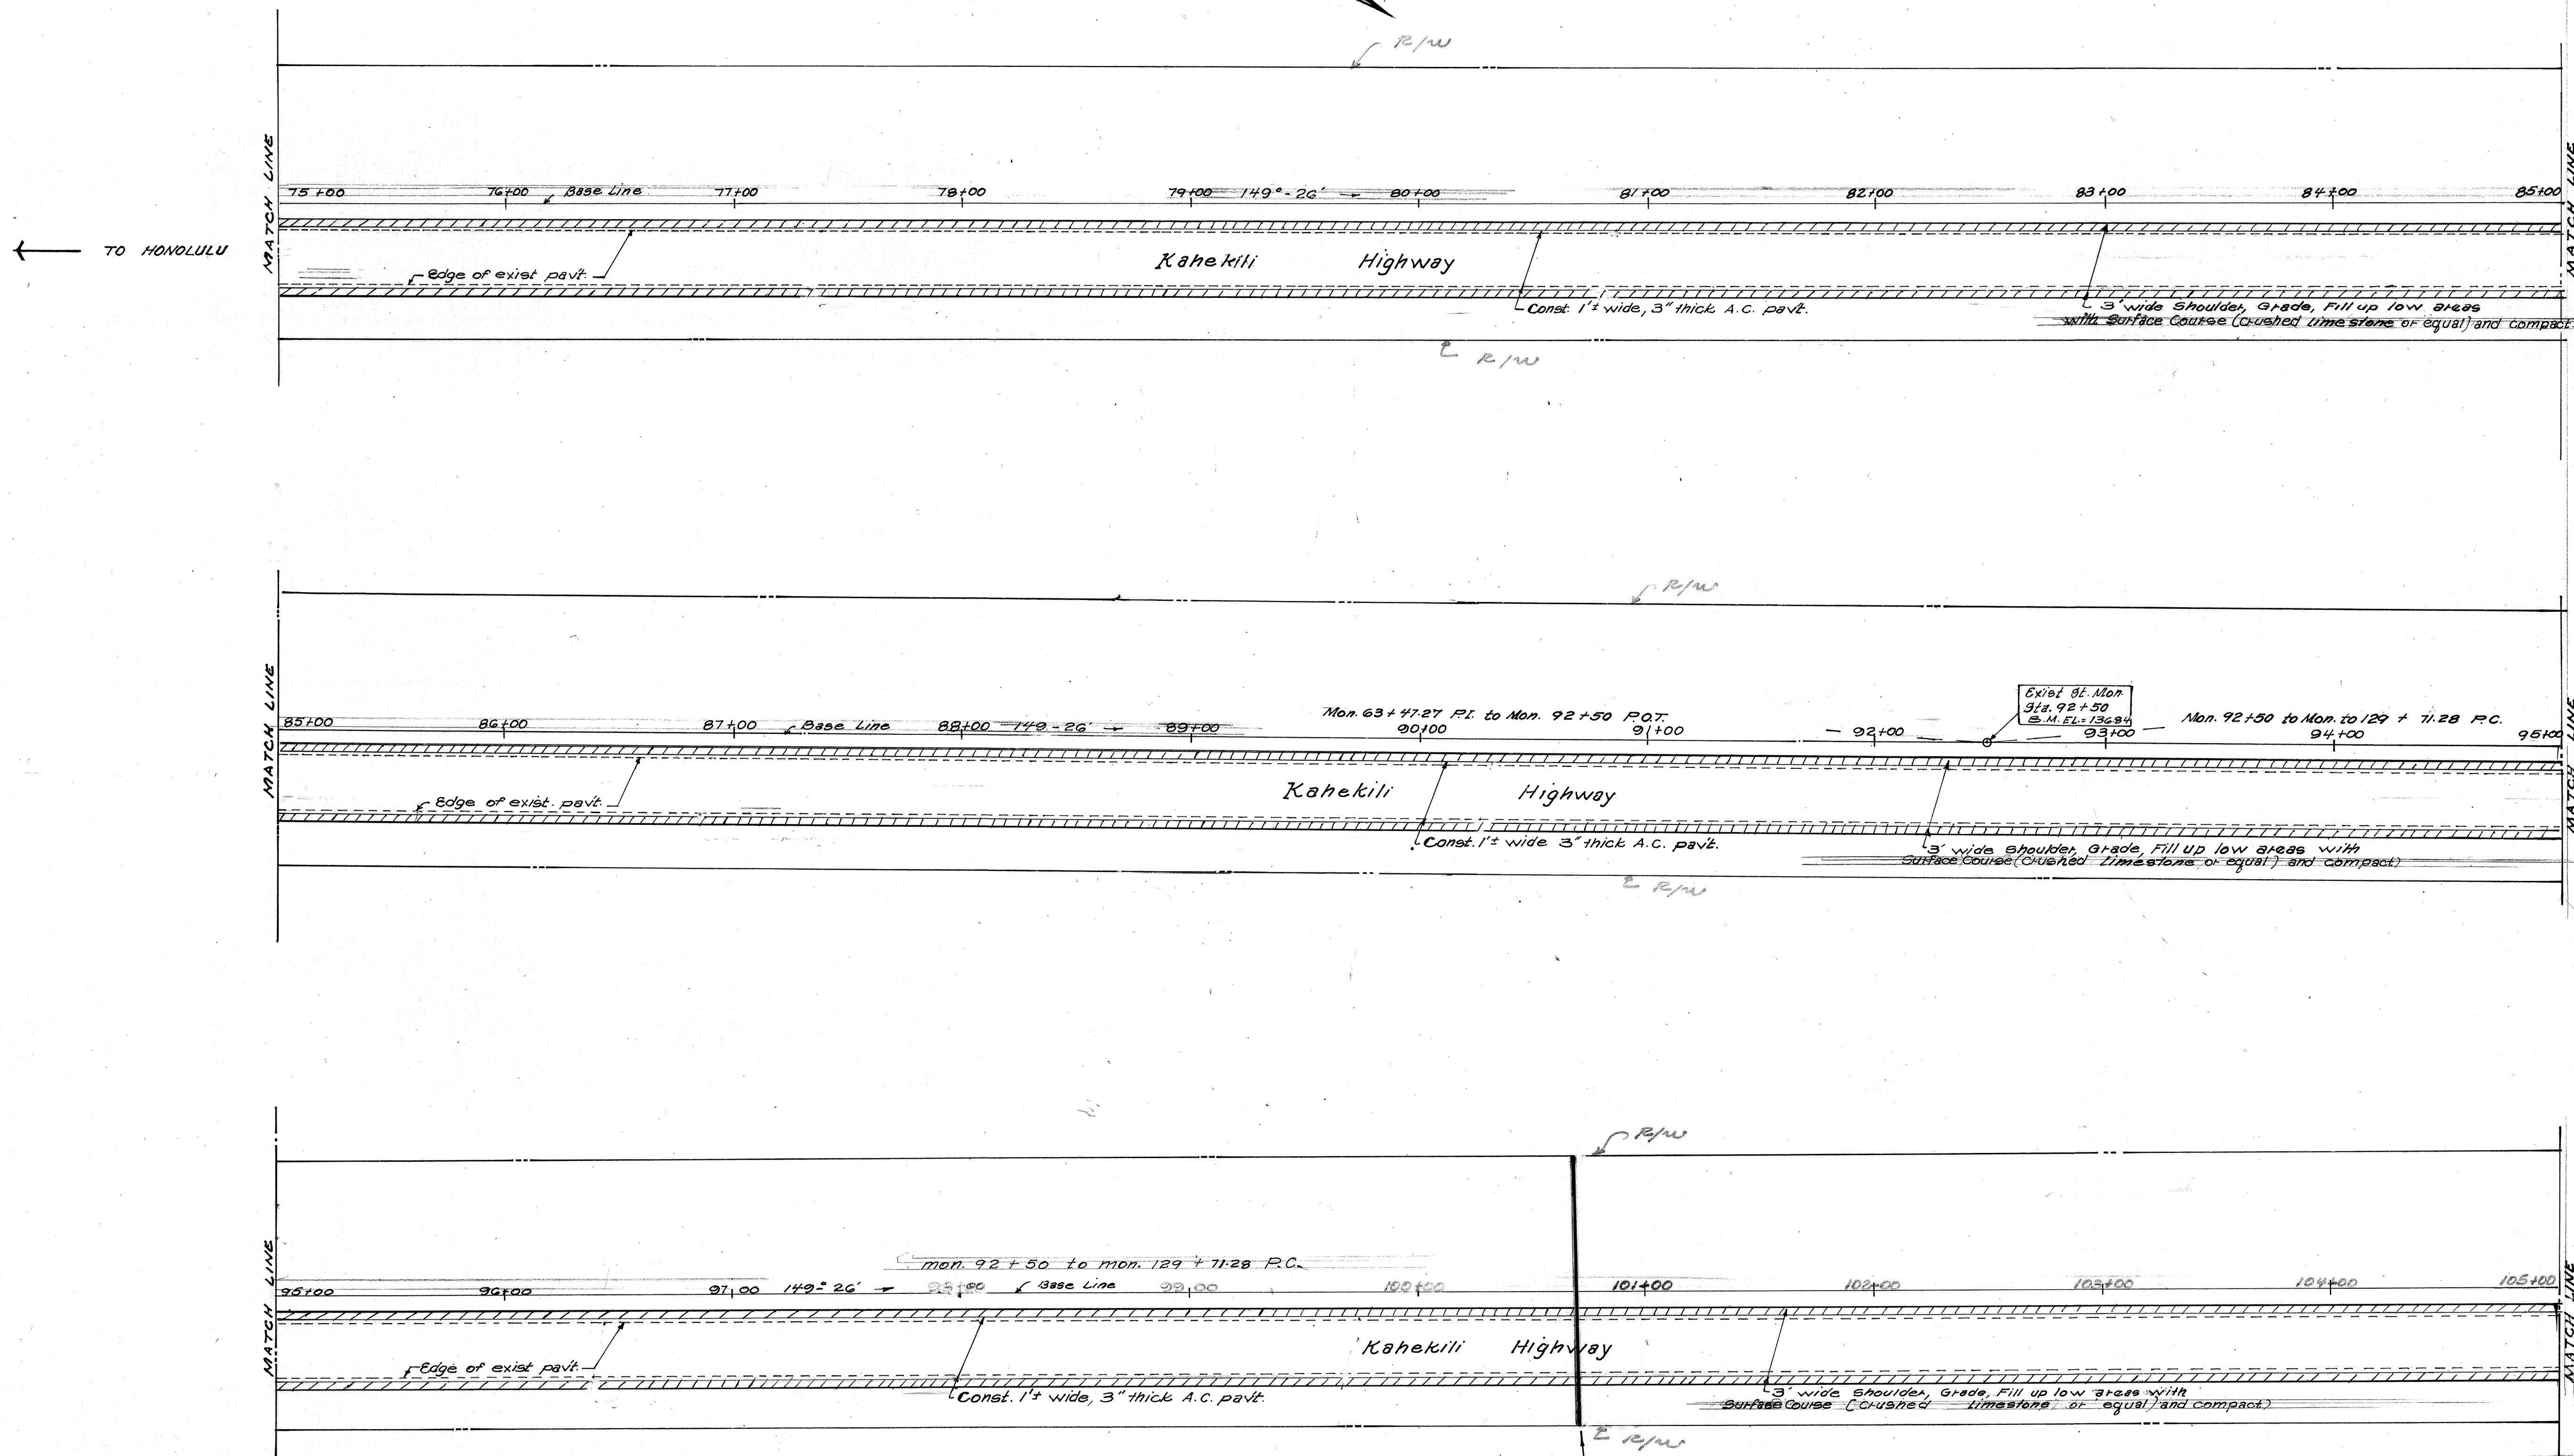


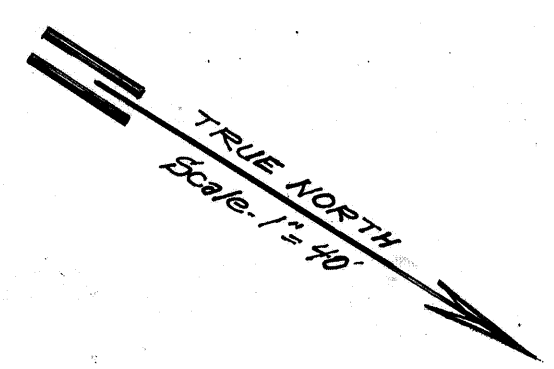


END OF PROJECT
STA. 100+70

AS-BUILT PLAN
Construction Completed 2-5-76
Date of As-Built 4-29-77
Drawn by [Signature]
Reviewed by [Signature]

AS BUILT

9-11-78		Revision for end of Project		From Sta. 191+92 to Sta. 100+70		9-11-78		[Signature]		
NO.	DATE	DESCRIPTION				ENGR.	DEPT. OR DIV.			
REVISIONS										APPR'D
DEPARTMENT OF PUBLIC WORKS CITY AND COUNTY OF HONOLULU DIVISION OF ENGINEERING KAHEKILI HIGHWAY SHOULDER IMPROVEMENTS FROM LIKELIKE HIGHWAY TO KEAAHALA ROAD AND FROM HAIKU ROAD TO HUI IWA ROAD										
ENGINEER		S. O'Hai		DATE		6-9-78				
DRAFTSMAN		S. O'Hai		CHECKED BY						
APPROVED:		[Signature]		Scale:		1" = 40'				
CHIEF, DIVISION OF ENGINEERING		[Signature]								
F. B.										

JOB NO. 42-75

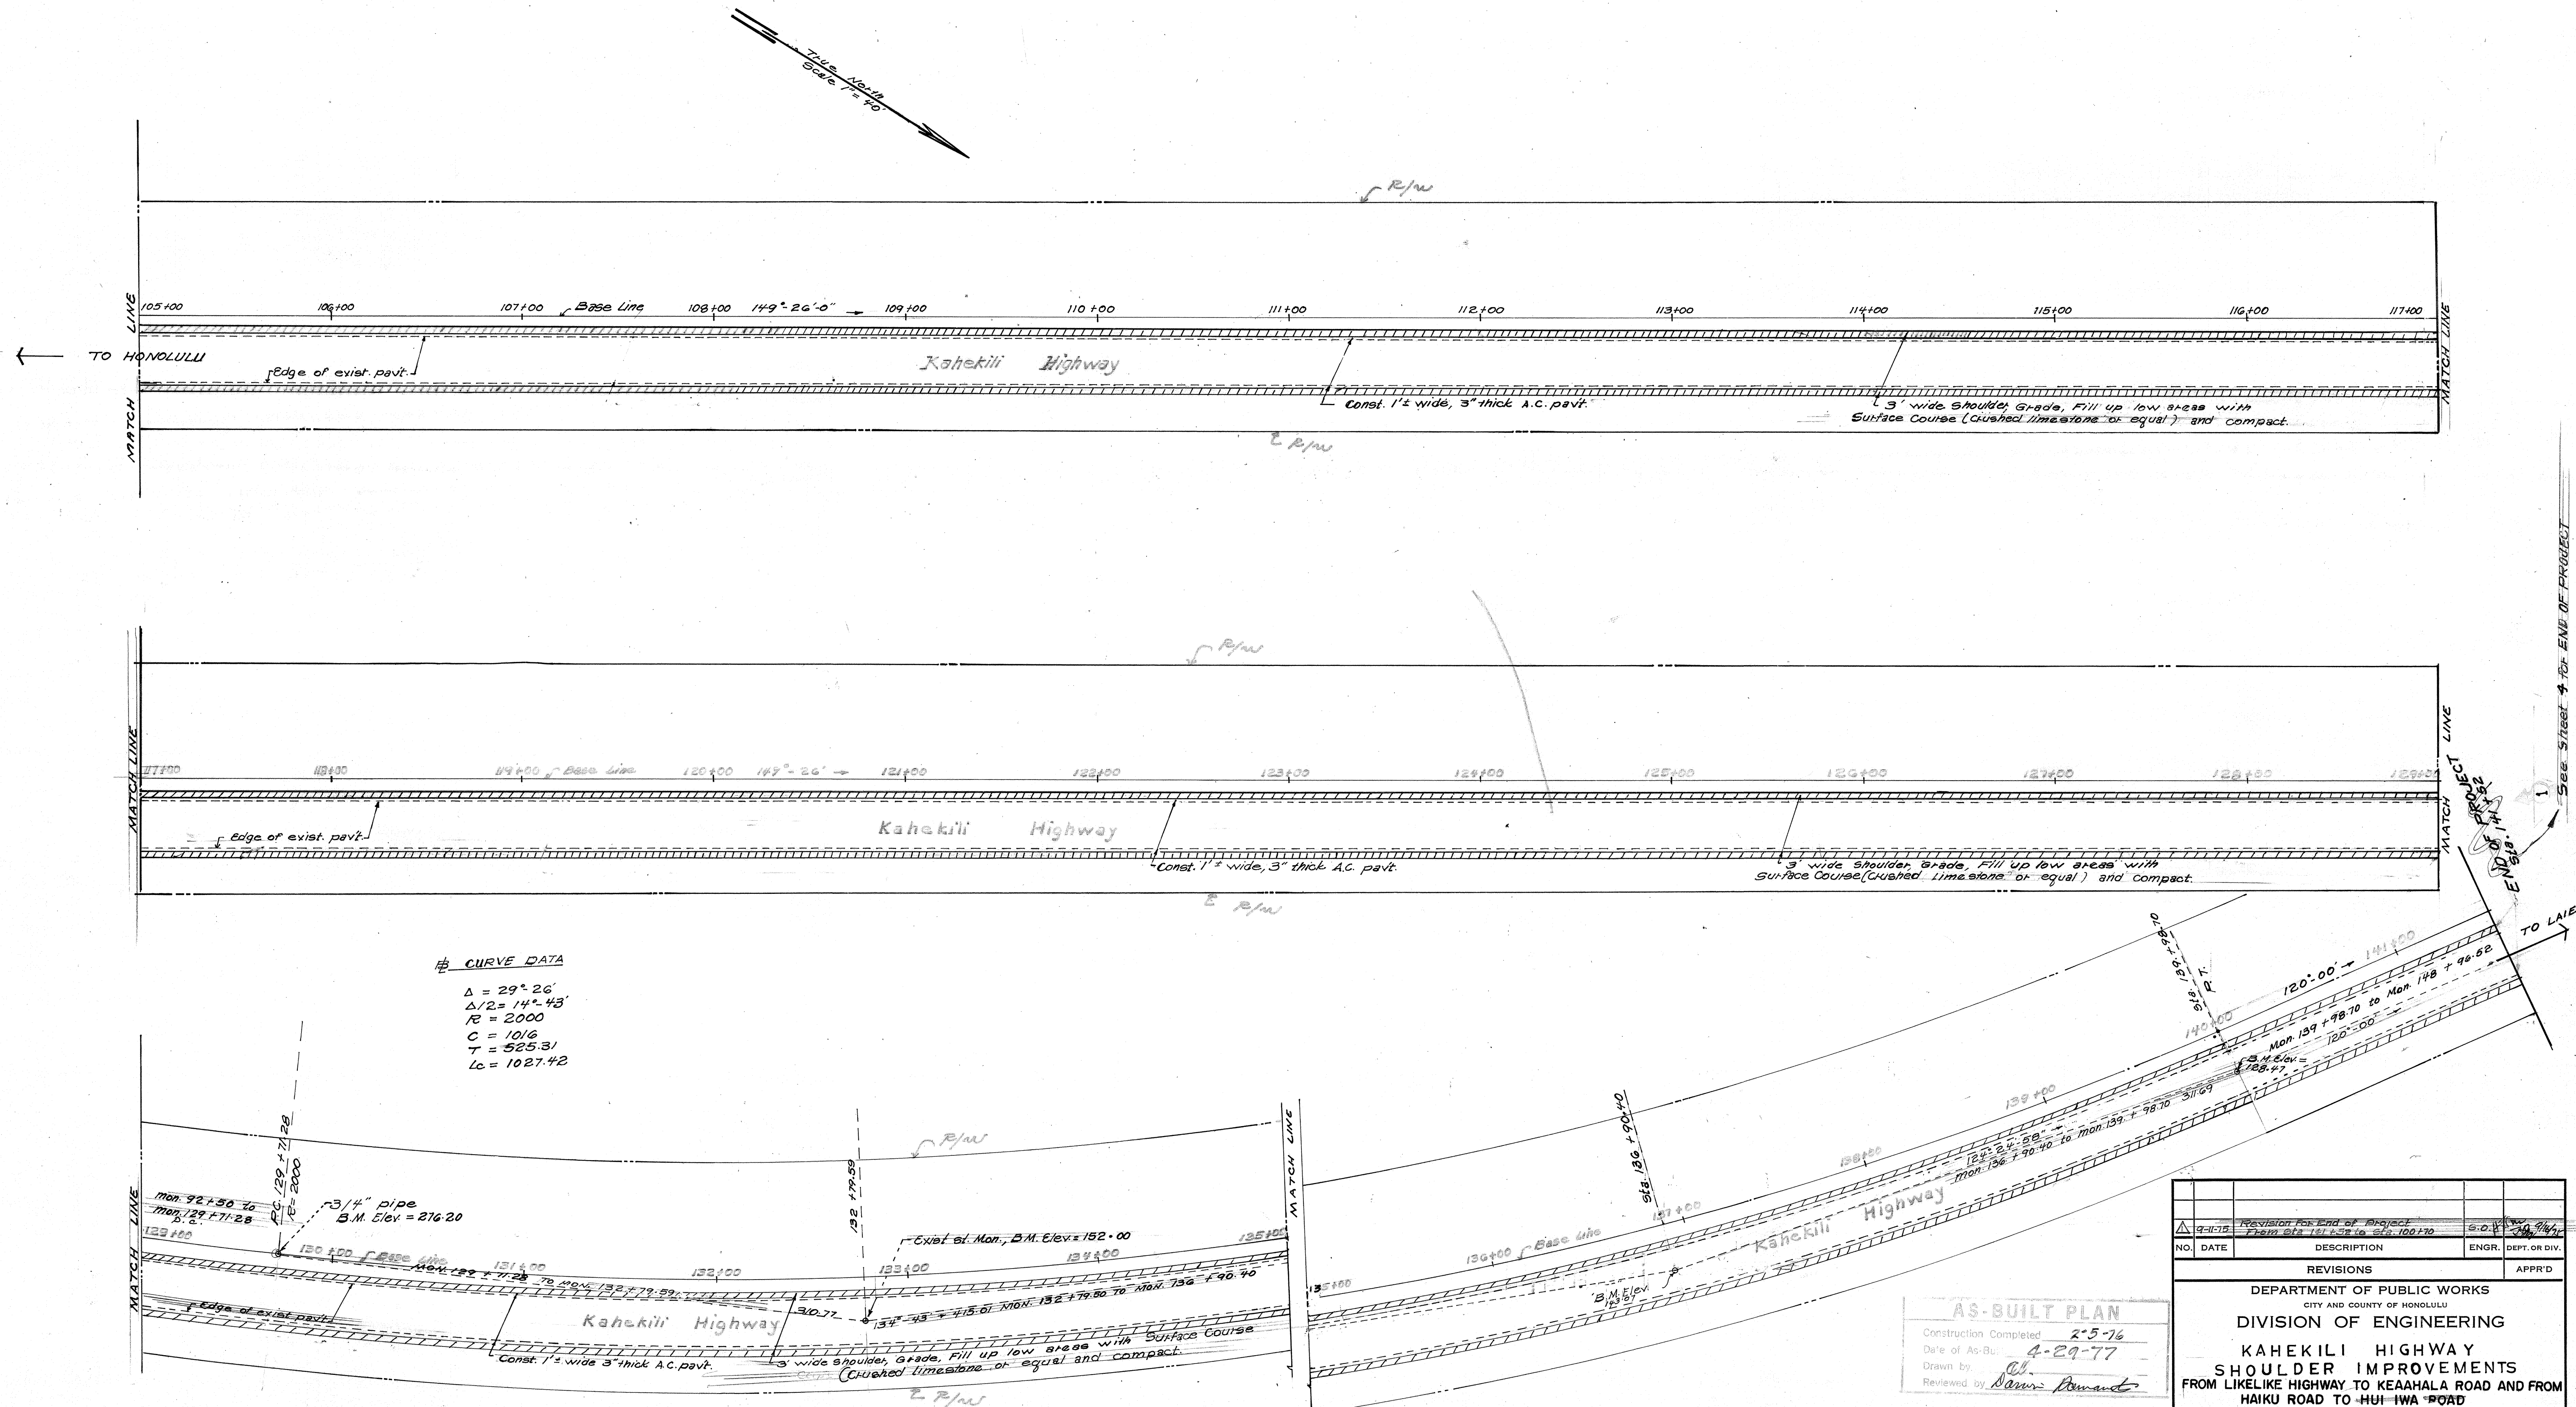

CURVE DATA
 $\Delta = 29^\circ 26'$
 $\Delta/2 = 14^\circ 43'$
 $R = 2000$
 $C = 1016$
 $T = 525.31$
 $L_c = 1027.42$

AS-BUILT PLAN
 Construction Completed **2-5-76**
 Date of As-Built **4-29-77**
 Drawn by **DL**
 Reviewed by **James Remond**

Revision for End of Project		S.O.V. 20/24/77	
NO.	DATE	DESCRIPTION	ENGR. DEPT. OR DIV.
REVISIONS		APPR'D	
DEPARTMENT OF PUBLIC WORKS CITY AND COUNTY OF HONOLULU DIVISION OF ENGINEERING KAHEKILI HIGHWAY SHOULDER IMPROVEMENTS FROM LIKELIKE HIGHWAY TO KEAAHALA ROAD AND FROM HAIKU ROAD TO HUI IWA ROAD 100+70			
ENGINEER S. O'Hai	DATE 6-9-75		
DRAFTSMAN S. O'Hai	CHECKED BY T.M.		
APPROVED:		Scale: 1" = 40'	
CHIEF, DIVISION OF ENGINEERING T.M.			
F. B.			

AS BUILT

JOB NO. 42-75

FILE	POCKET	FOLDER	NO.
22	1	2	11

See Sheet 4 for END OF PROJECT